


INDEX TO DRAWINGS	
SHEET NO.	DESCRIPTION
1	TITLE SHEET
2	TYPICAL SECTIONS
3-5	PLAN AND PROFILE
6	MISCELLANEOUS DETAILS

STATE OF HAWAII
DEPARTMENT OF TRANSPORTATION
HIGHWAYS DIVISION
AS BUILT PLANS FOR
RESURFACING AND WIDENING OF A PORTION OF
KAUAI BELT ROAD
MAHAIKONA BRIDGE TO ONAONA ROAD
PROJECT NO. 50B-01-67
DISTRICT OF WAIMEA
ISLAND OF KAUAI

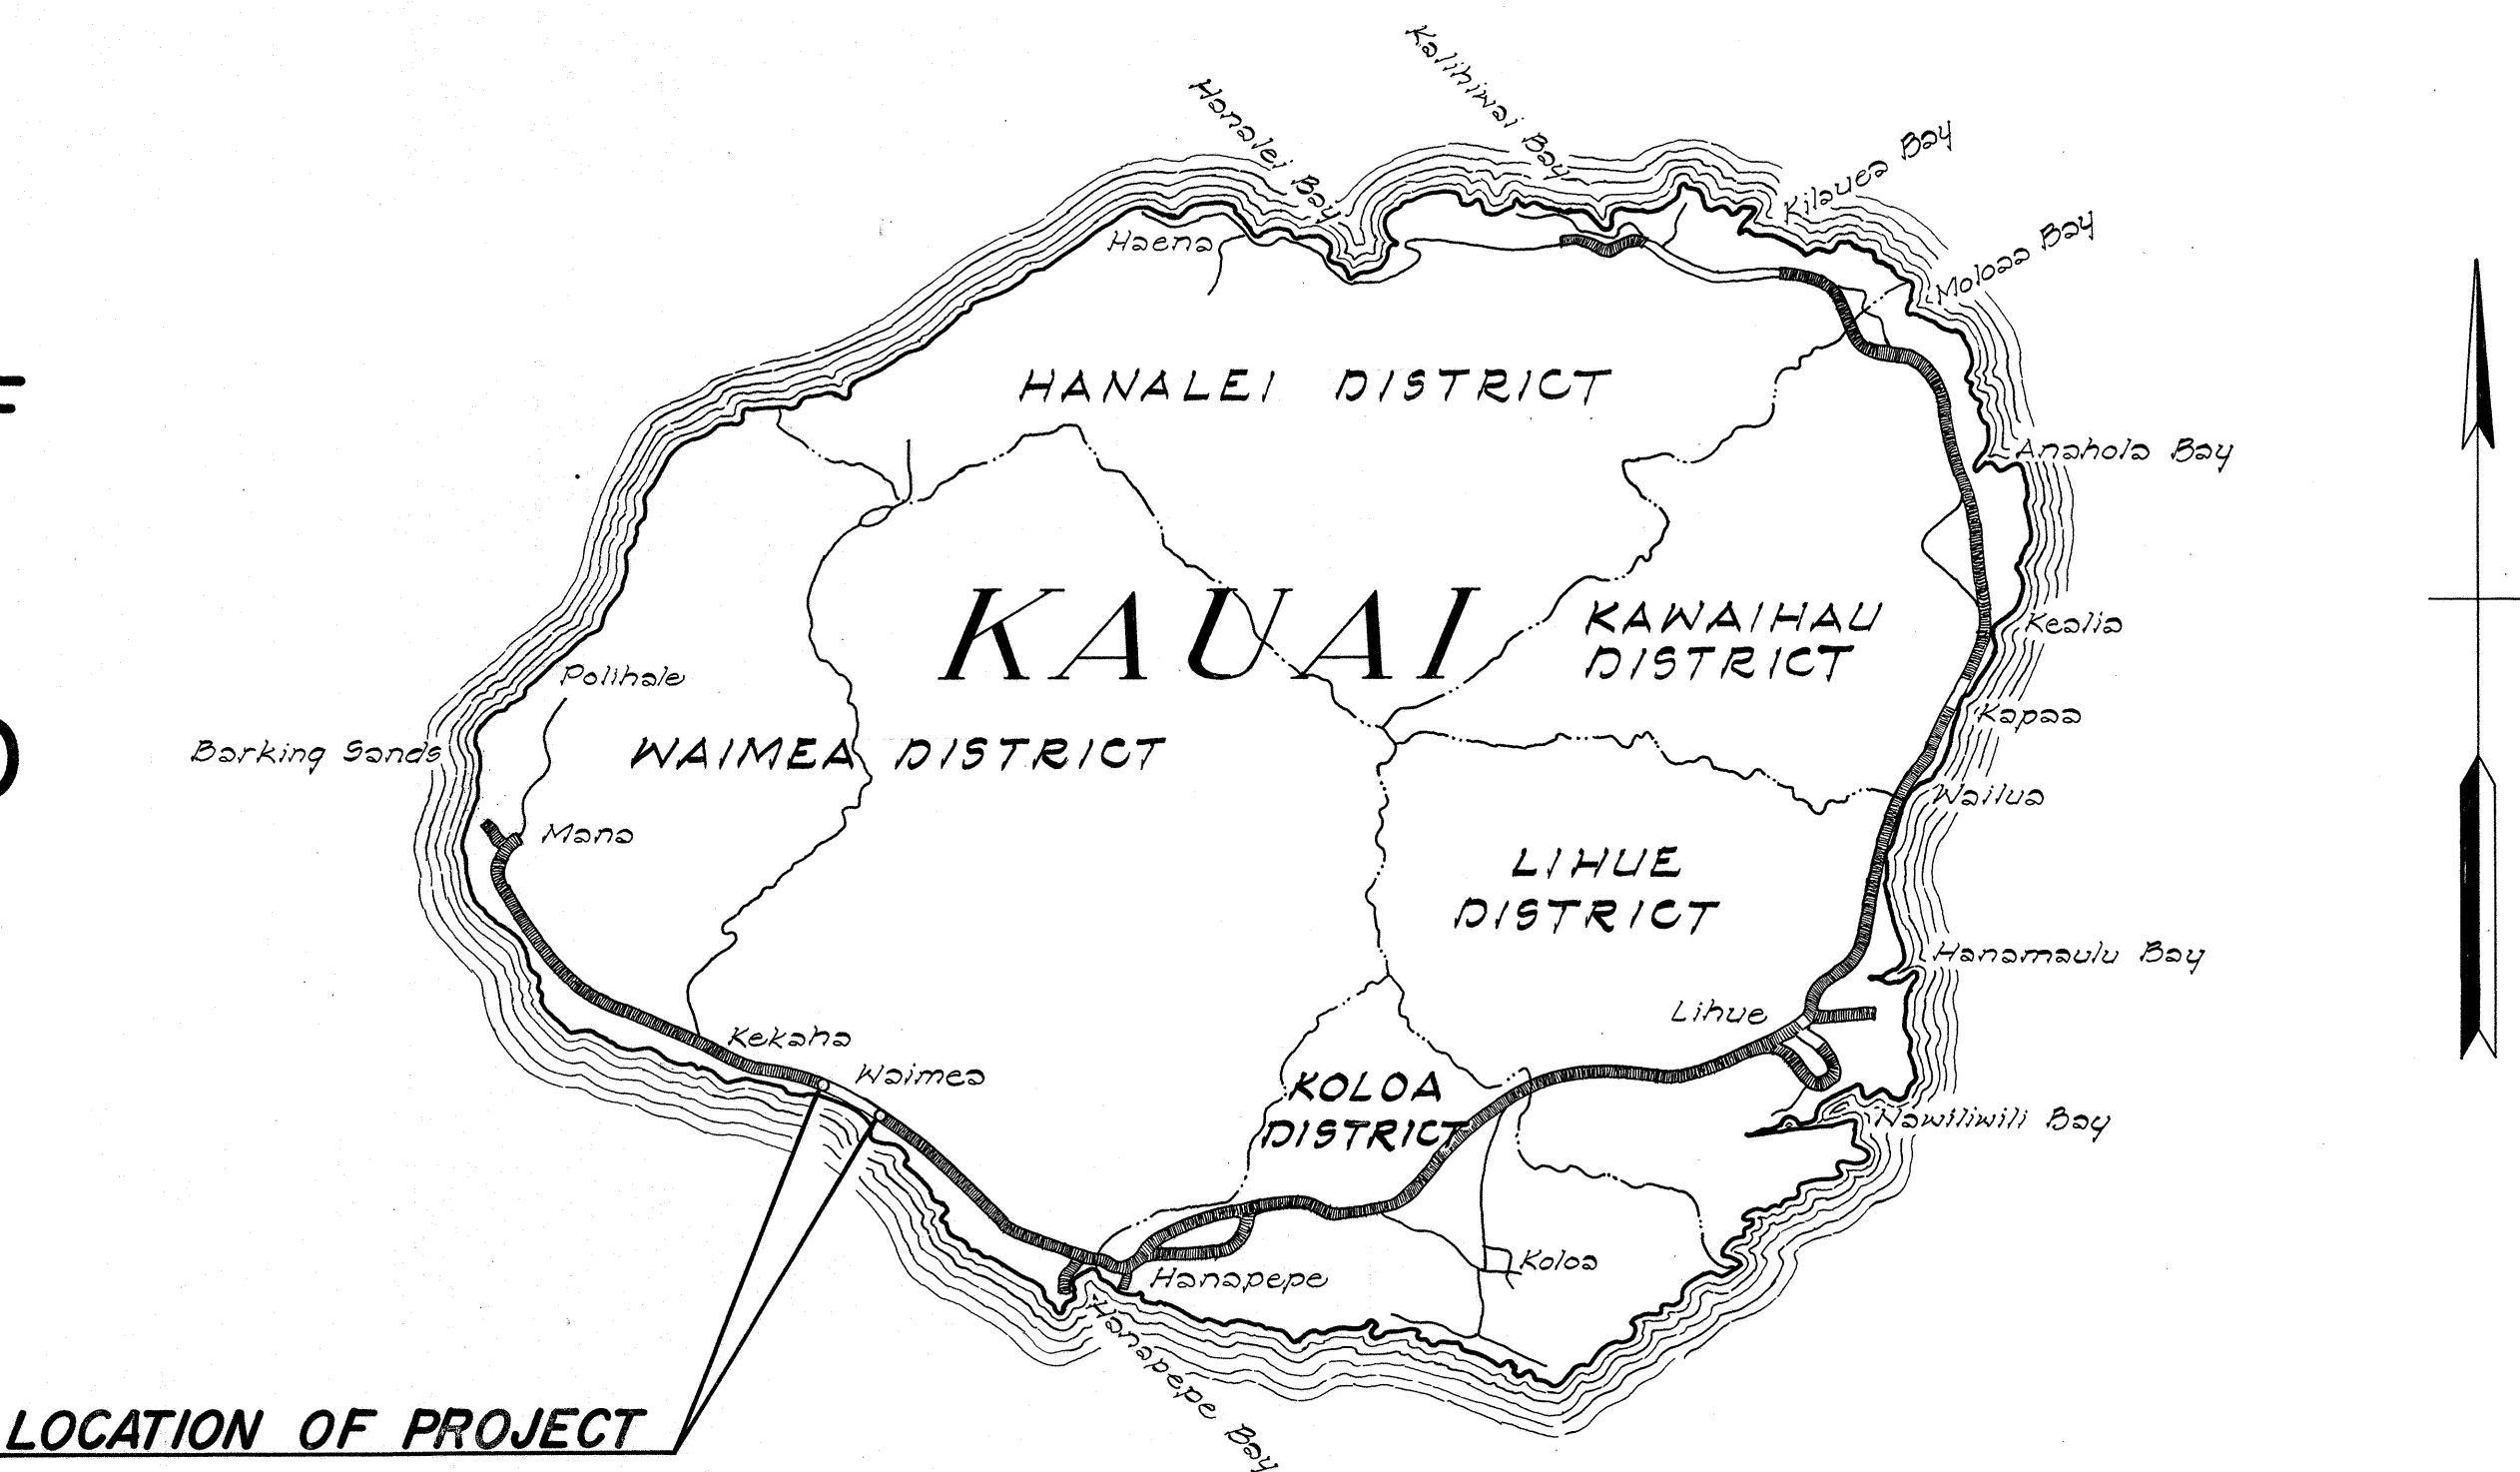


LOCATION OF PROJECT

FEDERAL AID PROJECTS PREVIOUSLY CONSTRUCTED OR UNDER CONSTRUCTION

CONVENTIONAL	SIGNS
Baseline	7/5
Boundary Line	
Fences (Named)	
Existing Roadway	
Pipe Culvert	
Box Culvert	
Telephone Line & Pole	
Electric Line & Pole	
Water Main	

PLAN
PROFILE

SCALES
1 INCH = 100 FT.
HOR. 1 INCH = 100 FT.
VER. 1 INCH = 10 FT.

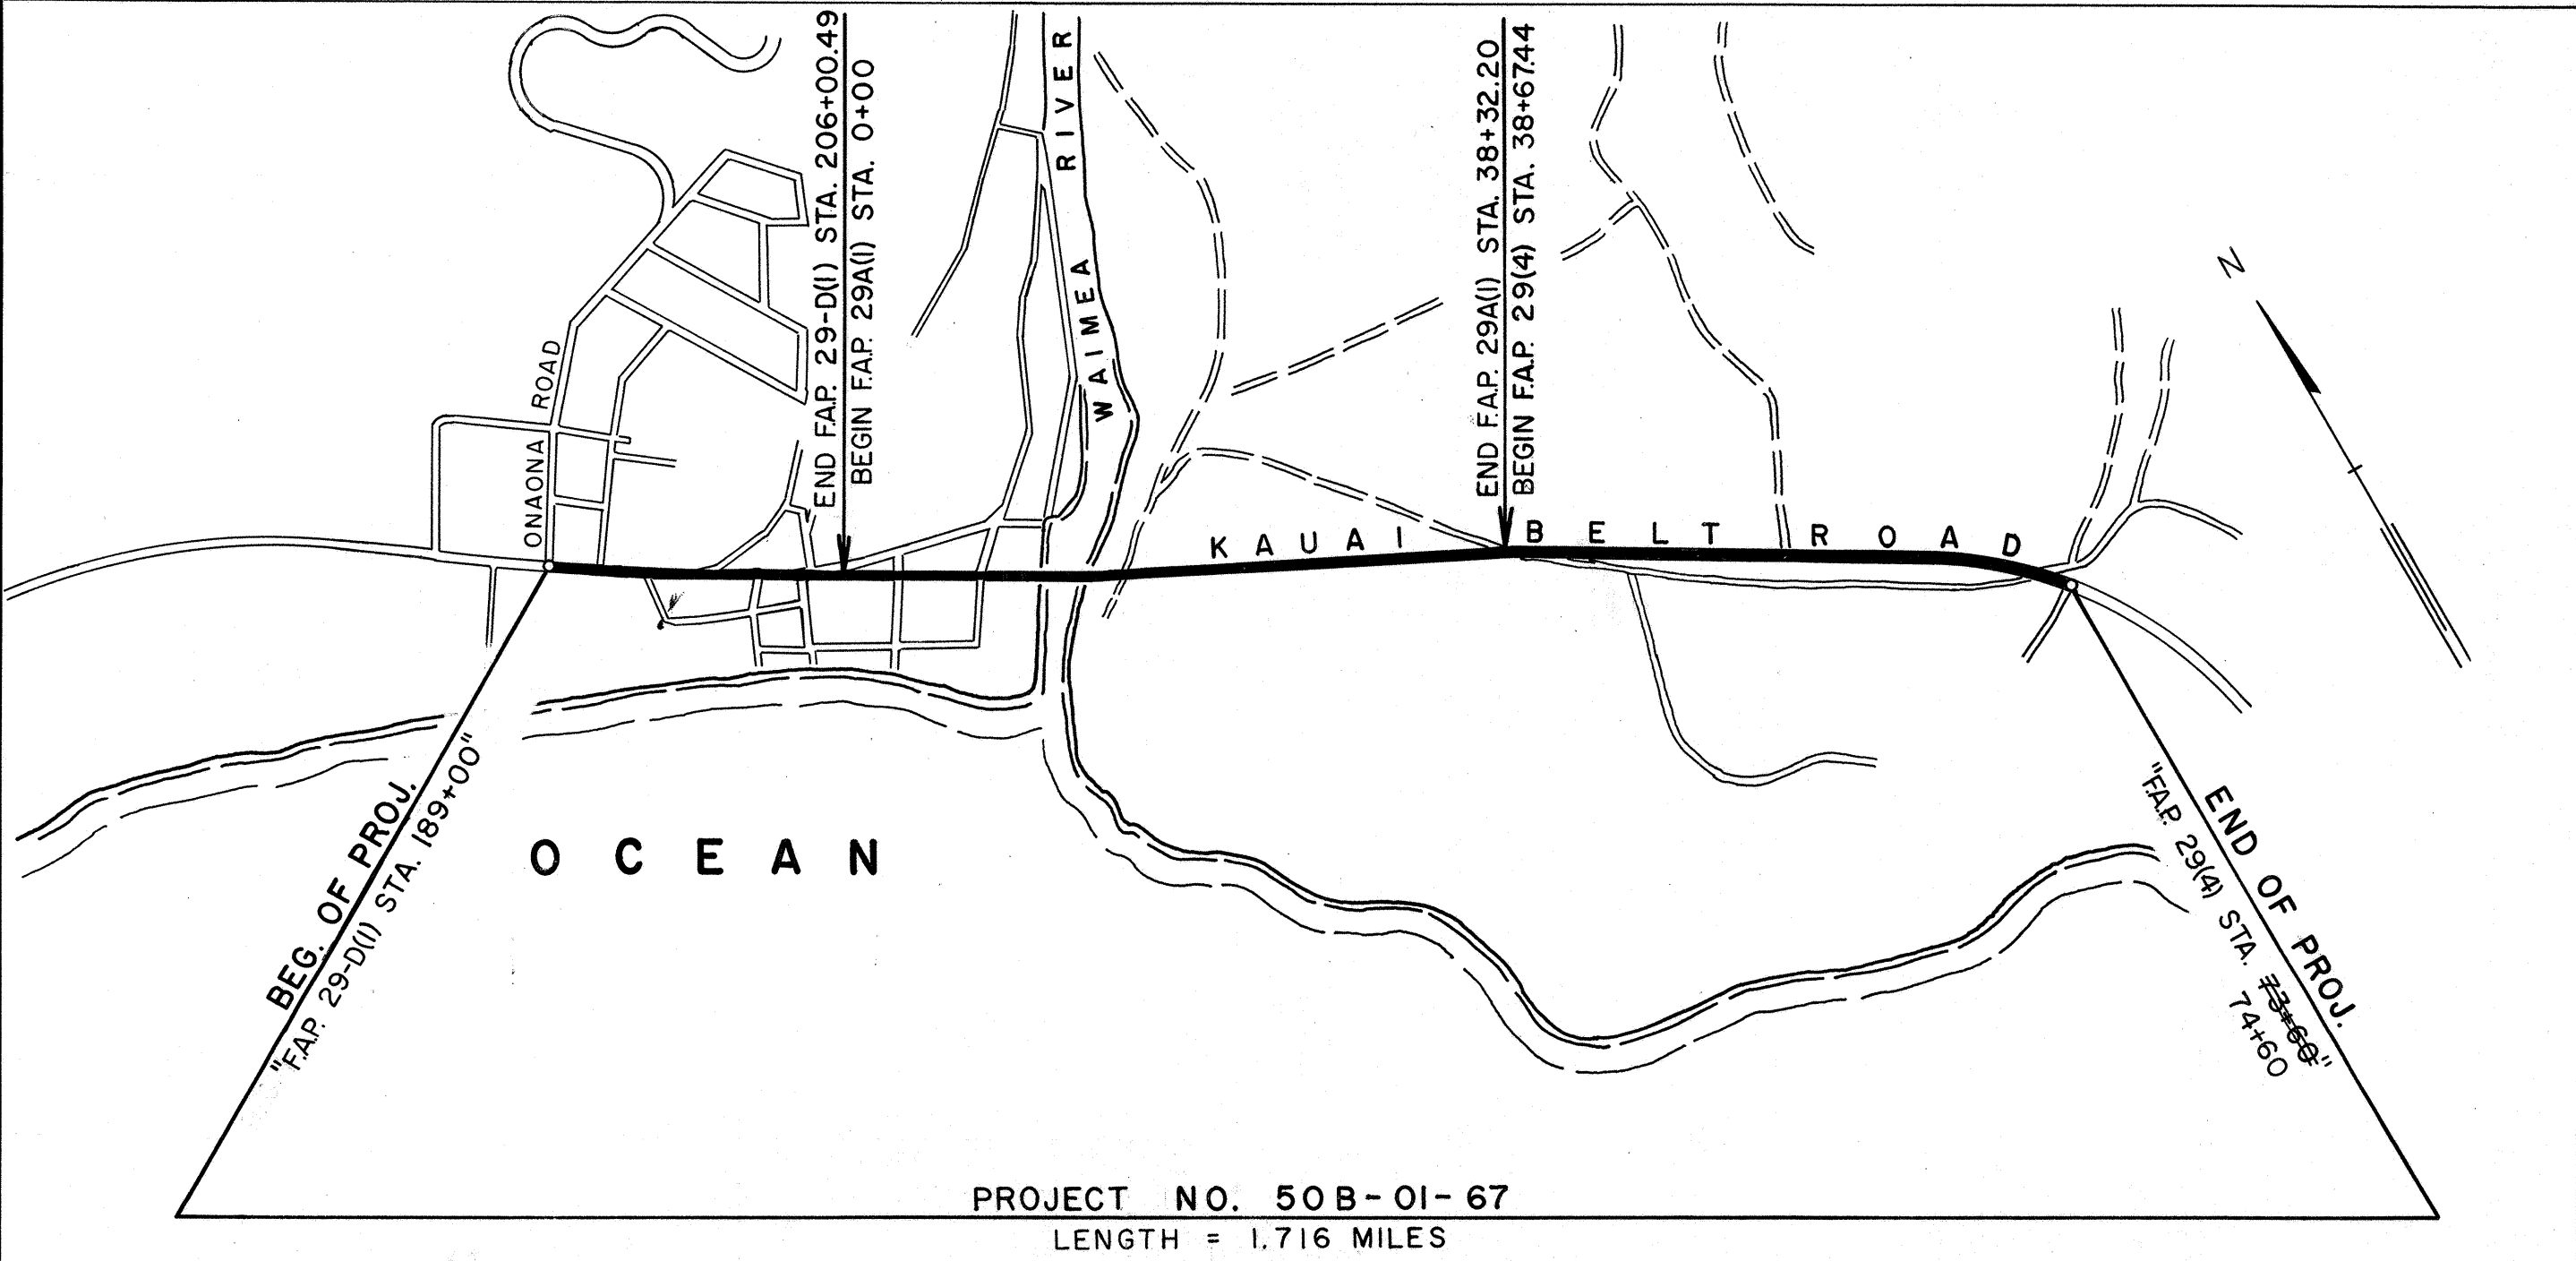

LAYOUT OF PROJECT
SCALE 1" = 1000'

NOTE:
All changes made during construction are shown in red on these tracings and checked by
Shigeto Yamaguchi
Project Engineer
3/19/68
Date

APPROVED:
DATE 10-20-66

John W. Sun
DIRECTOR OF TRANSPORTATION