


| PLAN     | DATE |
|----------|------|
| BY       |      |
| SURVEYED |      |
| NOTED    |      |
| NO.      |      |


| PROFILE  | DATE |
|----------|------|
| BY       |      |
| SURVEYED |      |
| NOTED    |      |
| NO.      |      |

| FED. ROAD DIST. No. | STATE | PROJ. No. | FISCAL YEAR | SHEET No. | TOTAL SHEETS |
|---------------------|-------|-----------|-------------|-----------|--------------|
| HAWAII              | HAW.  | 50E-02-66 | 1966        | 1         | 1            |

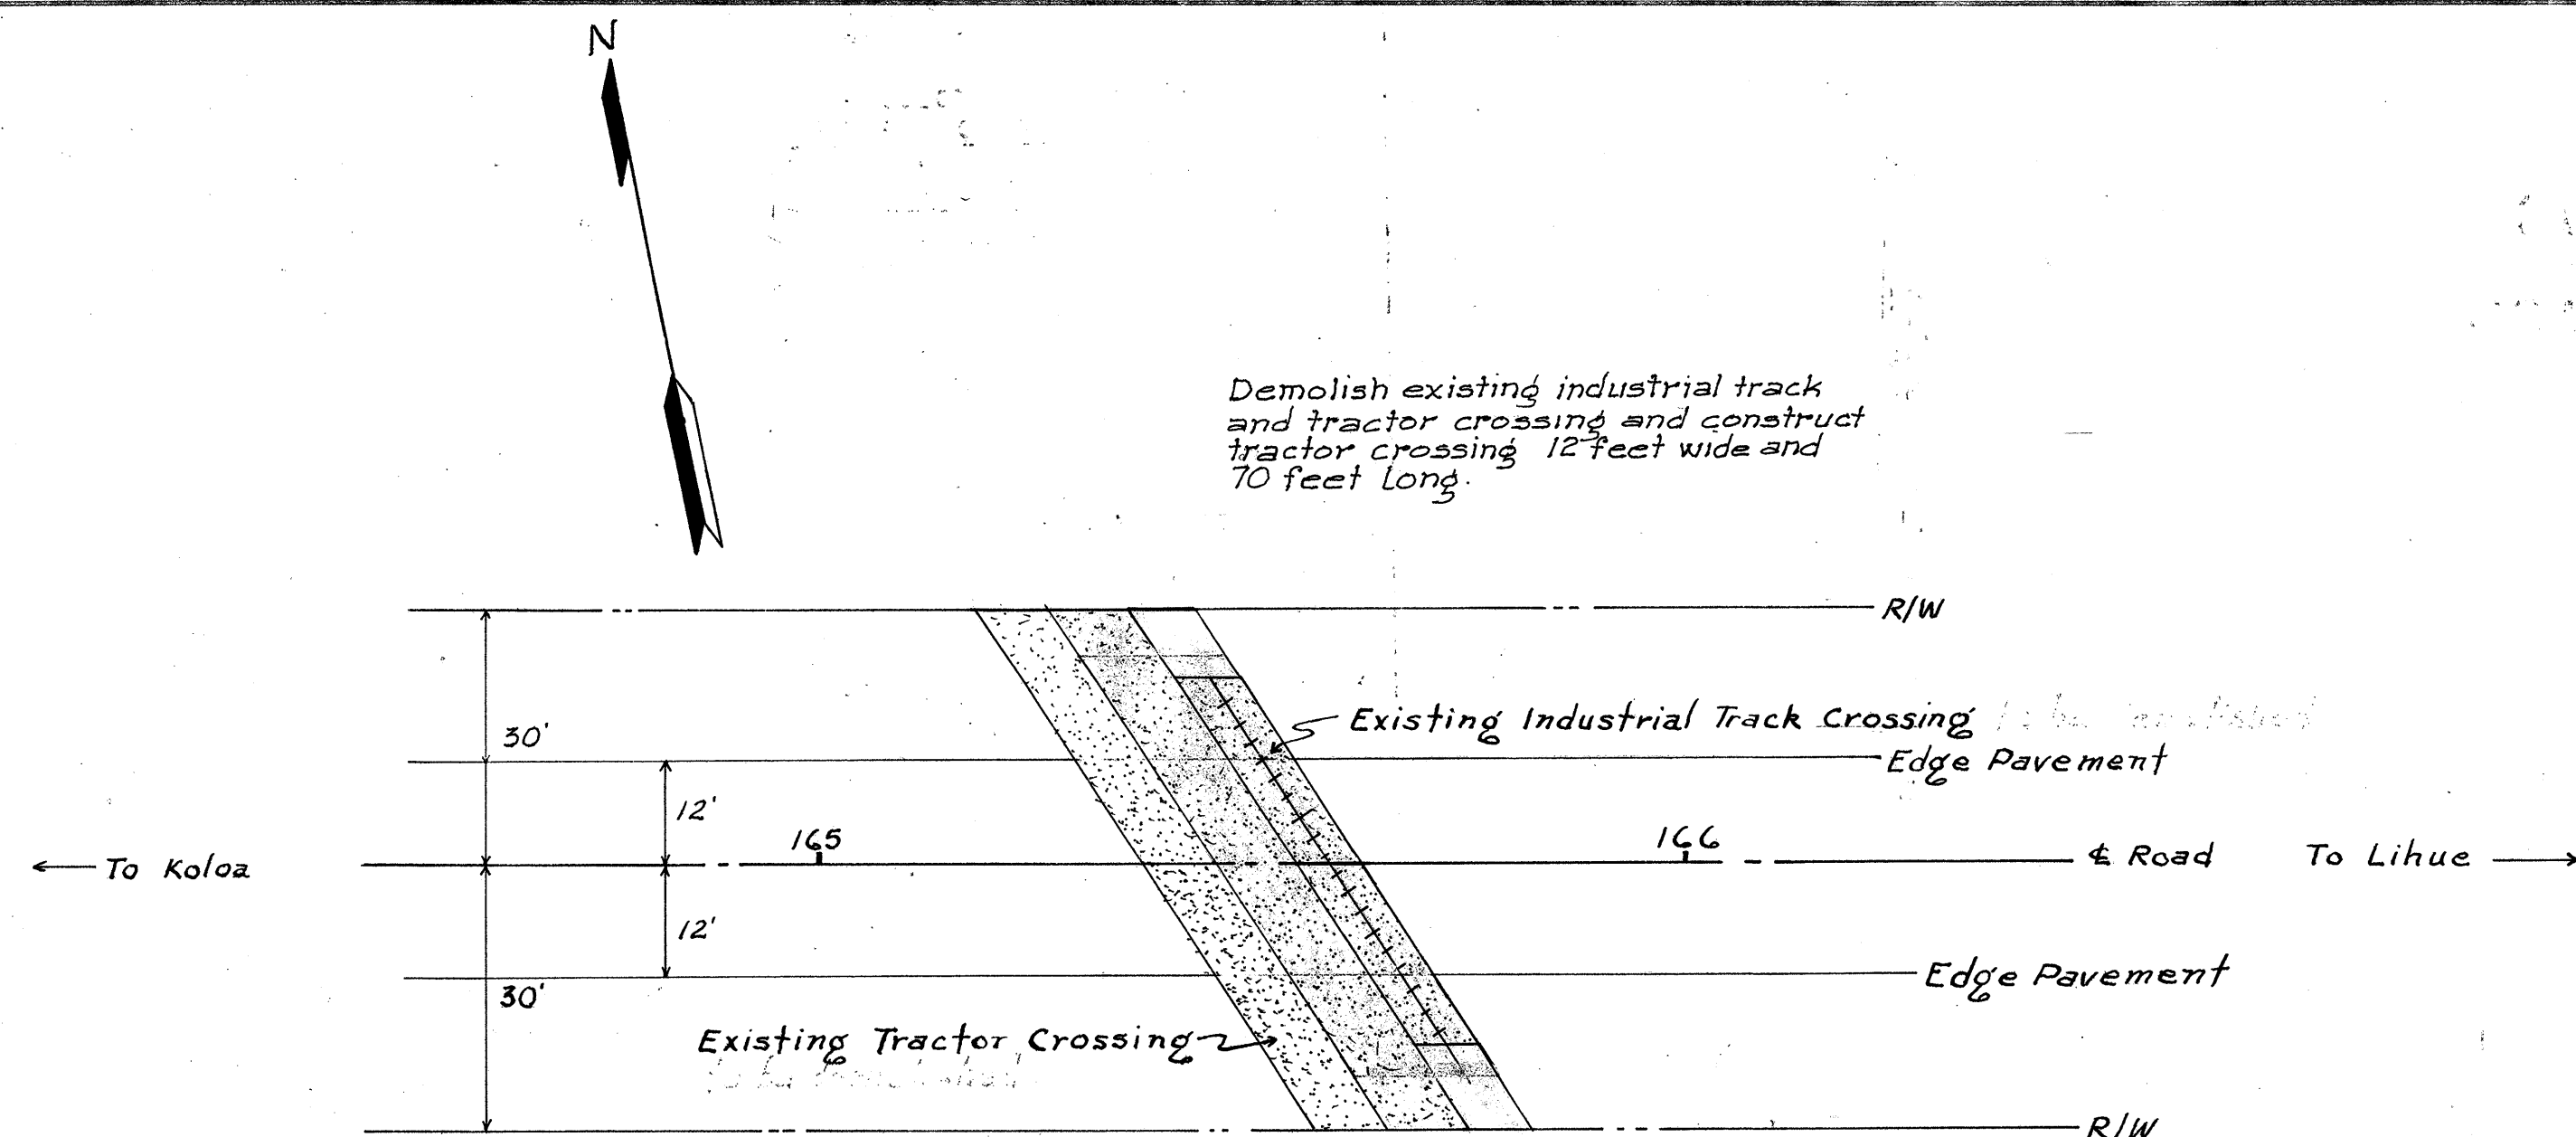



TRACTOR CROSSING AT STA 165+57±  
(PROJ. No. F 12 (17))  
Scale: 1"=20'

Note:  
Tractor crossing located at intersection  
of Kaunualii Highway and Grove Farm Company's  
tunnel road.

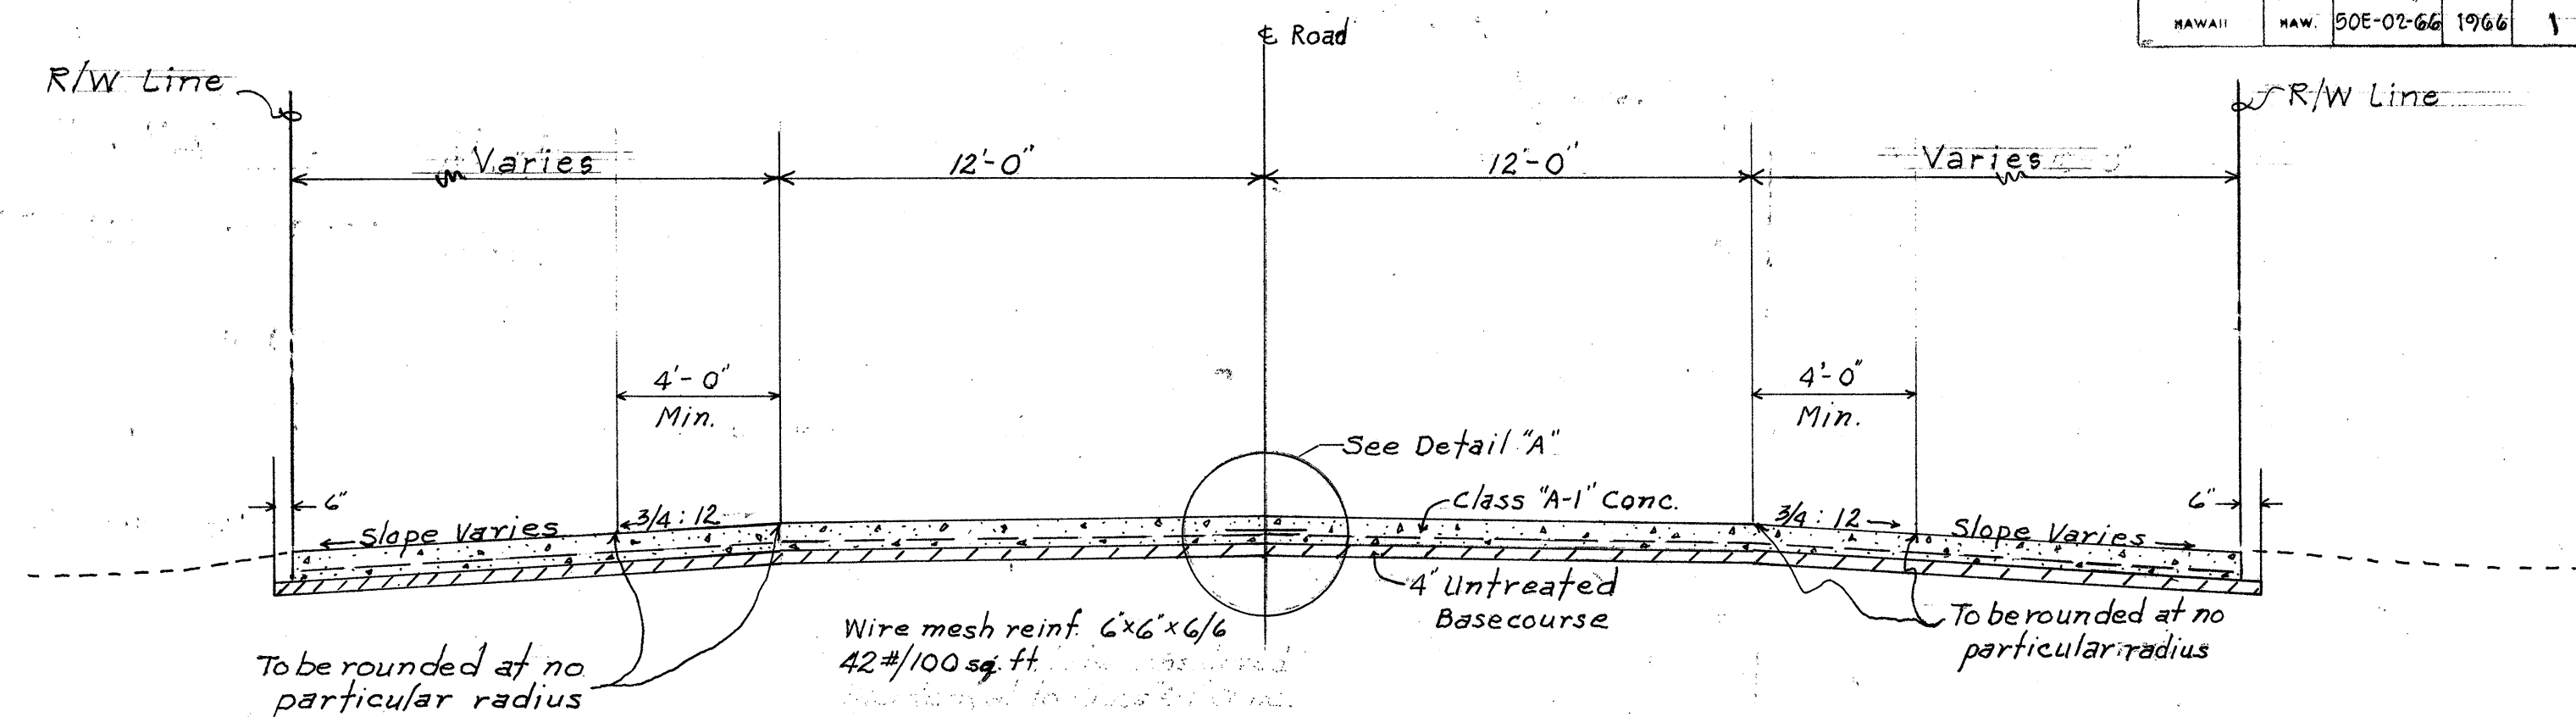

- NOTE:
1. Tractor crossing shall conform to pavement grade and crown.
  2. Excavation and dowels for Tractor Crossing shall be considered incidental to Class 'A-1' Concrete.
  3. Sprinkling to be considered incidental to Untreated Base Course.
  4. Traffic shall not be allowed on the tractor crossing until the concrete has developed a modulus of rupture of 450 psi, but not less than seven (7) days after the concrete has been placed.
  5. Tractors shall not be allowed on the tractor crossing until twenty eight (28) days after the concrete has been placed.
  6. Contractor shall make provisions for traffic to pass through the work area at all times.

TRACTOR CROSSING  
Scale: 1/4" = 1'-0"

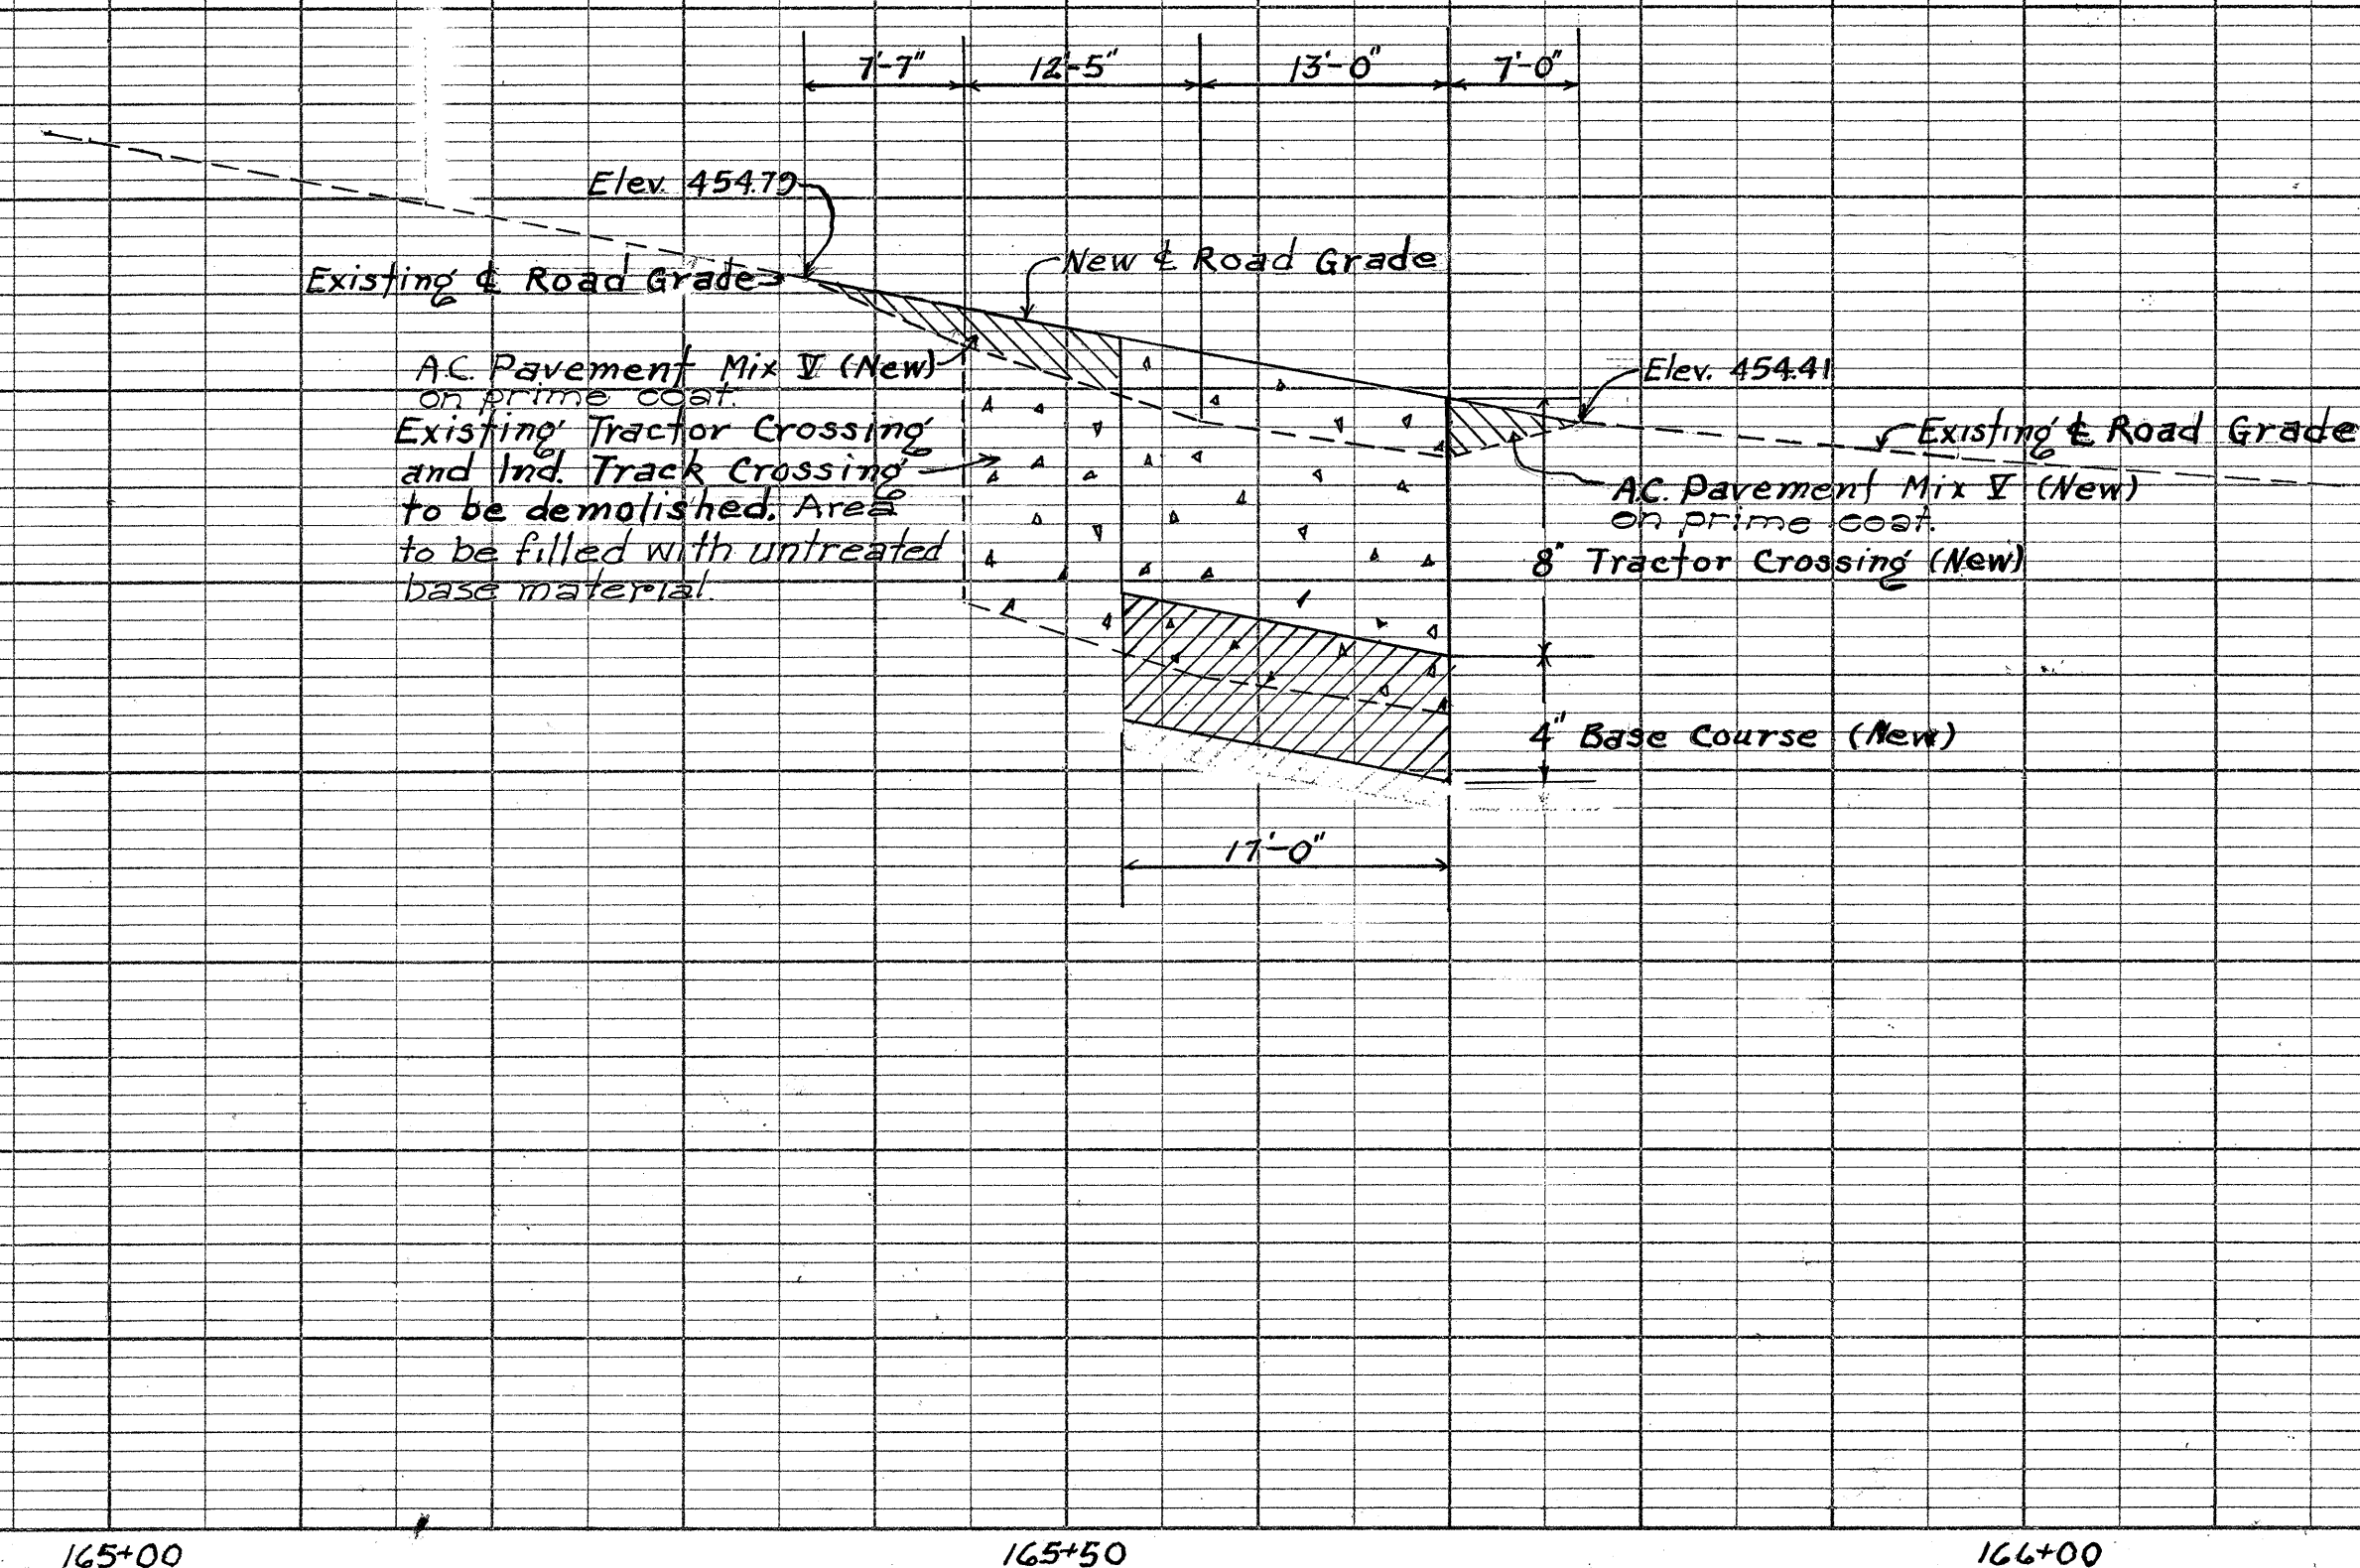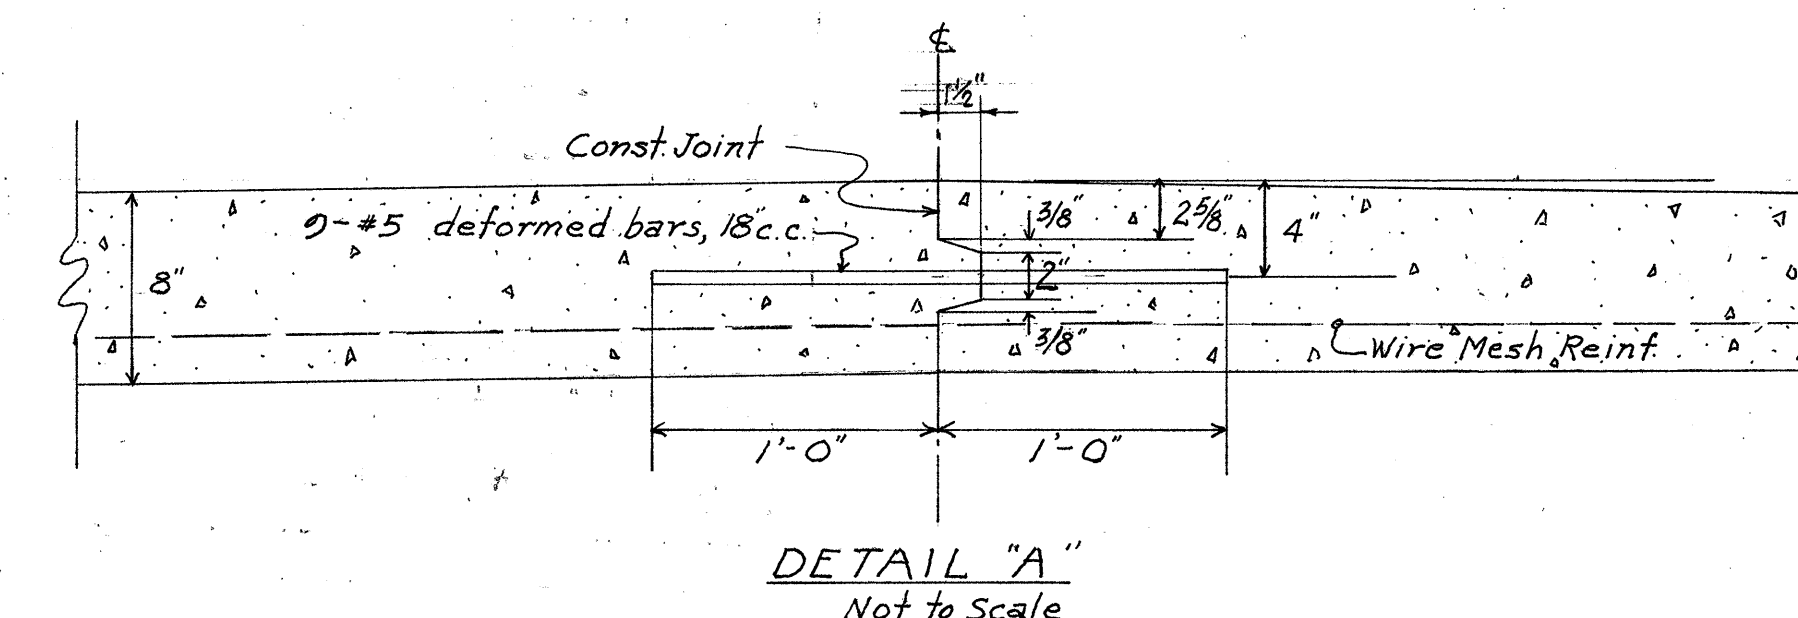

NO AS-BUILT CHANGES MADE  
DURING CONSTRUCTION.

PROJECT ENGINEER DATE

APPROVED DATE 10-20-66

John M. Lee  
DIRECTOR OF TRANSPORTATION

STATE OF HAWAII  
DEPARTMENT OF TRANSPORTATION  
HIGHWAYS DIVISION

DEMOLISHING AND RECONSTRUCTING  
TRACTOR CROSSING ON  
KAUNUALII HIGHWAY  
PROJ. NO. 50E-02-66

Scale: As Noted August, 1966