




FED. ROAD DIST. No.	STATE	FED. AID PROJ. No.	FISCAL YEAR	SHEET No.	TOTAL SHEETS
HAWAII	HAW.	50D-02-67	1967	7	11

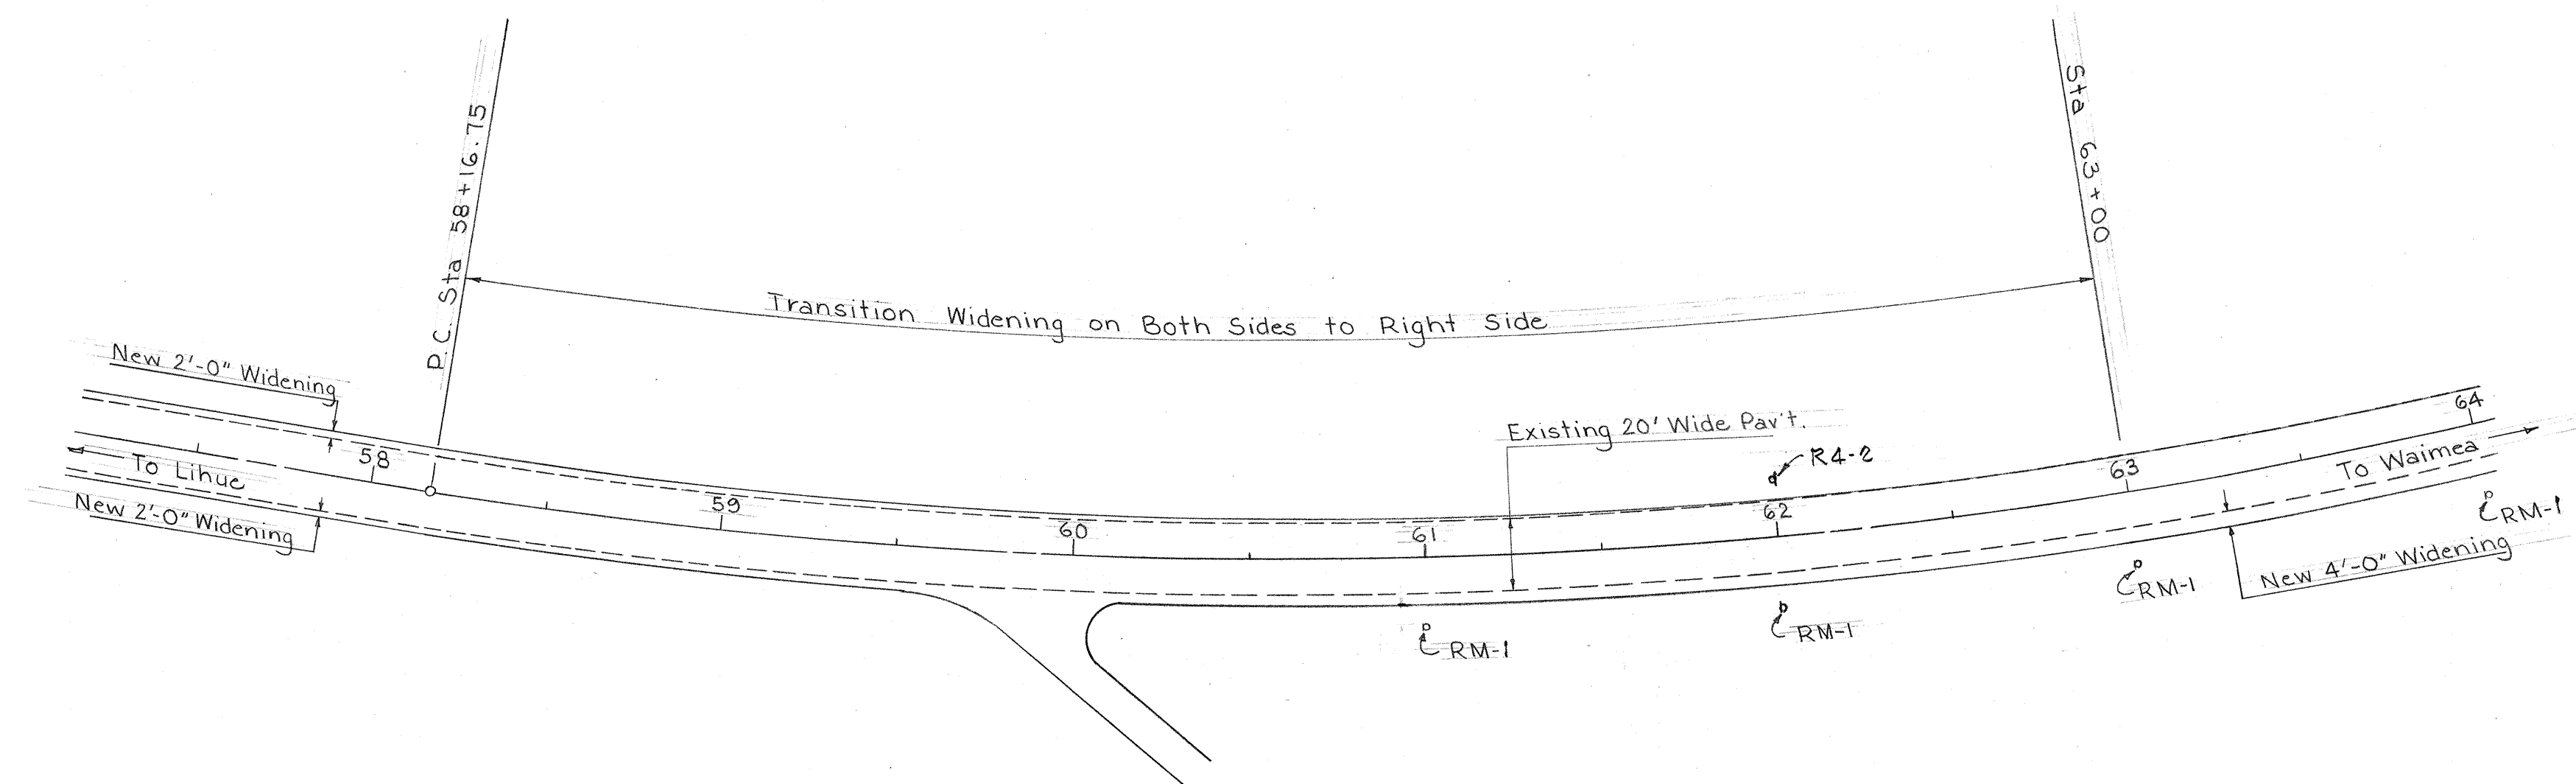



PLAN OF TRANSITION
STA 58+16.75 to STA 63+00
Scale: 1" = 40'-0"

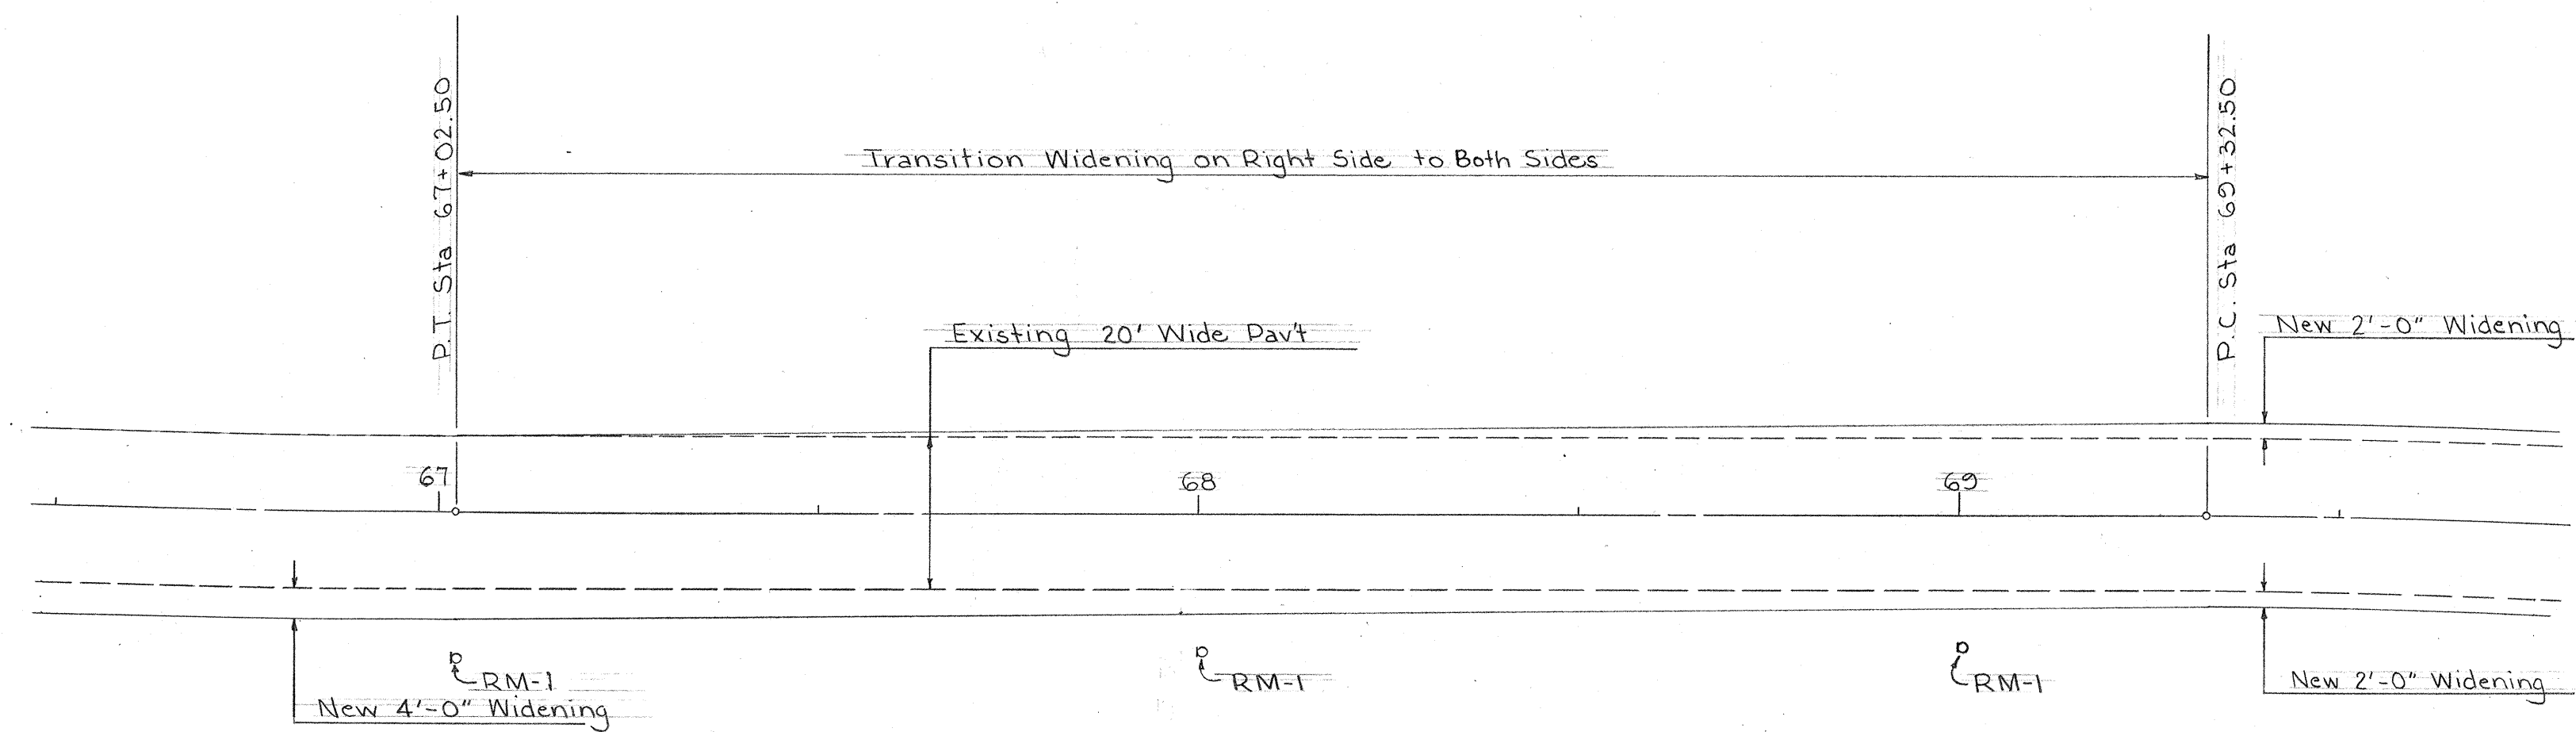

PLAN OF TRANSITION
STA 67+02.50 to STA 69+32.50
Scale: 1" = 20'-0"

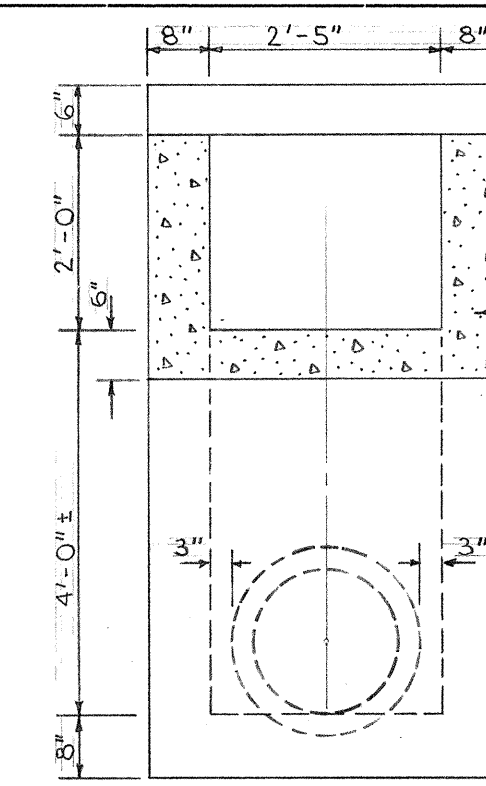

SECTION A-A

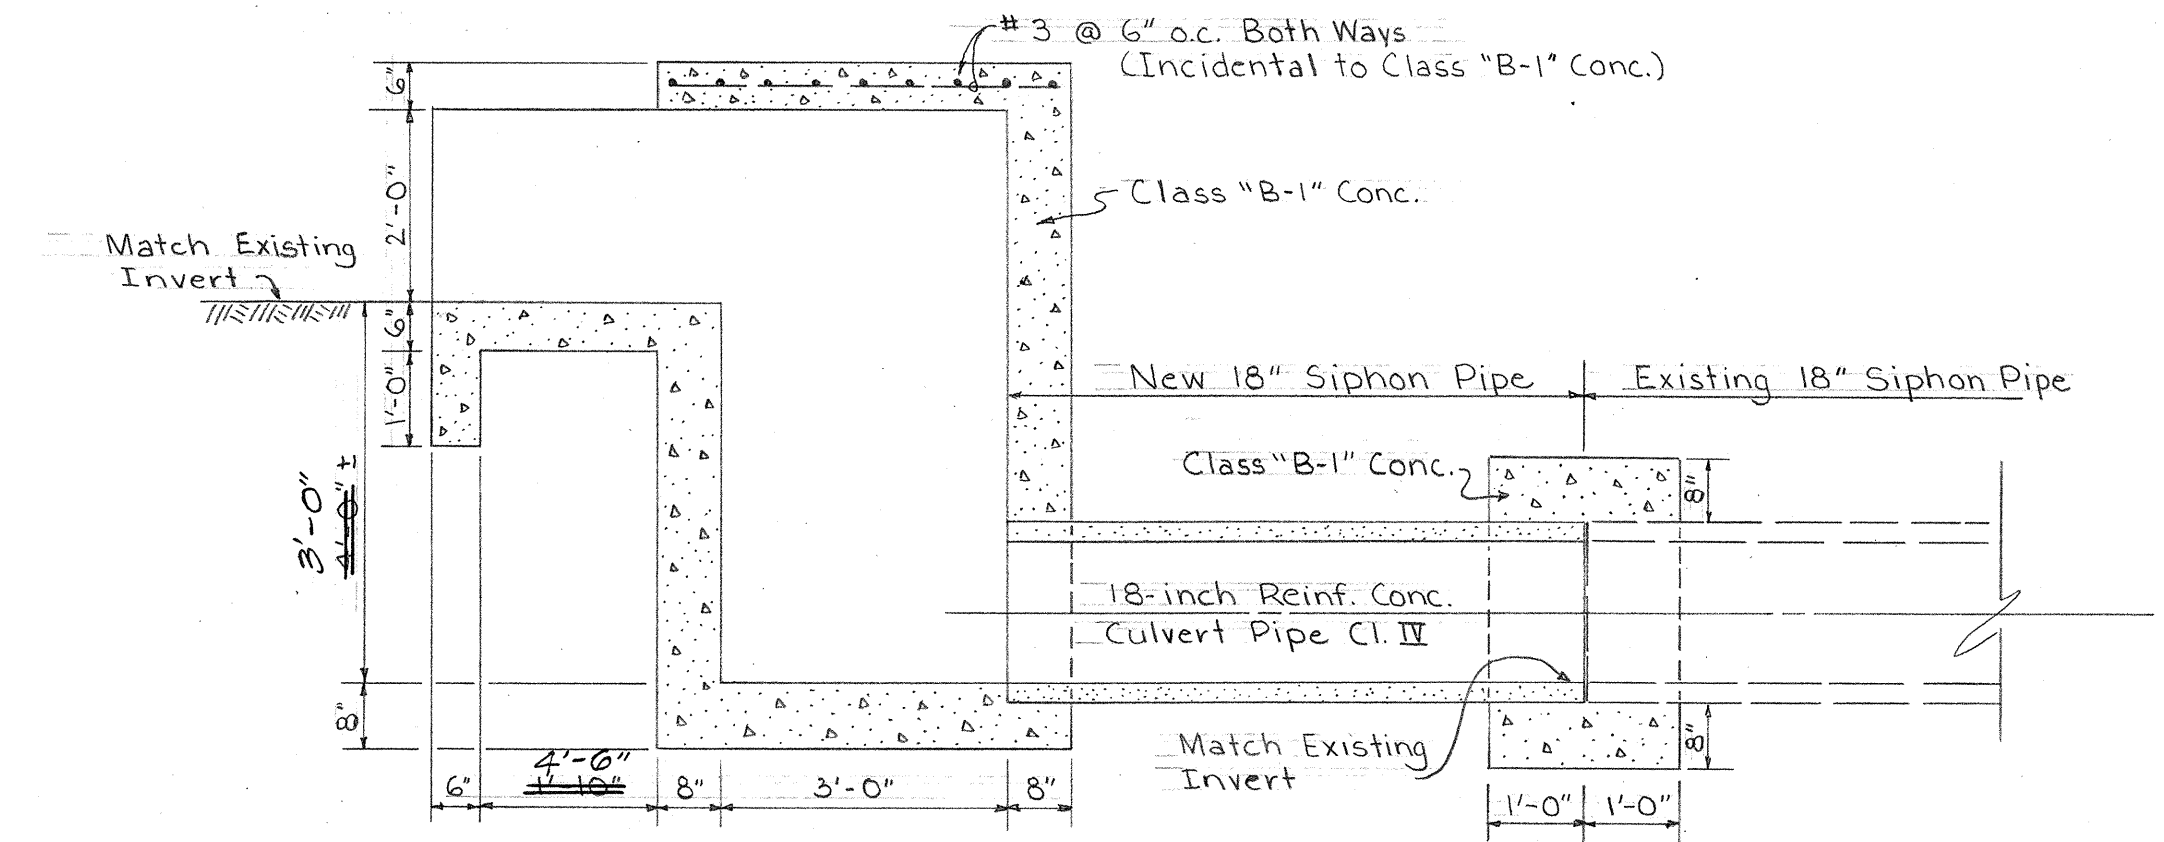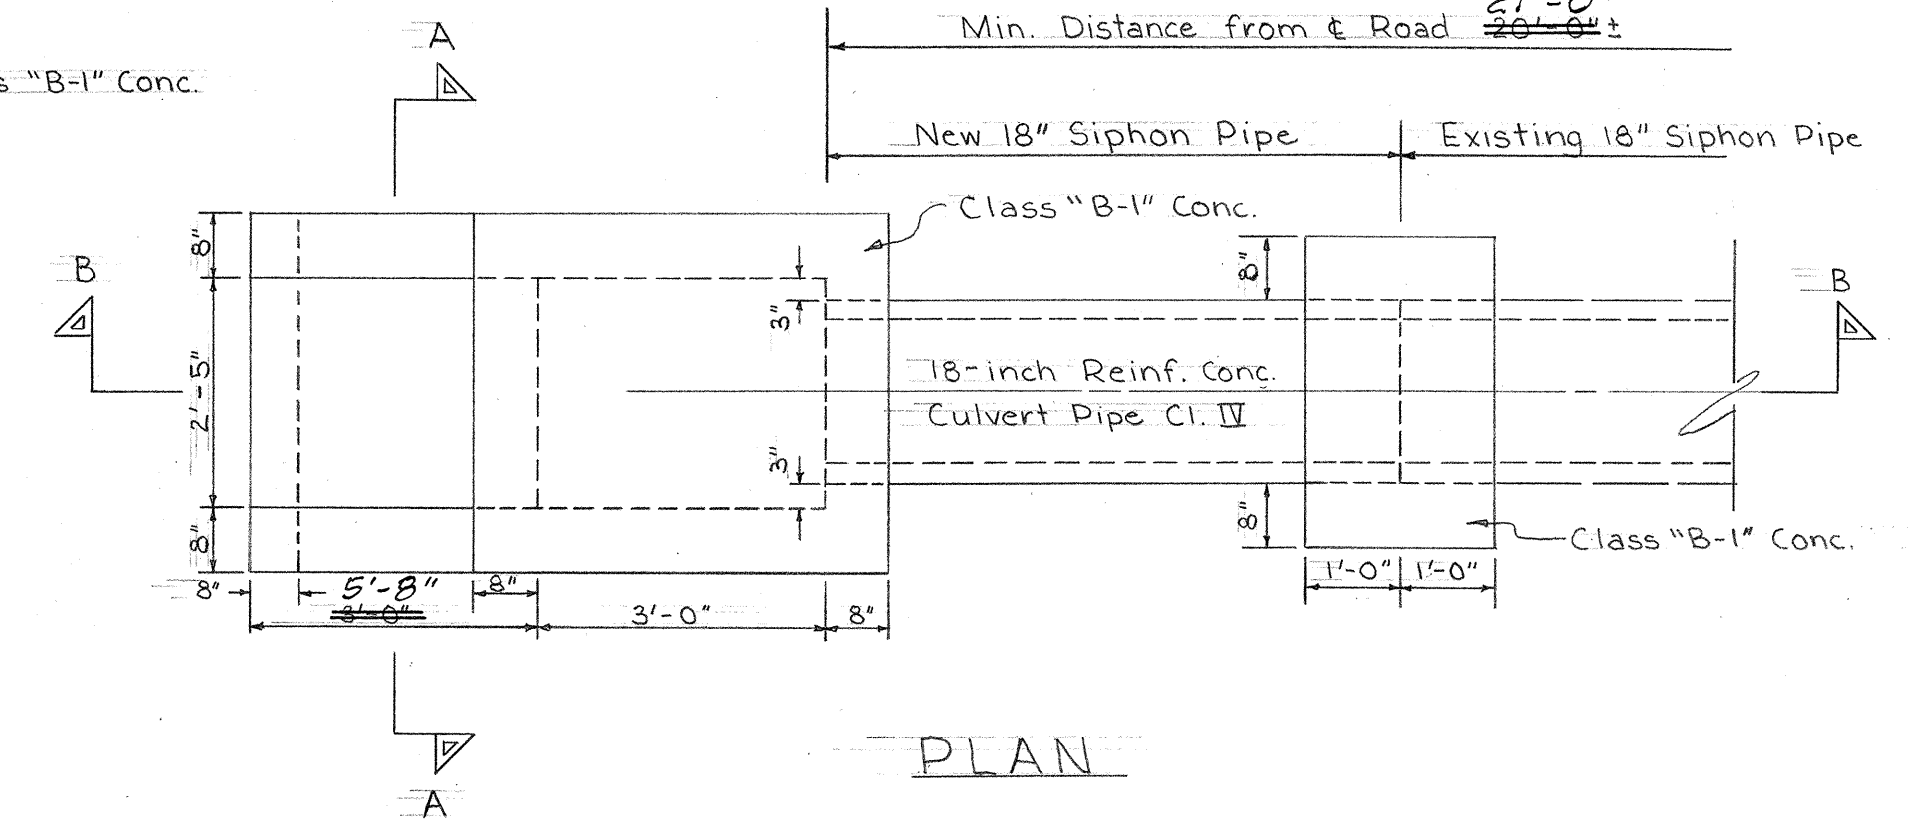

SECTION B-B

DETAILS FOR 18-INCH SIPHON EXTENSION STA 34+00
Scale: 1/2" = 1'-0"

DEPARTMENT OF TRANSPORTATION
HIGHWAYS DIVISION
STATE OF HAWAII
MISCELLANEOUS DETAILS
KAUAI BELT ROAD
PROJ. NO. 50D-02-67
SCALE: AS SHOWN DATE: JAN. 1967

SHEET NO. 7 OF 11 SHEETS