INDI	EX TO DRAWINGS
SHEET NO.	DESCRIPTION
	TITLE SHEET
2	TYPICAL SECTIONS
3 - 6	PLAN AND PROFILE
7	MISCELLANEOUS DETAILS
8 - 11	STANDARD DETAILS

DEPARTMENT OF TRANSPORTATION
HIGHWAYS DIVISION

"AS BUILT" PLANS FOR

RESURFACING AND WIDENING OF A PORTION OF

KAUAI BELT ROAD

KALAHEO TO WAHIAWA

PROJECT NO. 50D-02-67

DISTRICT OF KOLOA

ISLAND OF KAUAI

SCALES

PLAN PROFILE I INCH = IOO FT. HOR. I INCH = IOO FT. VER. I INCH = 20 FT.

CONVENTIONAL SIGNS

Baseline

Boundary Line
Fences (Named)

Existing Roadway

Pipe Culvert


Box Culvert

Telephone Line & Pole


Electric Line & Pole

Water Main (Size as shown)

D-9-7

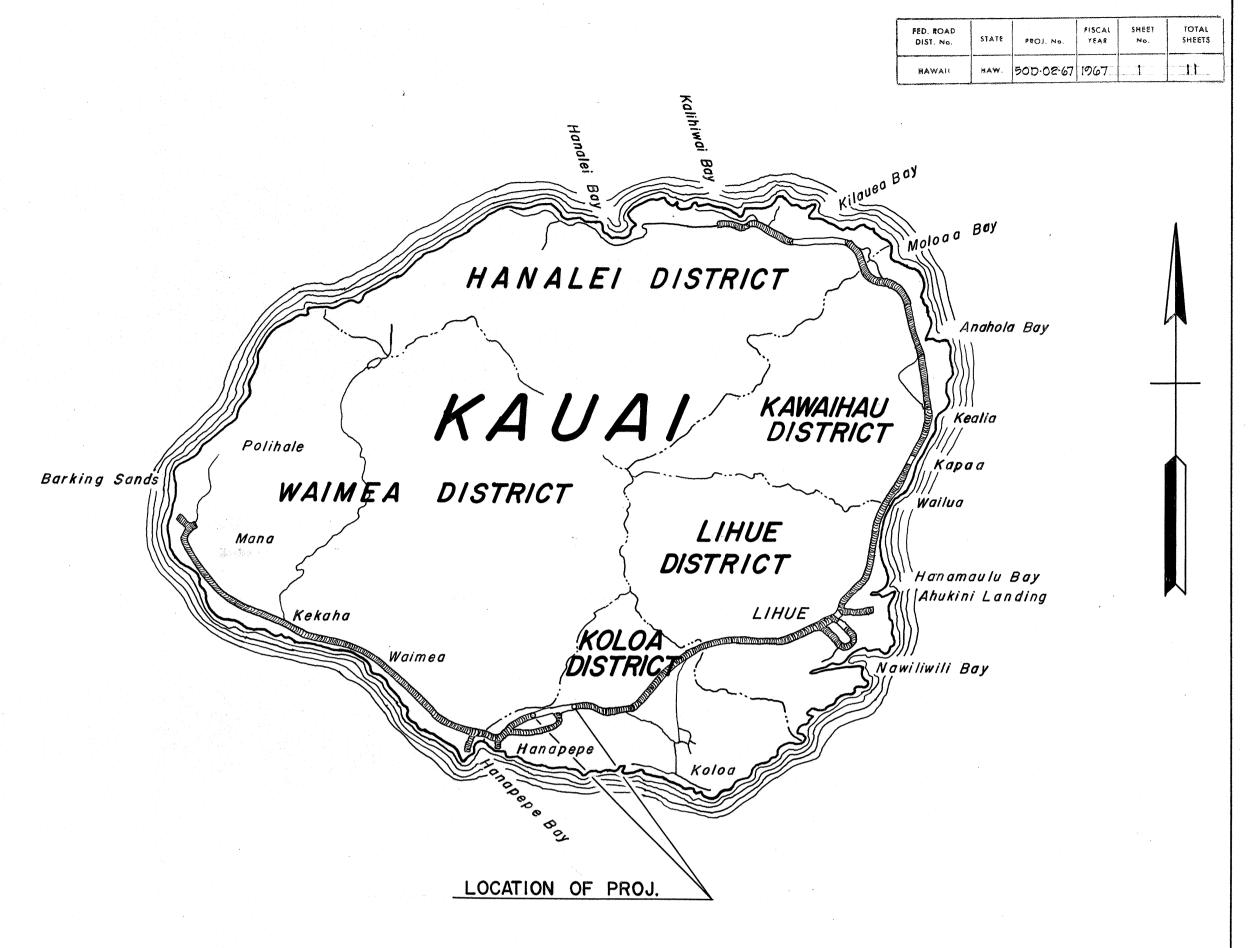

FEDERAL AID PROJECTS PREVIOUSLY CONSTRUCTED OR UNDER CONSTRUCTION

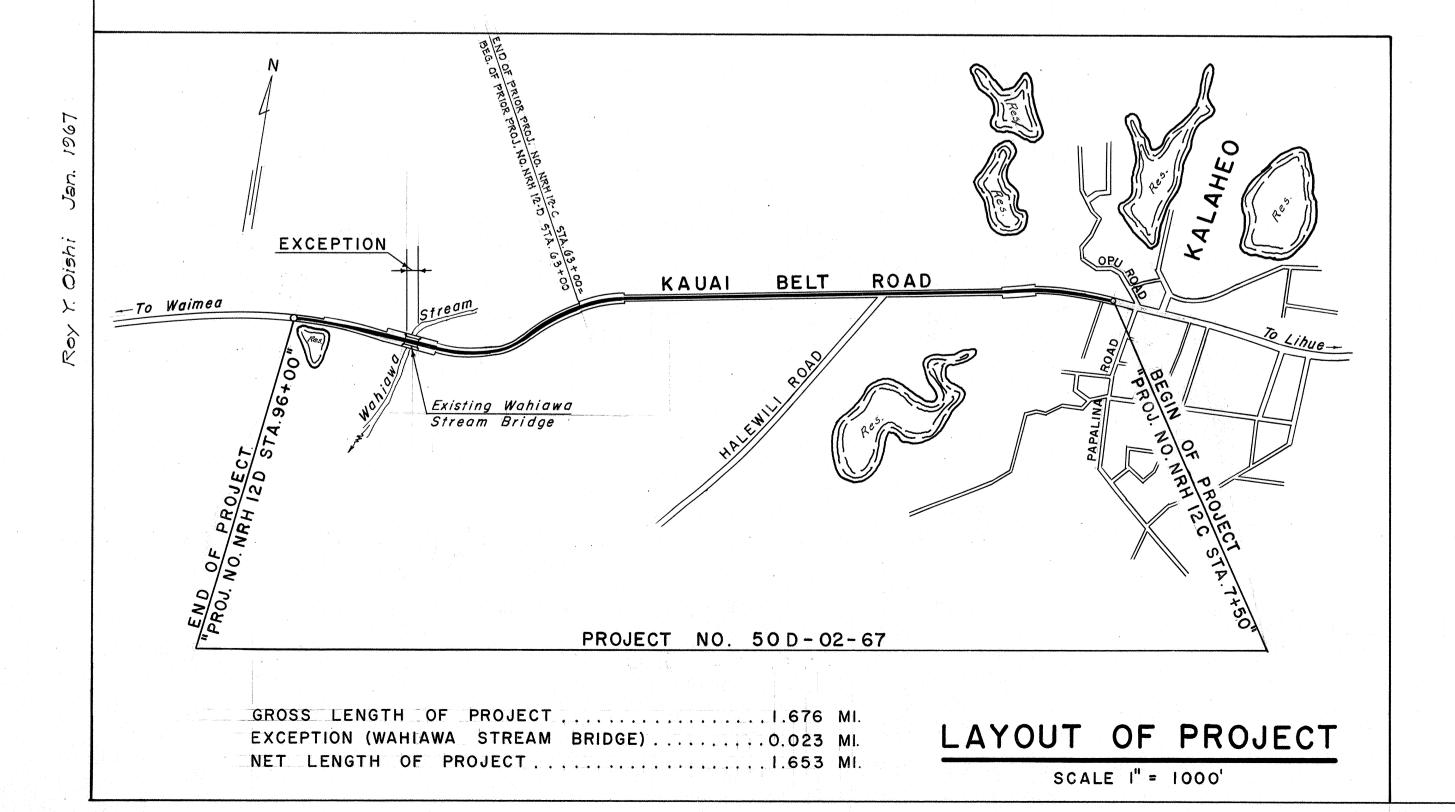

NOTE:

ALL CHANGES MADE DURING CONSTRUCTION HAVE BEEN NOTED IN RED ON THESE TRACINGS AND CHECKED BY:

PROJECT ENGINEER
May 31 1968

May 31, 1968
DATE

APPROVED: DATE Y-78-67....

Blue Man Man Director OF TRANSPORTATION

·