



[illegible]

LOCATION OF PROJECT

DIST. NO.	STATE	PROJ. NO.	FISCAL YEAR	SHEET NO.	TOTAL SHEETS
HAWAII	HAW.	50E-03-68	1967	1	4

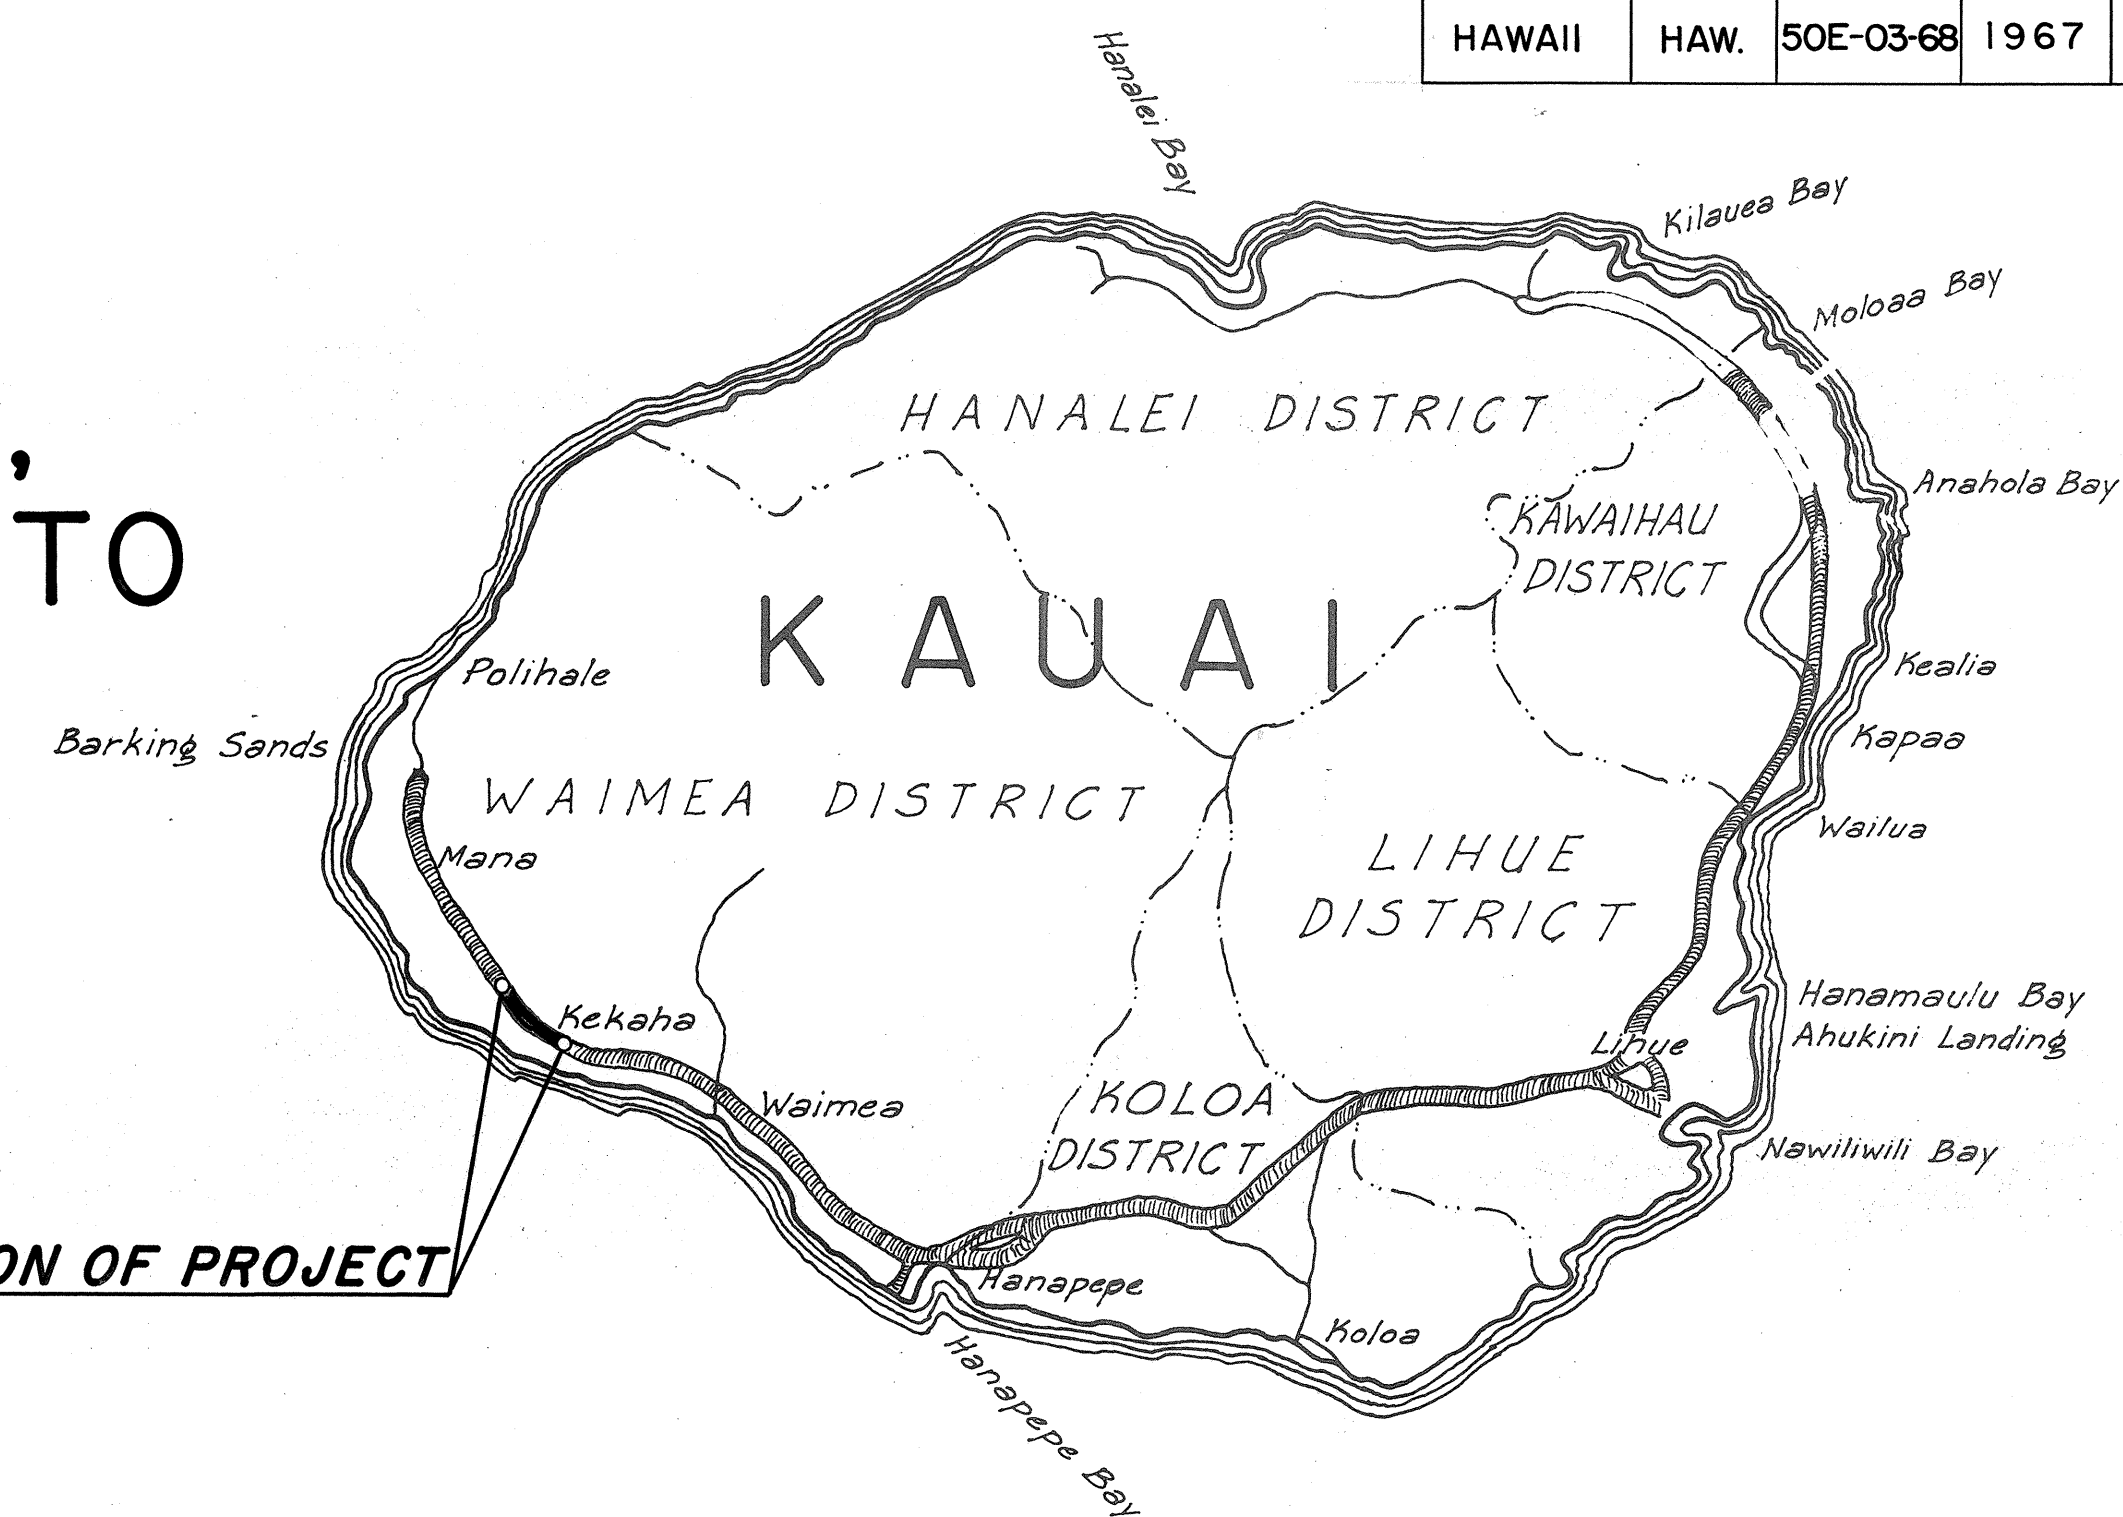

FEDERAL AID PROJECTS PREVIOUSLY CONSTRUCTED OR UNDER CONSTRUCTION

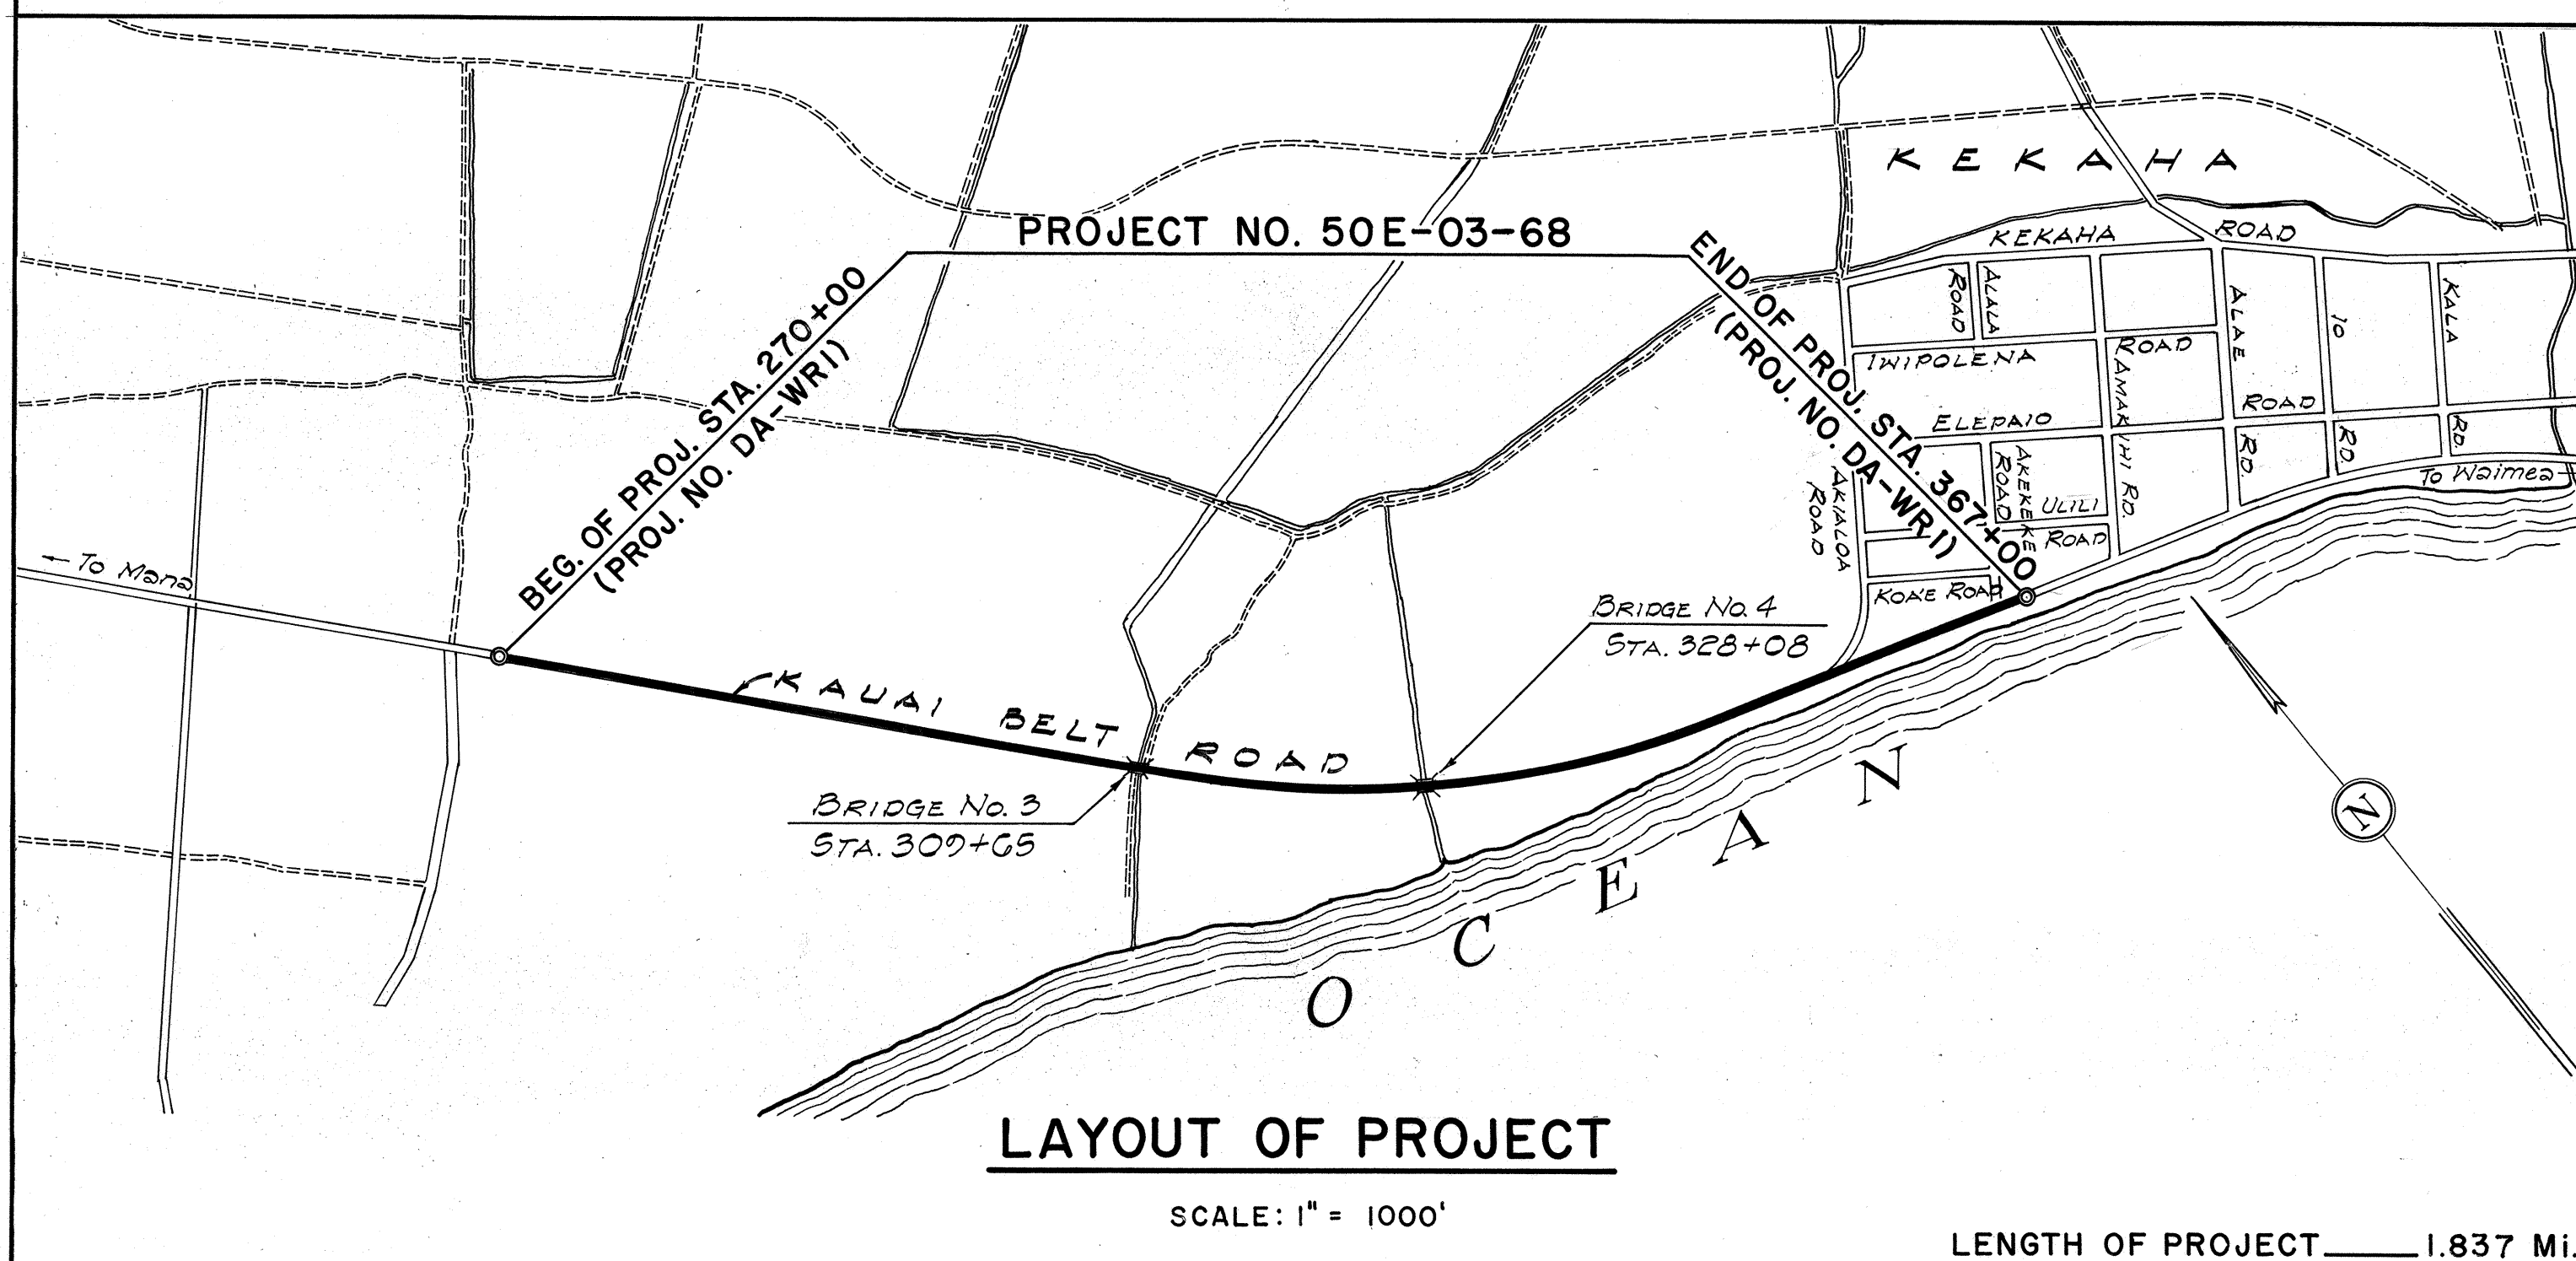

APPROVED:

DATE - 11/1/67

John H. McQuinn
 For DIRECTOR OF TRANSPORTATION