

INDEX TO DRAWINGS	
SHEET NO.	DESCRIPTION
1	TITLE SHEET
2	REVAMP CHANNEL SECT. AAKUKUI BRIDGE

STATE OF HAWAII

DEPARTMENT OF TRANSPORTATION

HIGHWAYS DIVISION

HONOLULU, HAWAII

PLANS TO


REVAMP CHANNEL SECTION OF AAKUKUI BRIDGE

PROJECT No. 50B-02-68

DISTRICT OF WAIMEA

ISLAND OF KAUAI

FED. ROAD DIST. NO.	STATE	PROJ. NO.	FISCAL YEAR	SHEET NO.	TOTAL SHEETS
HAWAII	HAW.	50B-02-68	1967	1	2

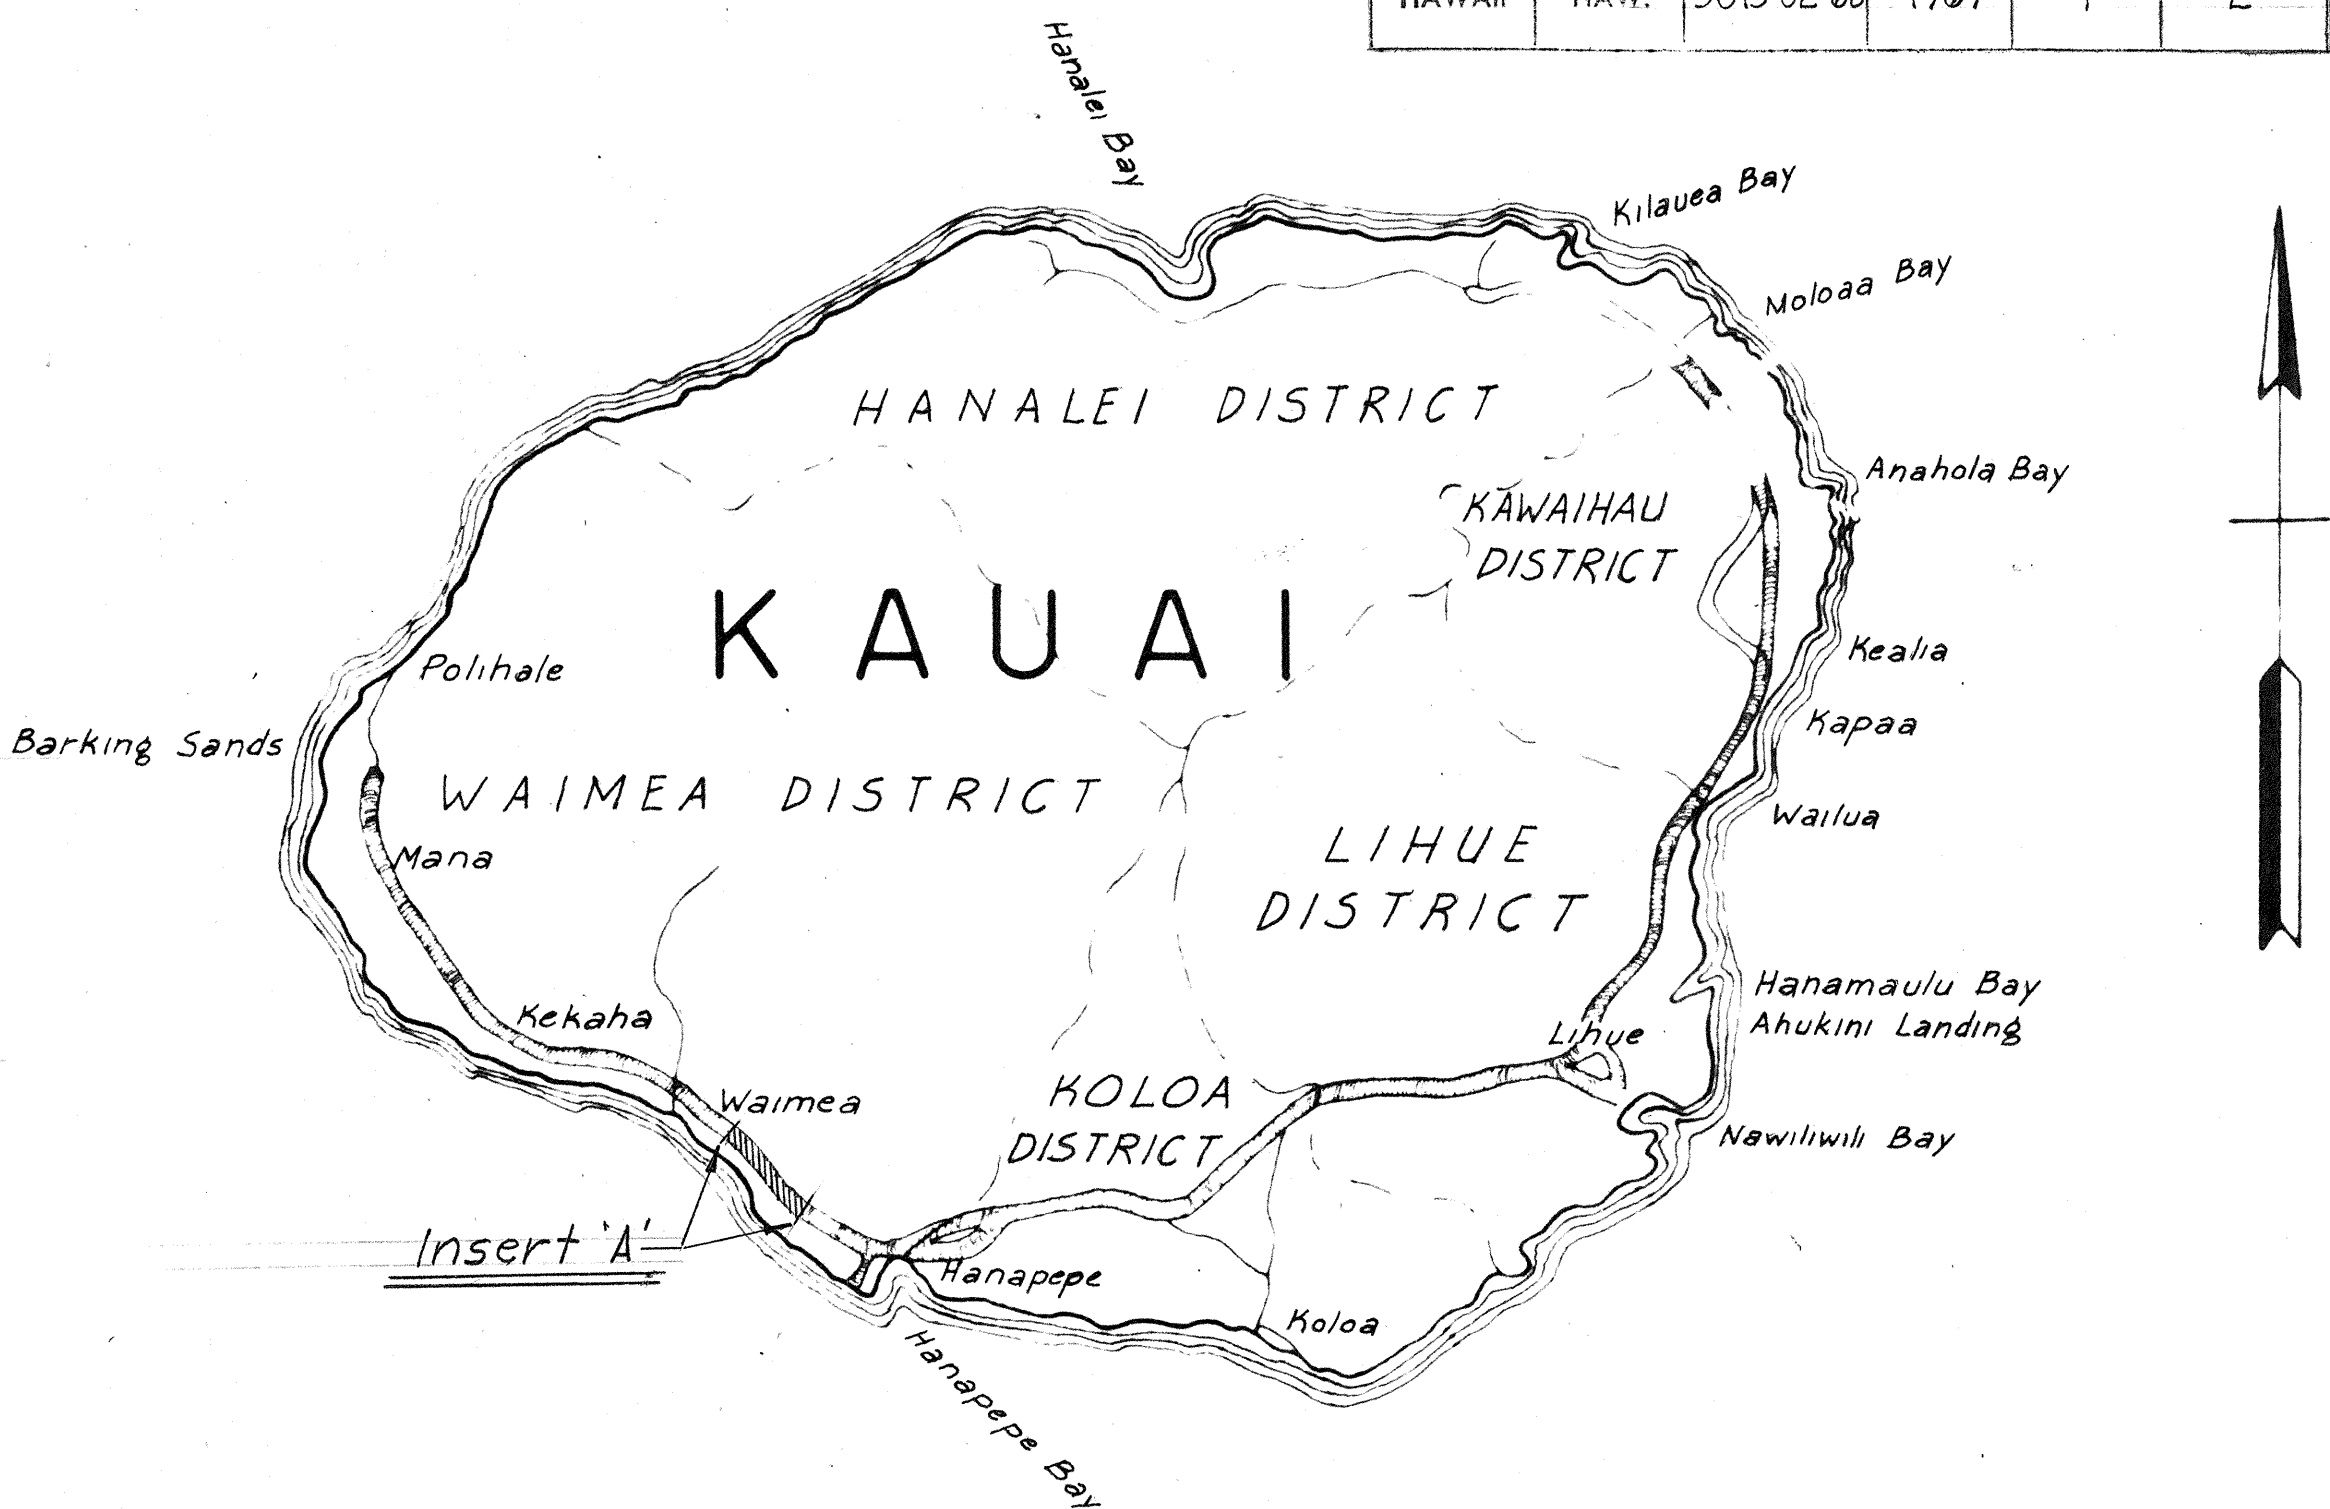

FEDERAL AID PROJECTS PREVIOUSLY CONSTRUCTED OR UNDER CONSTRUCTION

BEGINNING-PROJ. NO. F 29 (4) Sta. 38+67.44


FAP 29-A(1) Sta. 38+32.22

Station 200+54.04

BEGINNING OF FAP 29-B(1) Station 0+00

END OF PROJ. NO. F 29 (4)

Sta. 27+20

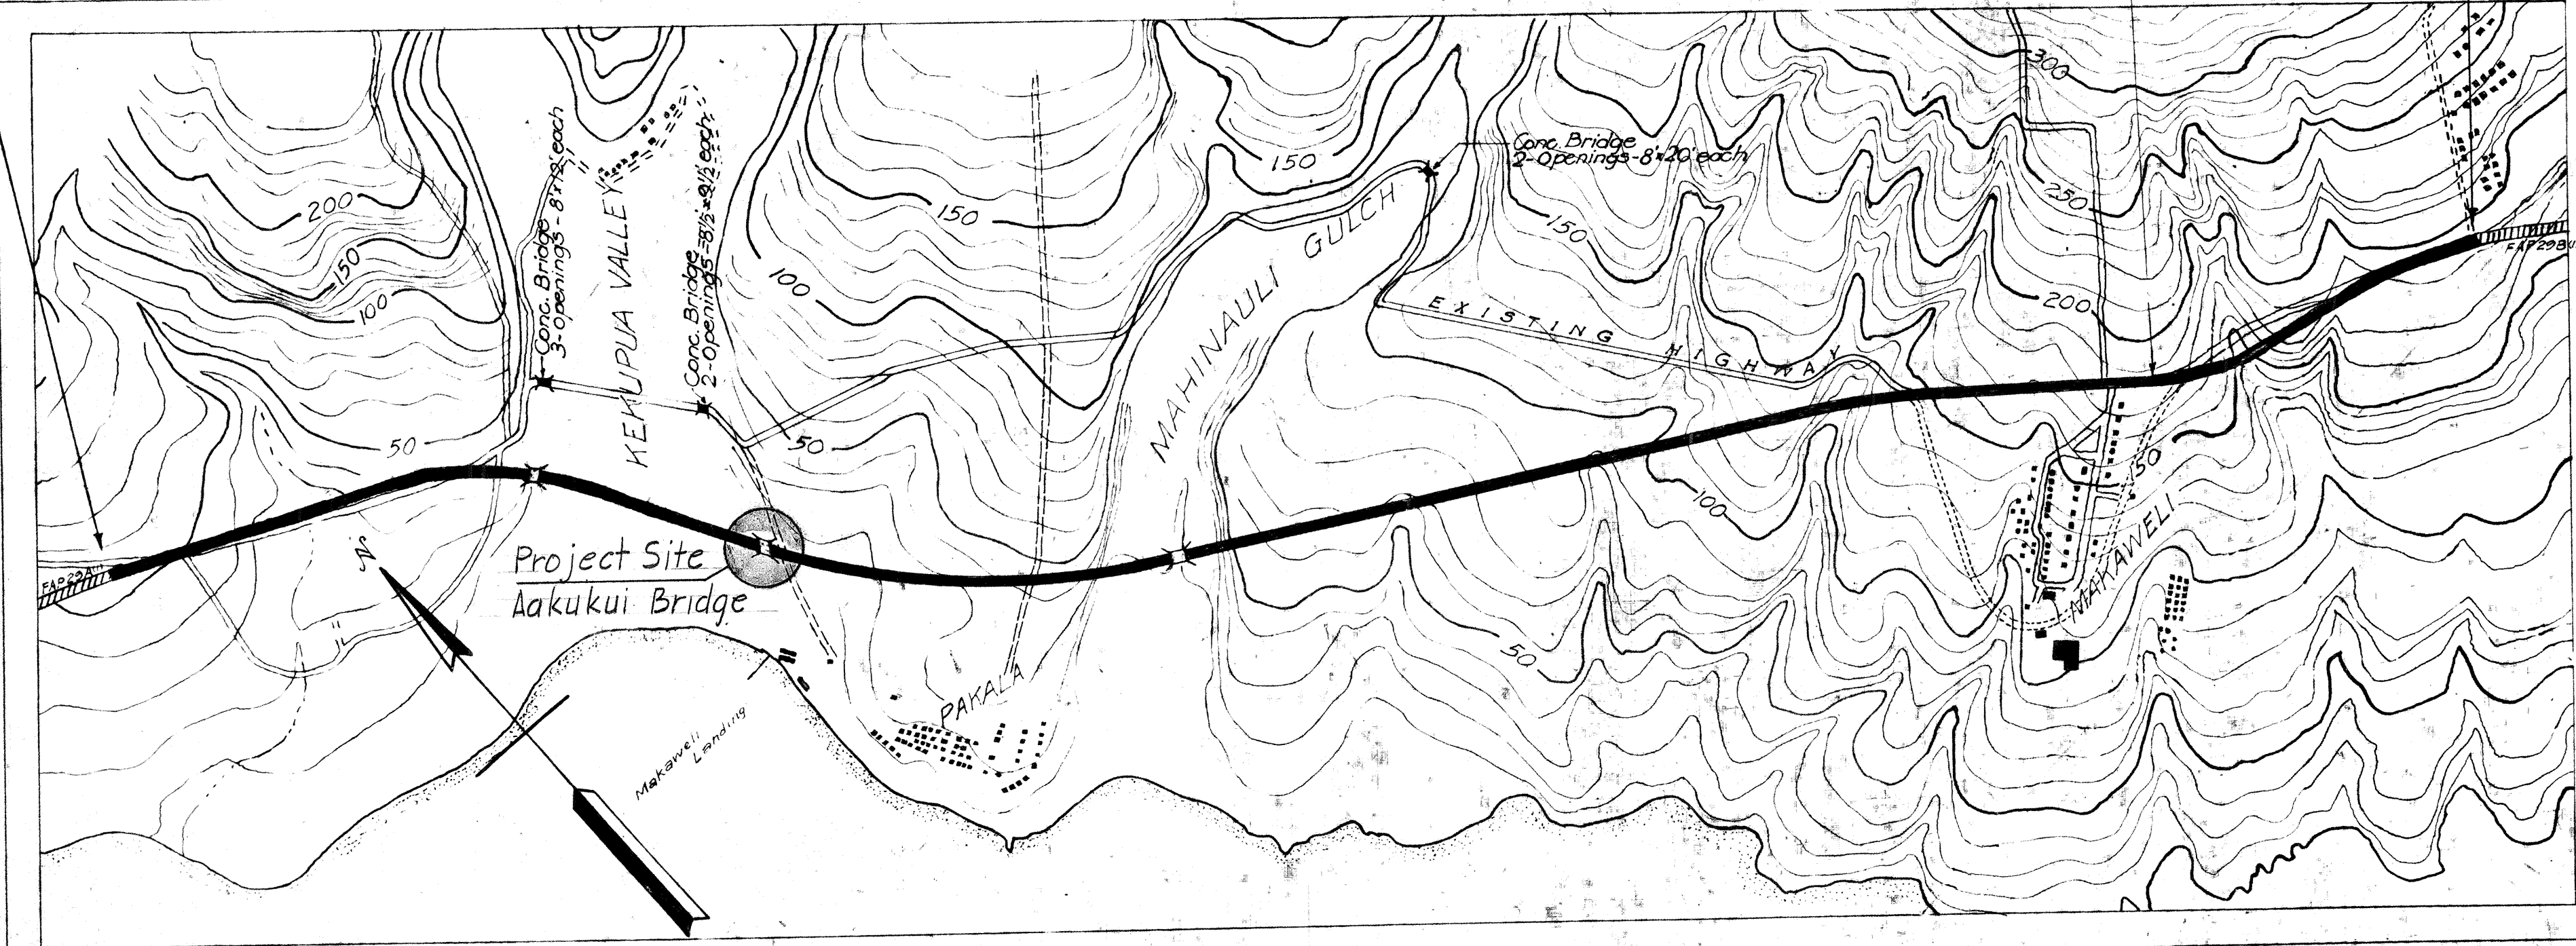

NO AS-BUILT CHANGES MADE

DURING CONSTRUCTION.

Donald Nagamine 8-11-81

PROJECT ENGINEER DATE

APPROVED: Date

[Signature]

DIRECTOR OF TRANSPORTATION

INSERT 'A'

SCALE: 1" = 1000'

DESIGNED BY: A. MARUTANI

DATE: Nov 67

PLANNED BY: A. MARUTANI

DATE: Nov 67

NOTES: BY: A. MARUTANI

DATE: Nov 67

CHECKED BY: A. MARUTANI

DATE: Nov 67