

INDEX TO DRAWINGS	
SHEET NO.	DESCRIPTION
1	TITLE SHEET
2	TYPICAL SECTION
3	STANDARD DETAILS

STATE OF HAWAII

DEPARTMENT OF TRANSPORTATION

HIGHWAYS DIVISION

"AS-BUILT" PLANS FOR

RESURFACING KAUAI BELT ROAD


KEKAHA TO MANA

(STA. 89+00 TO STA. 261+90, PROJ. NO. DA-WRI)

PROJECT NO. 50A-01-69

DISTRICT OF WAIMEA

ISLAND OF KAUAI

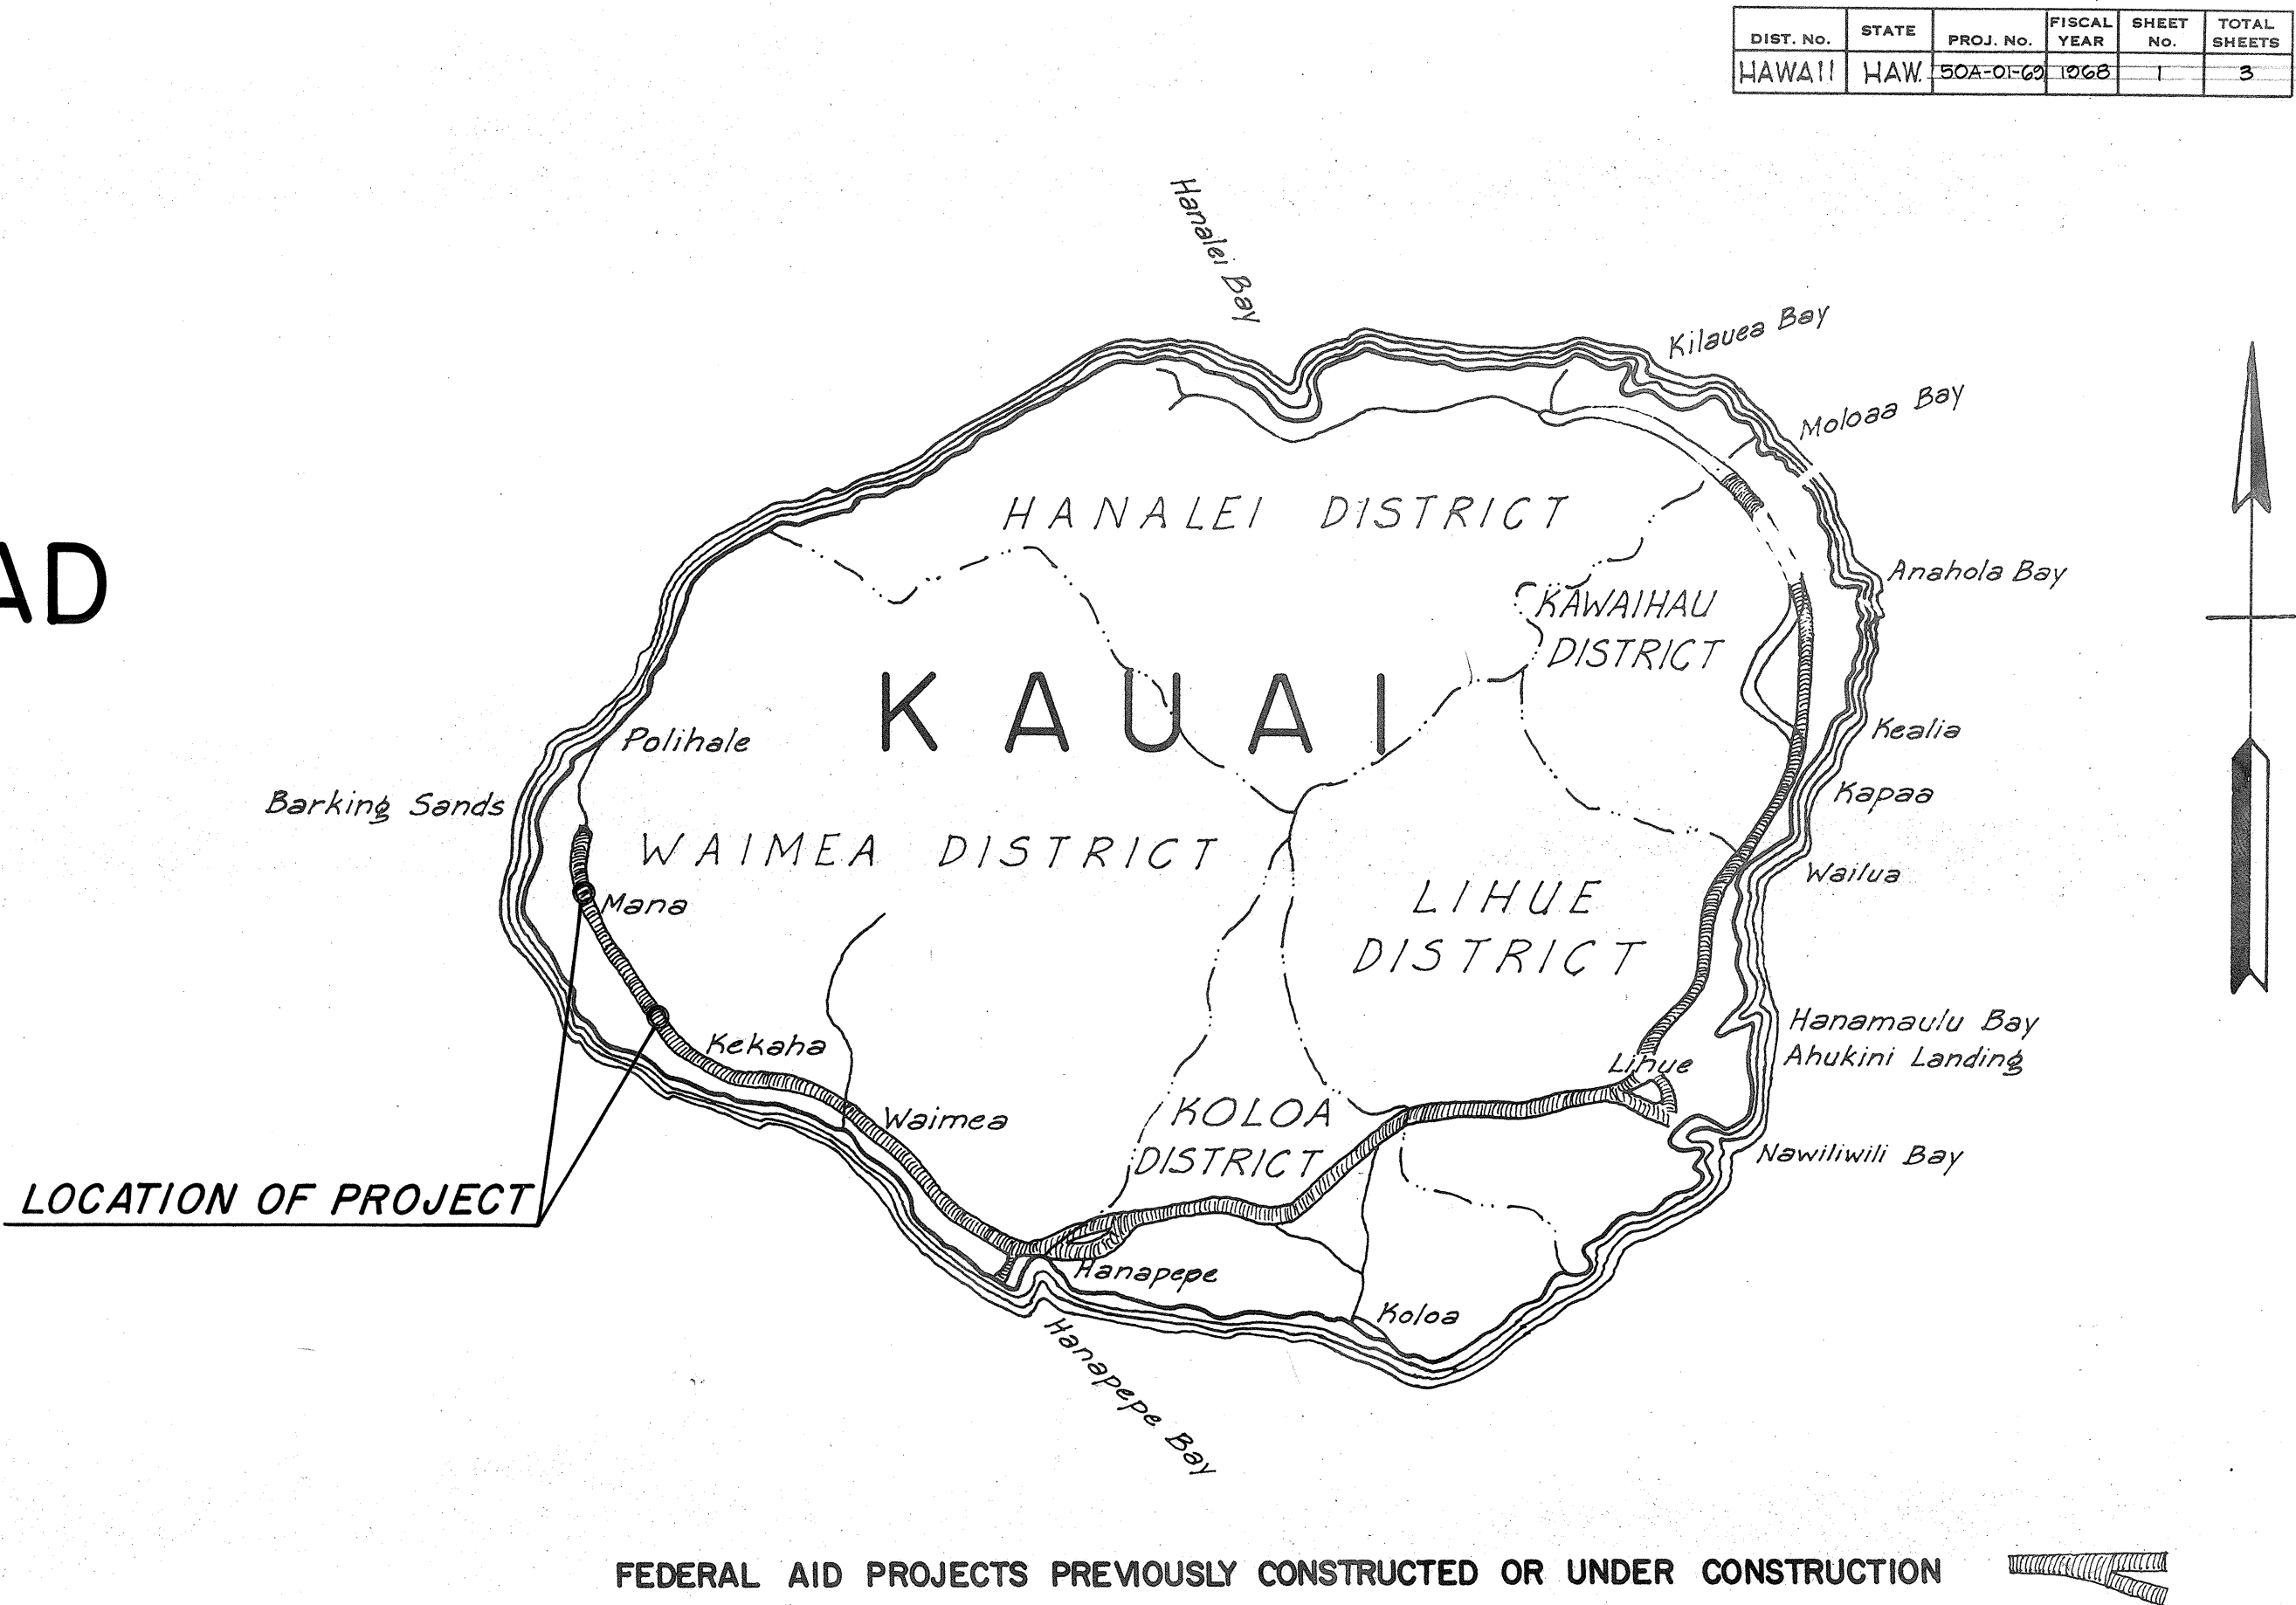


NO CHANGES WERE MADE DURING CONSTRUCTION ON THESE PLANS EXCEPT CHANGES IN THE ORIGINAL THEORETICAL QUANTITIES. FOR ACTUAL QUANTITIES, REFER TO PROJECT LEDGER AND/OR COMPUTATION BOOK.

[Signature]

RESIDENT ENGINEER

July 13, 1981

DATE

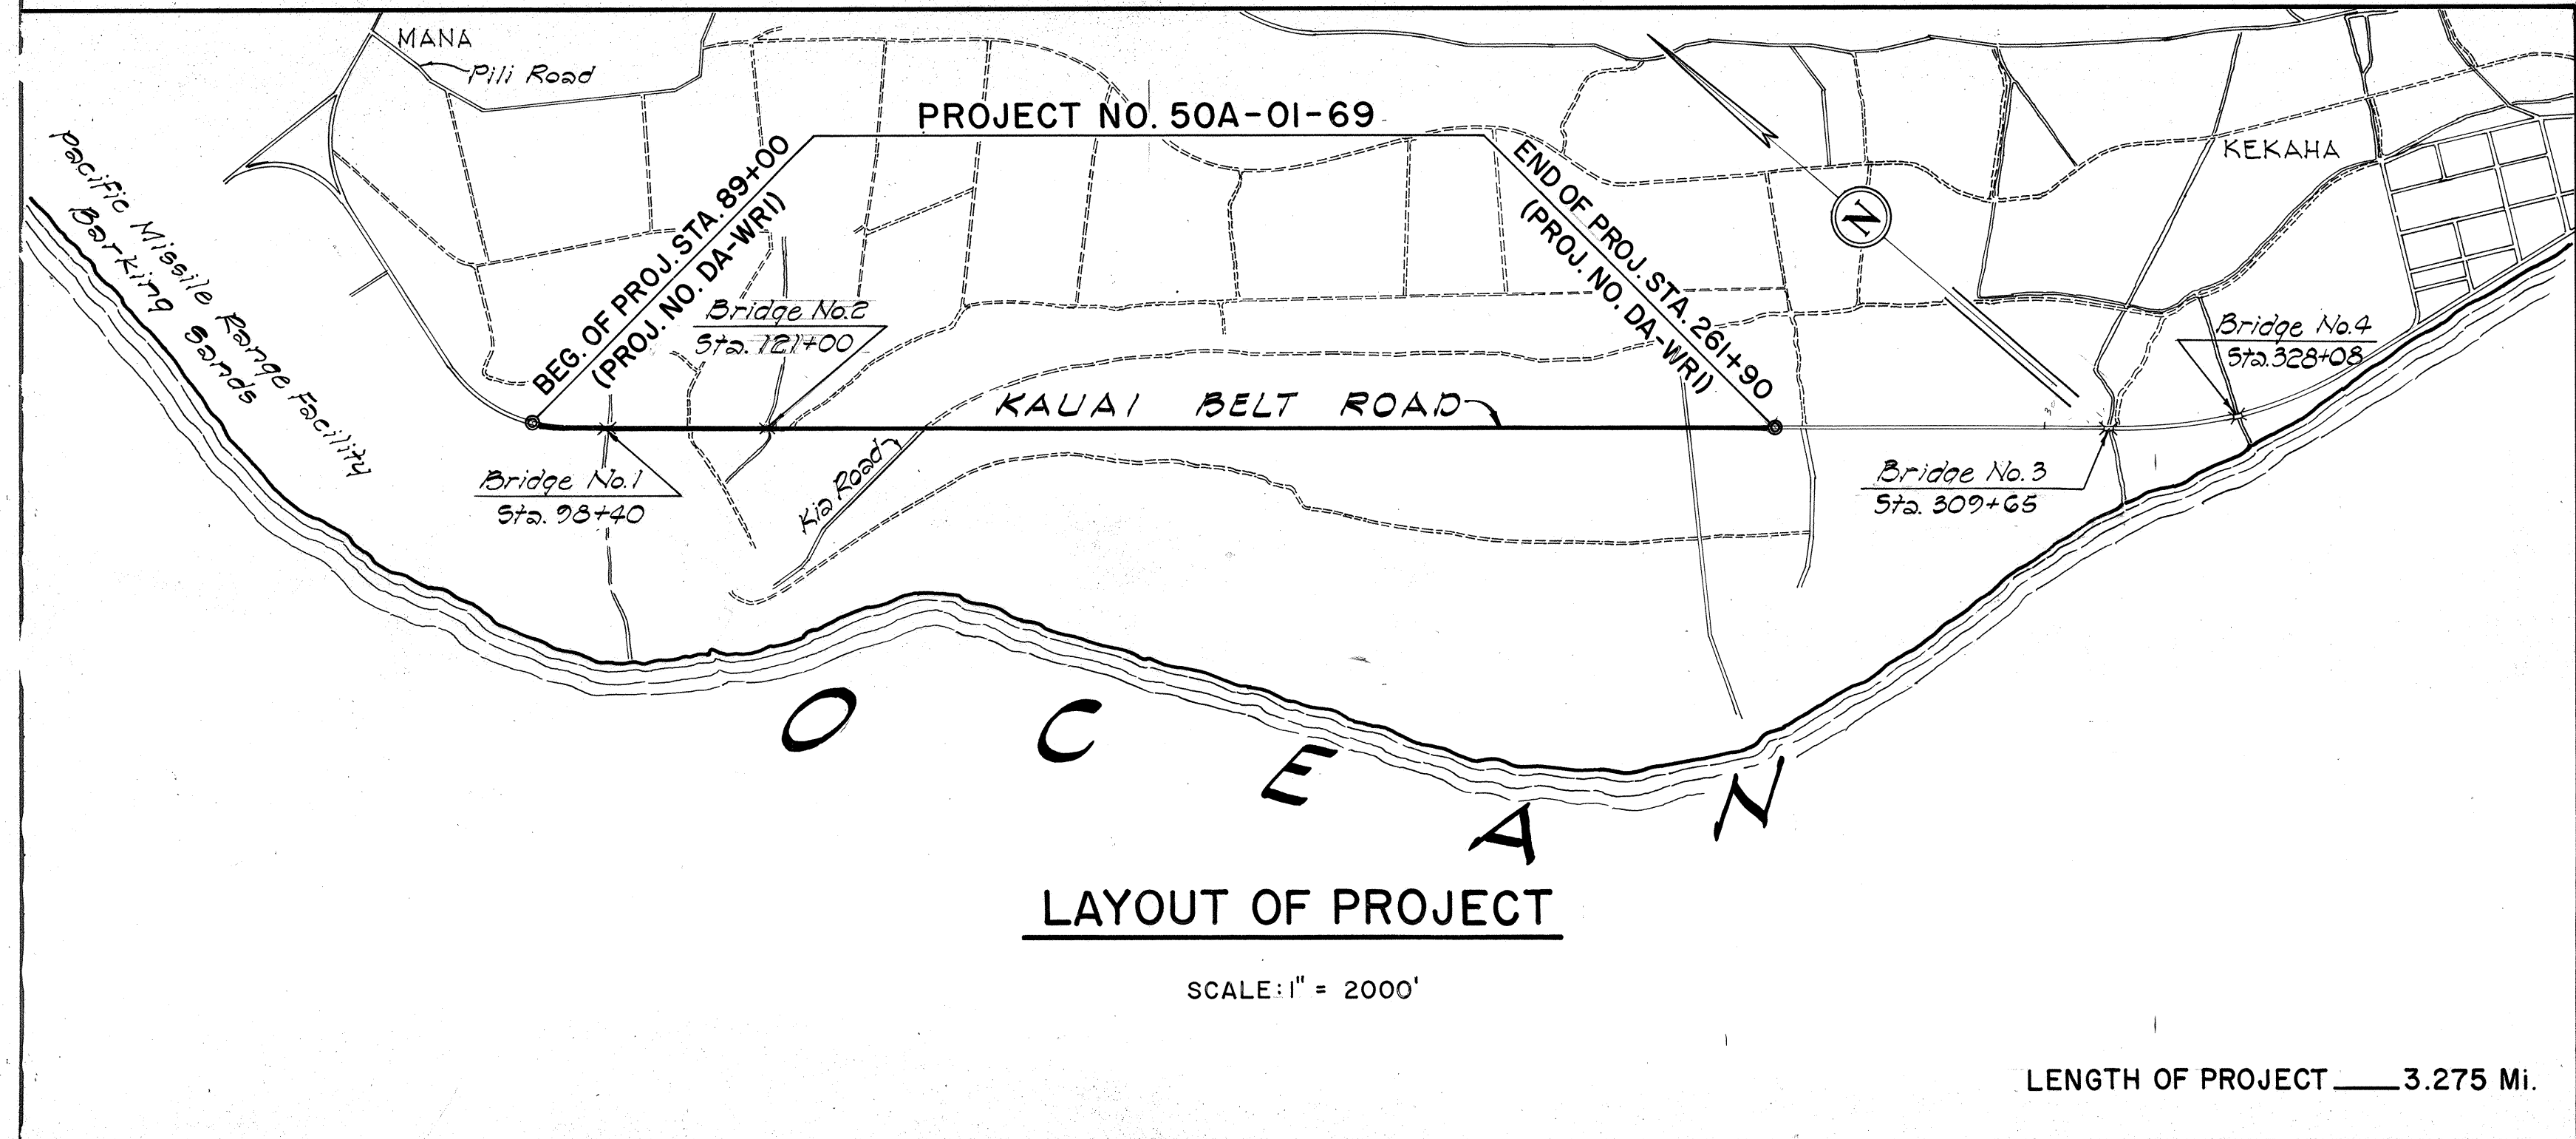

SURVEY PLOTTED BY	DATE
DESIGNED BY	
TRACED BY	
QUANTITIES CHECKED BY	
NOTE BOOK	
NO.	

DEPARTMENT OF TRANSPORTATION

STATE OF HAWAII

APPROVED:

E. Alvey Wright

8/26/68

for DIR. OF TRANSPORTATION

DATE