
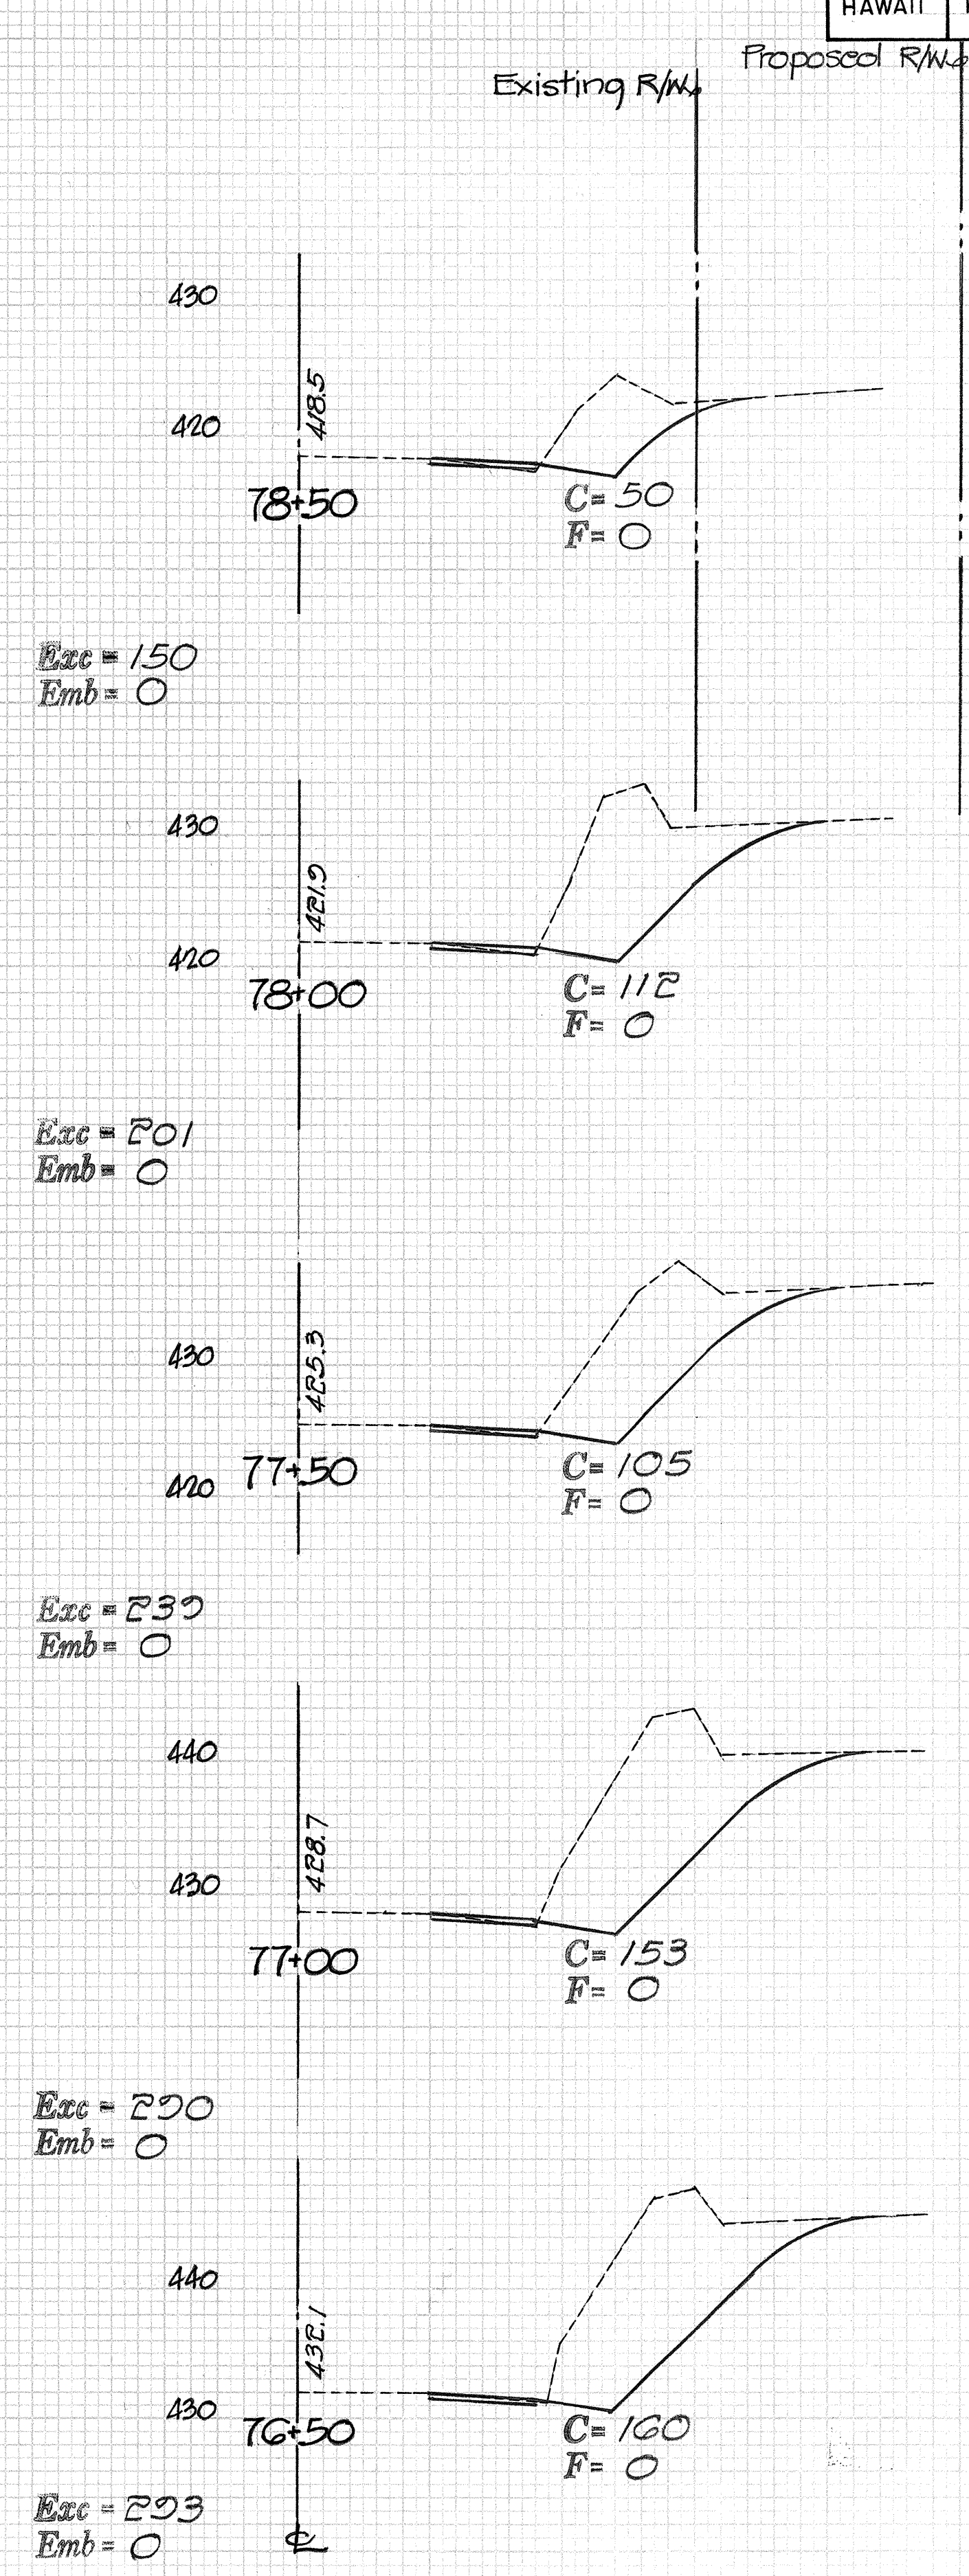
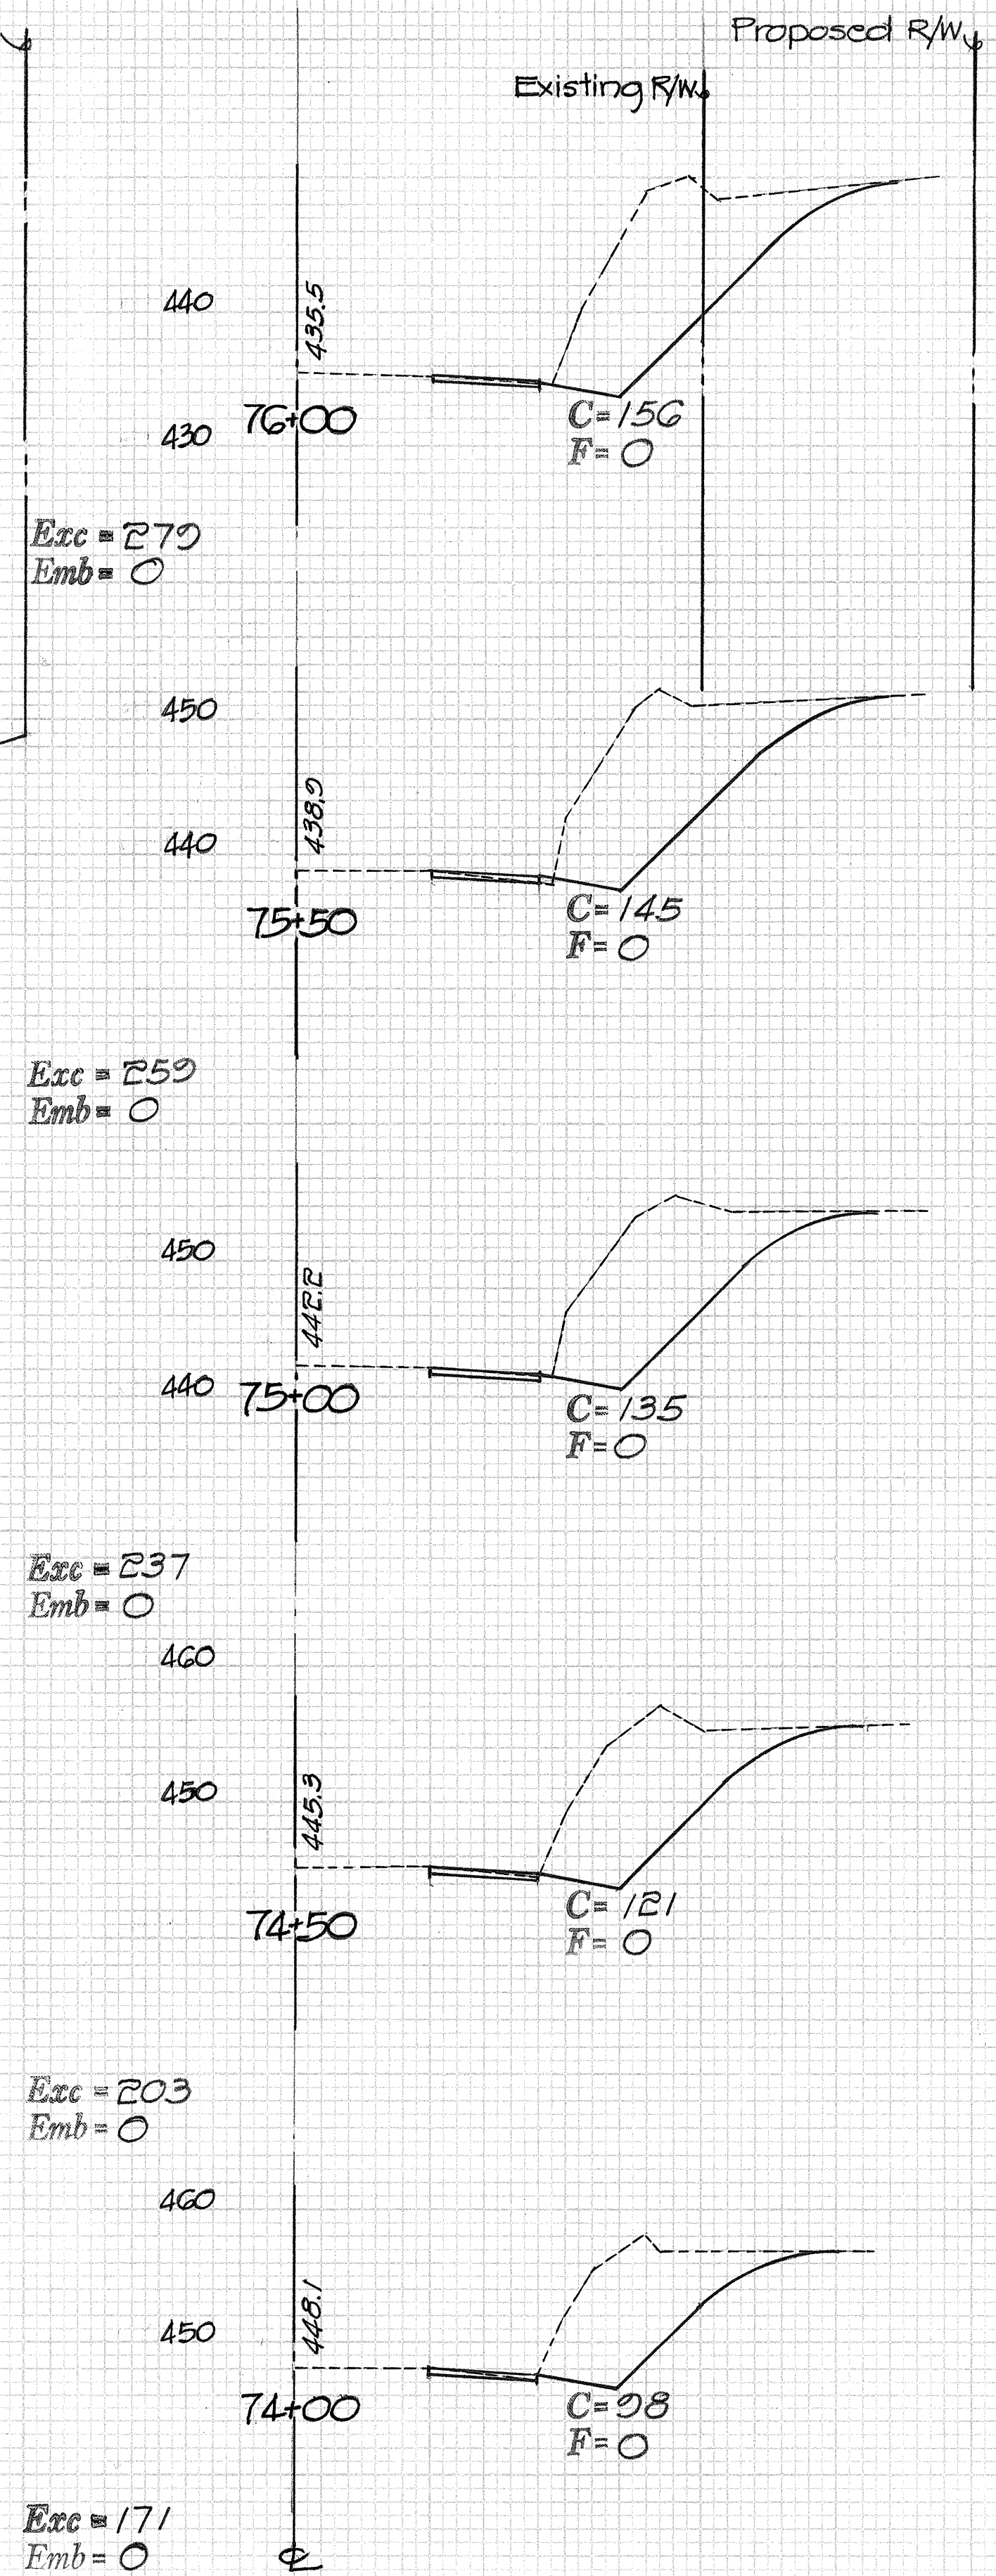
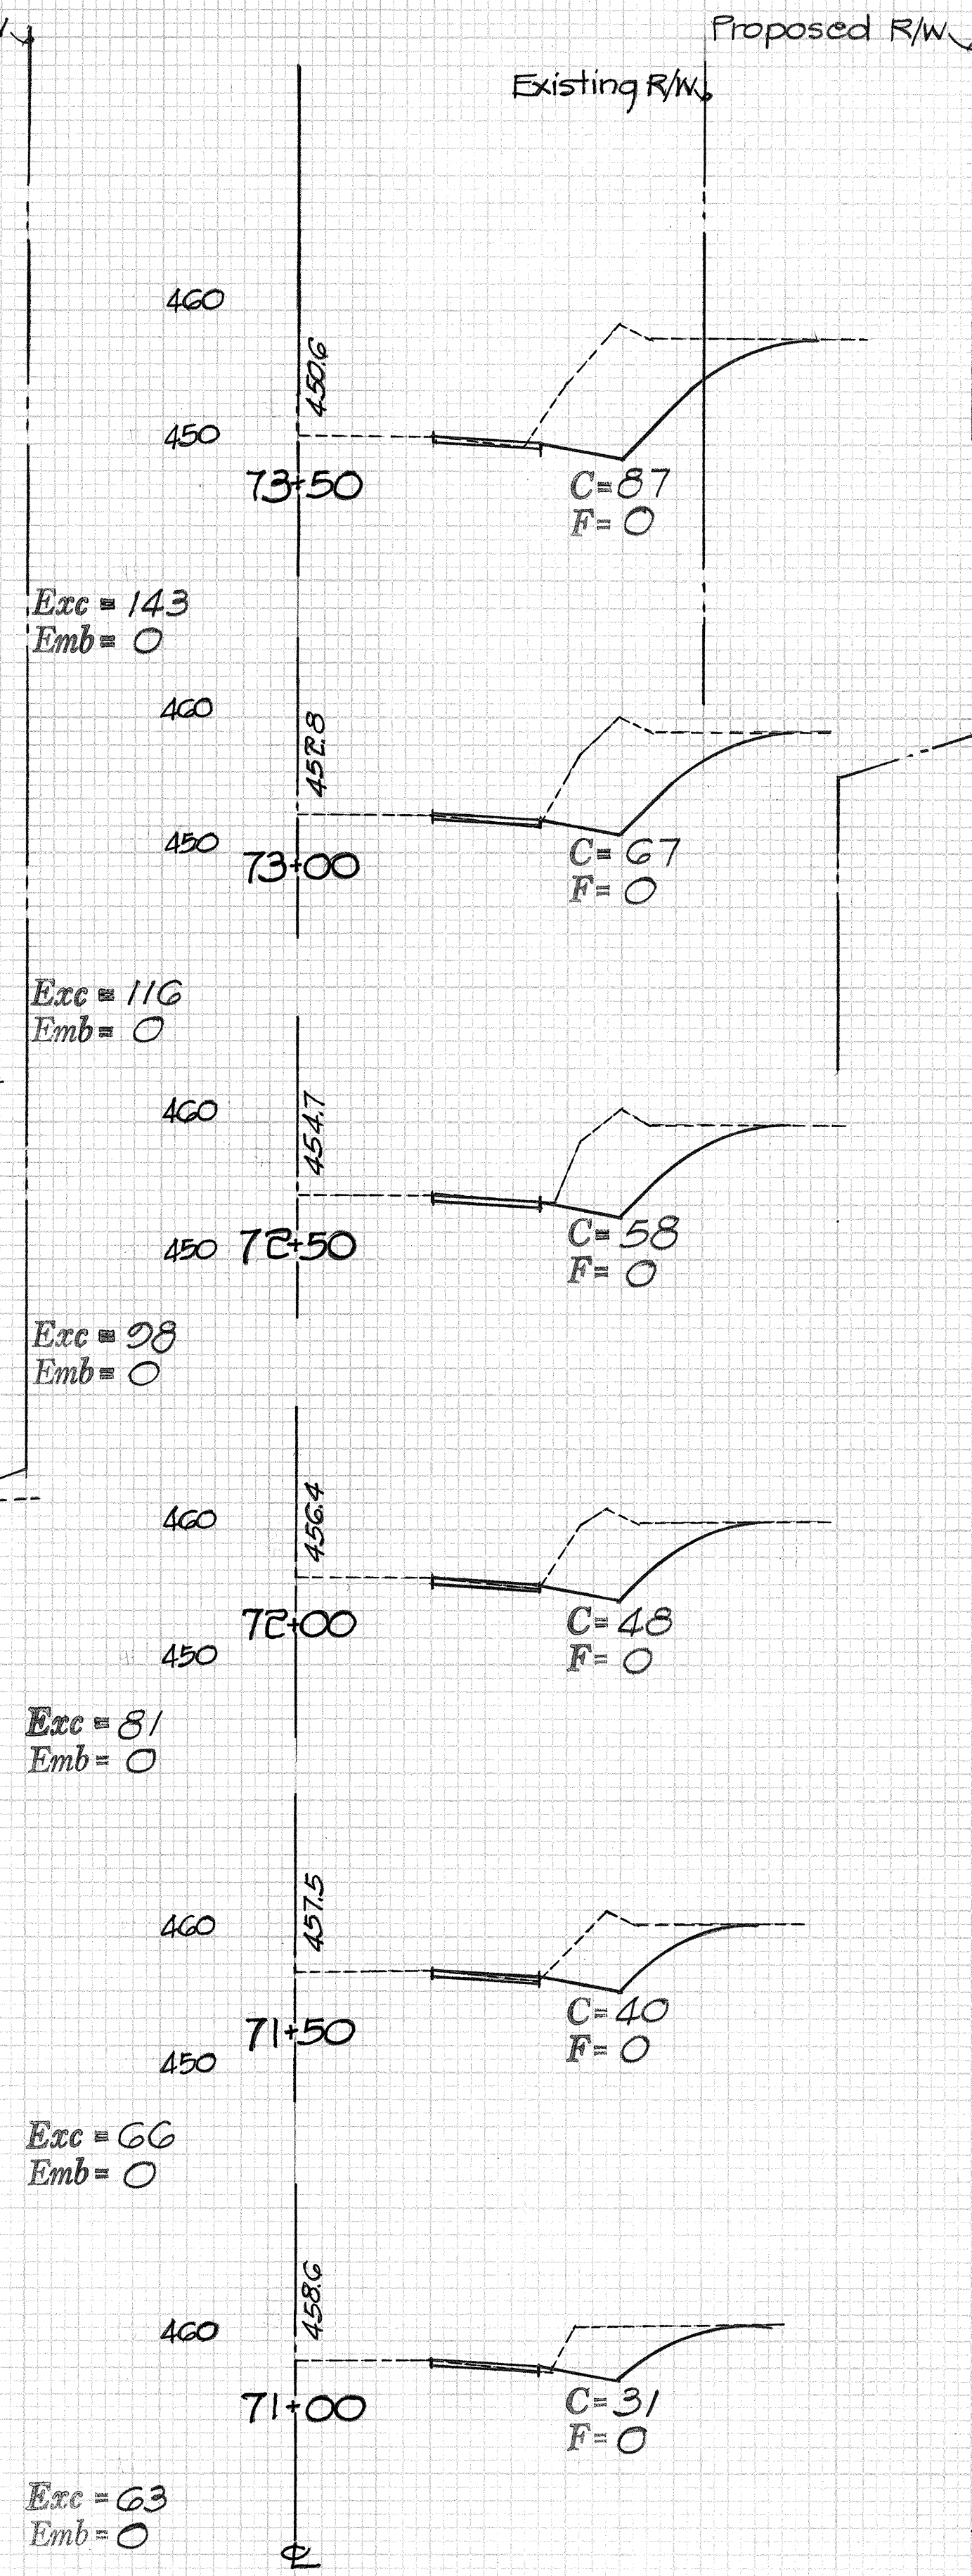


DIST. NO.	STATE	PROJ. NO.	FISCAL YEAR	SHEET NO.	TOTAL SHEETS
HAWAII	HAW.	50D-03-69	1970	5	14

FINAL SURVEY
BY: _____
DATE: _____
NO. _____

ORIGINAL SURVEY
BY: _____
DATE: _____
NO. _____

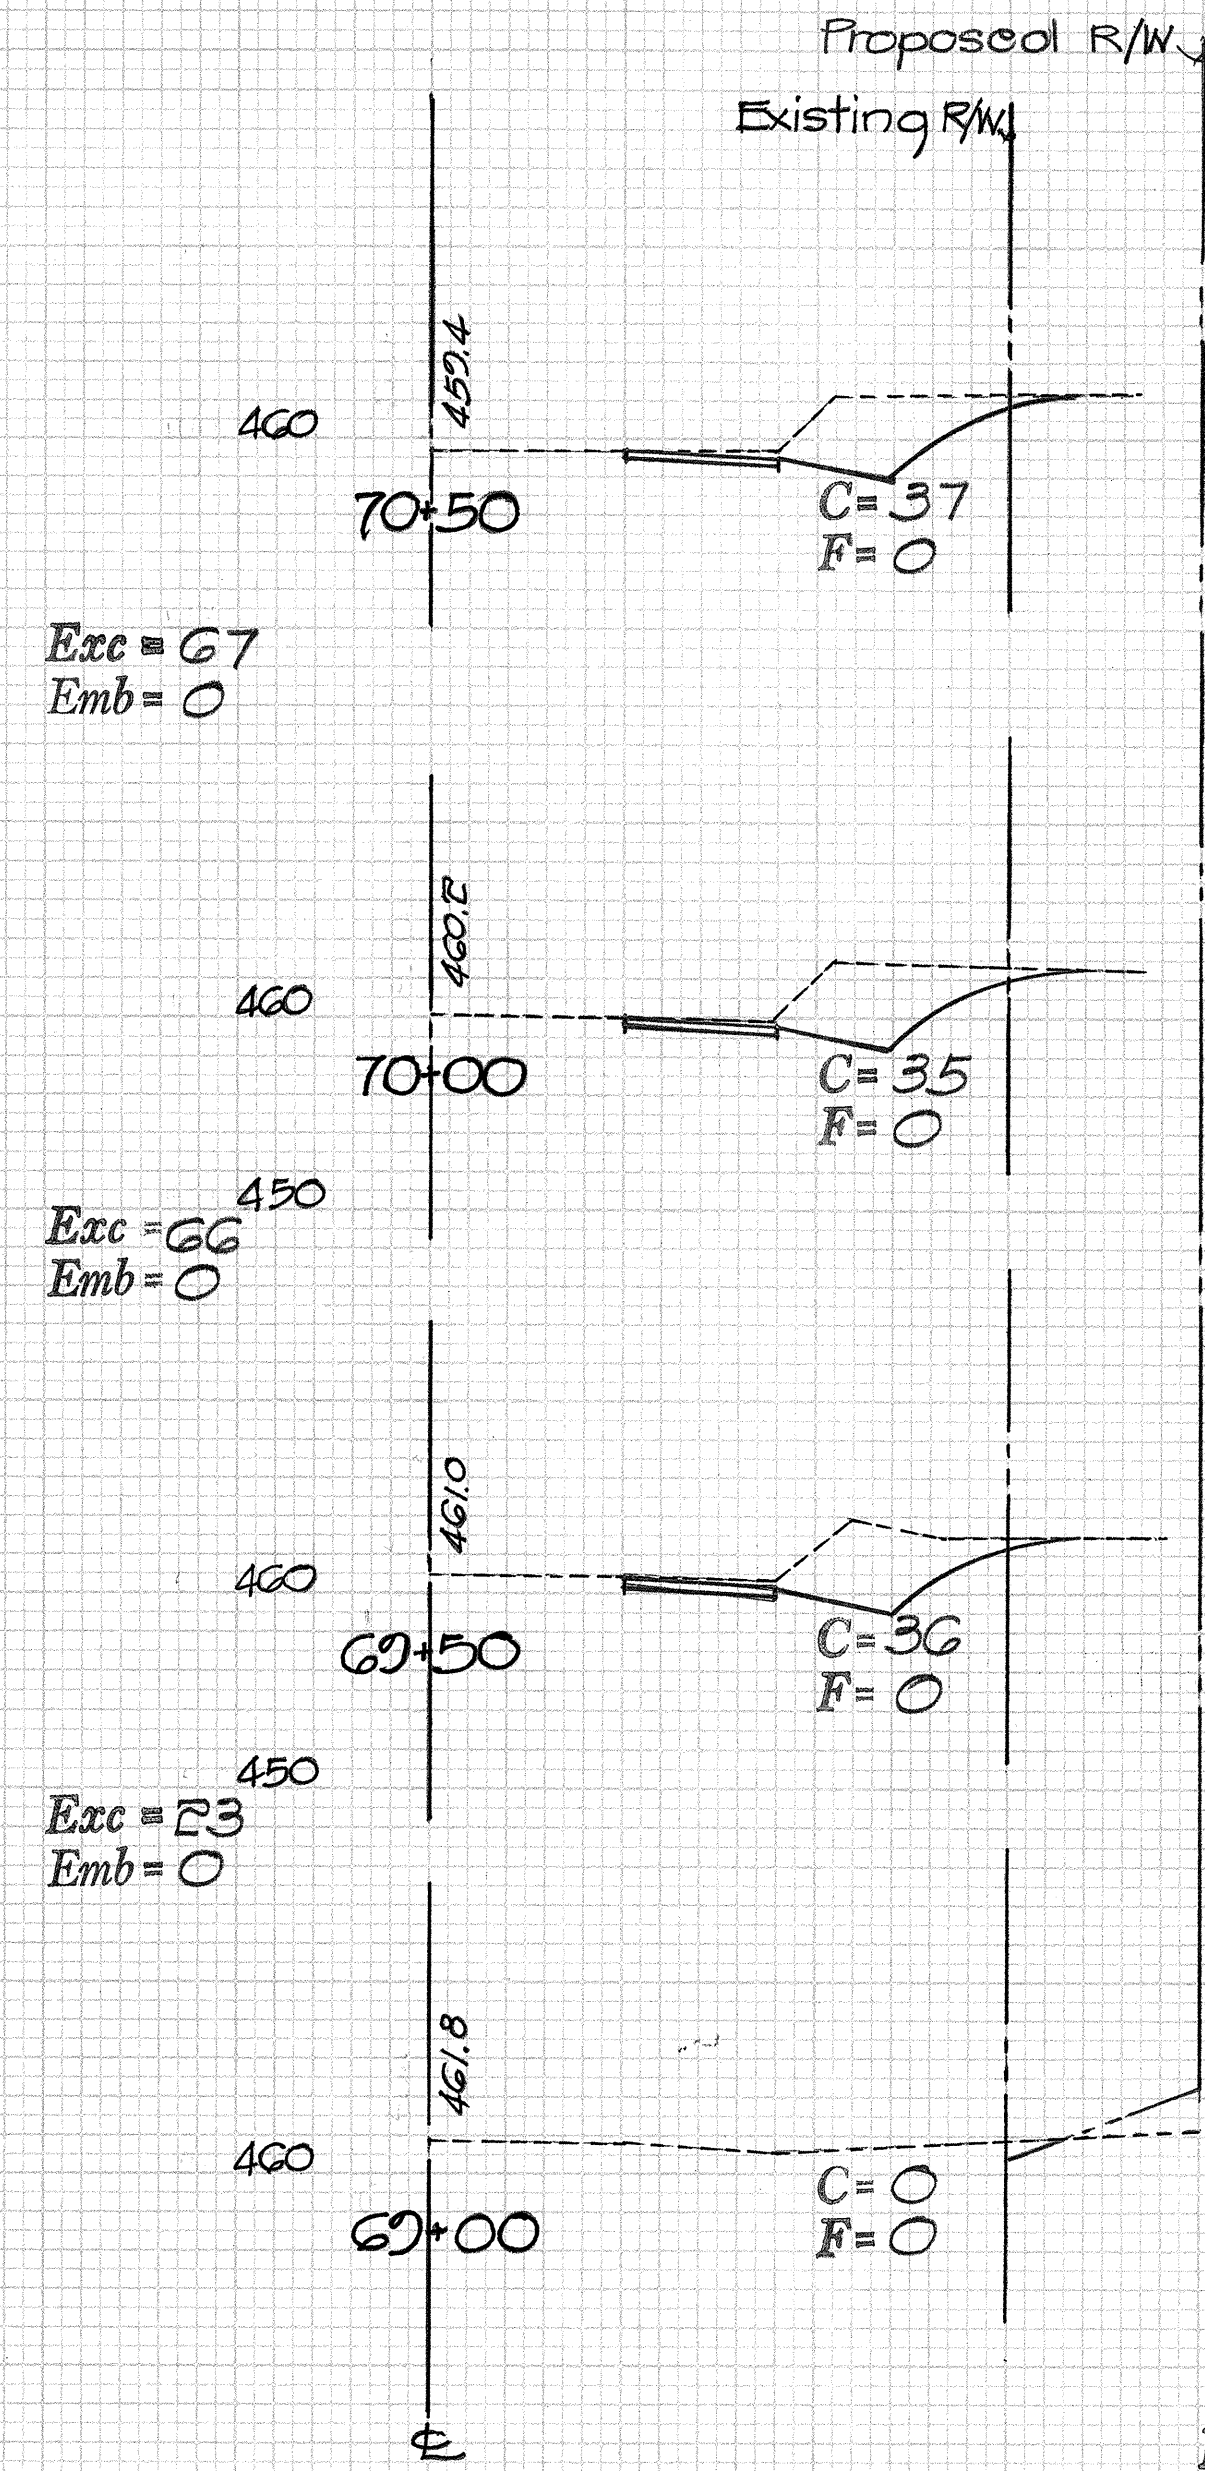

DIST. NO.	STATE	PROJ. NO.	FISCAL YEAR	SHEET NO.	TOTAL SHEETS
HAWAII	HAW.	50D-03-00	1970	6	14

