

INDEX TO DRAWINGS	
SHEET NO.	DESCRIPTION
1	TITLE SHEET
2	PLAN & TYPICAL SECTION
3	DRAINAGE & TRACTOR CROSSING DETAIL
4-15	STANDARD DETAIL
16	CROSS SECTIONS


STATE OF HAWAII
DEPARTMENT OF TRANSPORTATION
HIGHWAYS DIVISION
"AS BUILT"
PLANS FOR

KAUMUALII AND MALUHIA ROAD
INTERSECTION IMPROVEMENTS


STA. 261+00 TO STA.275+00 PROJ. NO. F-12(19)

PROJECT NO. 50D-04-70

DISTRICT OF KOLOA
ISLAND OF KAUAI

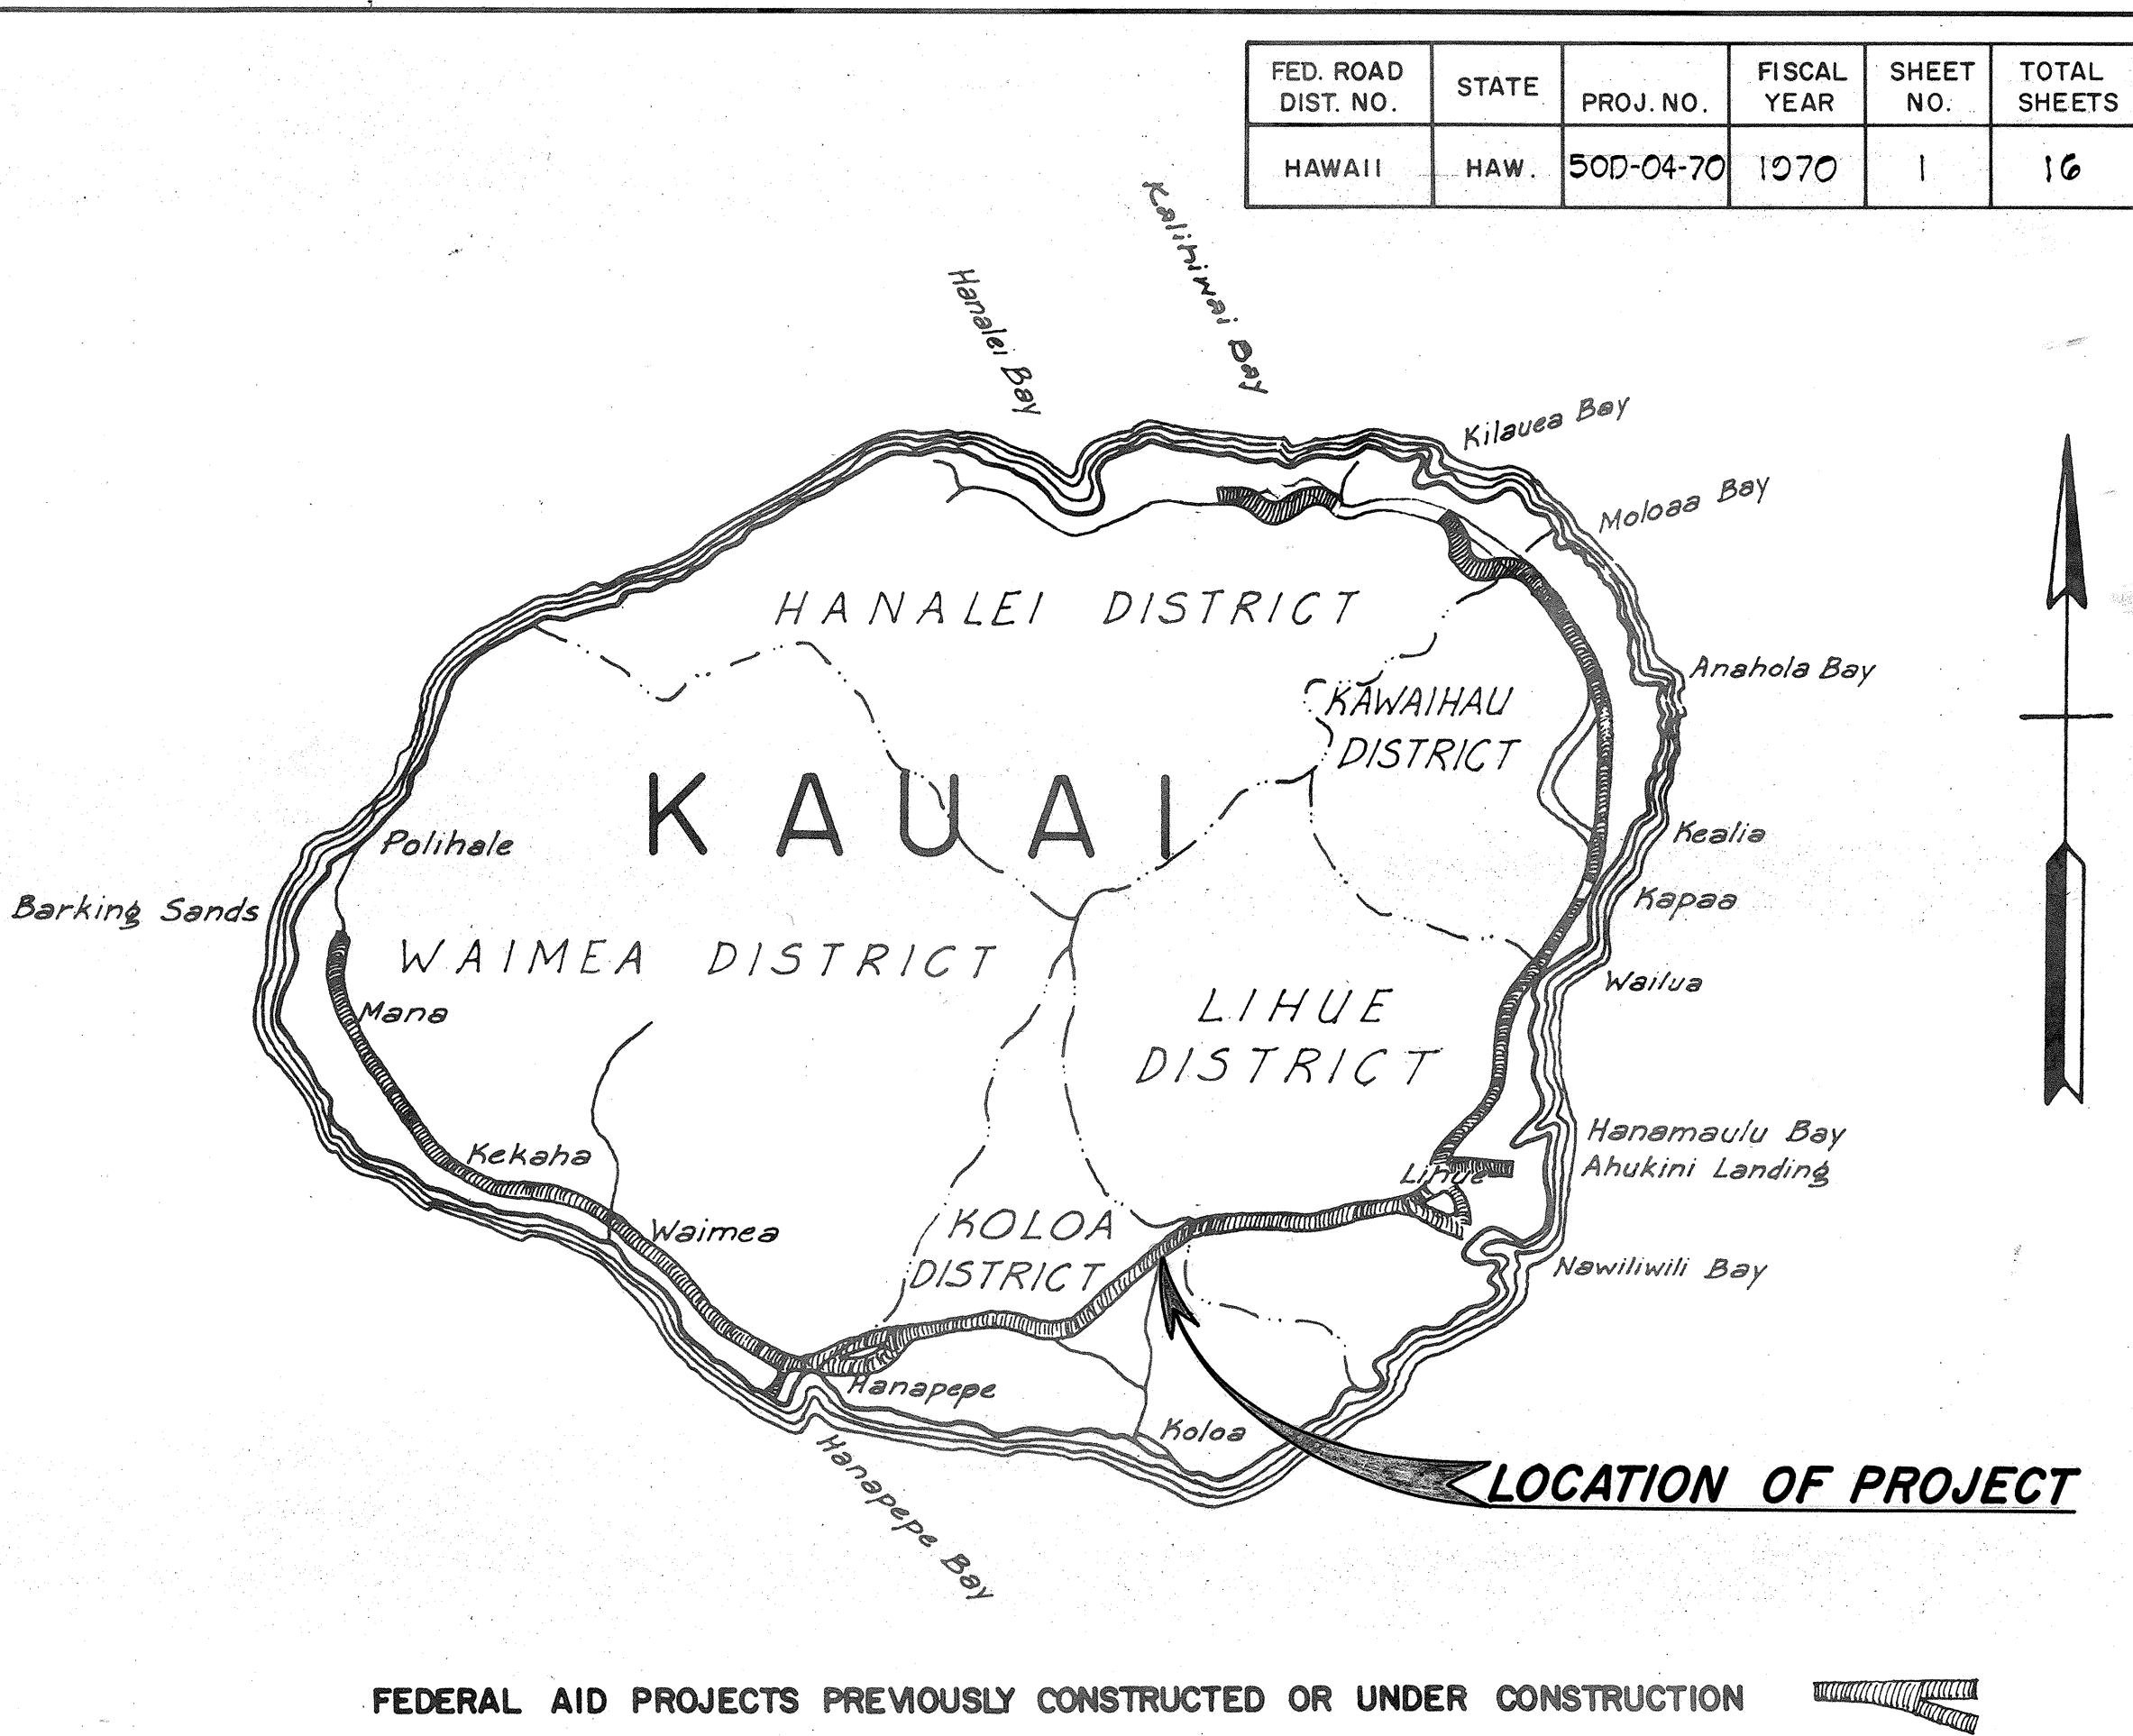

DESIGNED BY: KAUAI DISTRICT DESIGN OFFICE
PS & E BY: MIKE MIURA - DESIGN UNIT "C"
PHONE: 5482211 EXT. 301
DATE: JUNE 1970

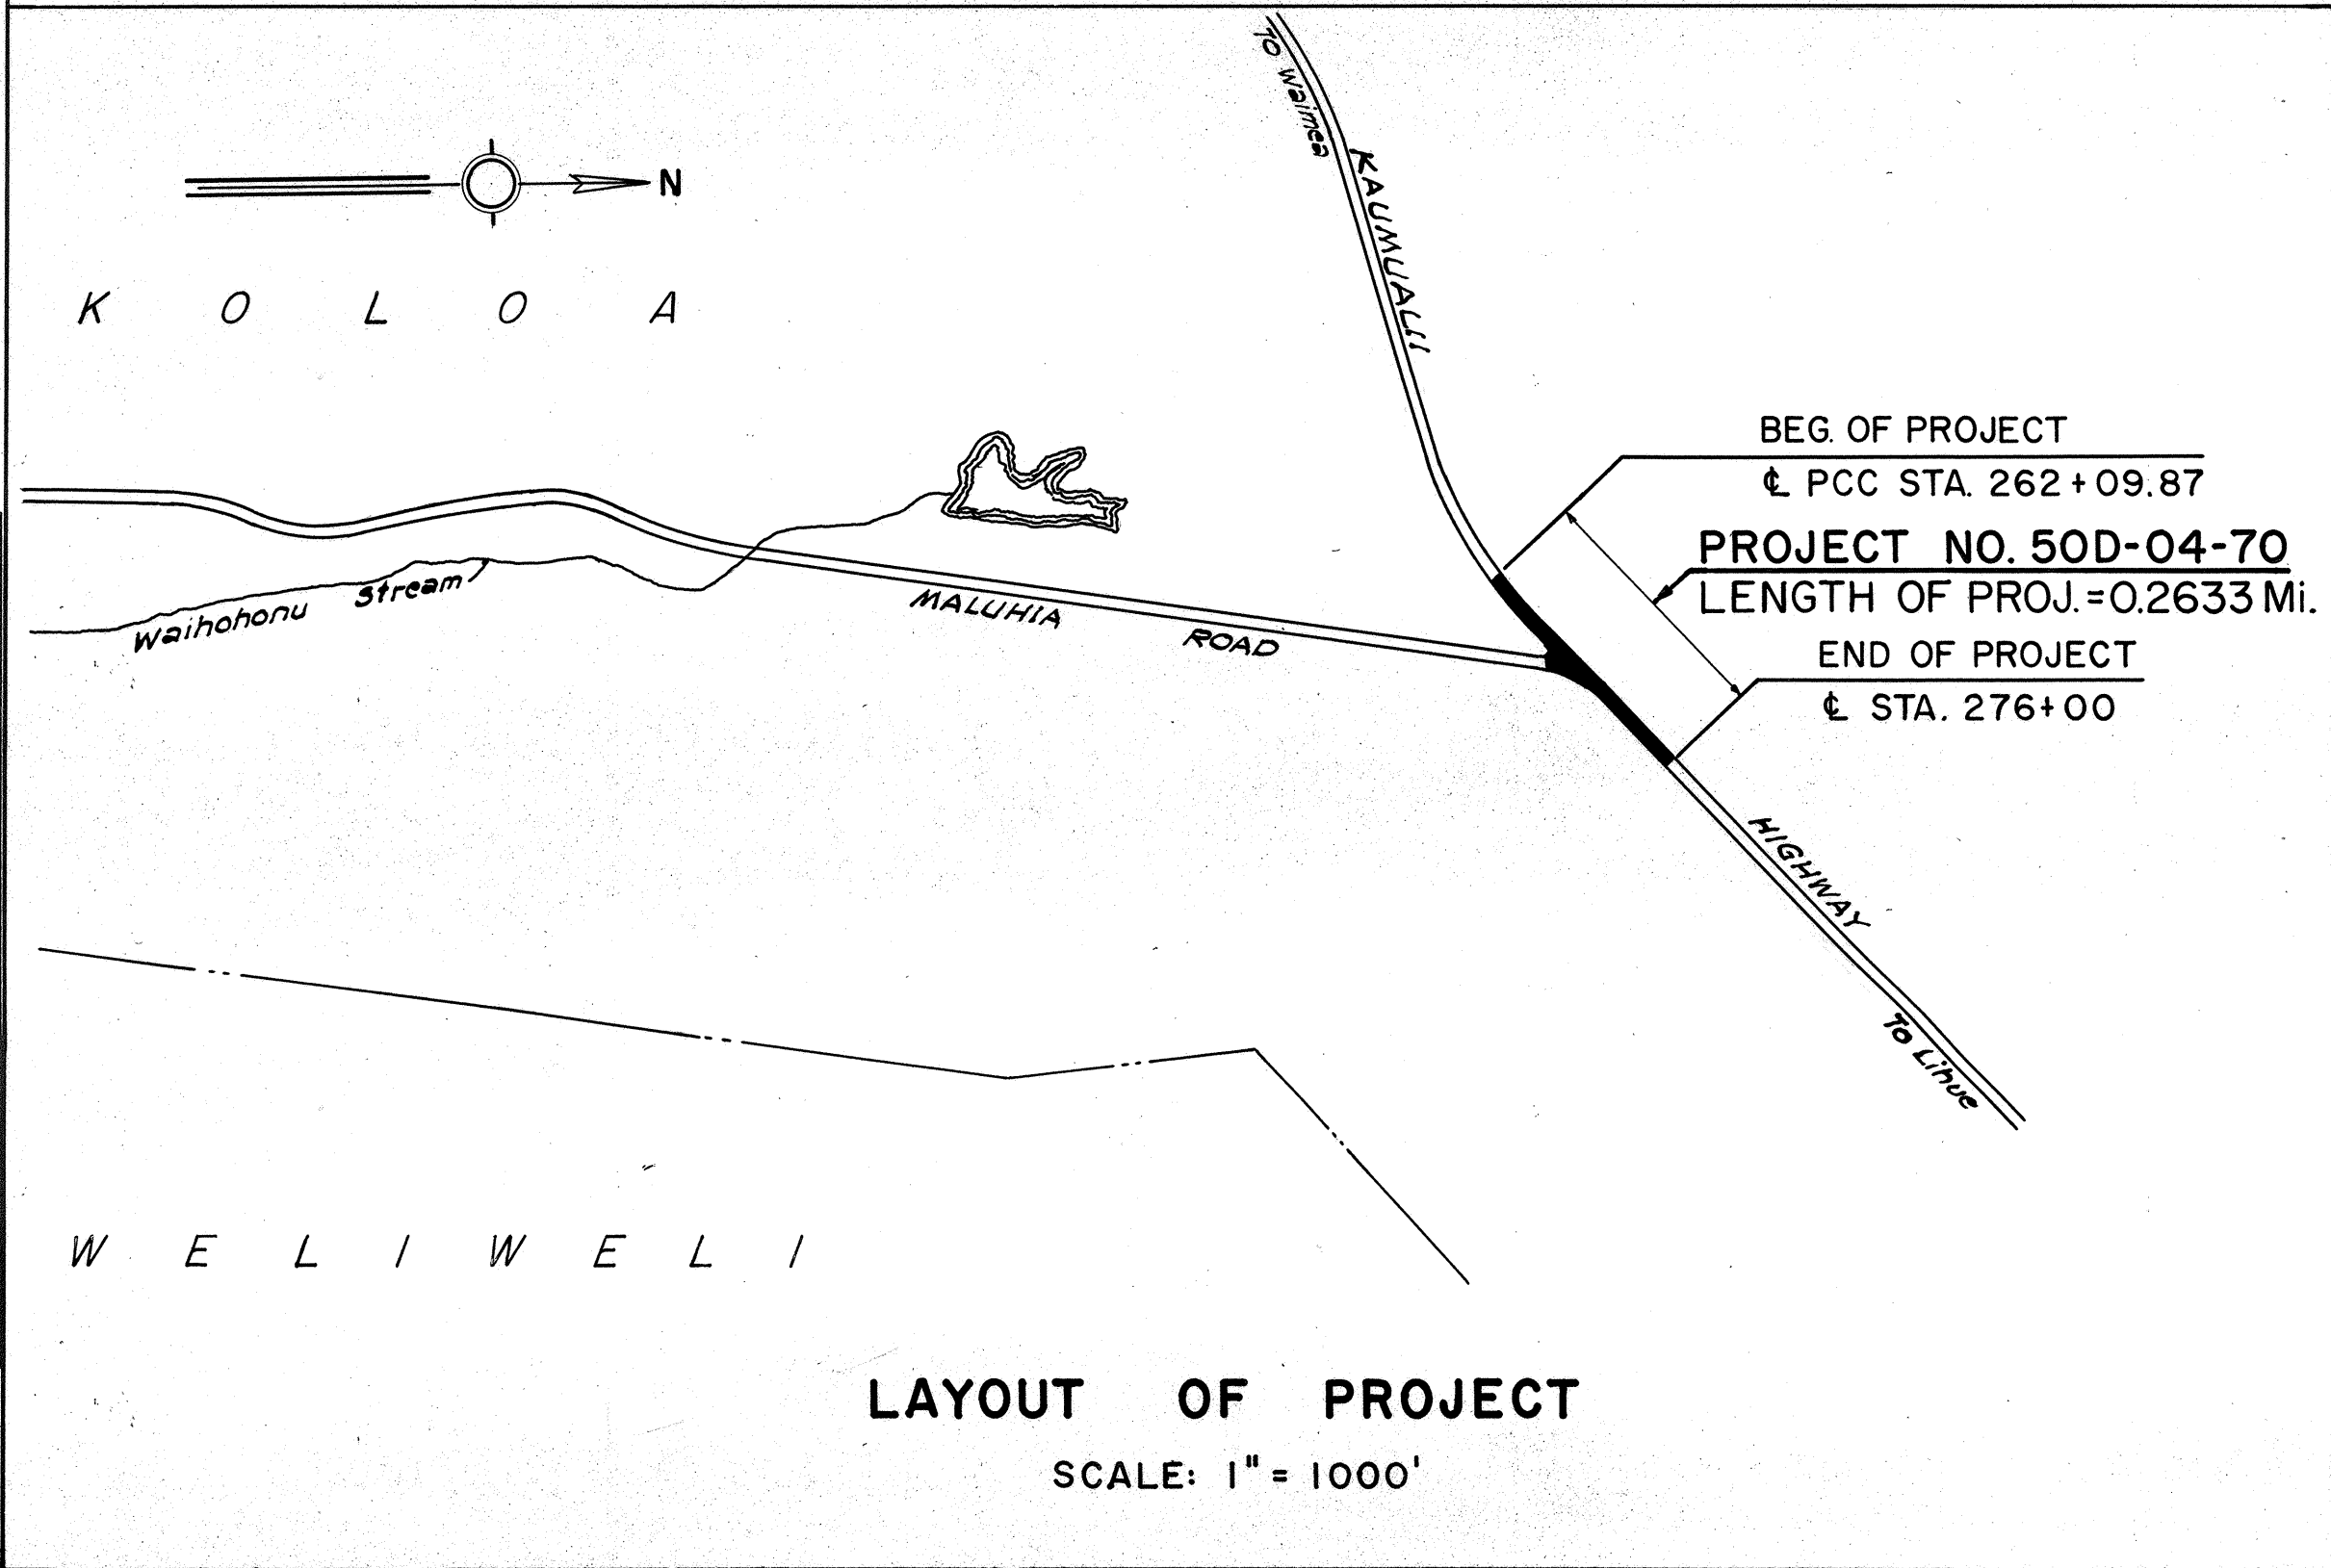

ALL CHANGES MADE DURING CONSTRUCTION HAVE BEEN INCORPORATED ON THESE PLANS IN RED EXCEPT CHANGES IN THE ORIGINAL THEORETICAL QUANTITIES. FOR ACTUAL QUANTITIES, REFER TO PROJECT LEDGER AND/OR COMPUTATION BOOK.

RESIDENT ENGINEER

6-1-81

DATE

DEPARTMENT OF TRANSPORTATION
STATE OF HAWAII
APPROVED:

9/11/70
for DIR. OF TRANSPORTATION DATE

ORIGINAL PLAN	NO.
DATE	
SURVEY PLOTTED BY	
DESIGNED BY	
DRAWN BY	
CHECKED BY	
QUANTITIES CHECKED BY	