
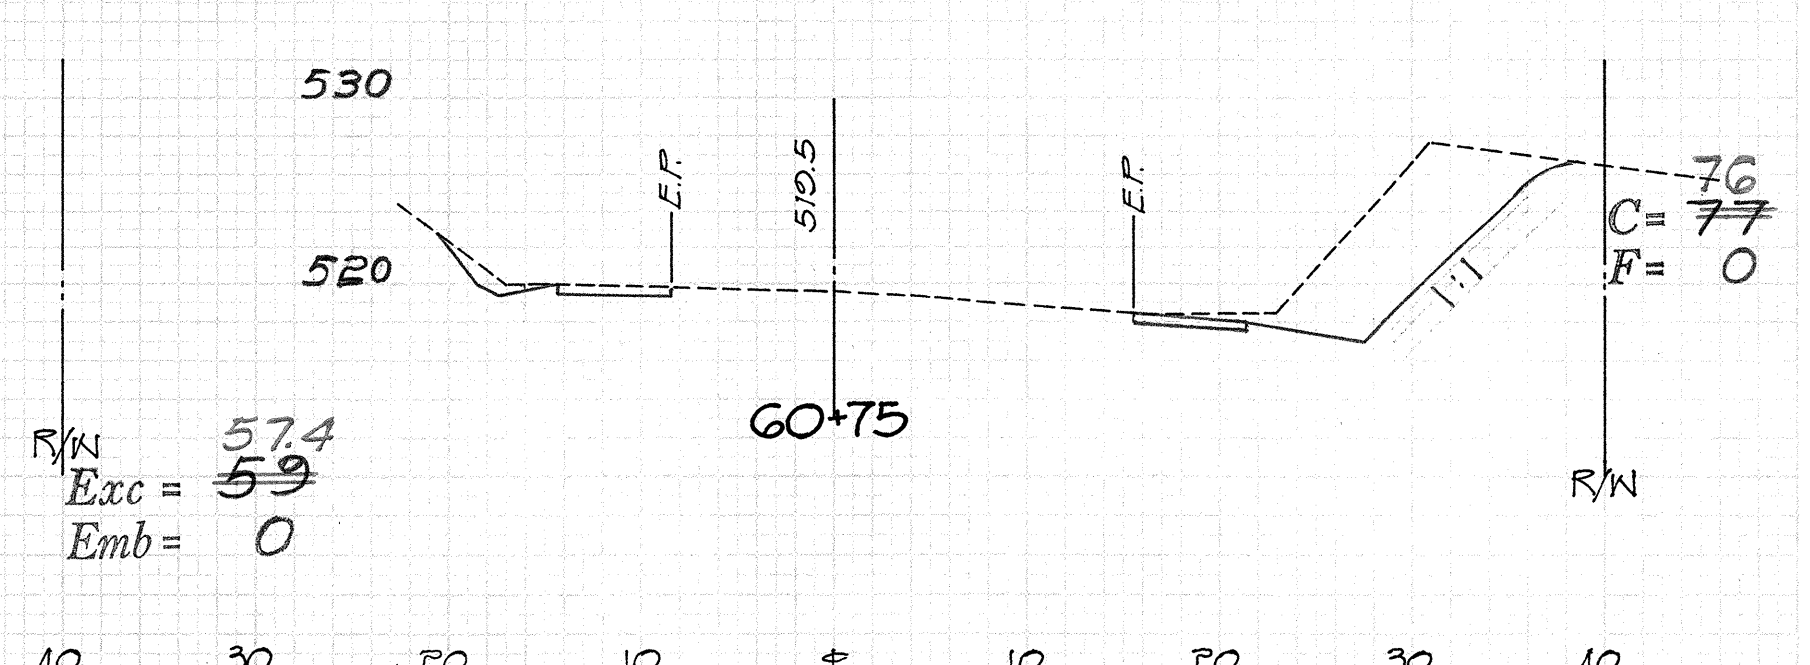
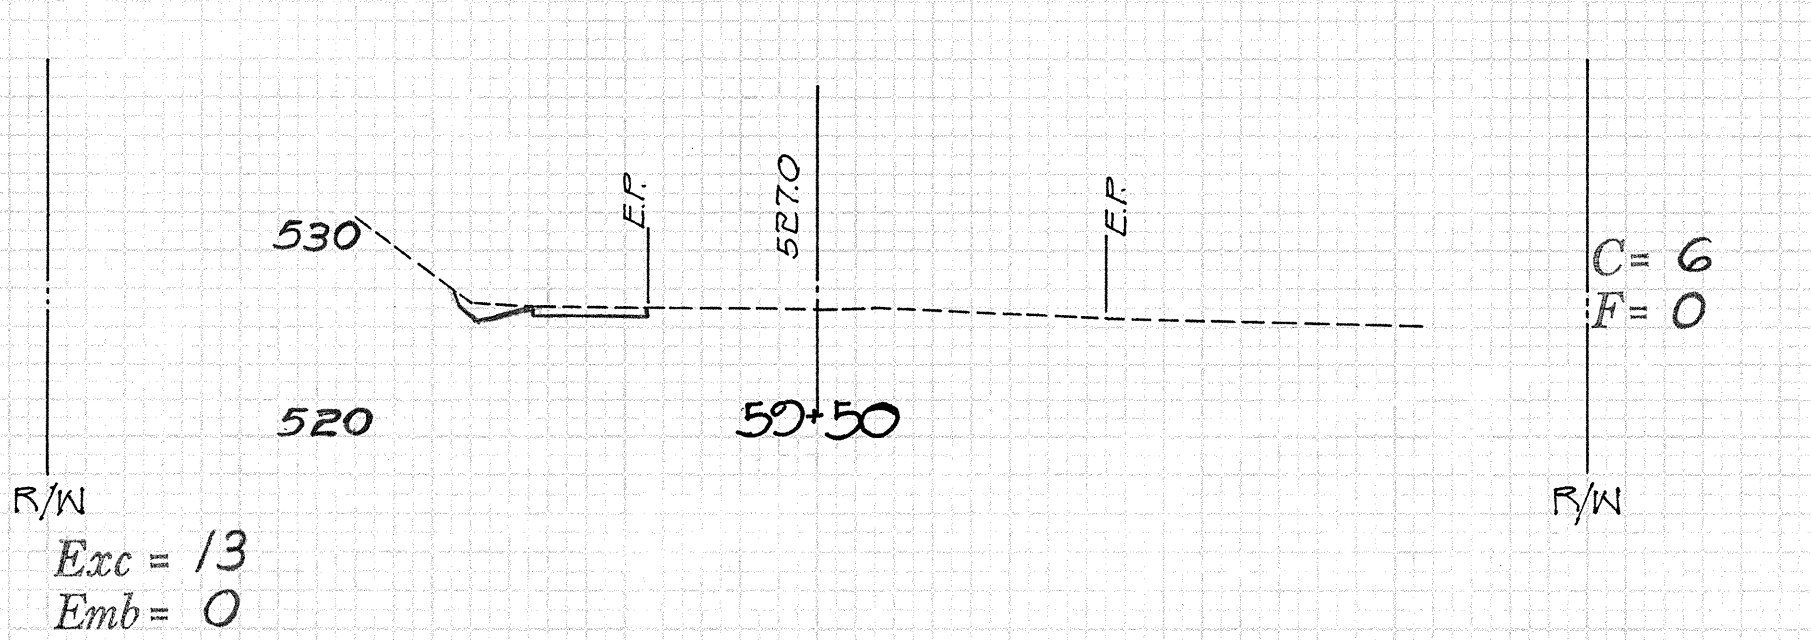
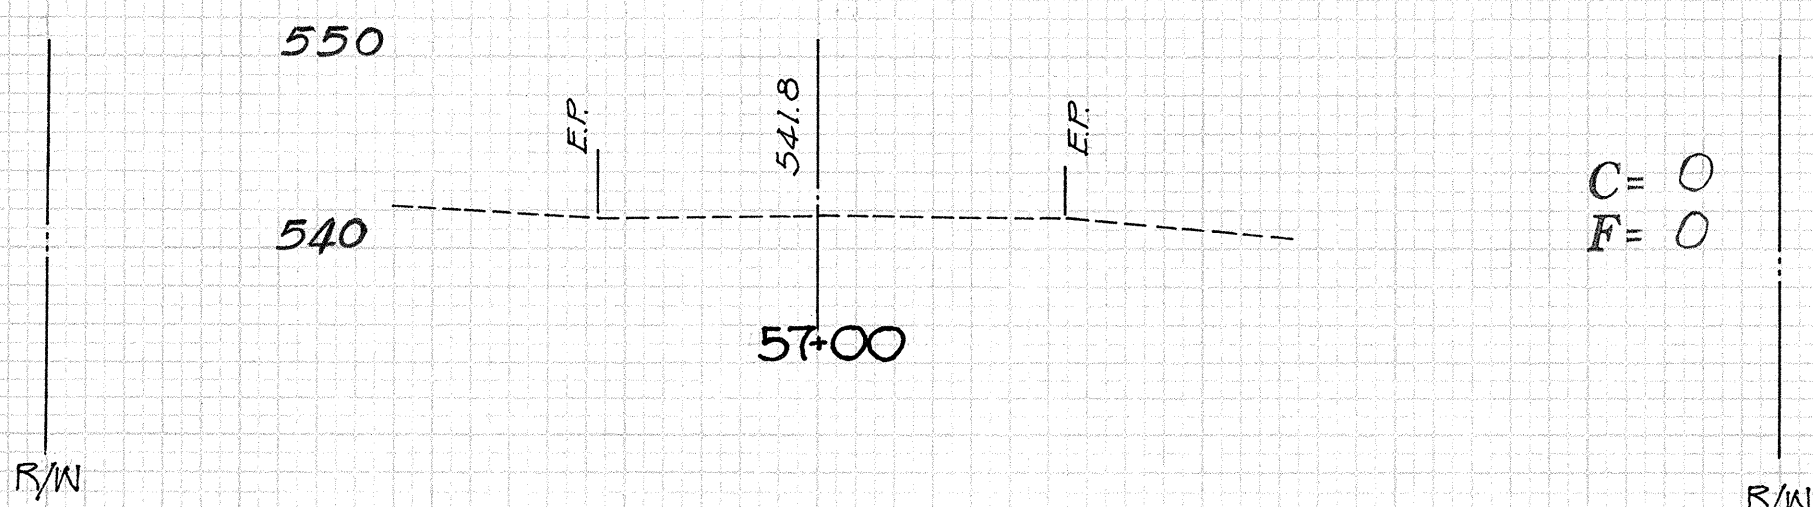
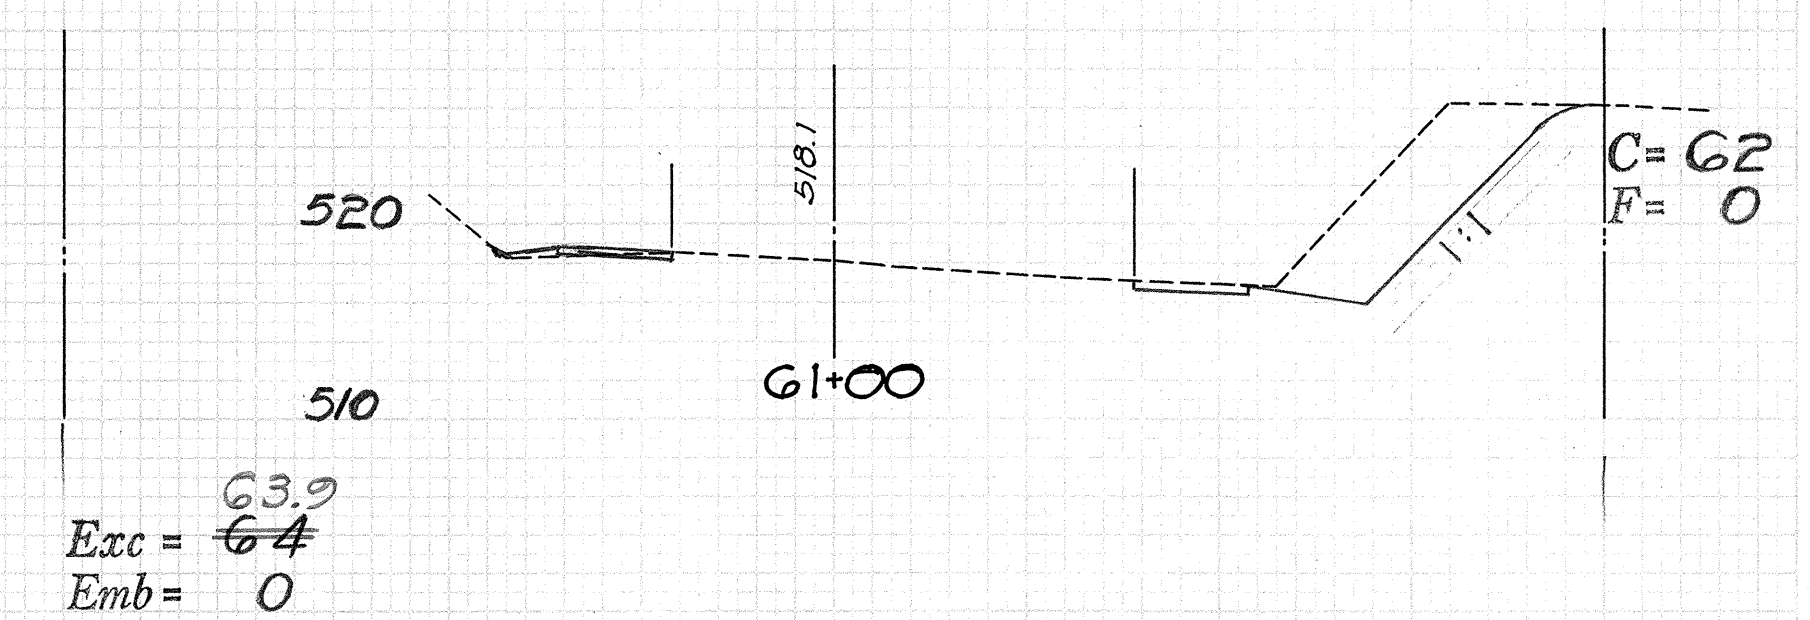
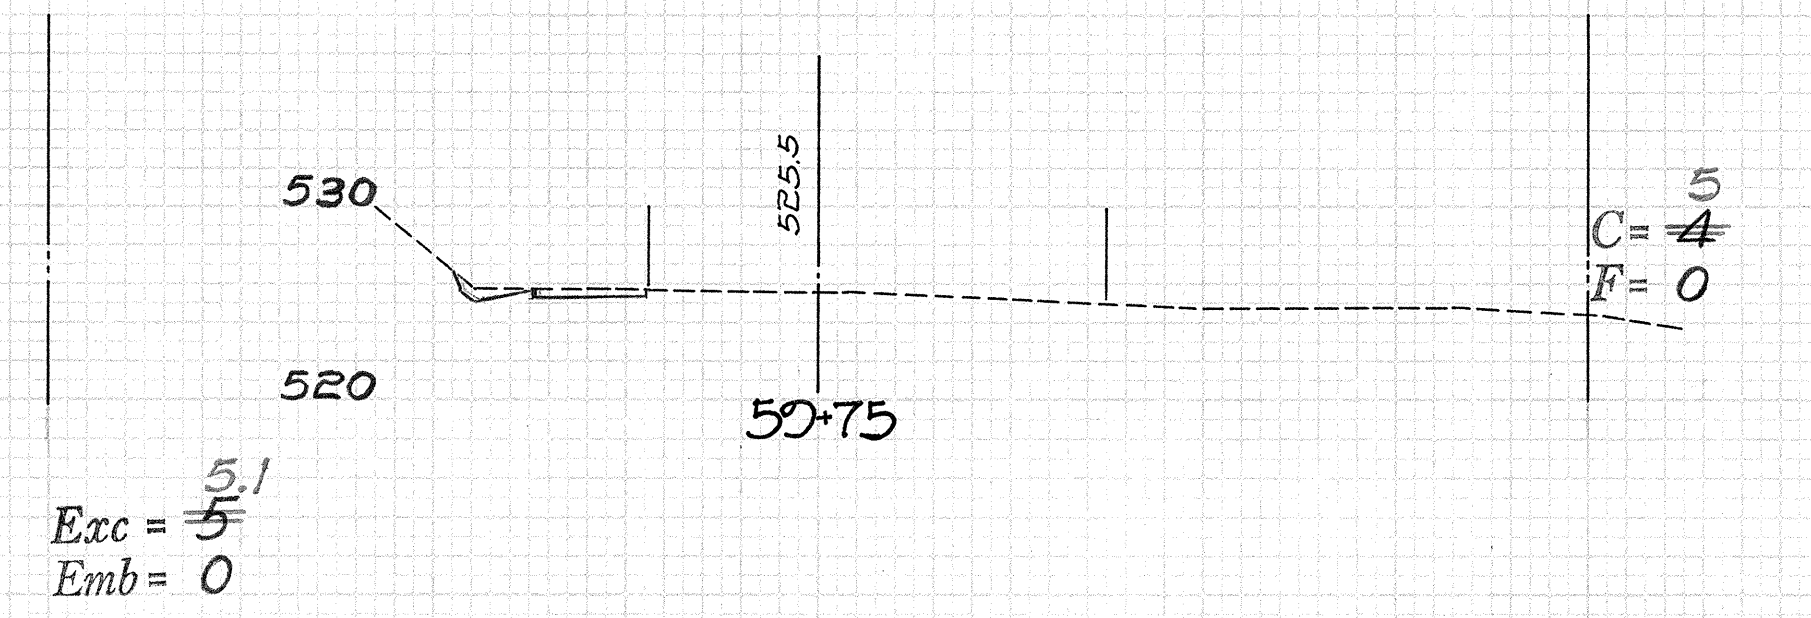
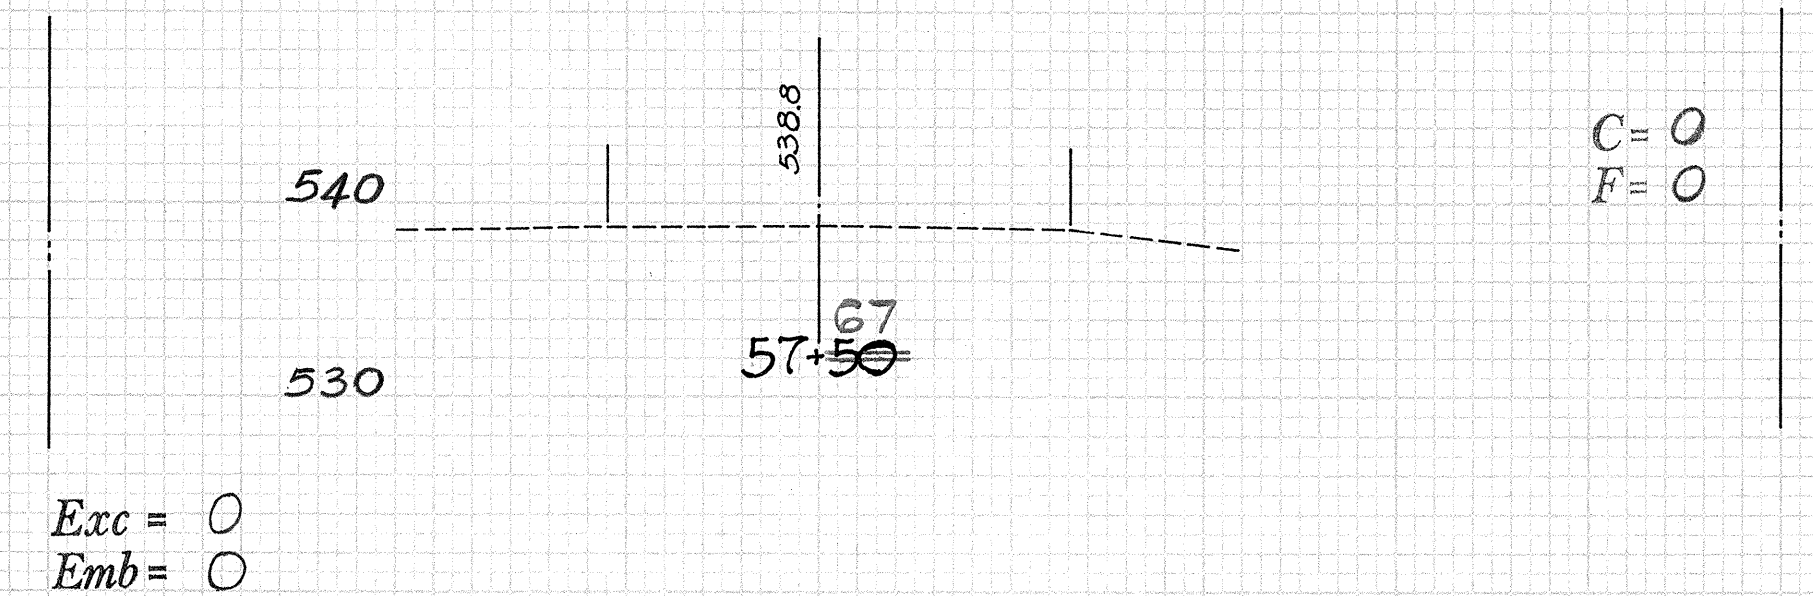
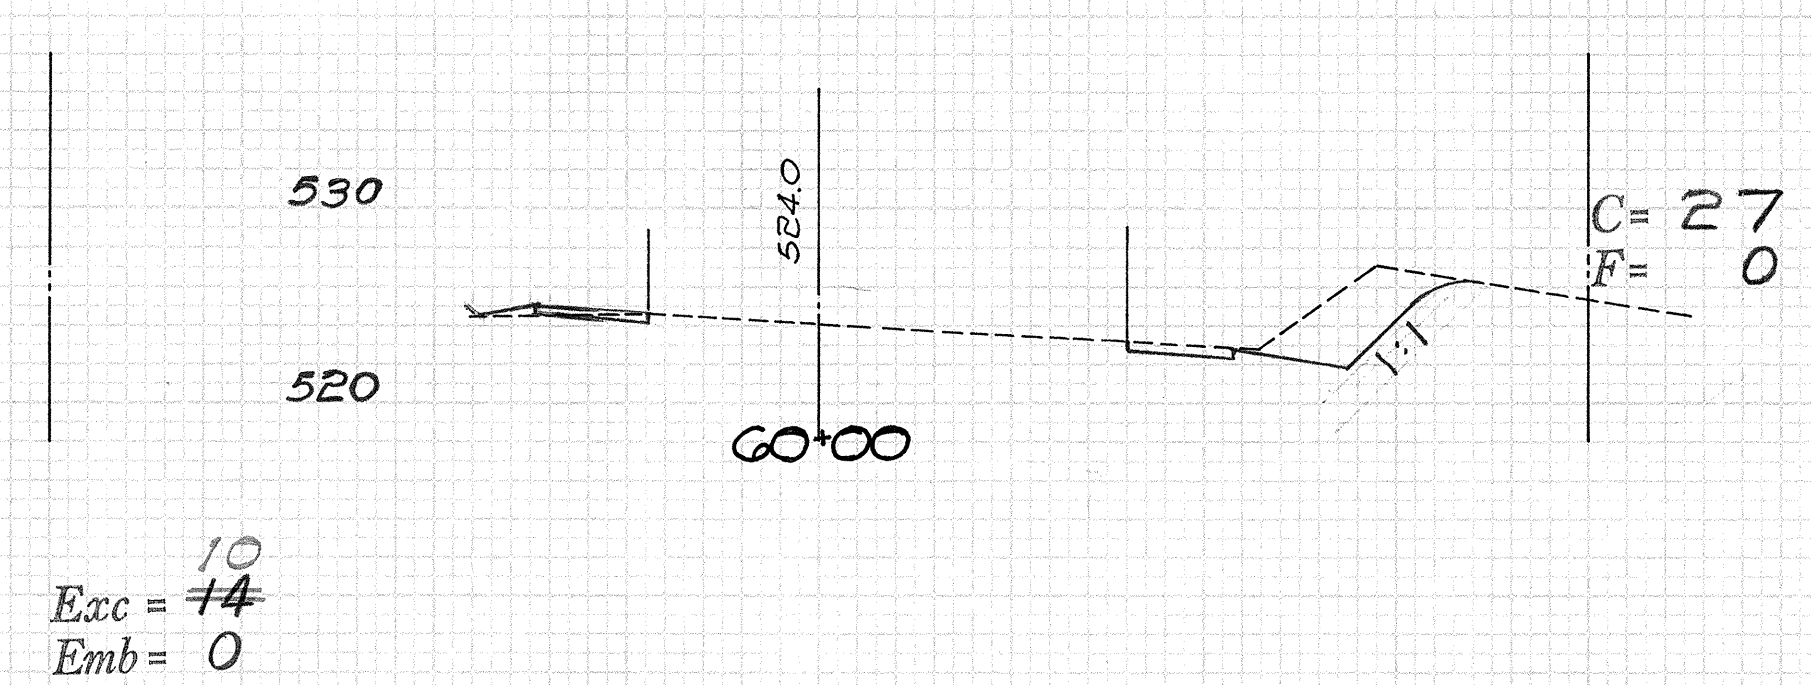
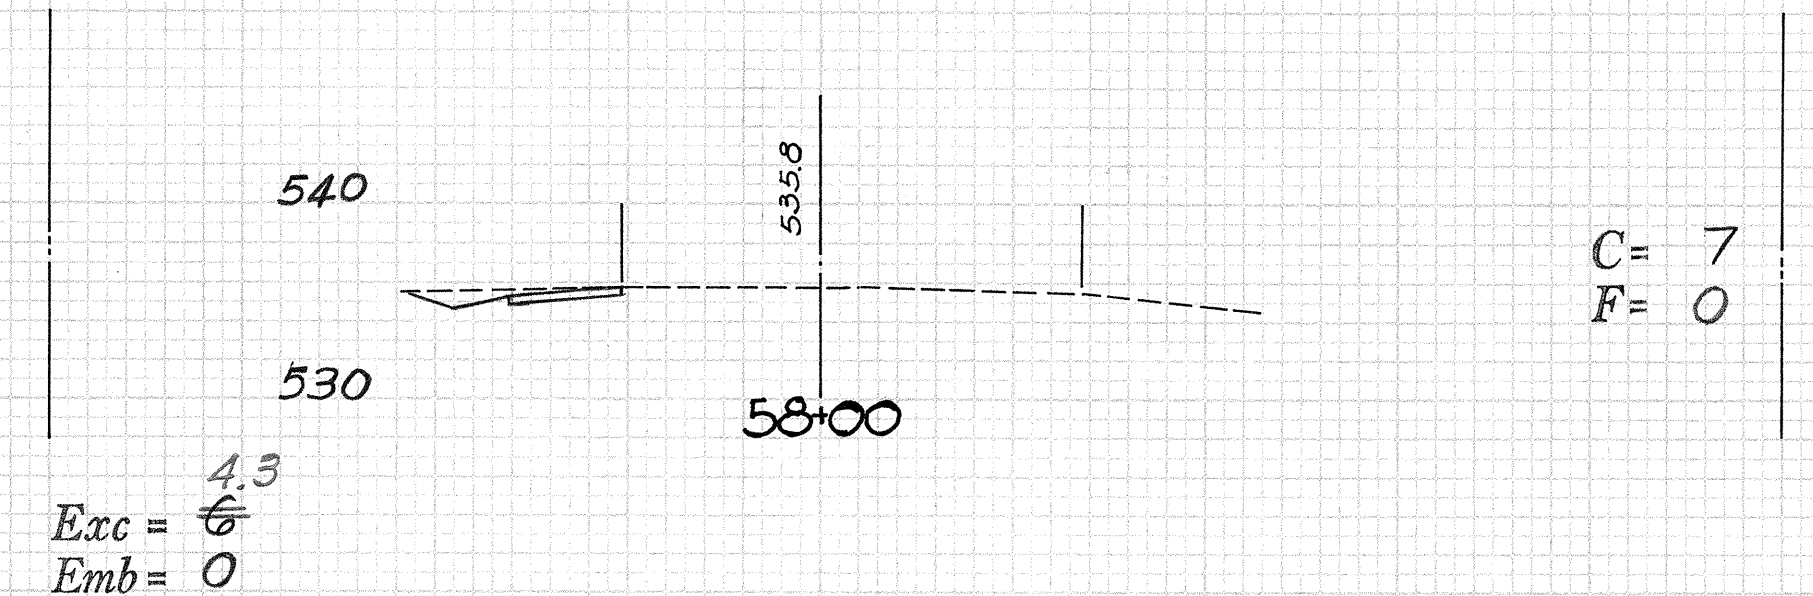
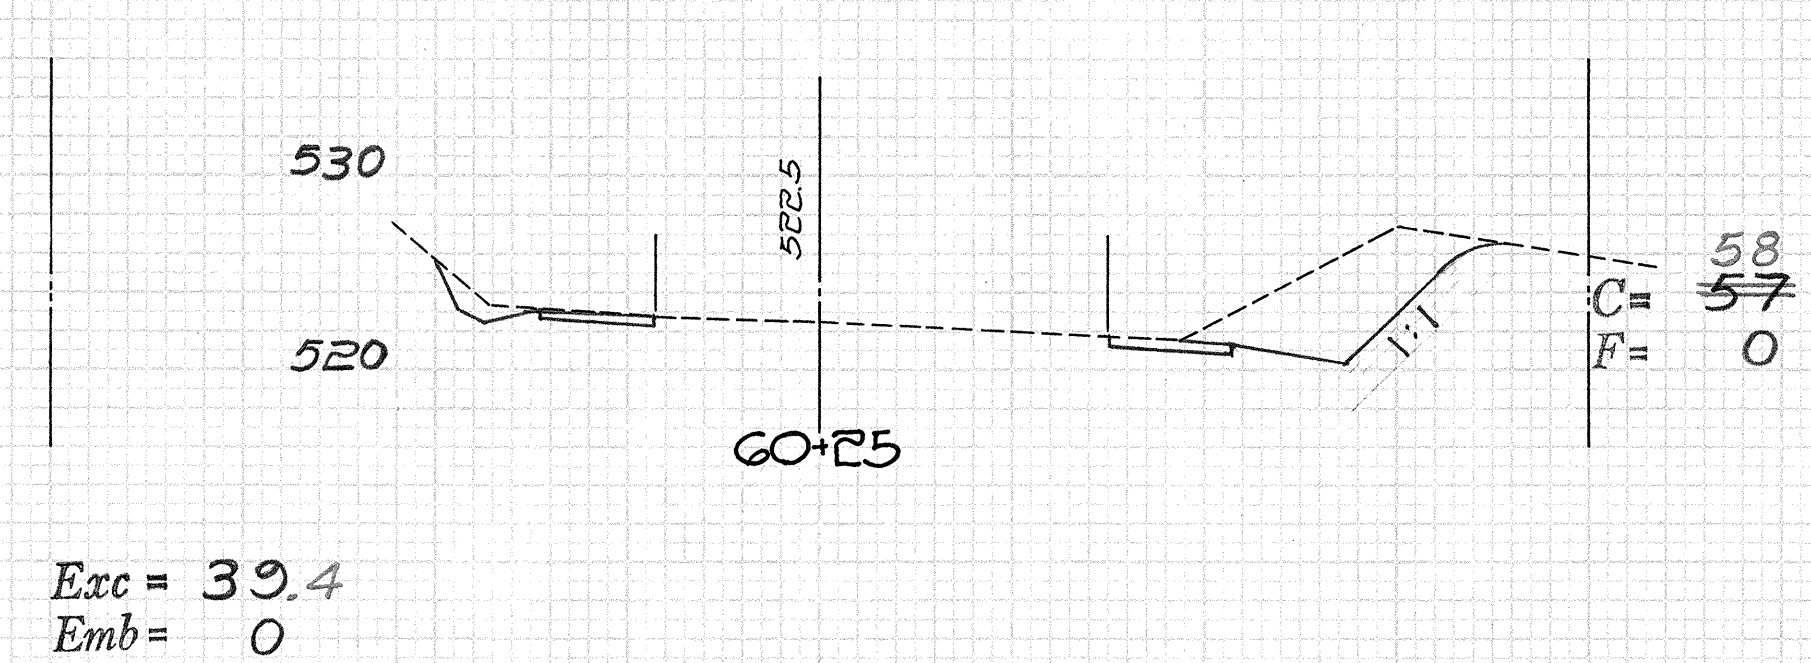
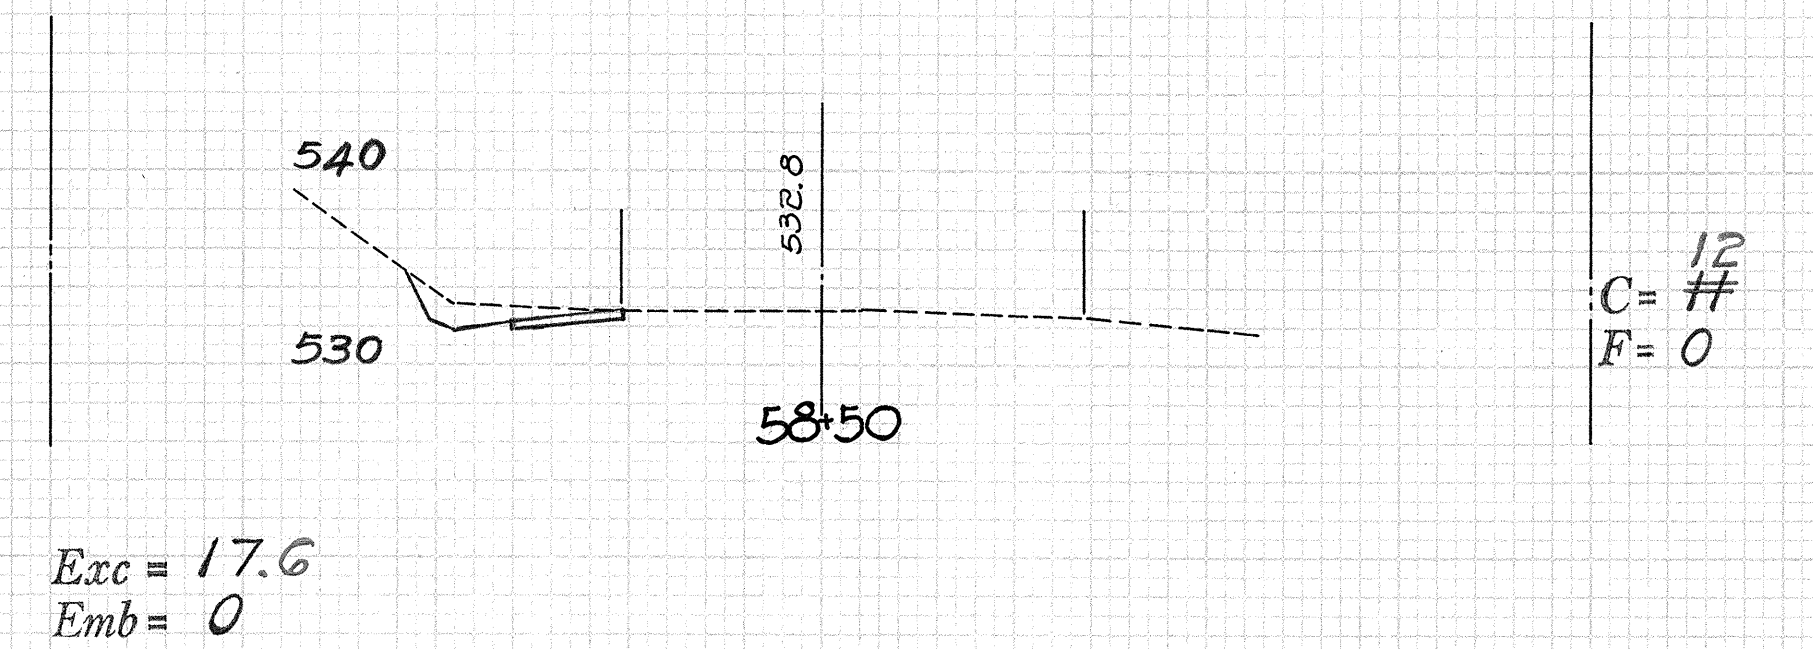
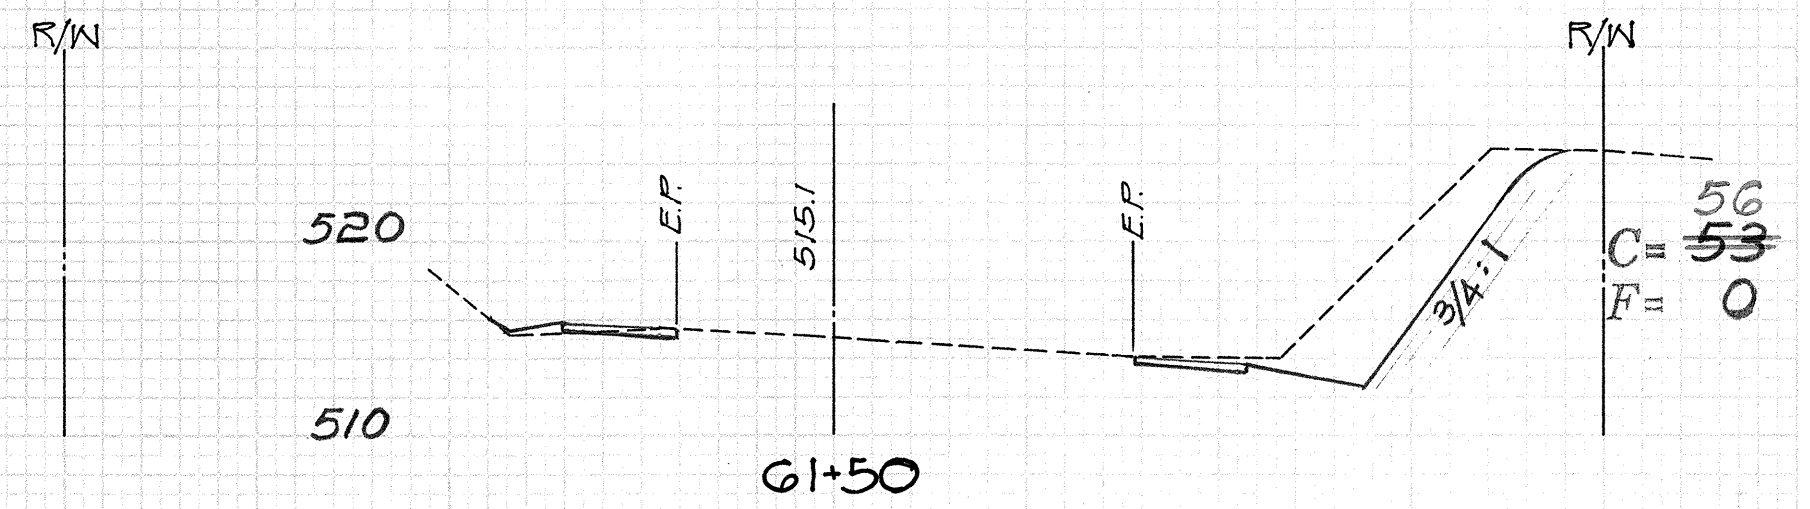
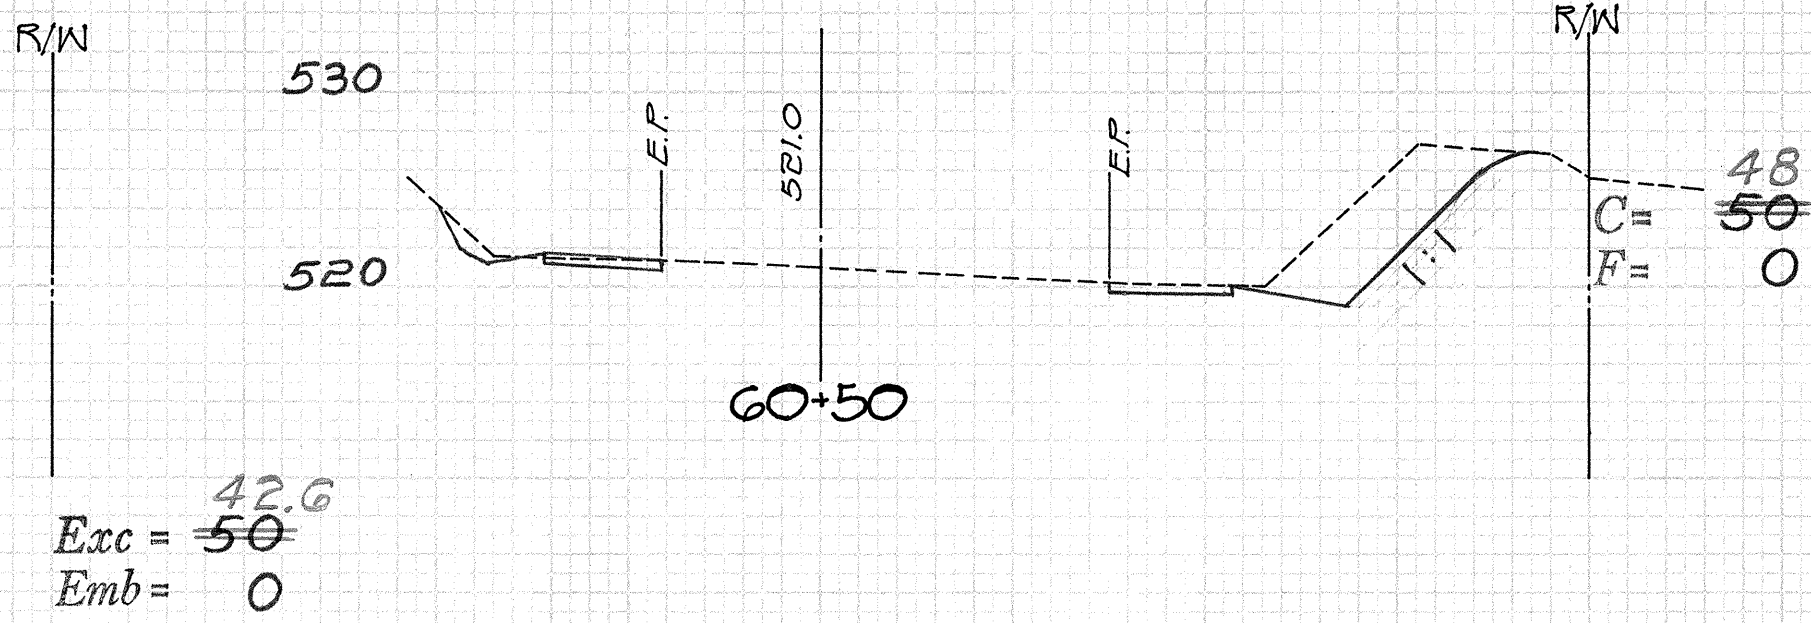


DIST. NO.	STATE	PROJ. NO.	FISCAL YEAR	SHEET NO.	TOTAL SHEETS
HAWAII	HAW.	50C-02-71	1971	6	7

FINAL SURVEY
NOTES
NO. 1

ORIGINAL SURVEY
NOTES
NO. 1

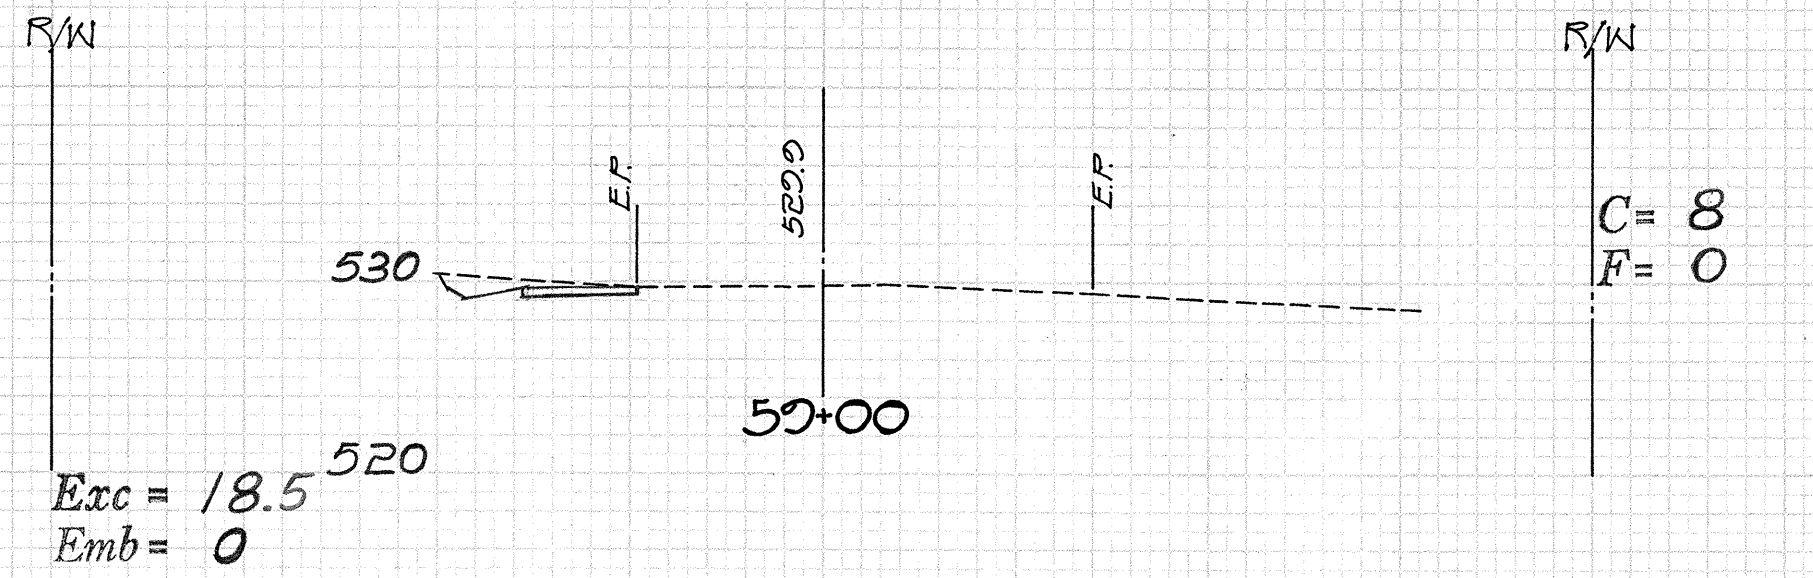

DIST. NO.	STATE	PROJ. NO.	FISCAL YEAR	SHEET NO.	TOTAL SHEETS
HAWAII	HAW.	50C-02-71	1971	7	7

