

INDEX TO DRAWINGS	
SHEET NO.	DESCRIPTION
1	TITLE SHEET
2	TYPICAL SECTION
3	PLAN
4	DROP INTAKE
5	PROJECT INFORMATION SIGN
6-7	CROSS-SECTIONS

Mar.1971

Date

548-2456

Phone-Loc

R. Tsuzuki

PS&E By

Kauai District

Designed By

SURVEY PLOTTED BY	DATE
DESIGNED BY	
TRACED BY	
NOTED BY	
QUANTITIES CHECKED BY	
CHECKED BY	
ORIGINAL PLAN	
NOTE BOOK NO.	

STATE OF HAWAII

DEPARTMENT OF TRANSPORTATION

HIGHWAYS DIVISION

"AS BUILT"

PLANS FOR



KAUMUALII HIGHWAY WEST OF LAWAI BRIDGE

EXCAVATION OF SIDE SLOPES AND SHOULDER STABILIZATION

PROJECT NO. 50C-02-71

DISTRICT OF KOLOA

ISLAND OF KAUAI

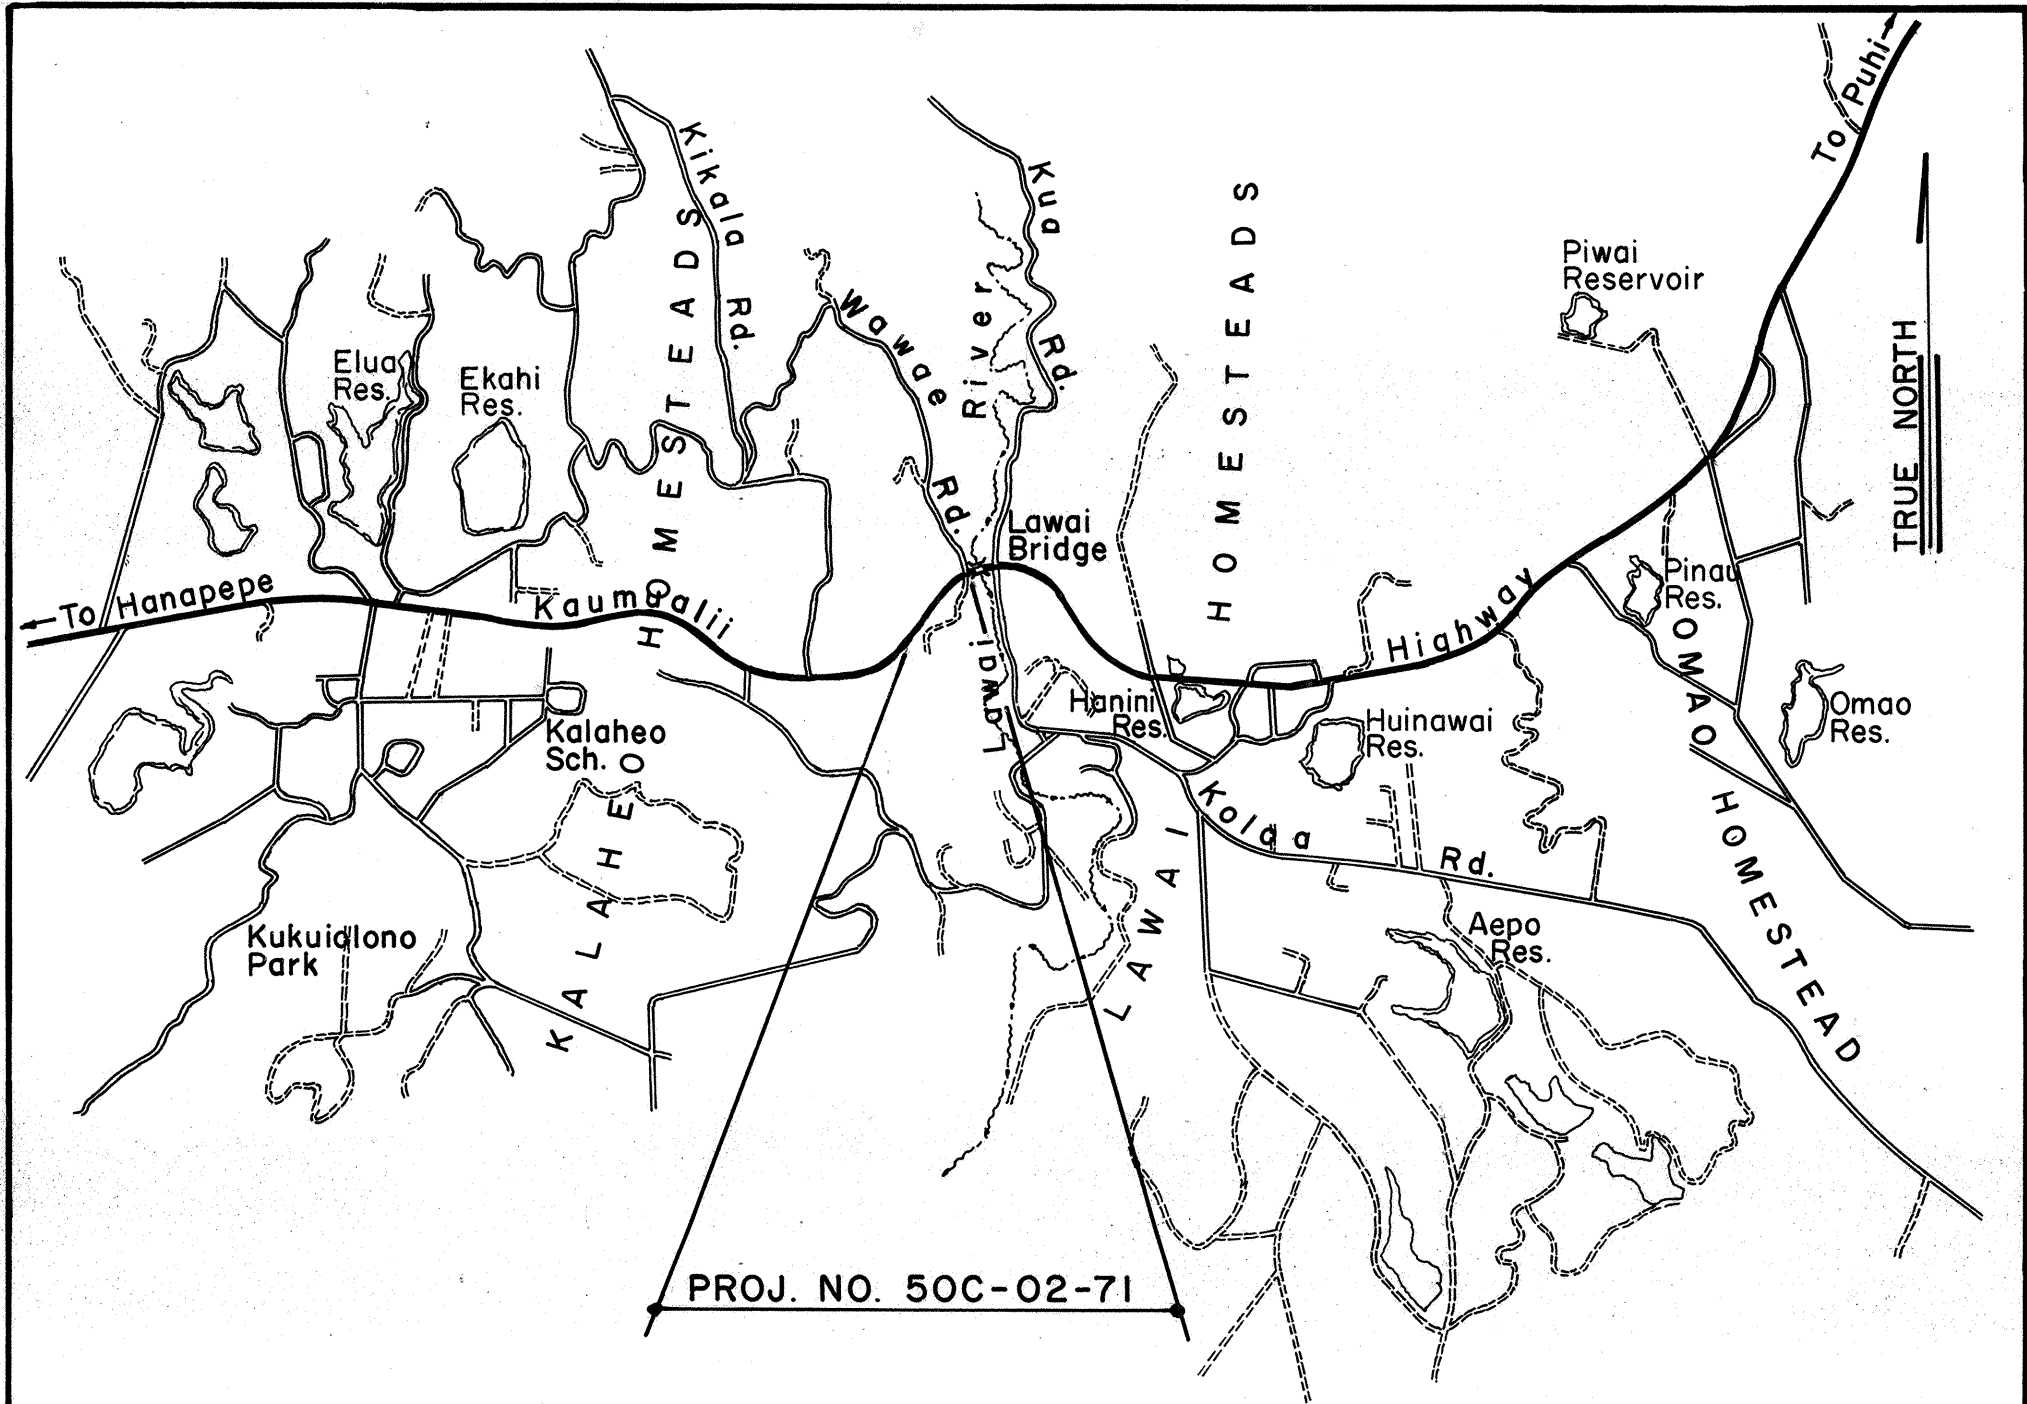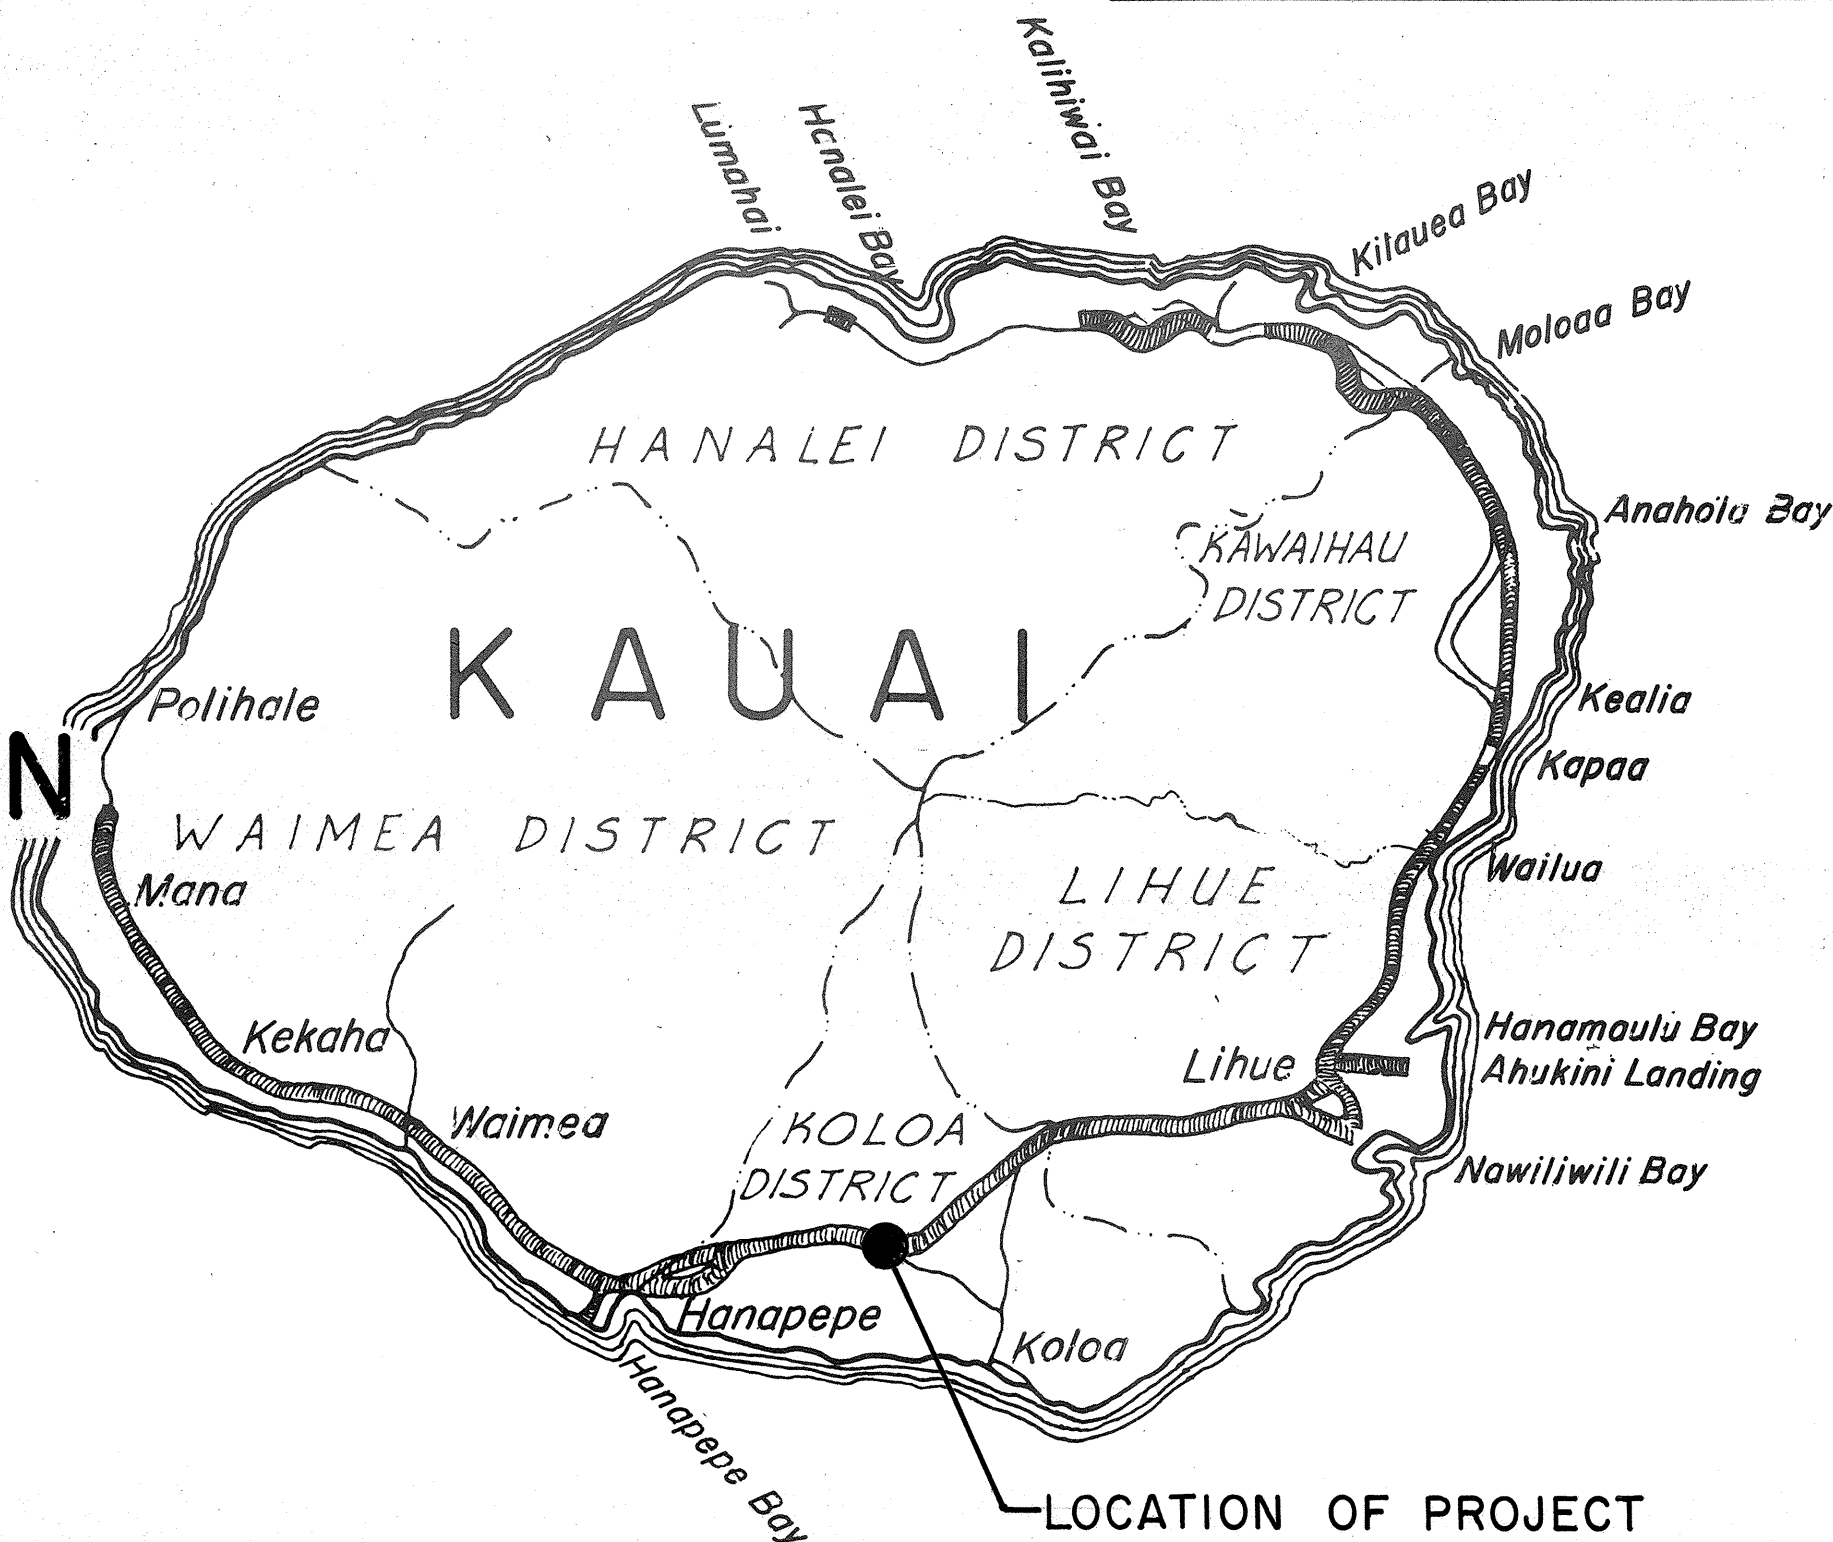

LAYOUT OF PROJECT

Scale: 1" = 2000'

ALL CHANGES MADE DURING CONSTRUCTION HAVE BEEN INCORPORATED ON THESE PLANS IN RED EXCEPT CHANGES IN THE ORIGINAL THEORETICAL QUANTITIES. FOR ACTUAL QUANTITIES, REFER TO PROJECT LEDGER AND/OR COMPUTATION BOOK.

[Signature]

RESIDENT ENGINEER

6-1-81

DATE

DEPARTMENT OF TRANSPORTATION STATE OF HAWAII	
APPROVED:	
<i>G. Alvey Shultz</i>	3/23/71
DIR. OF TRANSPORTATION	DATE