




DIST. NO.	STATE	PROJ. NO.	FISCAL YEAR	SHEET NO.	TOTAL SHEETS
HAWAII	HAW.	50A-01-72	1972	4	7

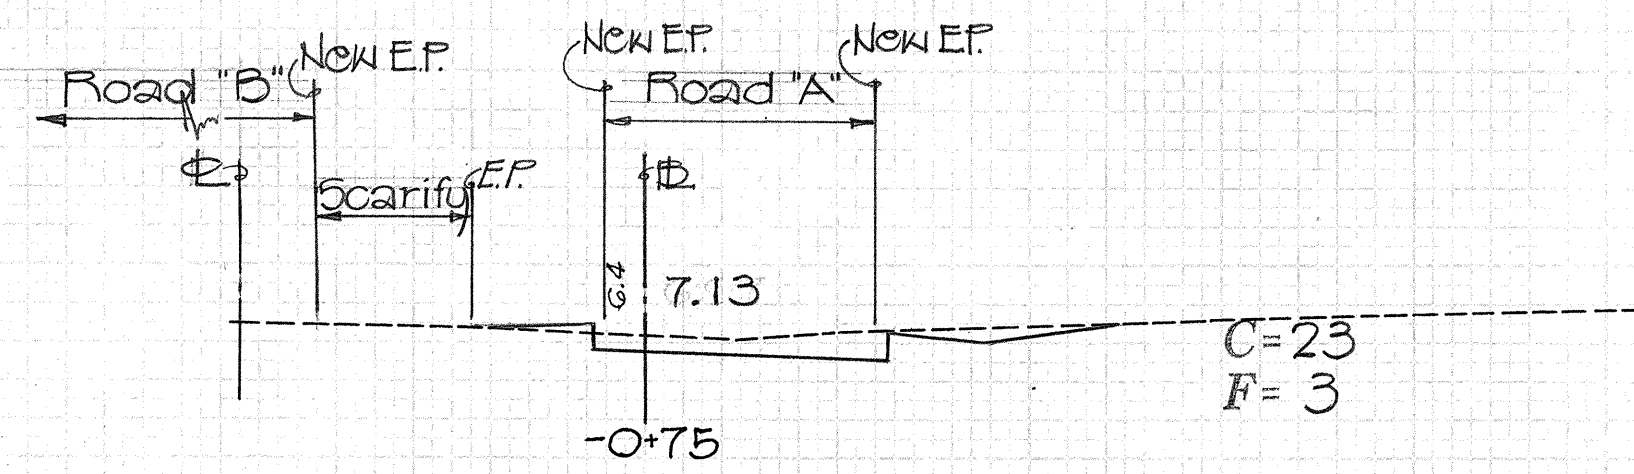


Exc = 14
Emb = 2

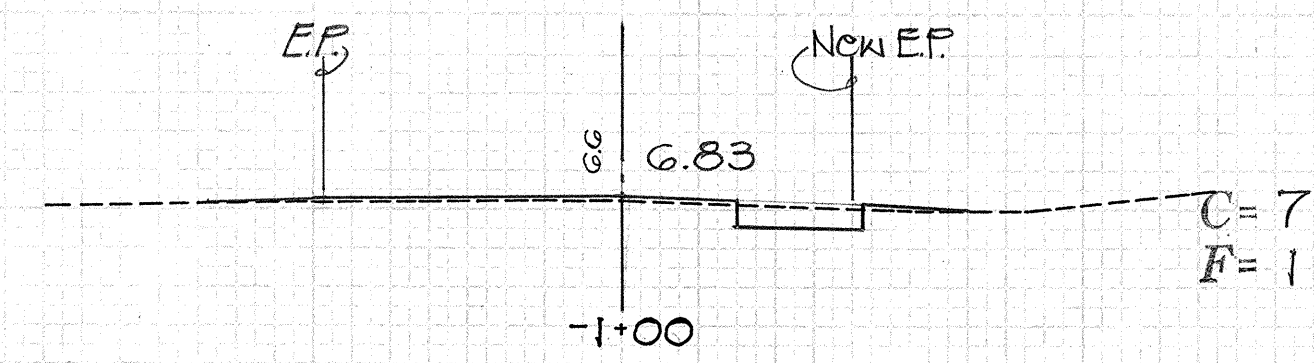


Exc = 5
Emb = 0

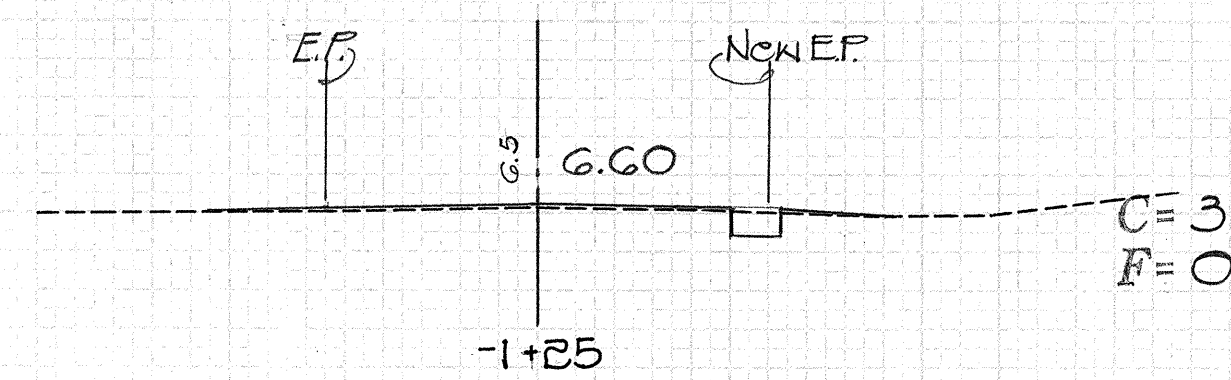


Exc = 1
Emb = 0

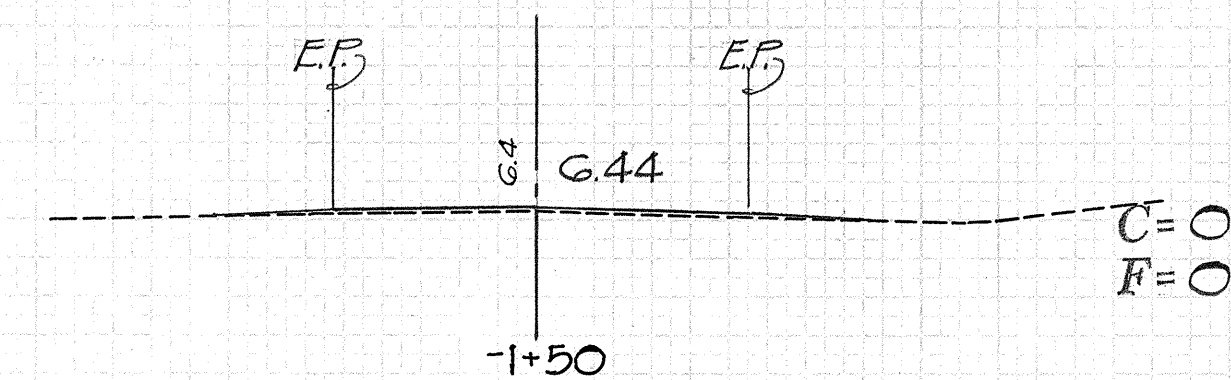

Exc = 0
Emb = 0

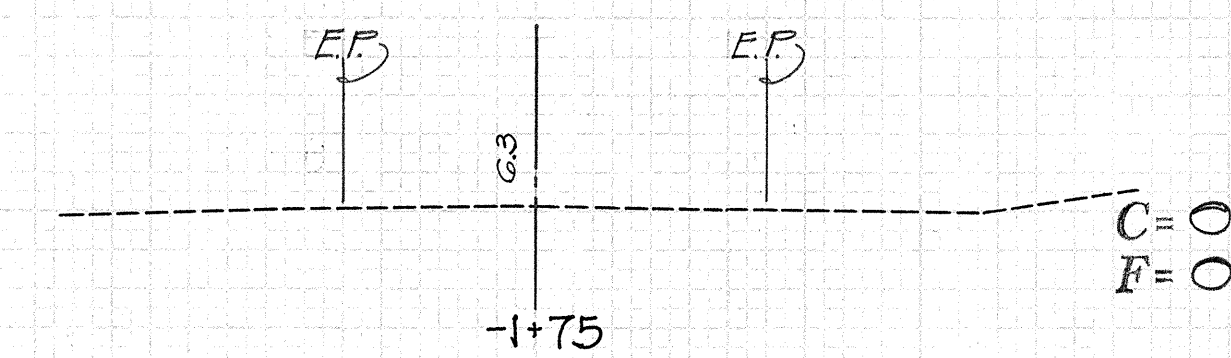

80 10 0 10 80

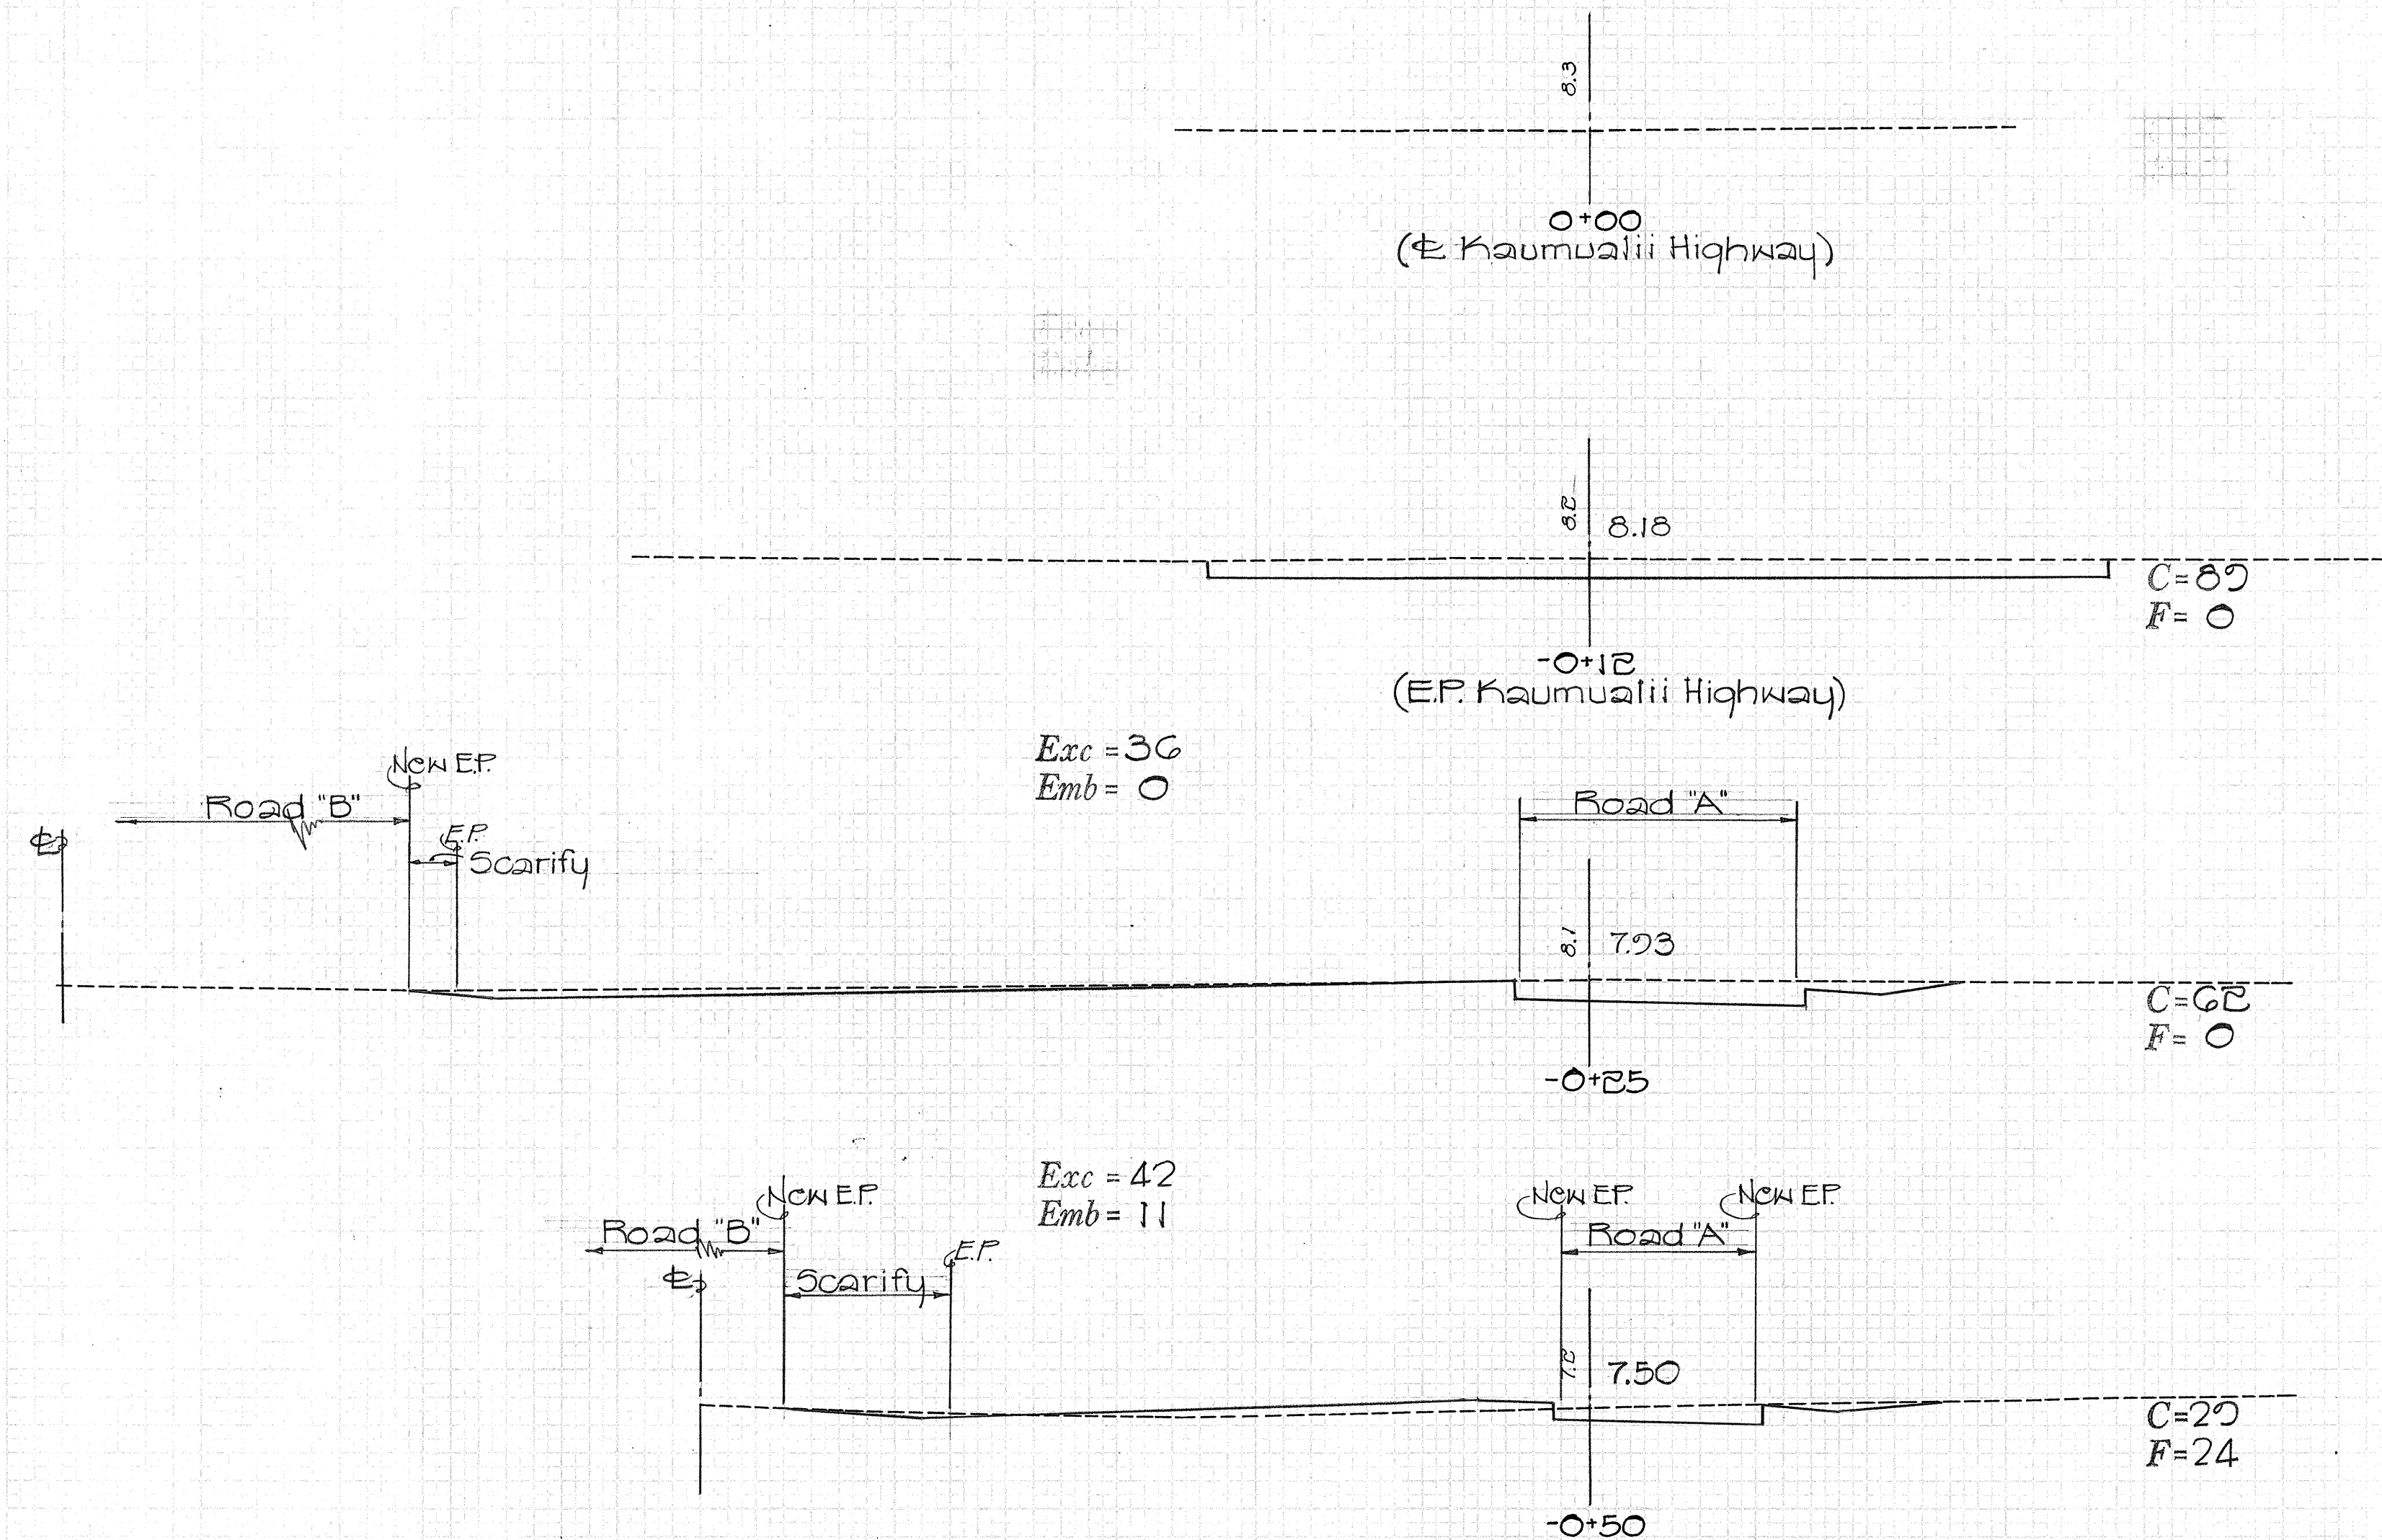

Exc = 36
Emb = 0

Exc = 42
Emb = 11

Exc = 24
Emb = 13

60 50 40 30 20 10 0 10 20 30