
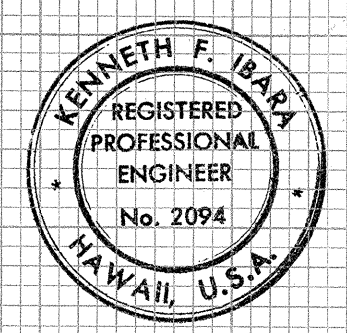
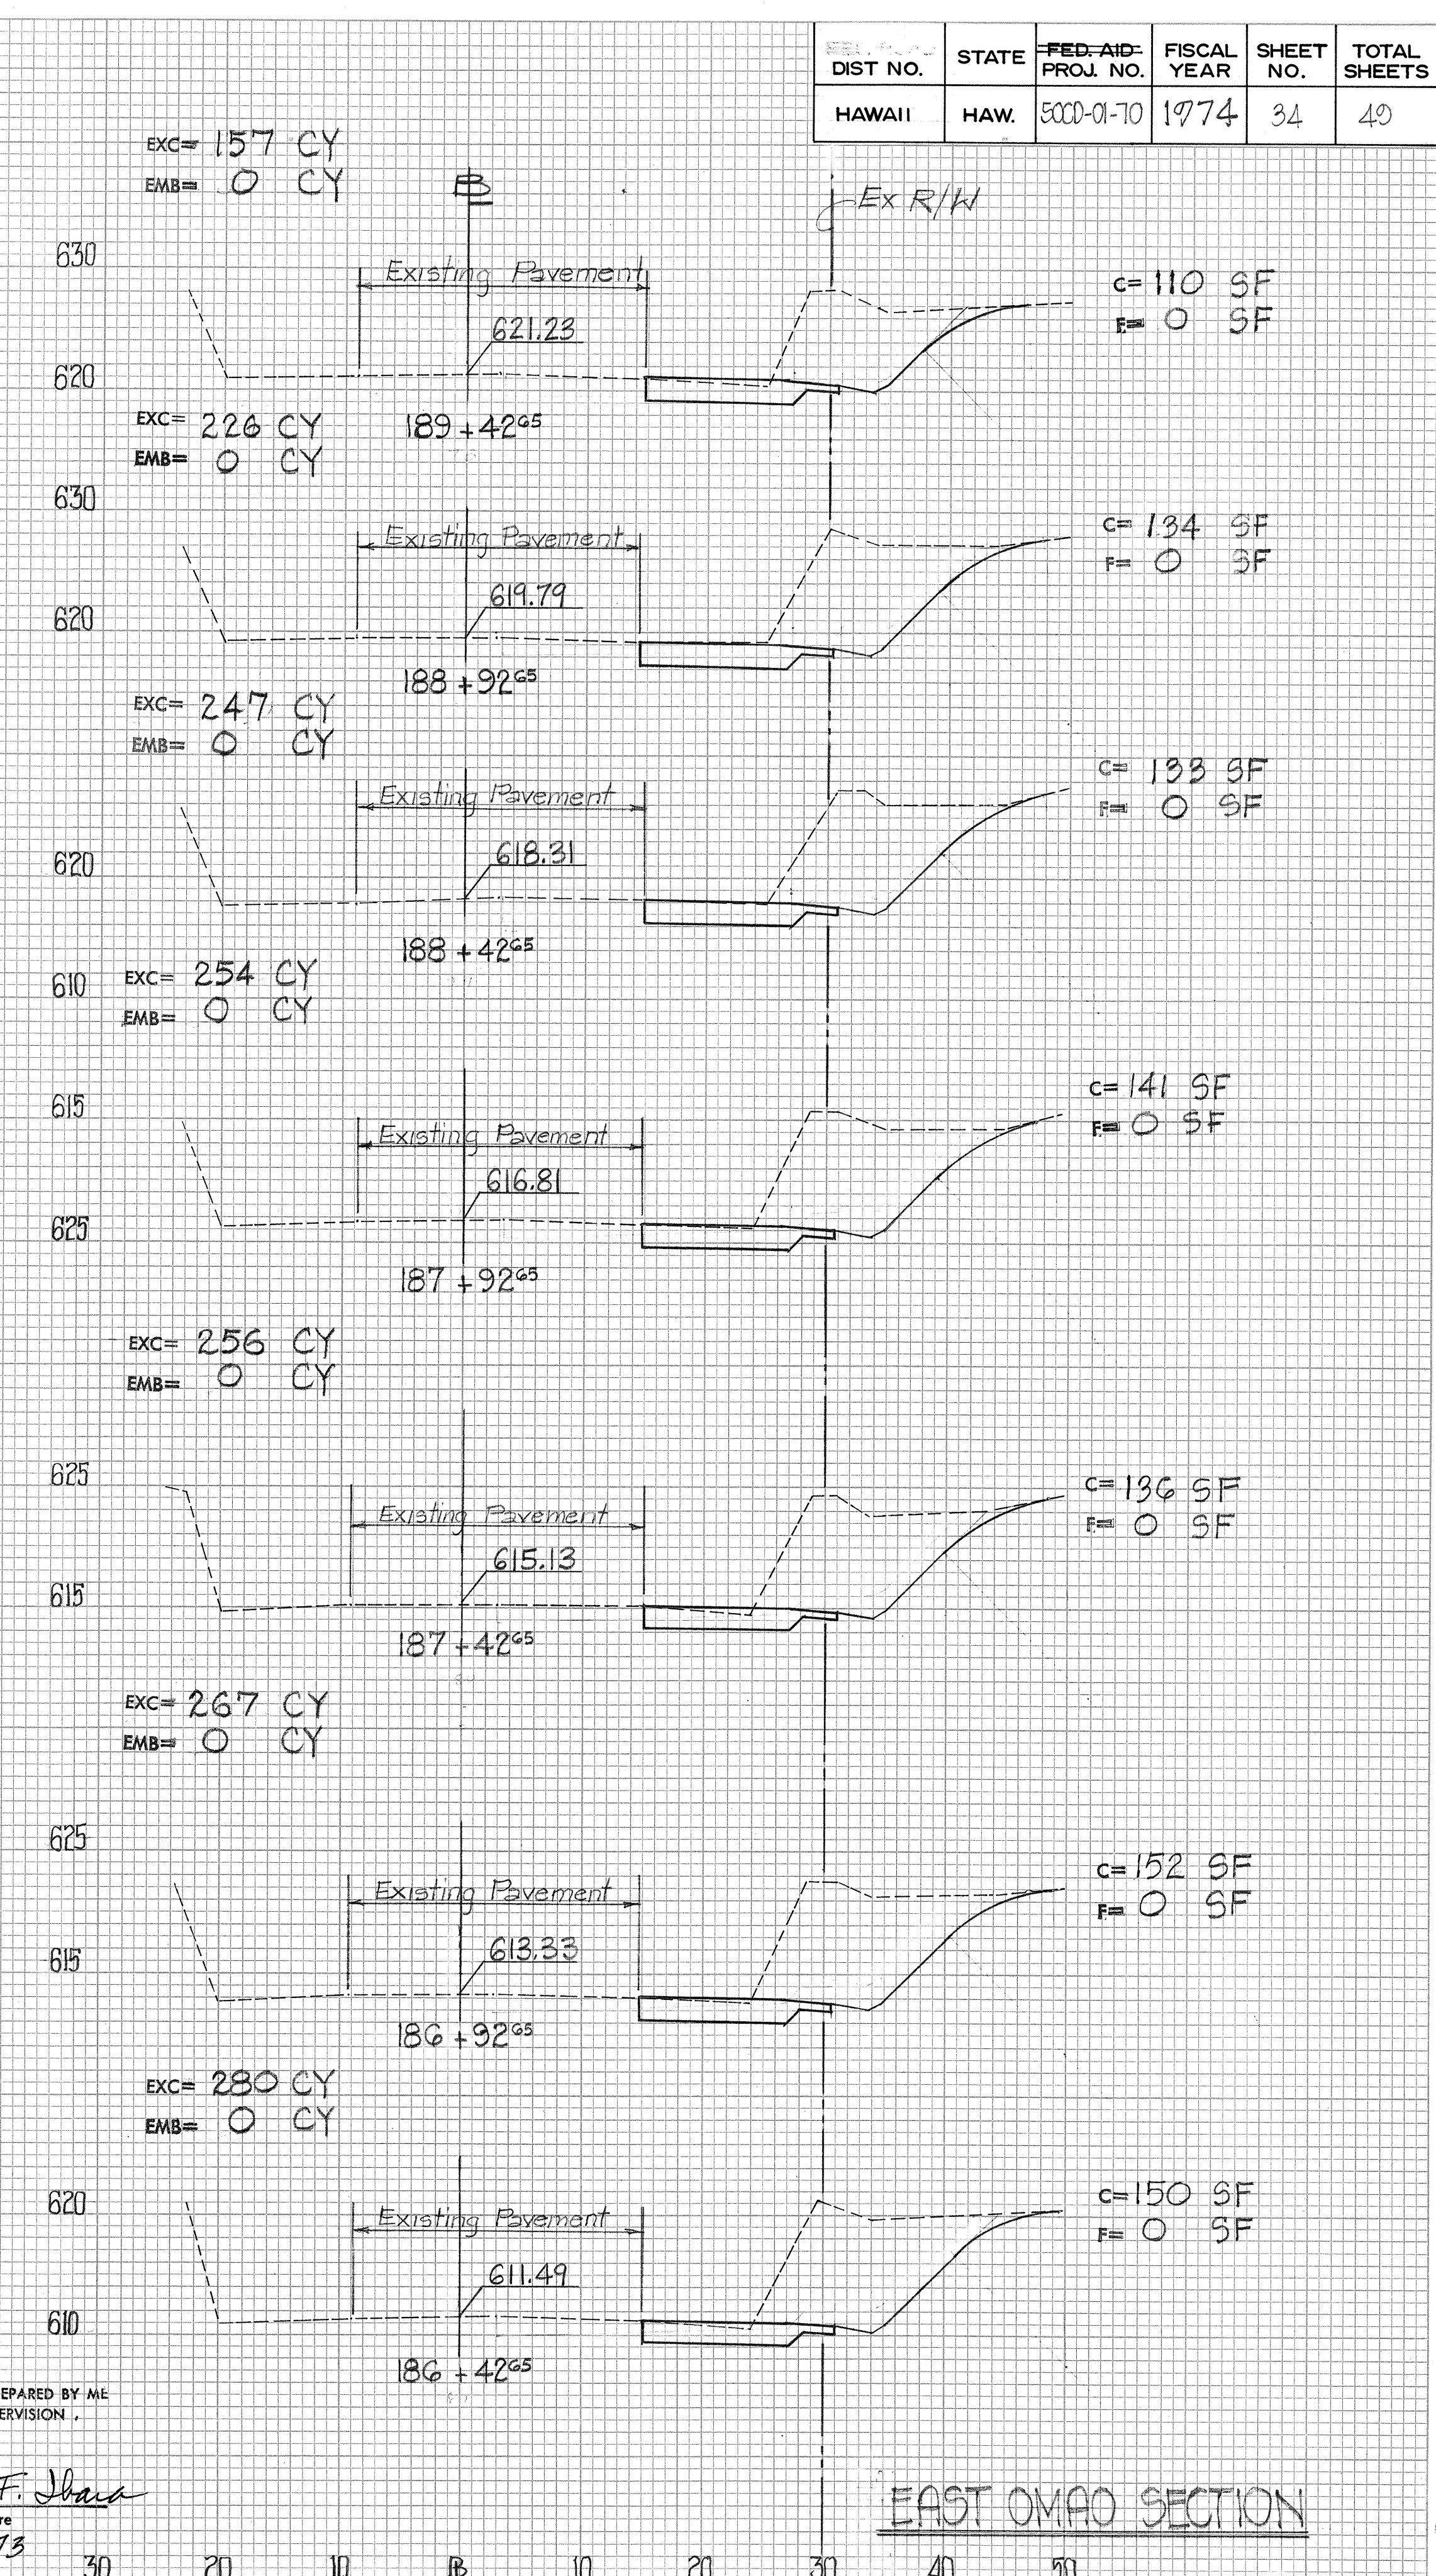
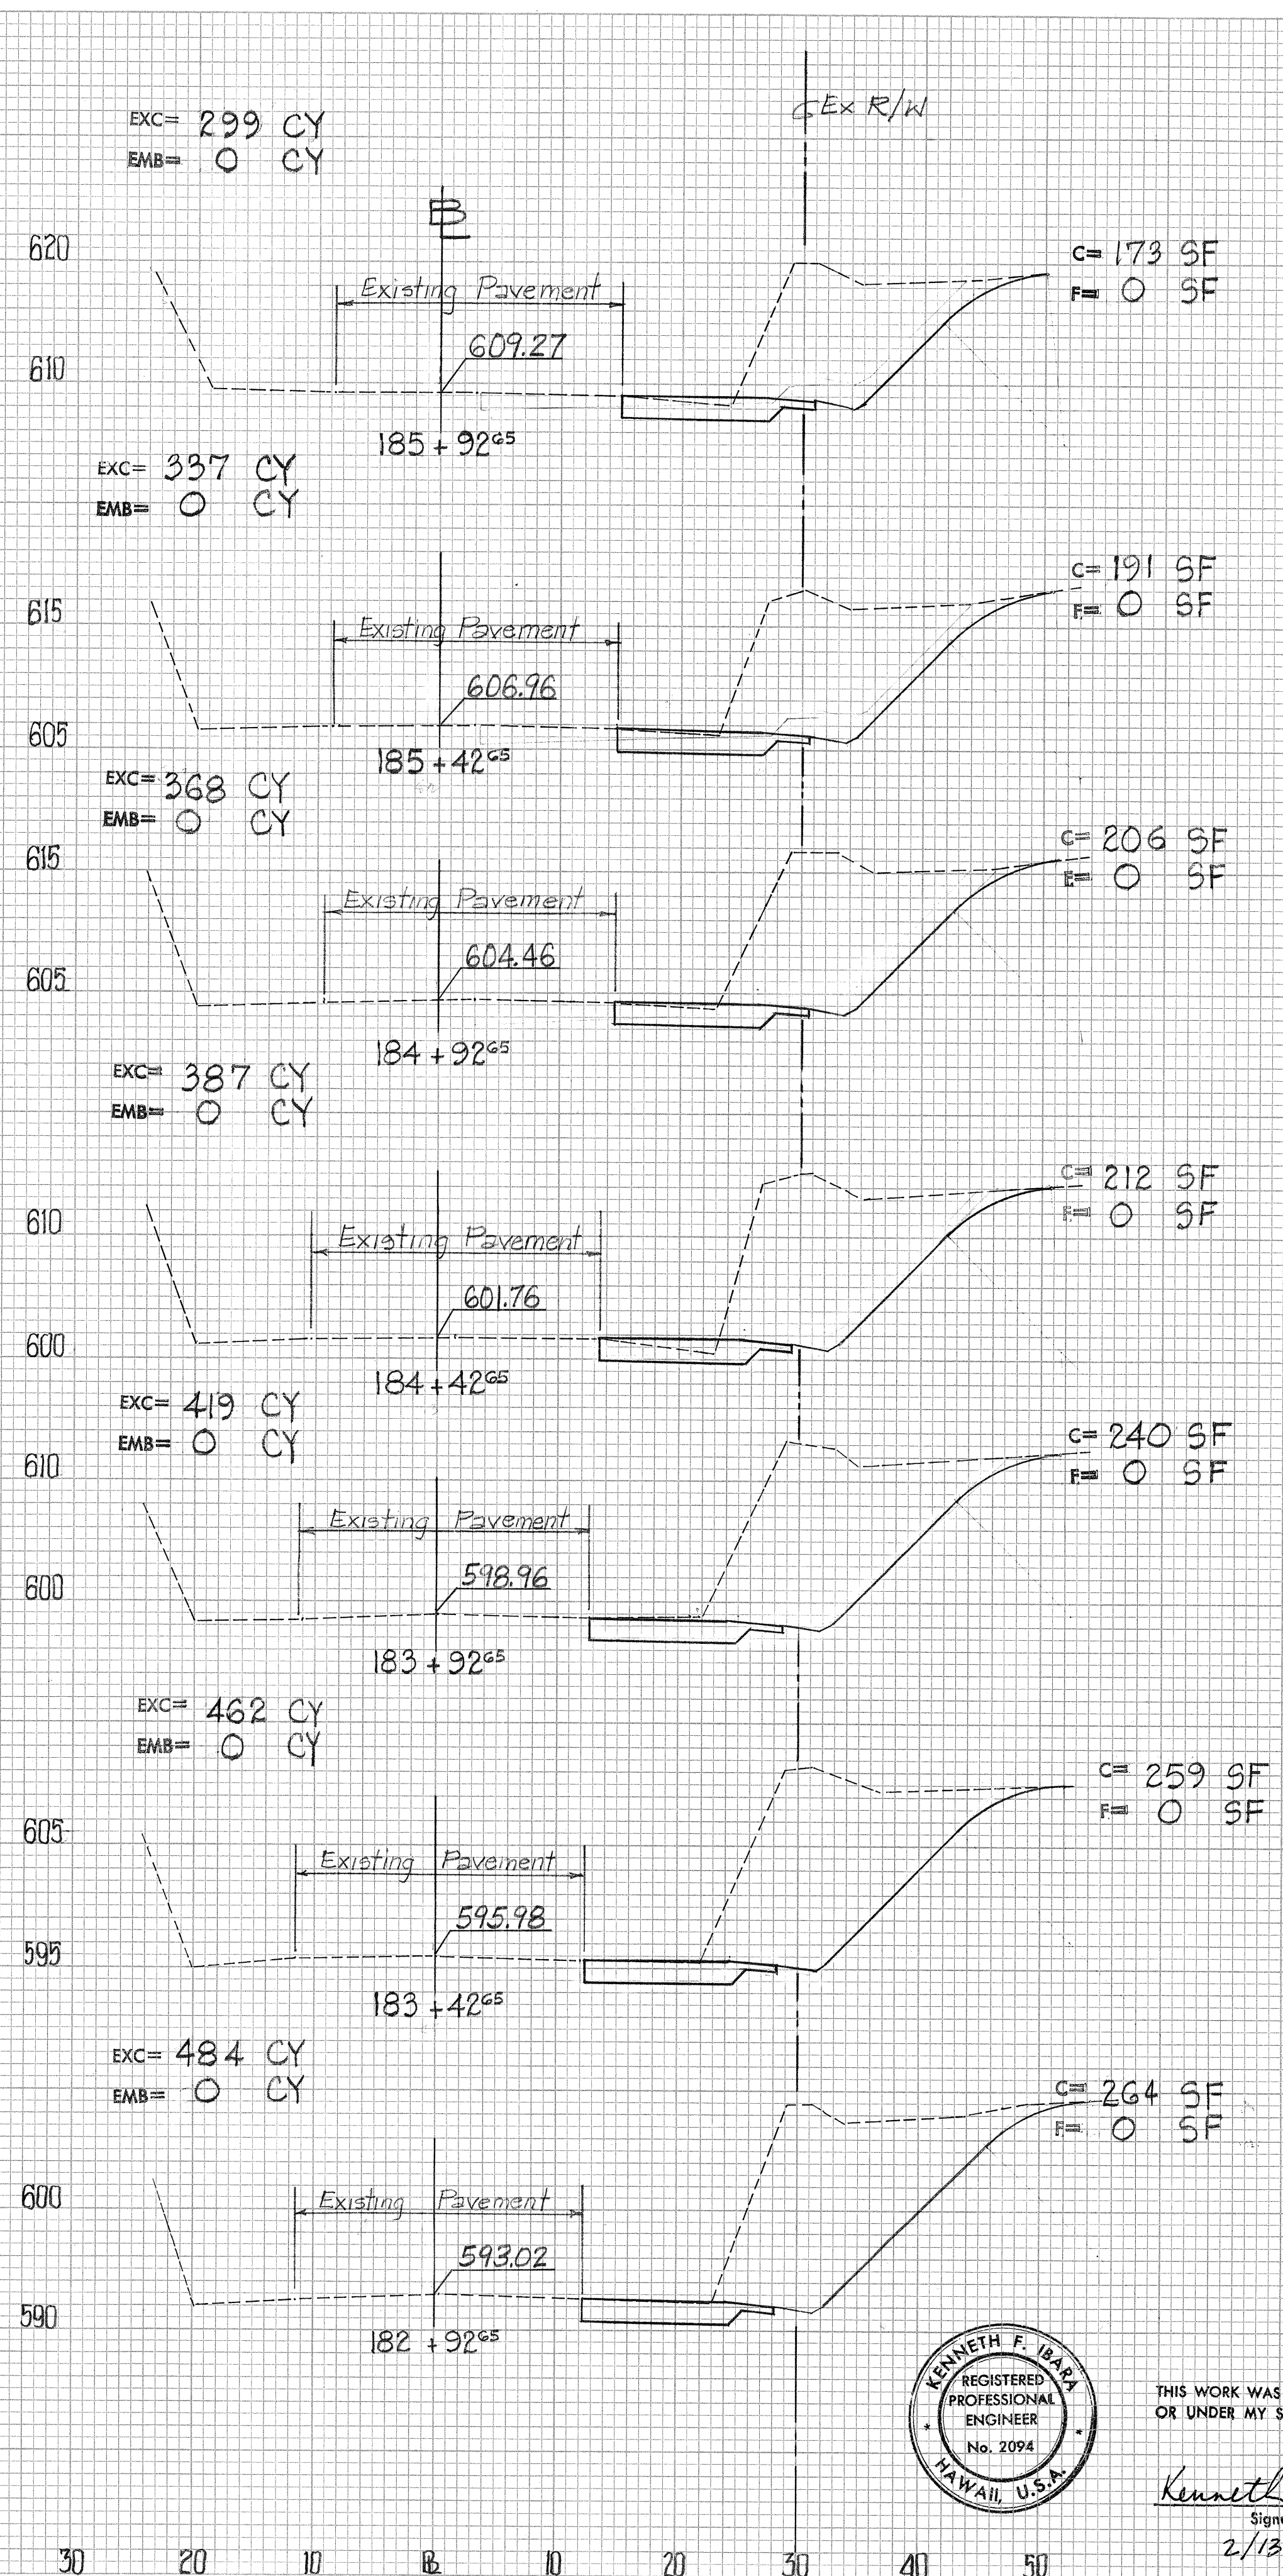


DIST. NO.	STATE	FED. AID PROJ. NO.	FISCAL YEAR	SHEET NO.	TOTAL SHEETS
HAWAII	HAW.	5000-01-10	1974	34	40

FINAL SURVEY	DATE
SURVEYED	BY
PLOTTED	DATE
NOTE BOOK	NO.
AREAS CHECKED	

ORIGINAL SURVEY	DATE
SURVEYED	BY
PLOTTED	DATE
NOTE BOOK	NO.
AREAS CHECKED	

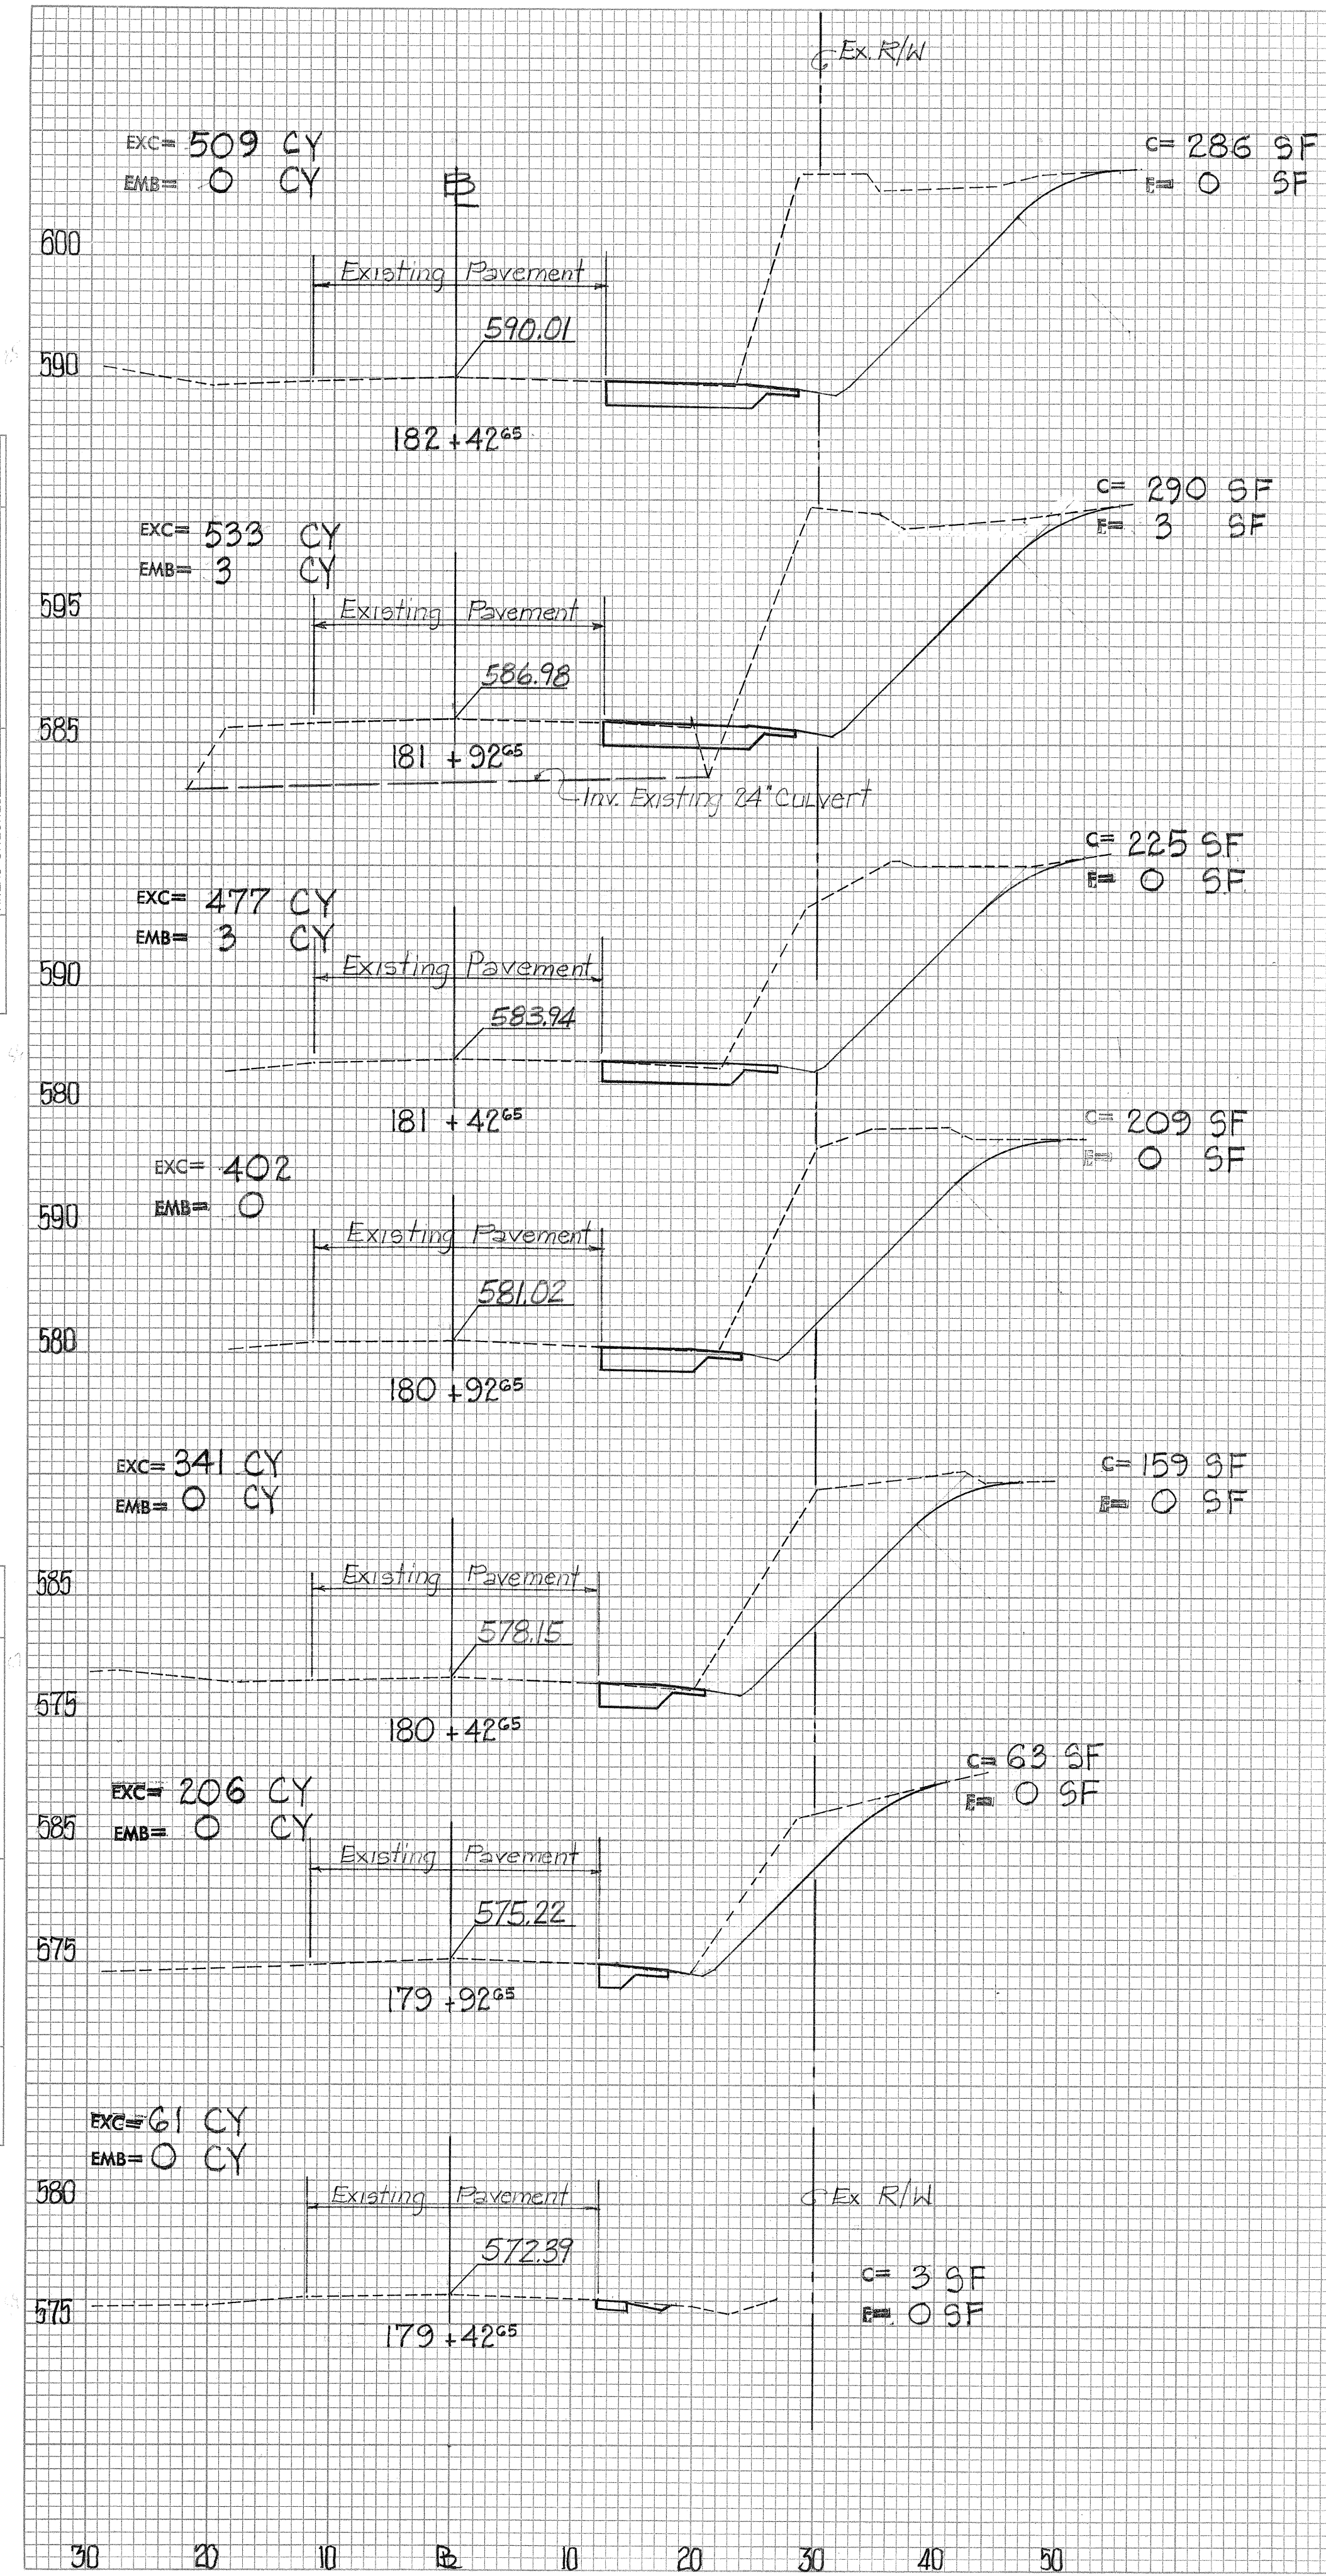

THIS WORK WAS PREPARED BY ME OR UNDER MY SUPERVISION.

Kenneth F. Ibara
Signature
2/13/73

EAST OMAO SECTION

33 41


DIST. NO.	STATE	FED-AID- PROJ. NO.	FISCAL YEAR	SHEET NO.	TOTAL SHEETS
HAWAII	HAW.	50CD-01-70	1974	35	49



THIS WORK WAS PREPARED BY ME
OR UNDER MY SUPERVISION.
Kenneth F. Hana
Signature
2/13/73

DATE
BY
FINAL SURVEY
SURVEYED
PLOTTED
NOTE BOOK
AREAS CHECKED

DATE
BY
ORIGINAL SURVEY
SURVEYED
PLOTTED
NOTE BOOK
AREAS CHECKED

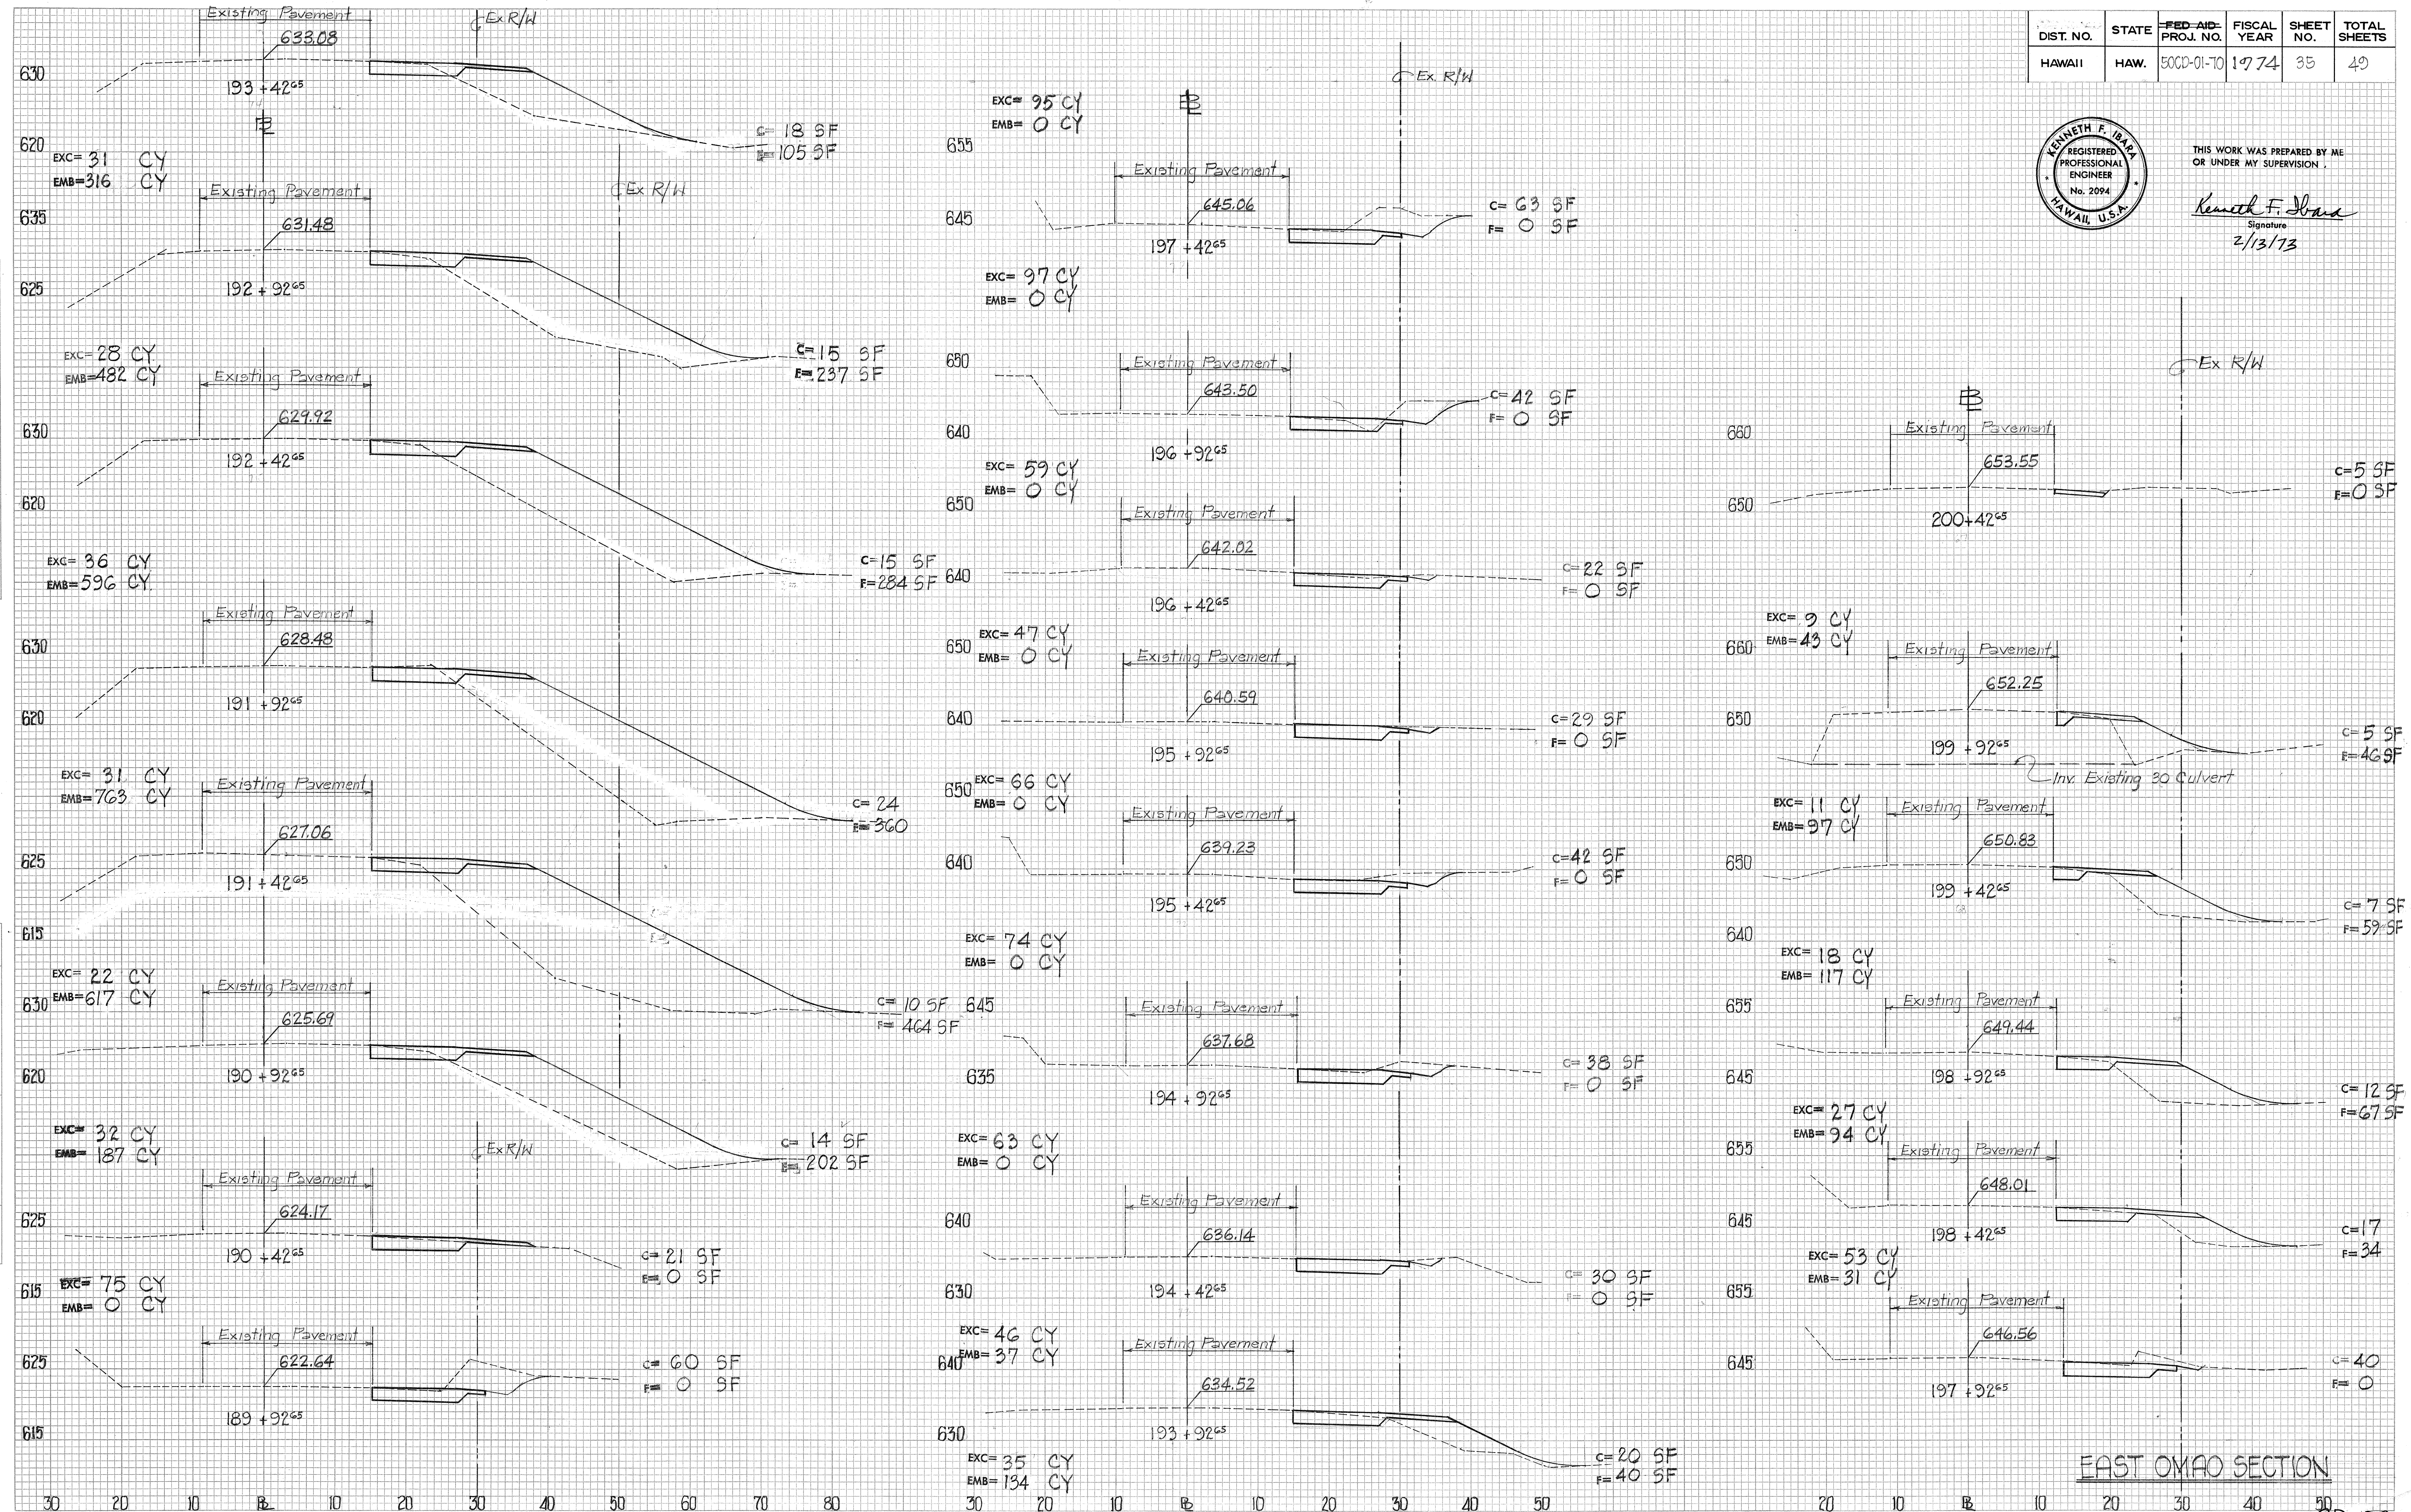

EAST OMAO SECTION