
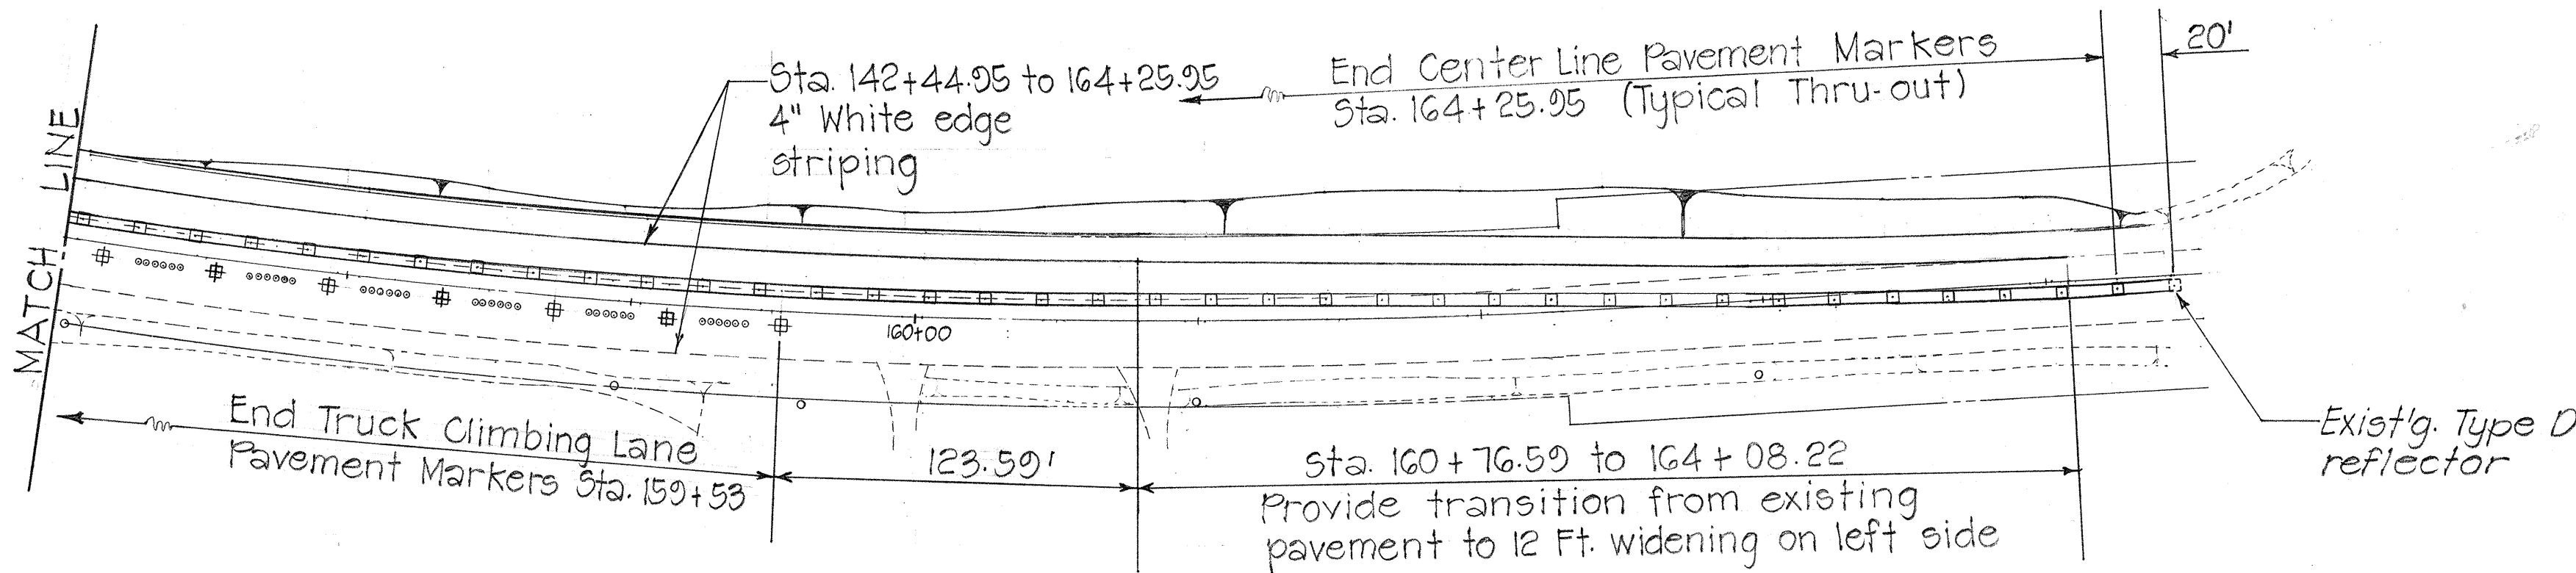


DIST. NO.	STATE	FED. AID PROJ. NO.	FISCAL YEAR	SHEET NO.	TOTAL SHEETS
HAWAII	HAW.	50CD-01-70	1974	26	49

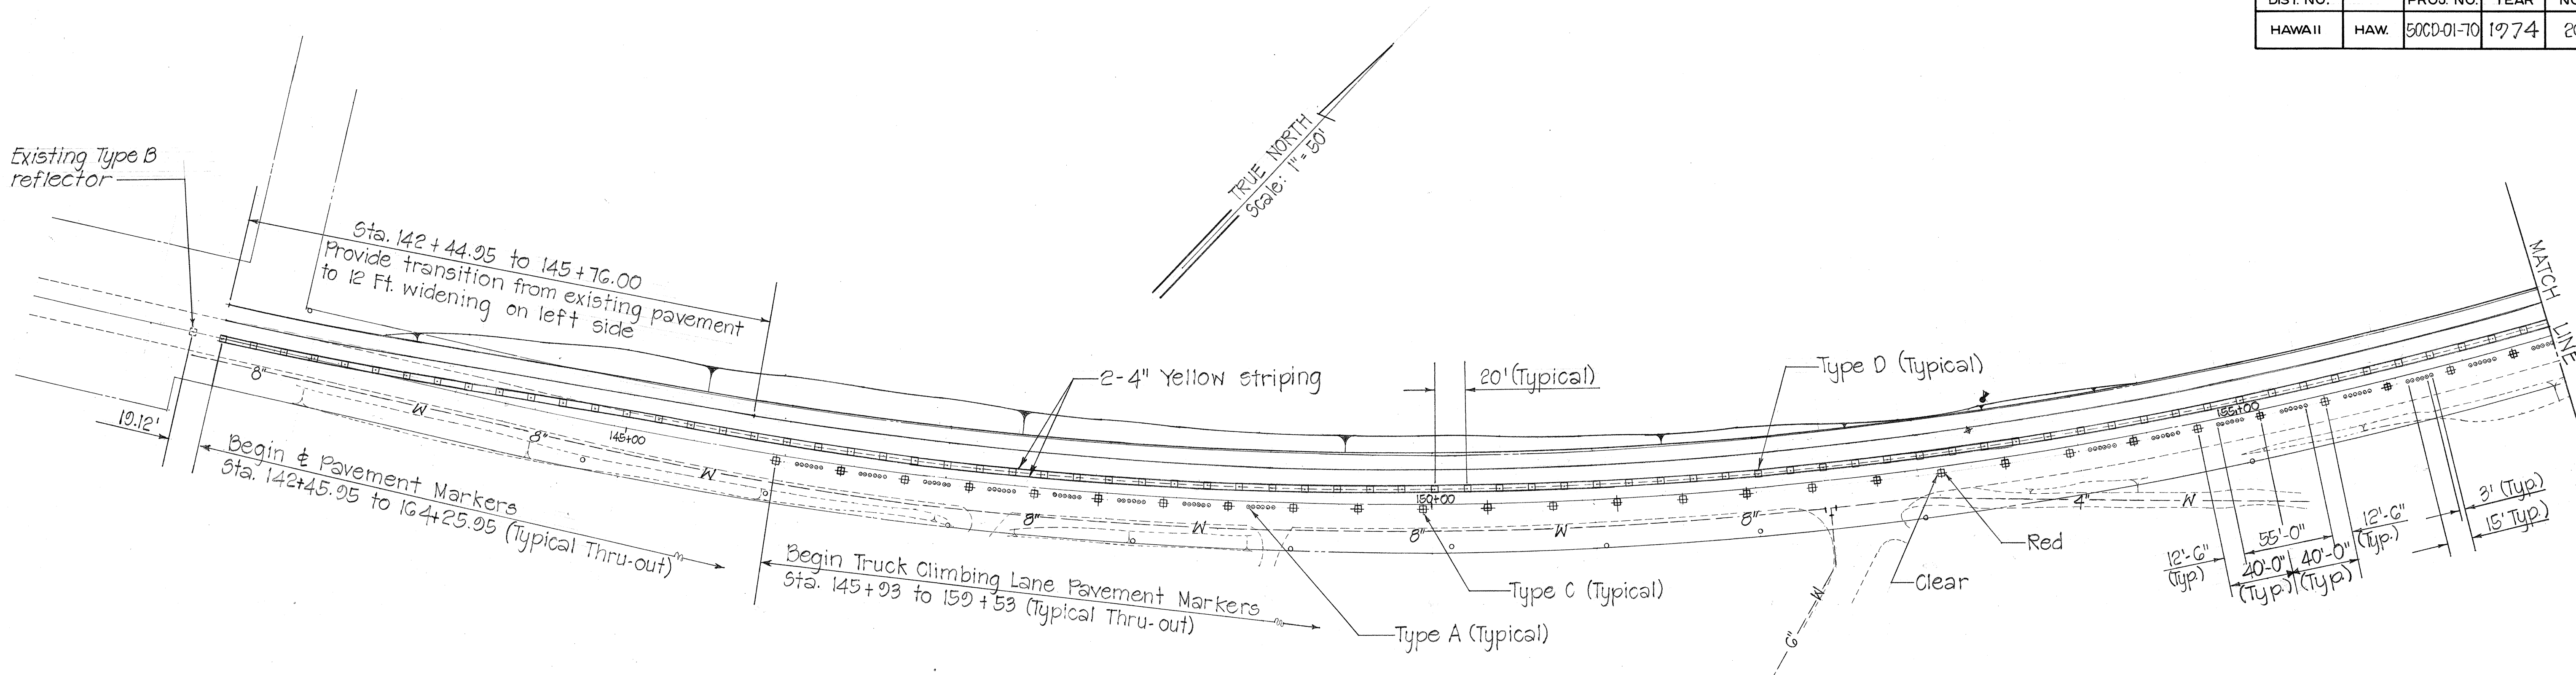


SUMMARY OF RAISED PAV'T MARKERS WEST OMAO SECTION				
STATION	MARKING	QUANTITY		
		TYPE A	TYPE C	TYPE D
142+45.95 to 164+25.95	Centerline	—	—	110-107
	Trucklane	228-204	39-35	—

NOTE:

All Electrical, Telephone, and T.V. Cable works shall be done by the Kauai Electric, Hawaiian Telephone Co., and Derby Cable Vision, respectively.

3-22-74	ADD. NO. 1 Note for Electrical, Telephone and T.V. Cable works.
DATE	REVISION

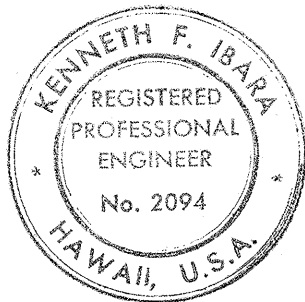

THIS WORK WAS PREPARED BY ME OR UNDER MY SUPERVISION,
Kenneth F. Ibara
Signature
2/13/73

STATE OF HAWAII DEPARTMENT OF TRANSPORTATION HIGHWAYS DIVISION PAV'T. MARKER & UTILITY RELOCATION PLAN WEST OMAO SECTION TRUCK CLIMBING LANES AT THREE LOCATIONS (WAHIAWA, LAWAI AND OMAO VALLEYS) PROJ. NO. 50 CD-01-70 SHEET No. OF SHEETS
--