

GENERAL NOTES: (EAST OMAO SECTION)

1. All work for new swales, canefield roads and ditches in canefield areas shall be coordinated with Grove Farm Co., Inc.
2. Standard Construction Signs shall be provided at both ends of the project site.


T.M.K. 2-7-01:1 Lot 50
A.F. Knudsen Trust
Bishop Trust Co., Ltd. - Tr.
Eric A. Knudsen Trust
Bishop Trust Co., Ltd. &
Yaldemar L. Knudsen - Trs.
(Owners)
(Grove Farm Co., Inc.) le.

E CURVE DATA



$\Delta = 9^\circ 37' 30''$
 $R = 4000.00'$
 $Ch = 671.16'$
 $Lc = 671.95'$
 $T = 336.77'$

DIST. NO.	STATE	FED. AID PROJ. NO.	FISCAL YEAR	SHEET NO.	TOTAL SHEETS
HAWAII	HAW.	50CD-01-70	1974	29	40

PLAN
SURVEYED
PLOTTED
CHECKED
DATE
BY
NO.

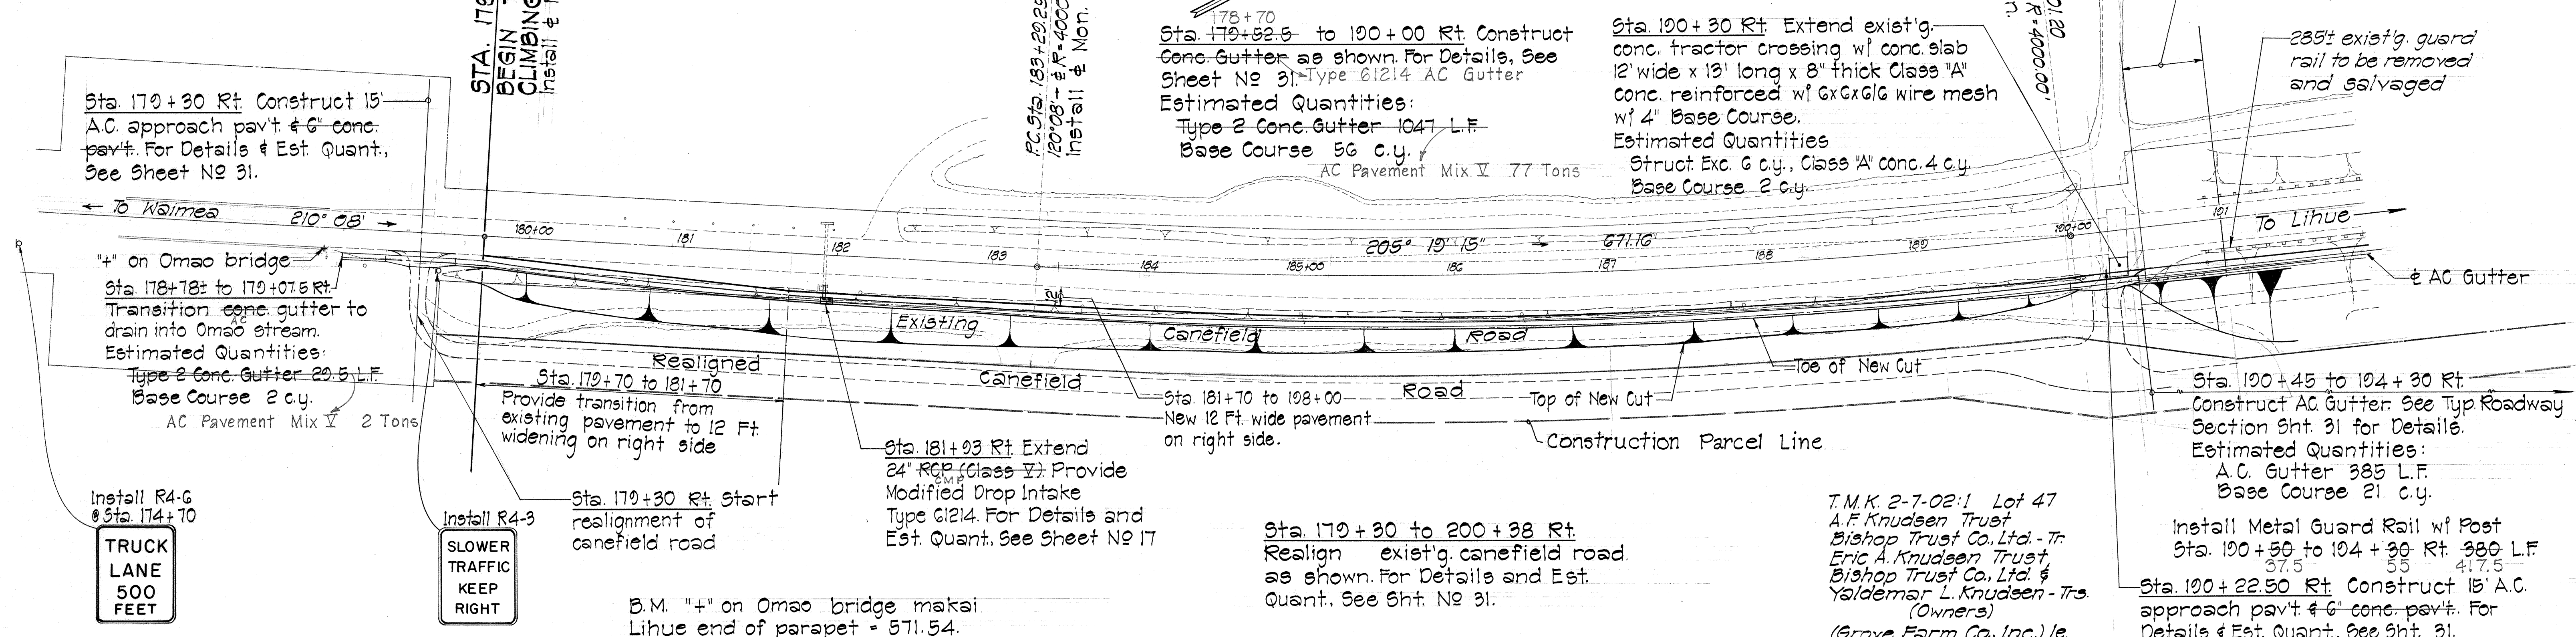

PROFILE
SURVEYED
PLOTTED
CHECKED
DATE
BY
NO.

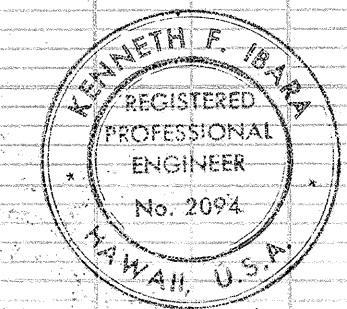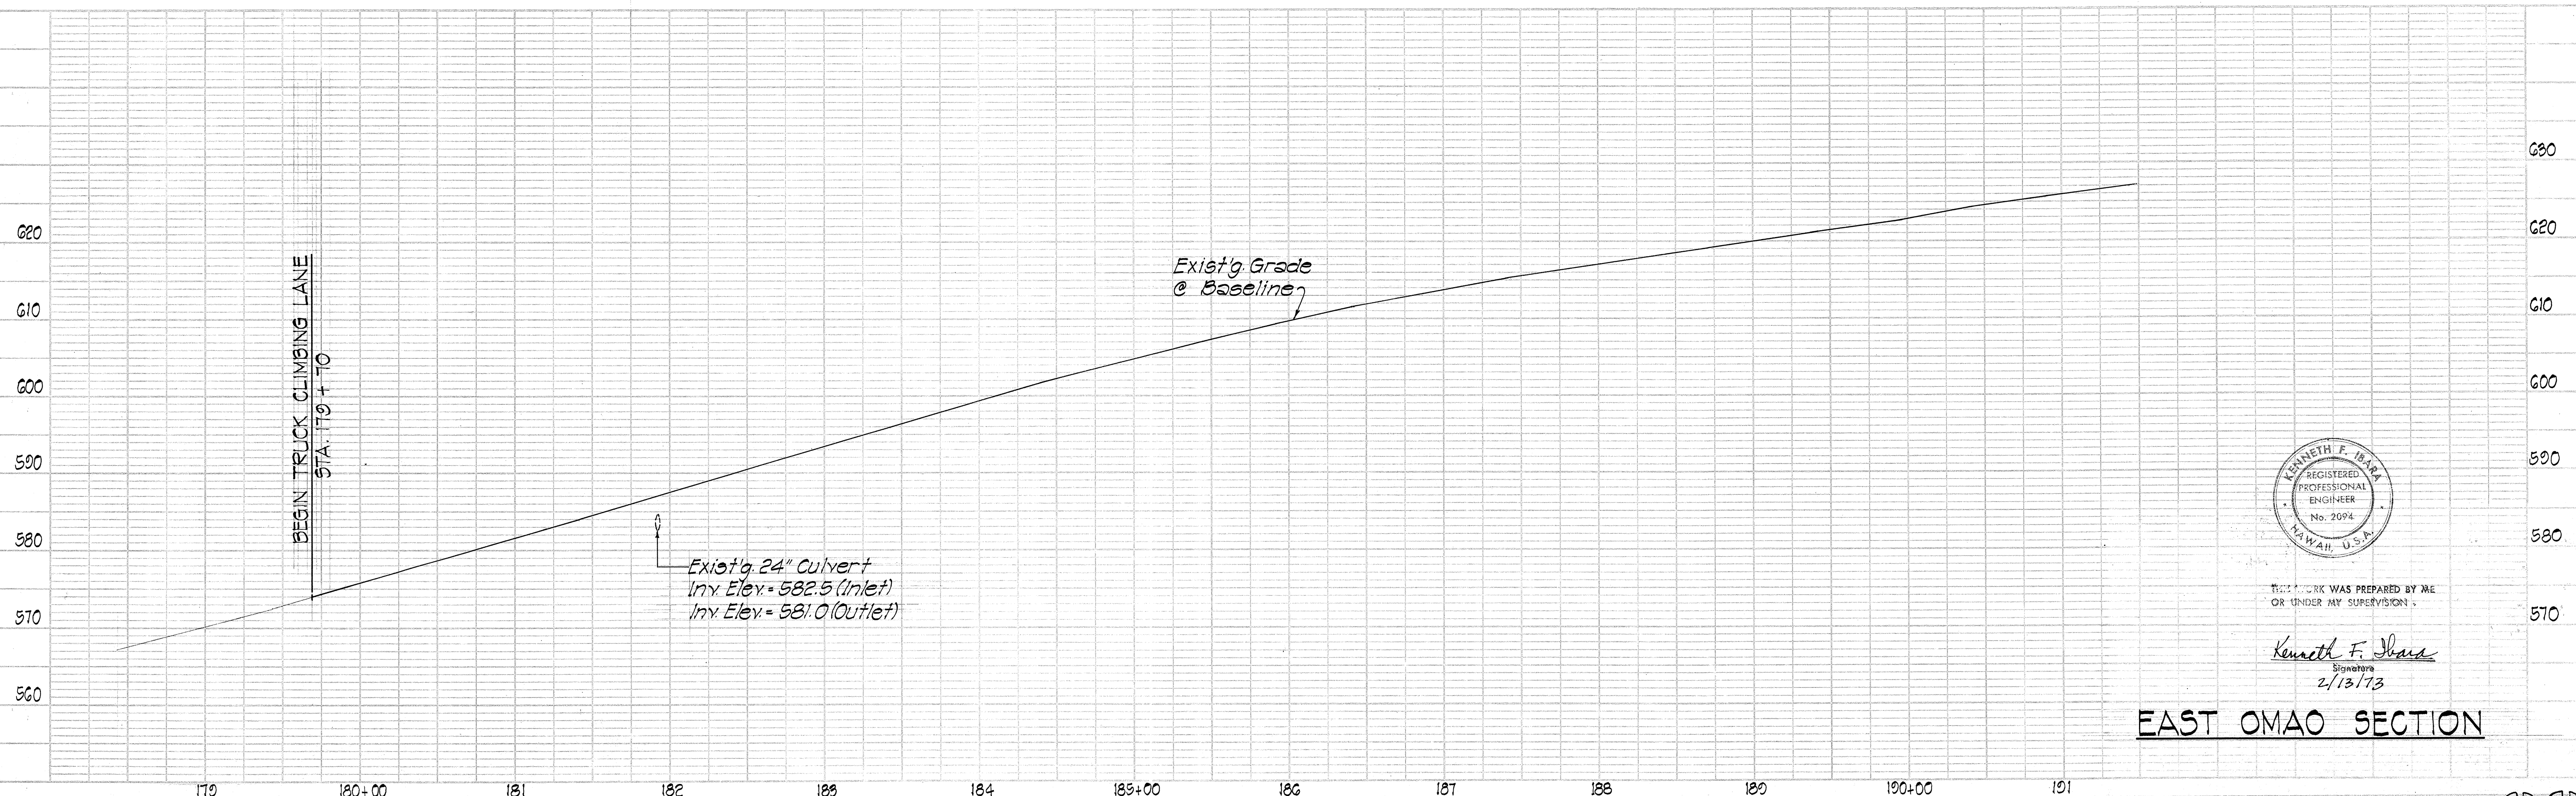

THIS WORK WAS PREPARED BY ME OR UNDER MY SUPERVISION
Kenneth F. Hara
2/13/73

EAST OMAO SECTION

