


| PLAN     | DATE | BY | NO. |
|----------|------|----|-----|
| DESIGNED |      |    |     |
| PLOTTED  |      |    |     |
| CHECKED  |      |    |     |
| NO.      |      |    |     |

| PROFILE  | DATE | BY | NO. |
|----------|------|----|-----|
| DESIGNED |      |    |     |
| PLOTTED  |      |    |     |
| CHECKED  |      |    |     |
| NO.      |      |    |     |


| DIST. NO. | STATE | PROJ. NO.  | FISCAL YEAR | SHEET NO. | TOTAL SHEETS |
|-----------|-------|------------|-------------|-----------|--------------|
| HAWAII    | HAW.  | 50CD-01-70 | 1974        | 23        | 40           |

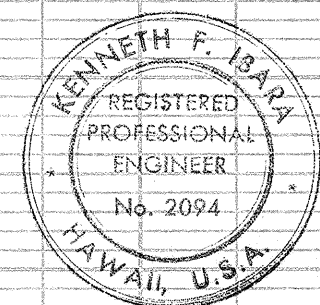

THIS WORK WAS PREPARED BY ME  
OR UNDER MY SUPERVISION

*Kenneth F. Ibarra*  
Signature  
2/13/73

## WEST OMAO SECTION

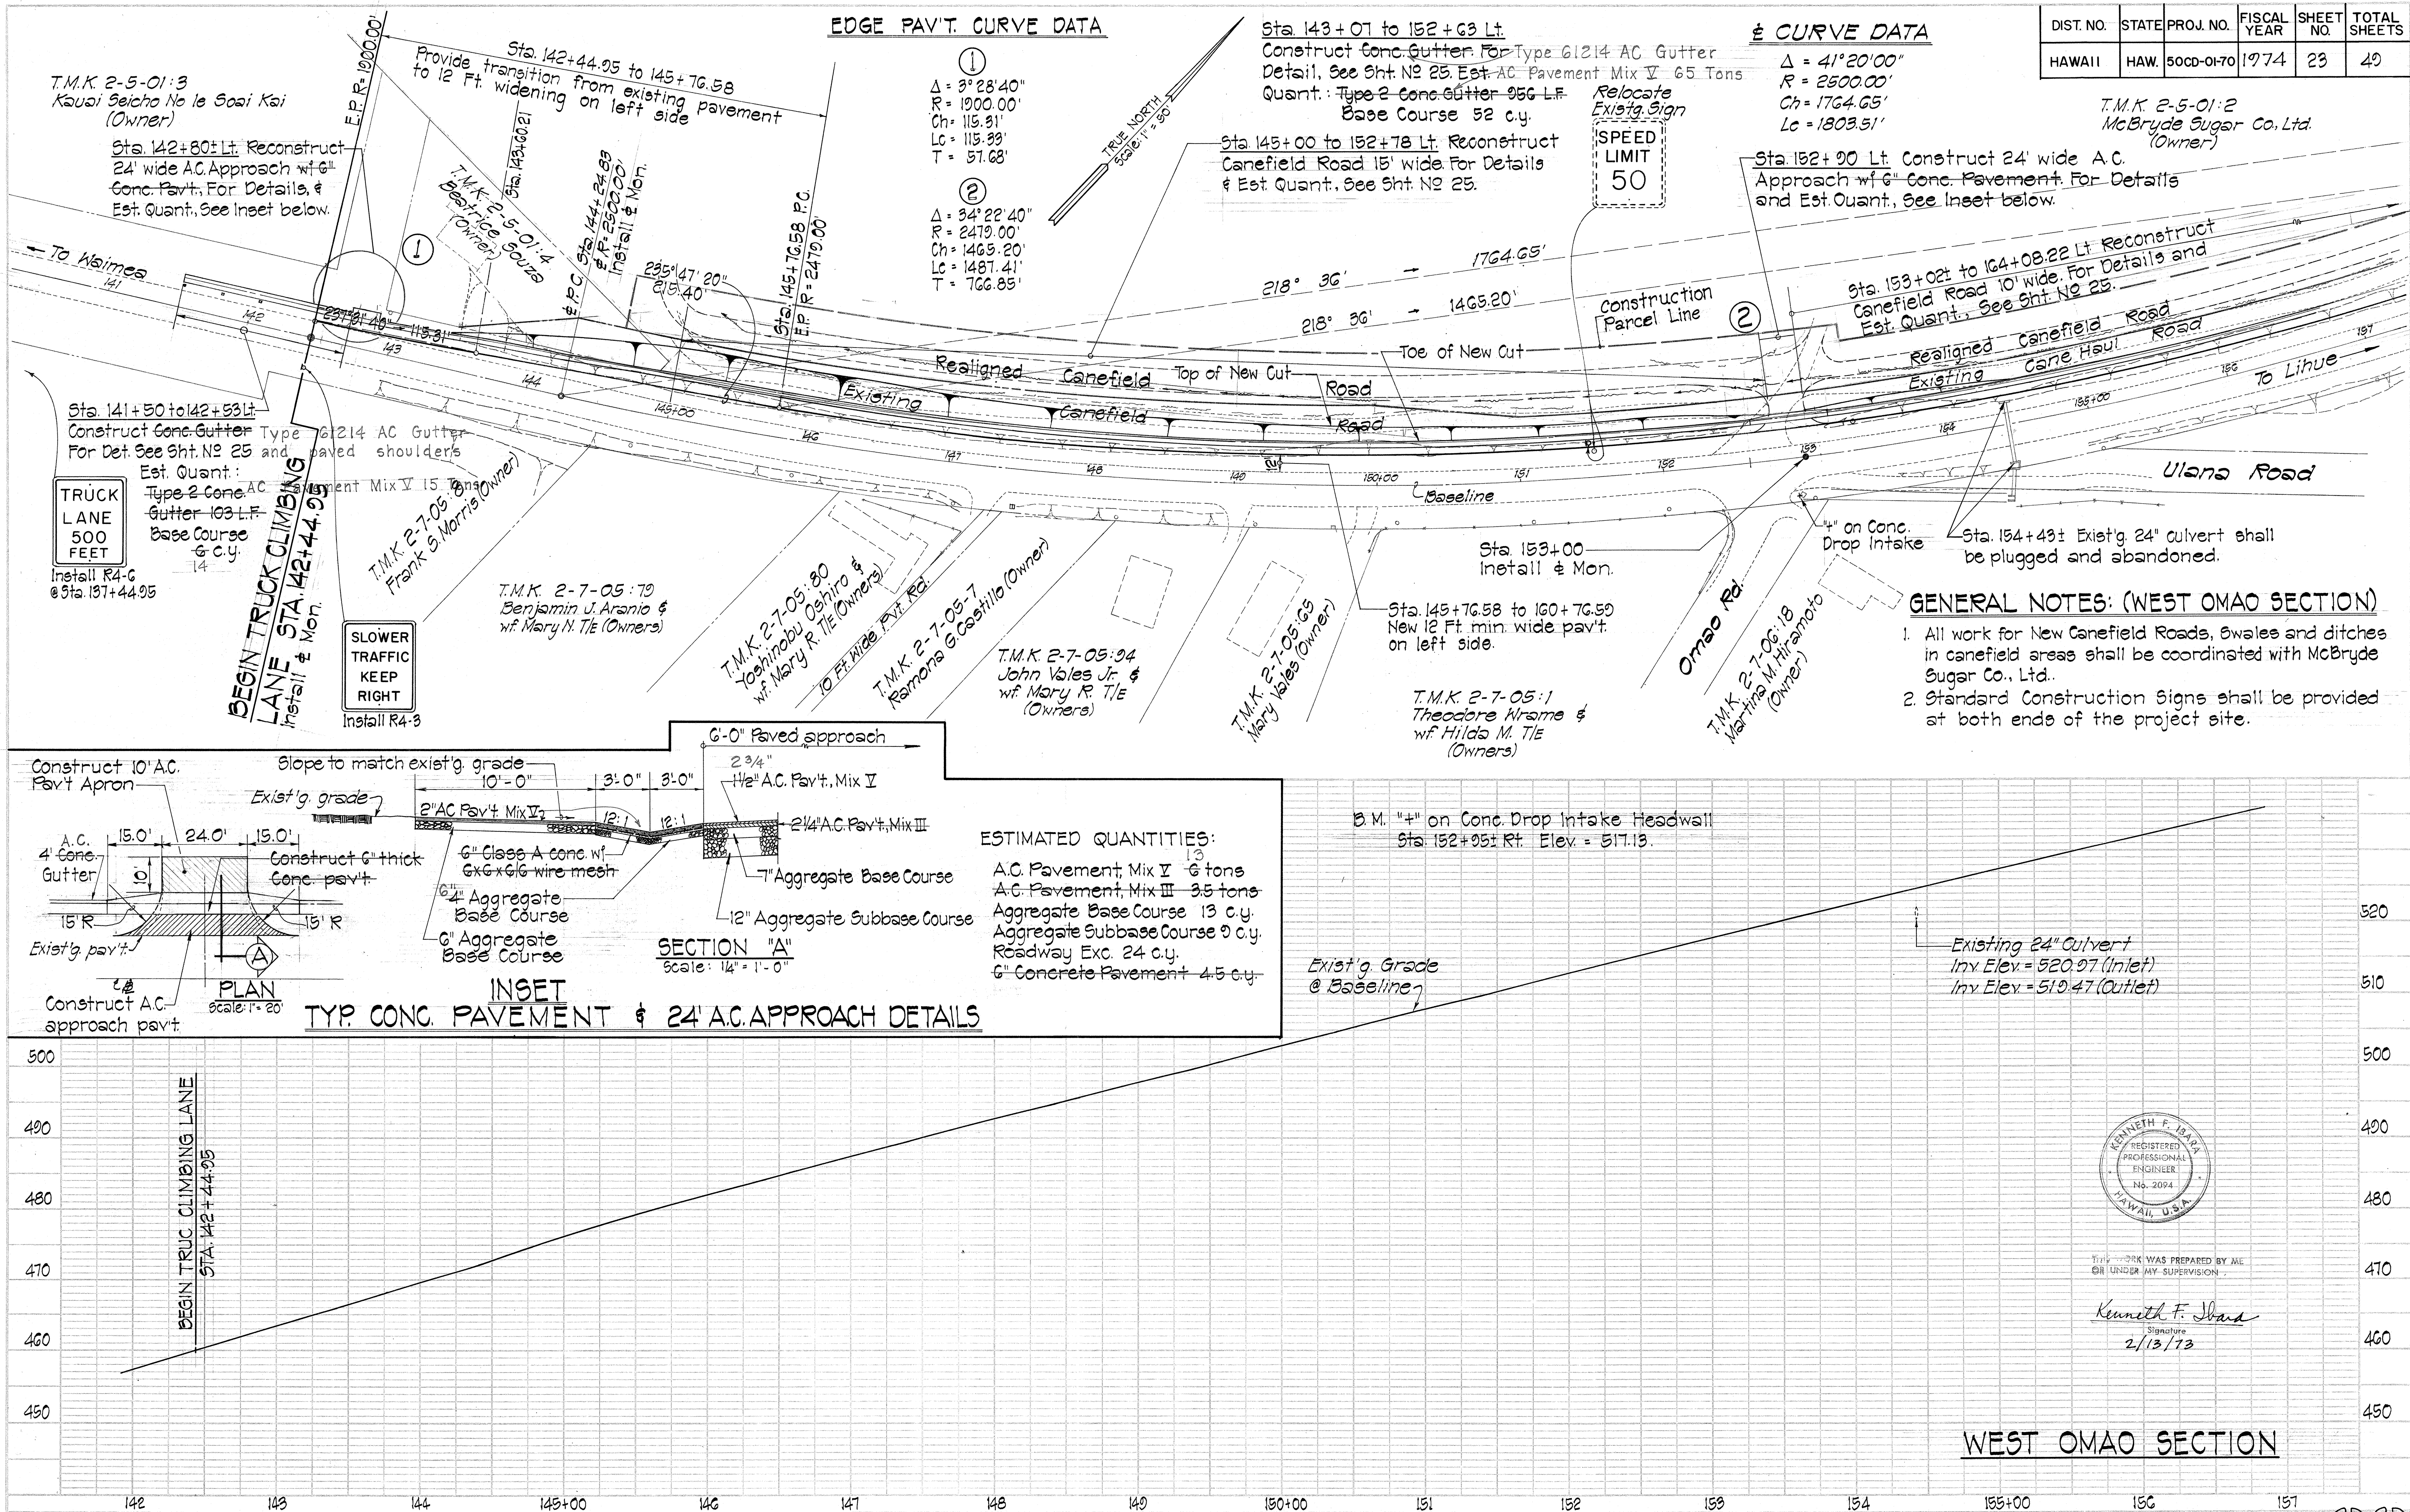



| DIST. NO. | STATE | PROJ. NO.  | FISCAL YEAR | SHEET NO. | TOTAL SHEETS |
|-----------|-------|------------|-------------|-----------|--------------|
| HAWAII    | HAW.  | 50CD-01-70 | 1974        | 24        | 49           |

|      |          |  |
|------|----------|--|
| PLAN | DATE     |  |
|      | BY       |  |
|      | SURVEYED |  |
|      | NOTED    |  |

|         |          |  |
|---------|----------|--|
| PROFILE | DATE     |  |
|         | BY       |  |
|         | SURVEYED |  |
|         | NOTED    |  |

