

DIST. NO.	STATE	PROJ. NO.	FISCAL YEAR	SHEET NO.	TOTAL SHEETS
HAWAII	HAW.	50CD-01-70	1974	1	42





STATE OF HAWAII
DEPARTMENT OF TRANSPORTATION
HIGHWAYS DIVISION

ACT 155, SLH 1969, SECTION I, ITEM C-II5

"AS BUILT" PLANS FOR
KAUAI BELT ROAD
TRUCK CLIMBING LANES AT THREE LOCATIONS
(WAHIAWA, LAWAI & OMAO VALLEYS)

PROJECT NO. 50CD-01-70

DISTRICT OF KOLOA
ISLAND OF KAUAI

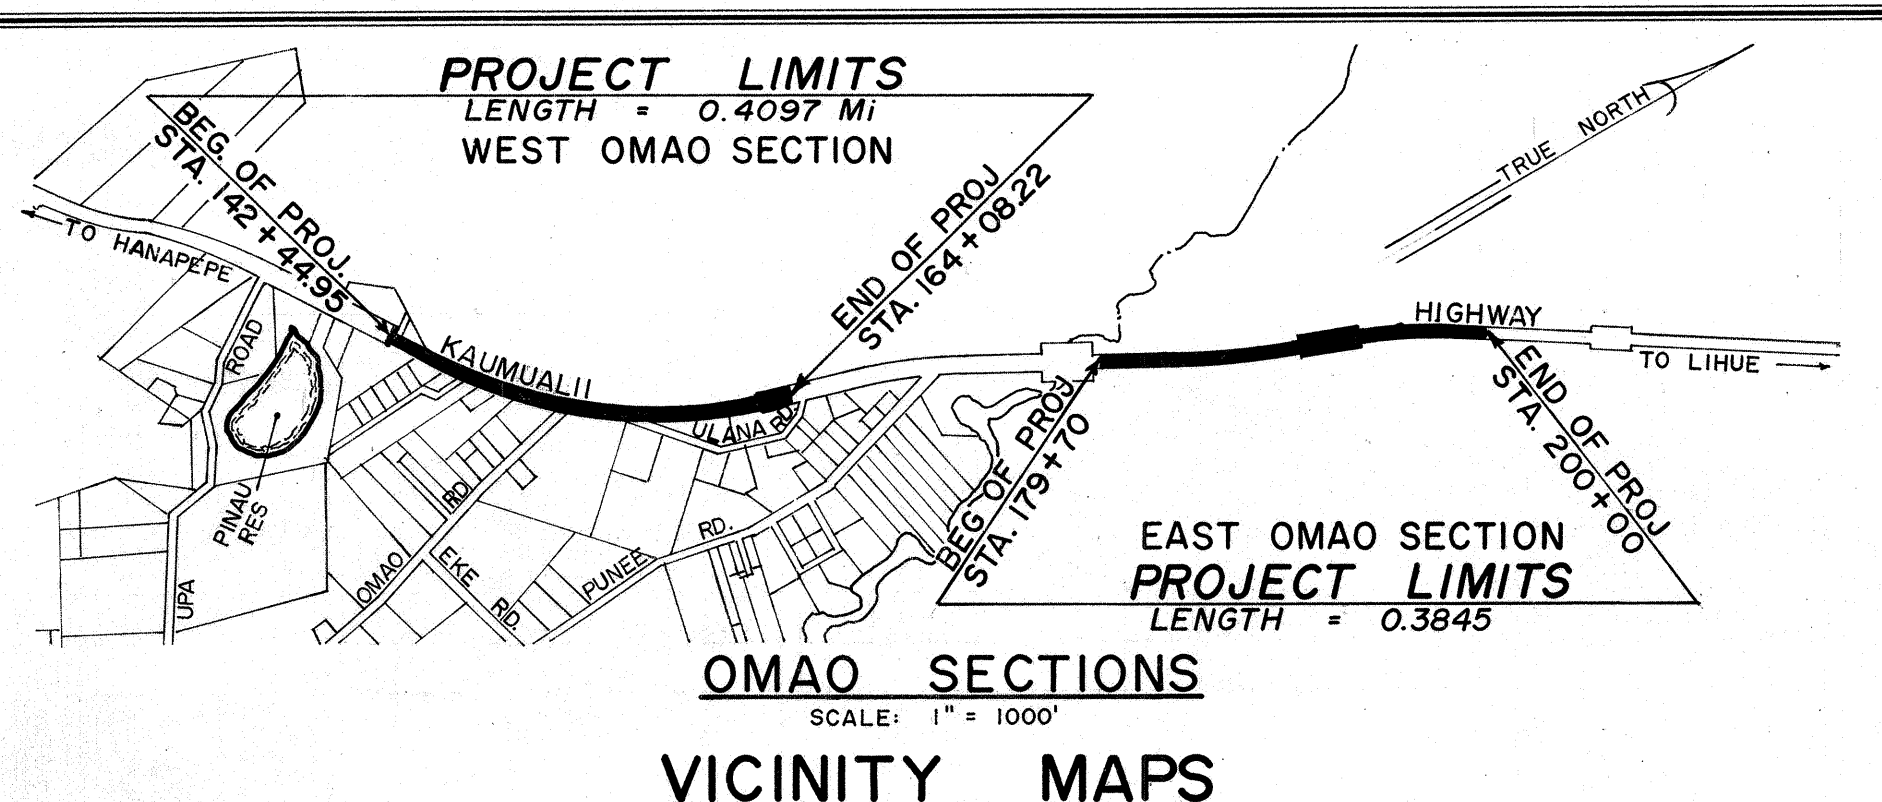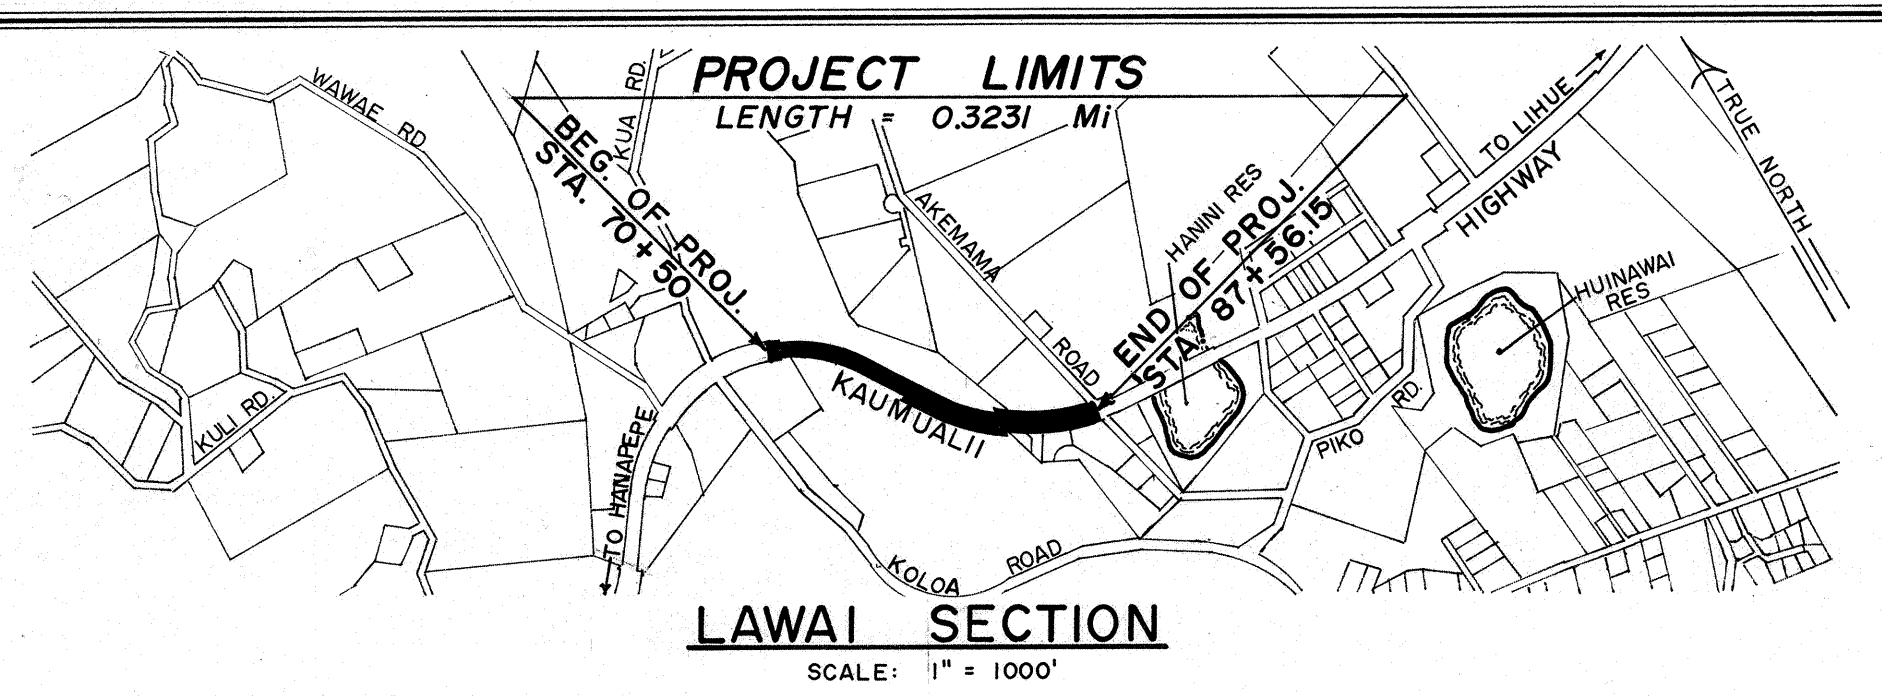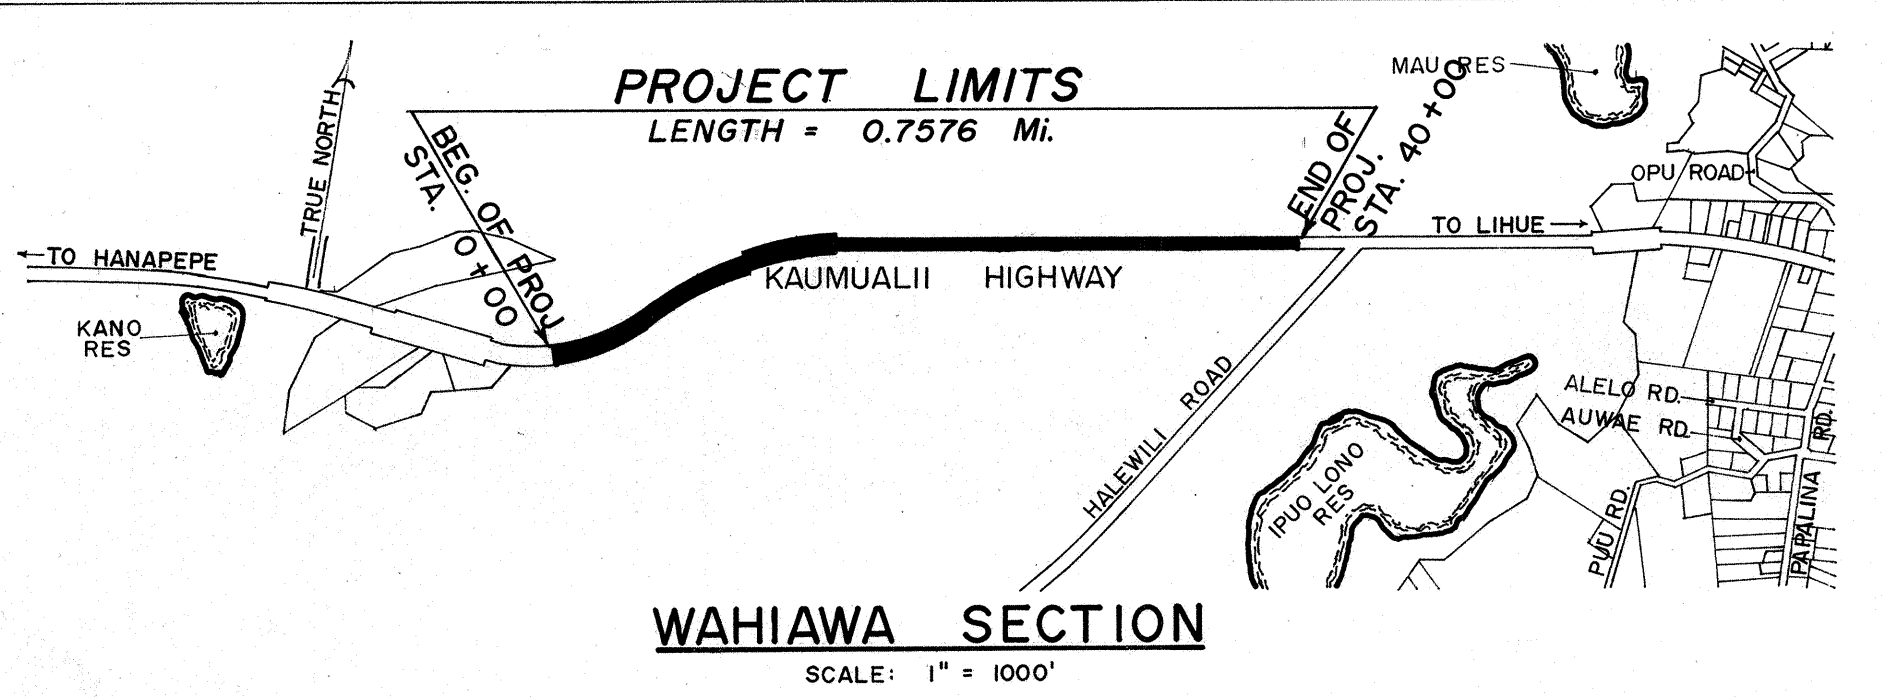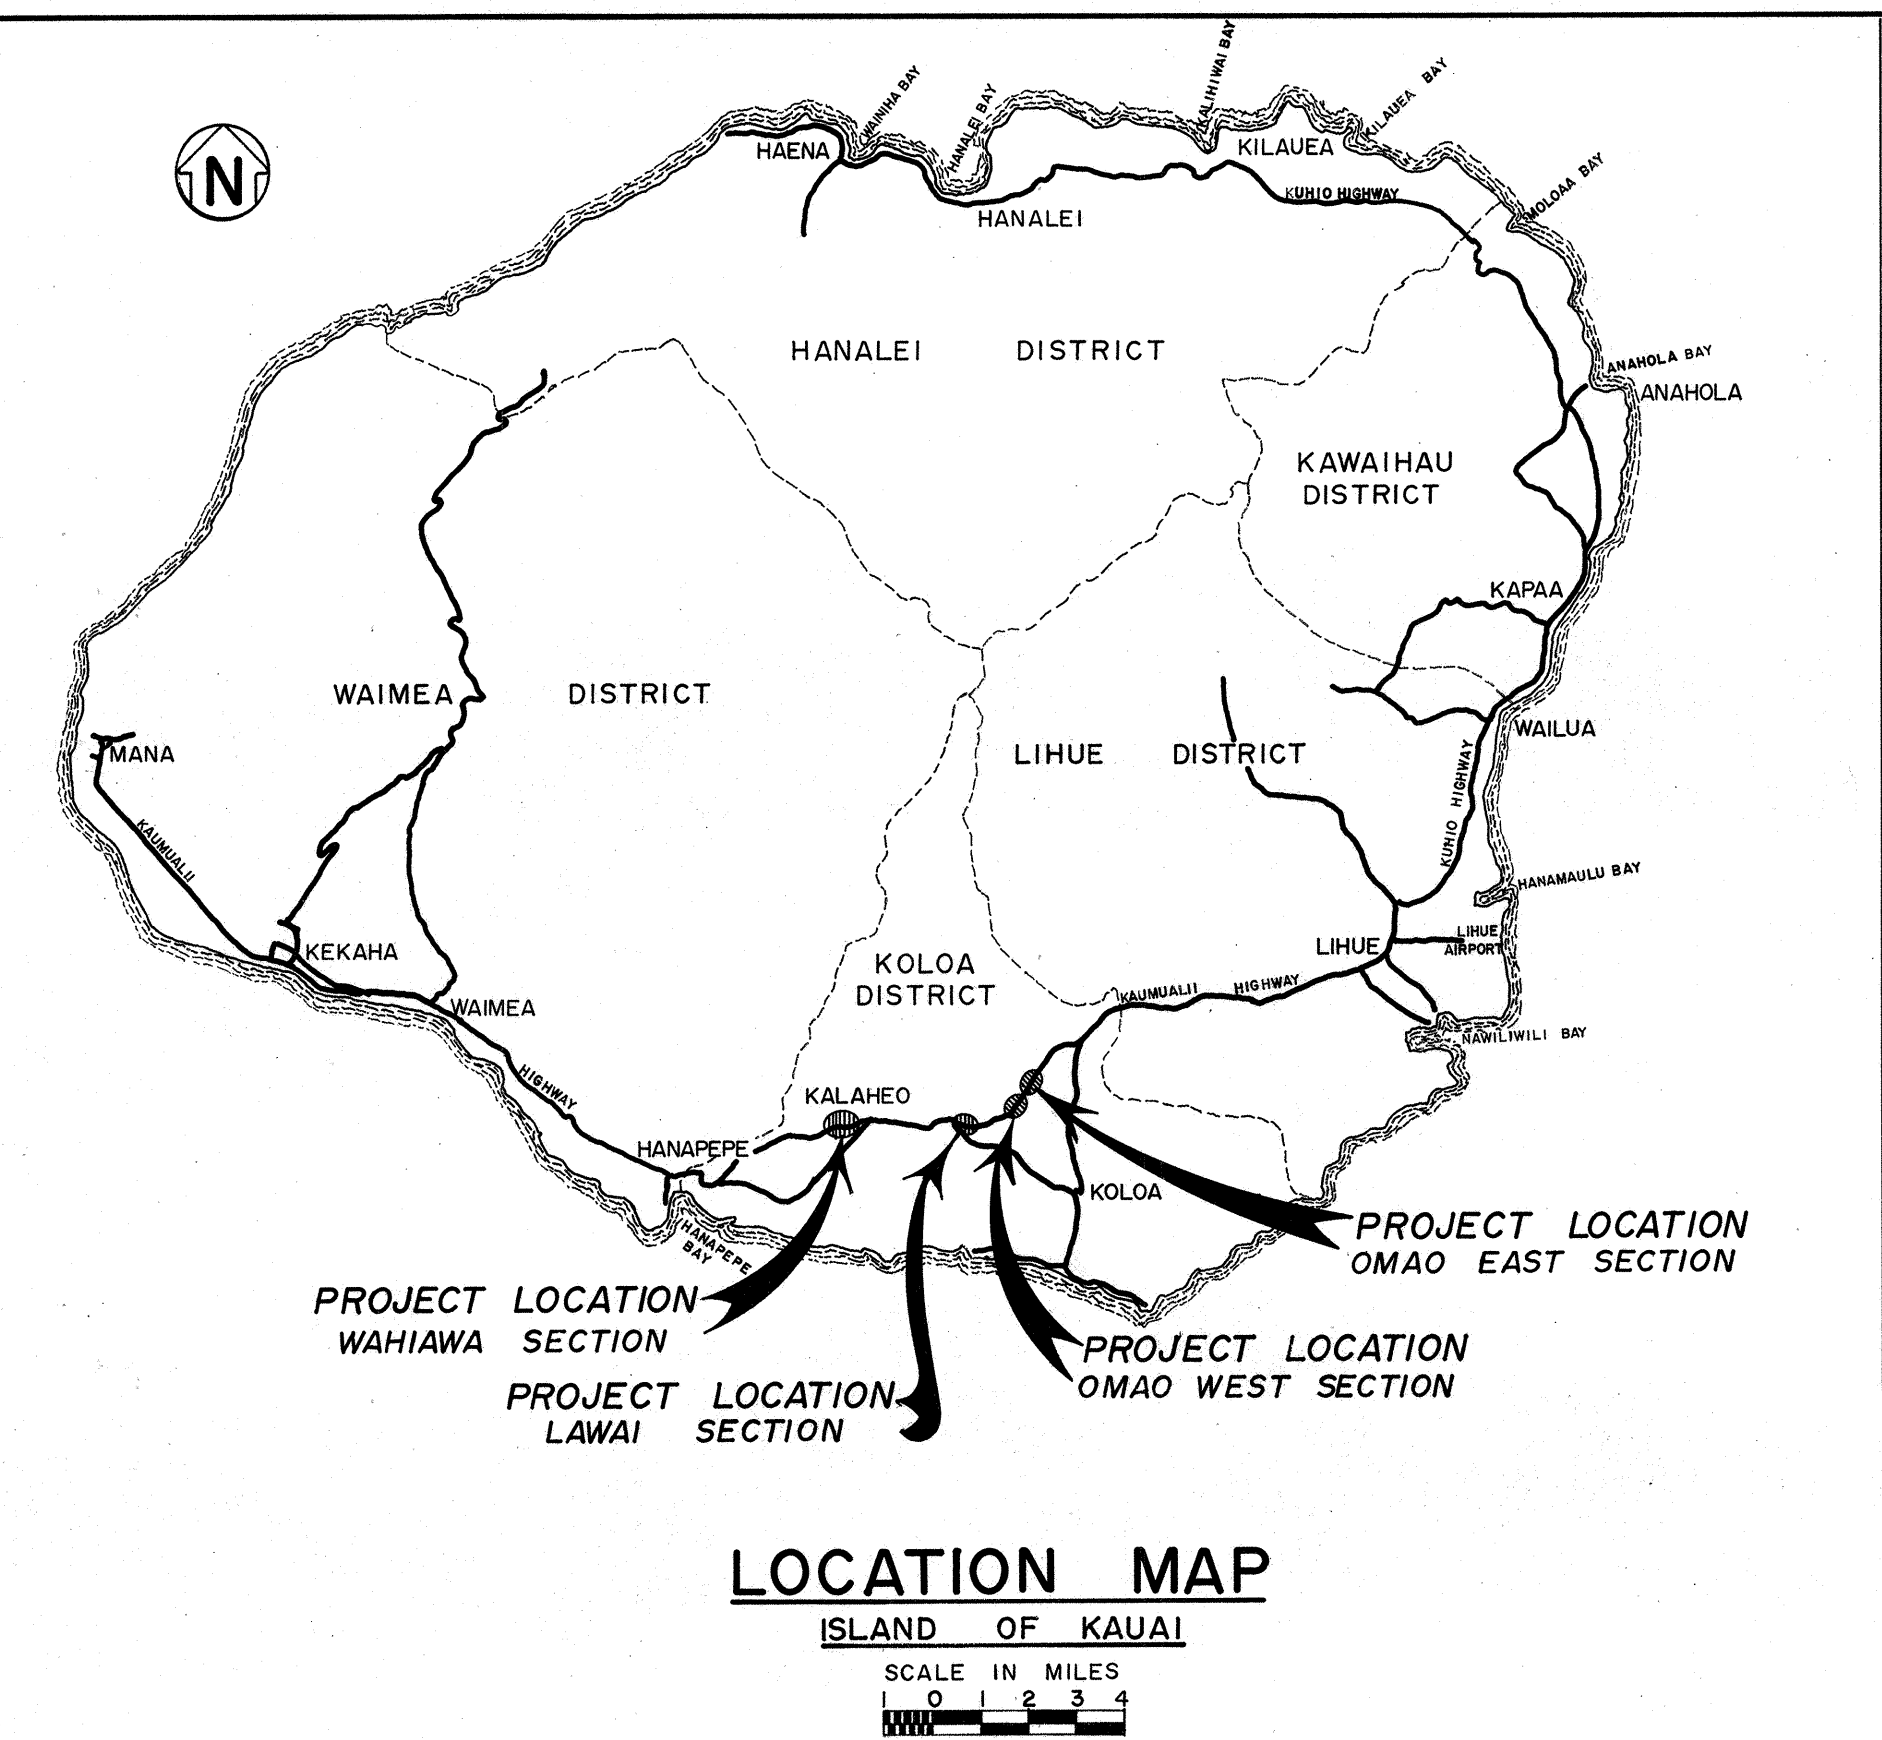

NOTE:
ALL CHANGES MADE DURING CONSTRUCTION HAVE BEEN NOTED
IN RED ON THESE TRACINGS AND CHECKED BY:

Sam Kogimoto
PROJECT ENGINEER
1/22/76
DATE

INDEX TO DRAWINGS

SHEET NO.	DESCRIPTION	SHEET NO.	DESCRIPTION
1	TITLE SHEET		
WAHIAWA SECTION:		WEST OMAO SECTION:	
2-4	PLAN and PROFILE	23-24	PLAN and PROFILE
5	TYPICAL ROADWAY SECTION	25	TYPICAL ROADWAY SECTION
6-7	DRAINAGE DETAILS(WITH SUPPLEMENT SHT. NO. 6A)	26	PAVEMENT MARKER & UTILITY RELOCATION PLAN
8	PAVEMENT MARKER & UTILITY RELOCATION PLAN	27-28	CROSS SECTIONS
9-13	CROSS SECTIONS	EAST OMAO SECTION:	
LAWAI SECTION:		29-30	PLAN and PROFILE
14-15	PLAN and PROFILE	31	TYPICAL ROADWAY SECTION
16	TYPICAL ROADWAY SECTION	32	DRAINAGE DETAILS
17-18	DRAINAGE DETAILS	33	PAVEMENT MARKER & UTILITY RELOCATION PLAN
19	PAVEMENT MARKER & UTILITY RELOCATION PLAN	34-35	CROSS SECTIONS
20-22	CROSS SECTIONS	36	MOD. STD. TYPE 61214 GRATED DROP INTAKE
		37-49	STANDARD DETAILS

PREPARED BY:
KUTAKA, PORTUGAL & IBARA, INC.
ENGINEERS and SURVEYORS
LIHUE, KAUAI, HAWAII 96766

DEPARTMENT OF TRANSPORTATION
STATE OF HAWAII
APPROVED:
Murray Lee 2/1/74
For DIR. OF TRANSPORTATION DATE

F. Abeshima