



DIST. NO.	STATE	FED. AID PROJ. NO.	FISCAL YEAR	SHEET NO.	TOTAL SHEETS
HAWAII	HAW.	50CD-01-70	1974	31	40

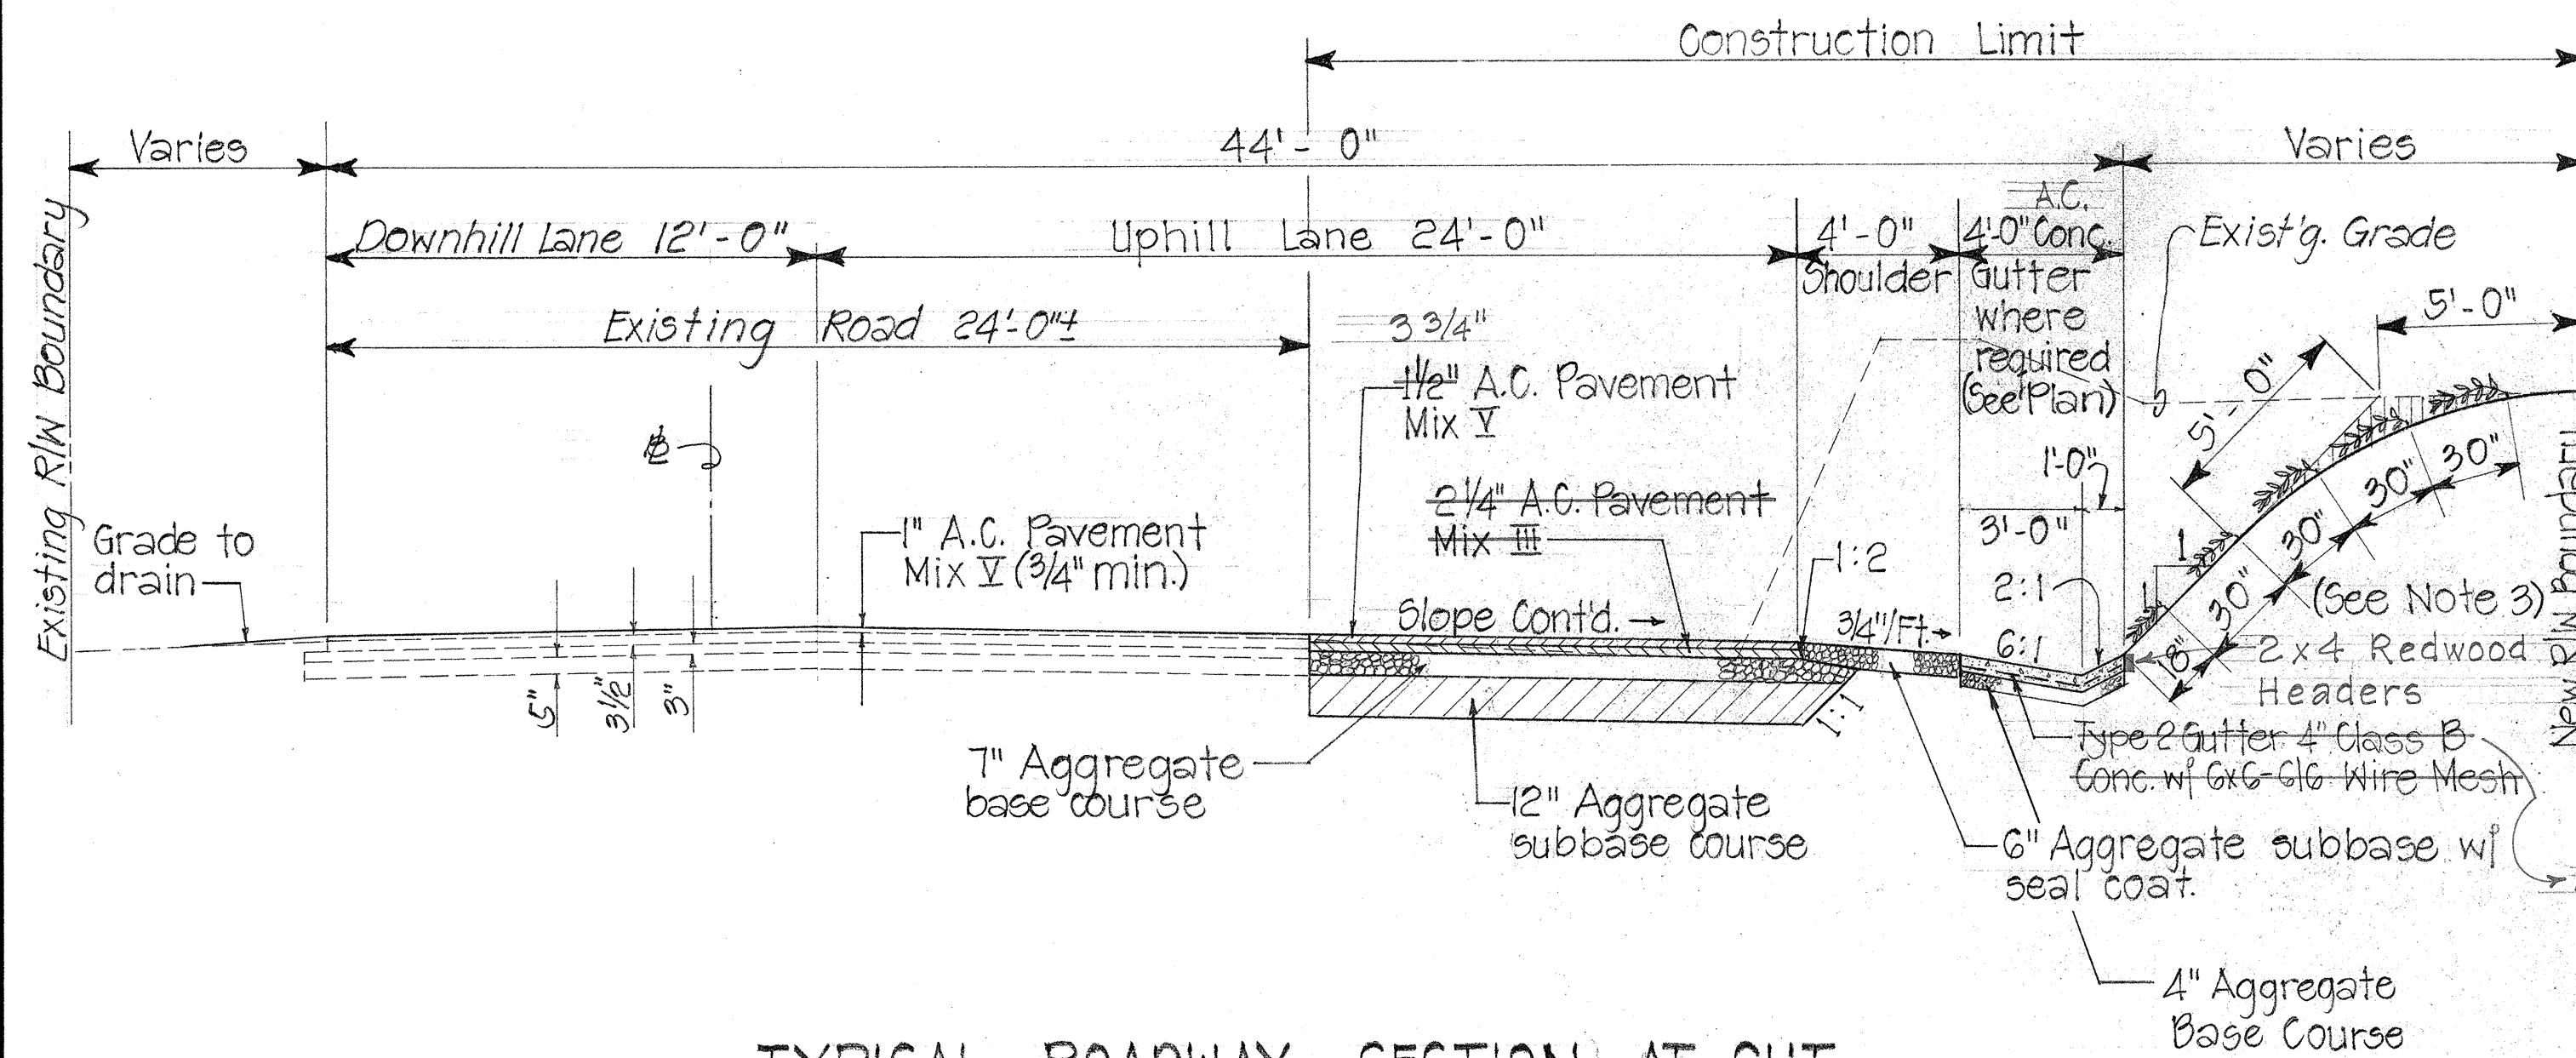


TYPICAL ROADWAY SECTION AT CUT
(STATIONS 179+70 TO 190+42.65 AND 194+42.65 TO 197+02.65)
Scale: 1/4" = 1'-0"

GENERAL NOTES:

- The typical sections shown are in general only and is not intended to depict any specific location.
- All wire mesh reinforcing shall be considered incidental to the various contract items.
- HA-1833 Dwarf Pangola Grass shall be planted in holes 4" Dia. x 6" Deep at 30"x30" Spacing (Typical for all Cut and Fill Areas).

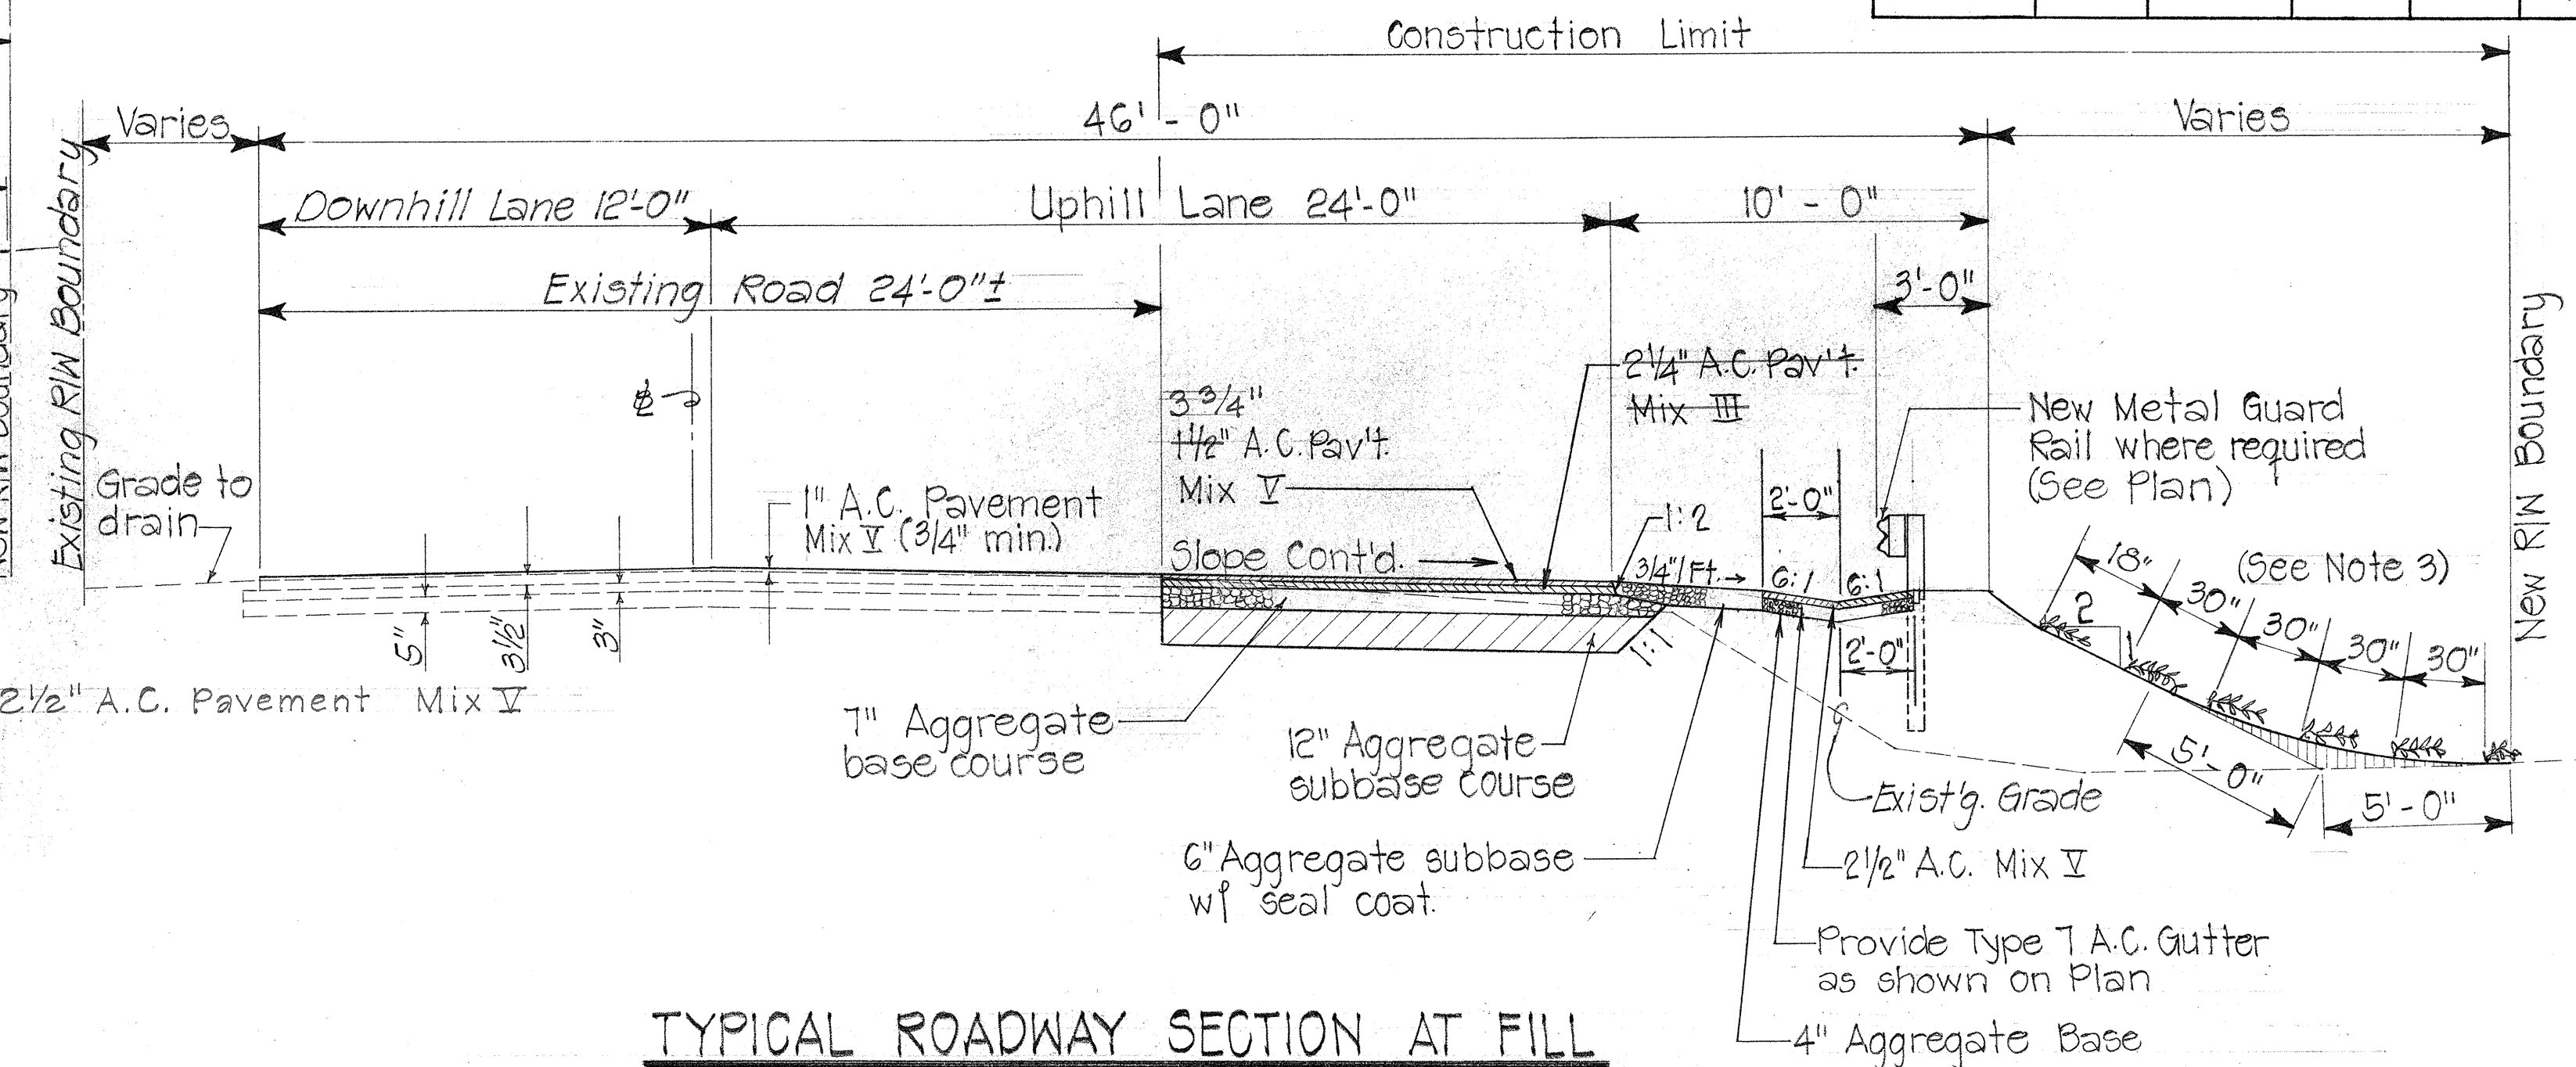


TYPICAL ROADWAY SECTION AT FILL
(STATIONS 190+42.65 TO 194+42.65 AND 197+02.65 TO 200+00)
Scale: 1/4" = 1'-0"

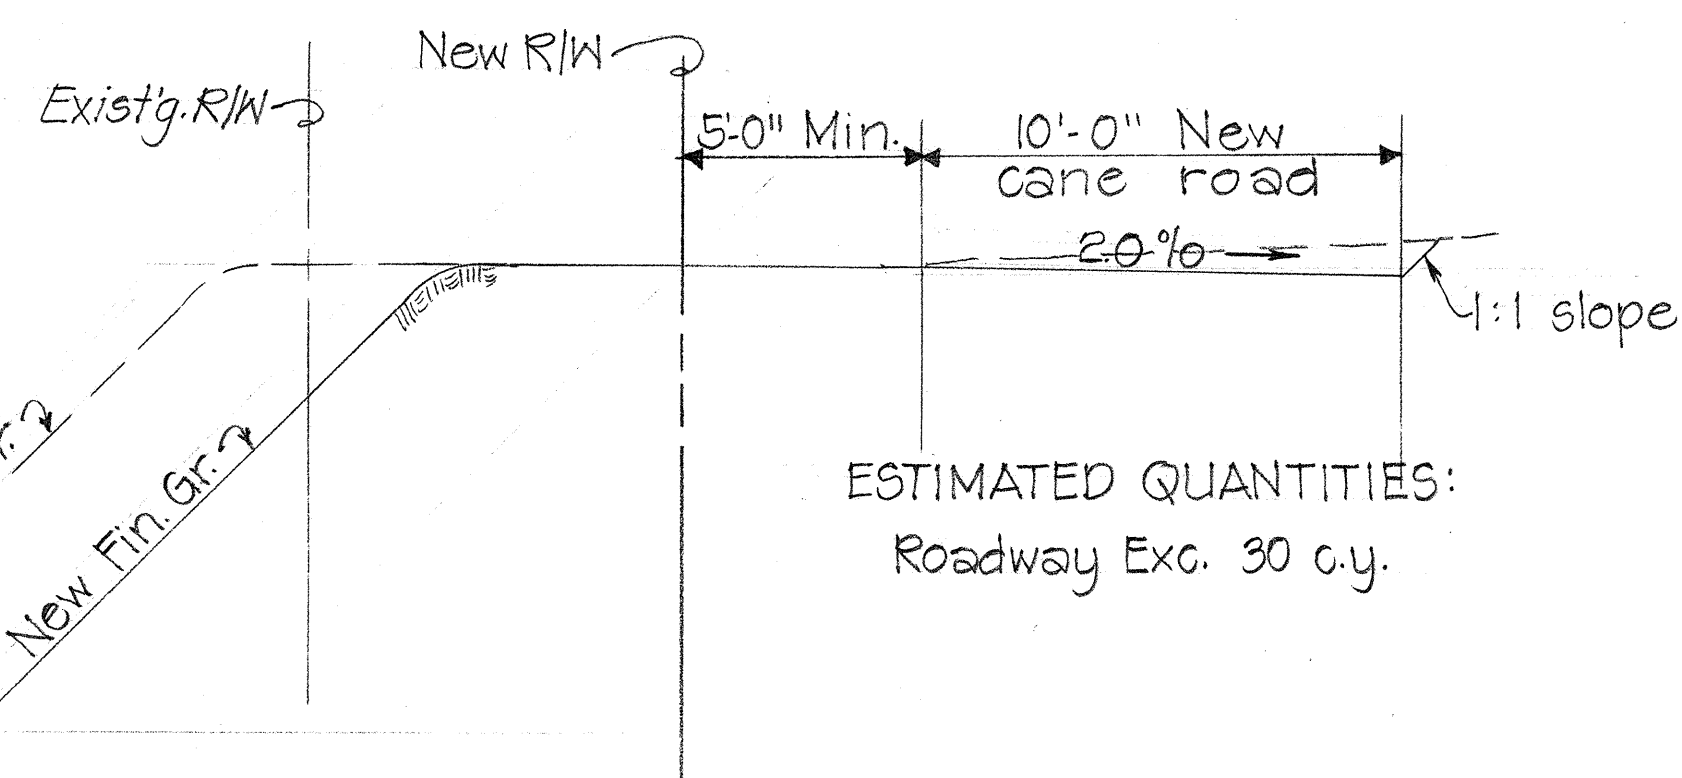


ESTIMATED QUANTITIES:
Roadway Exc. 30 c.y.

TYPICAL SECTION OF REALIGNED CANEFIELD ROAD
STA. 179+30 TO 200+38± Rt.
Not to Scale

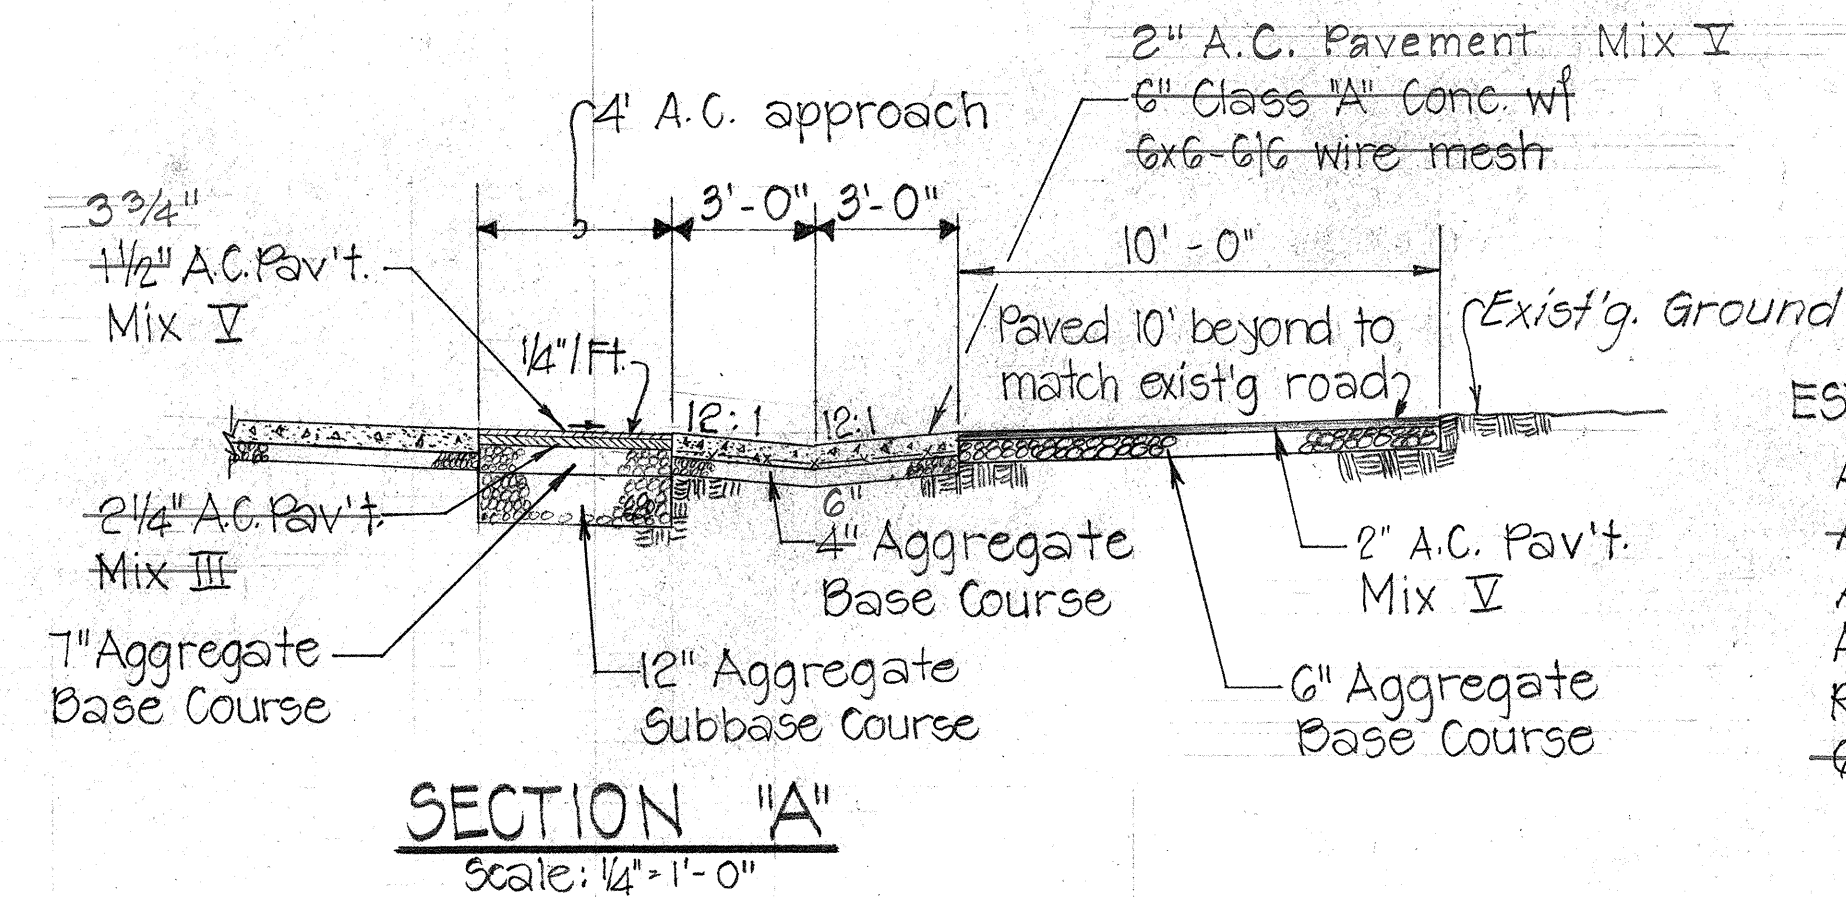


ESTIMATED QUANTITIES
A.C. Pavement, Mix V 3 ton
A.C. Pavement, Mix III 2 ton
Aggregate Base Course 9 c.y.
Aggregate Subbase Course 5 c.y.
Roadway Exc. 13 c.y.
6" Conc. Pavement 3.5 c.y.

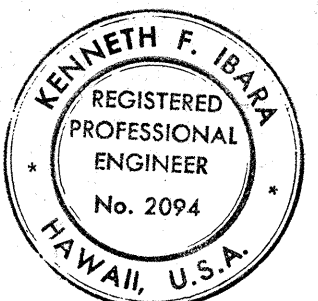

THIS WORK WAS PREPARED BY ME
OR UNDER MY SUPERVISION.

Kenneth F. Hara
Signature
2/13/73

STATE OF HAWAII
DEPARTMENT OF TRANSPORTATION
HIGHWAYS DIVISION
TYPICAL ROADWAY SECTIONS
EAST OMAO SECTION
TRUCK CLIMBING LANES AT THREE
LOCATIONS (WAHIAWA, LAWAI AND OMAO VALLEYS)
PROJ. NO. 50 CD-01-70
SHEET NO. OF SHEETS

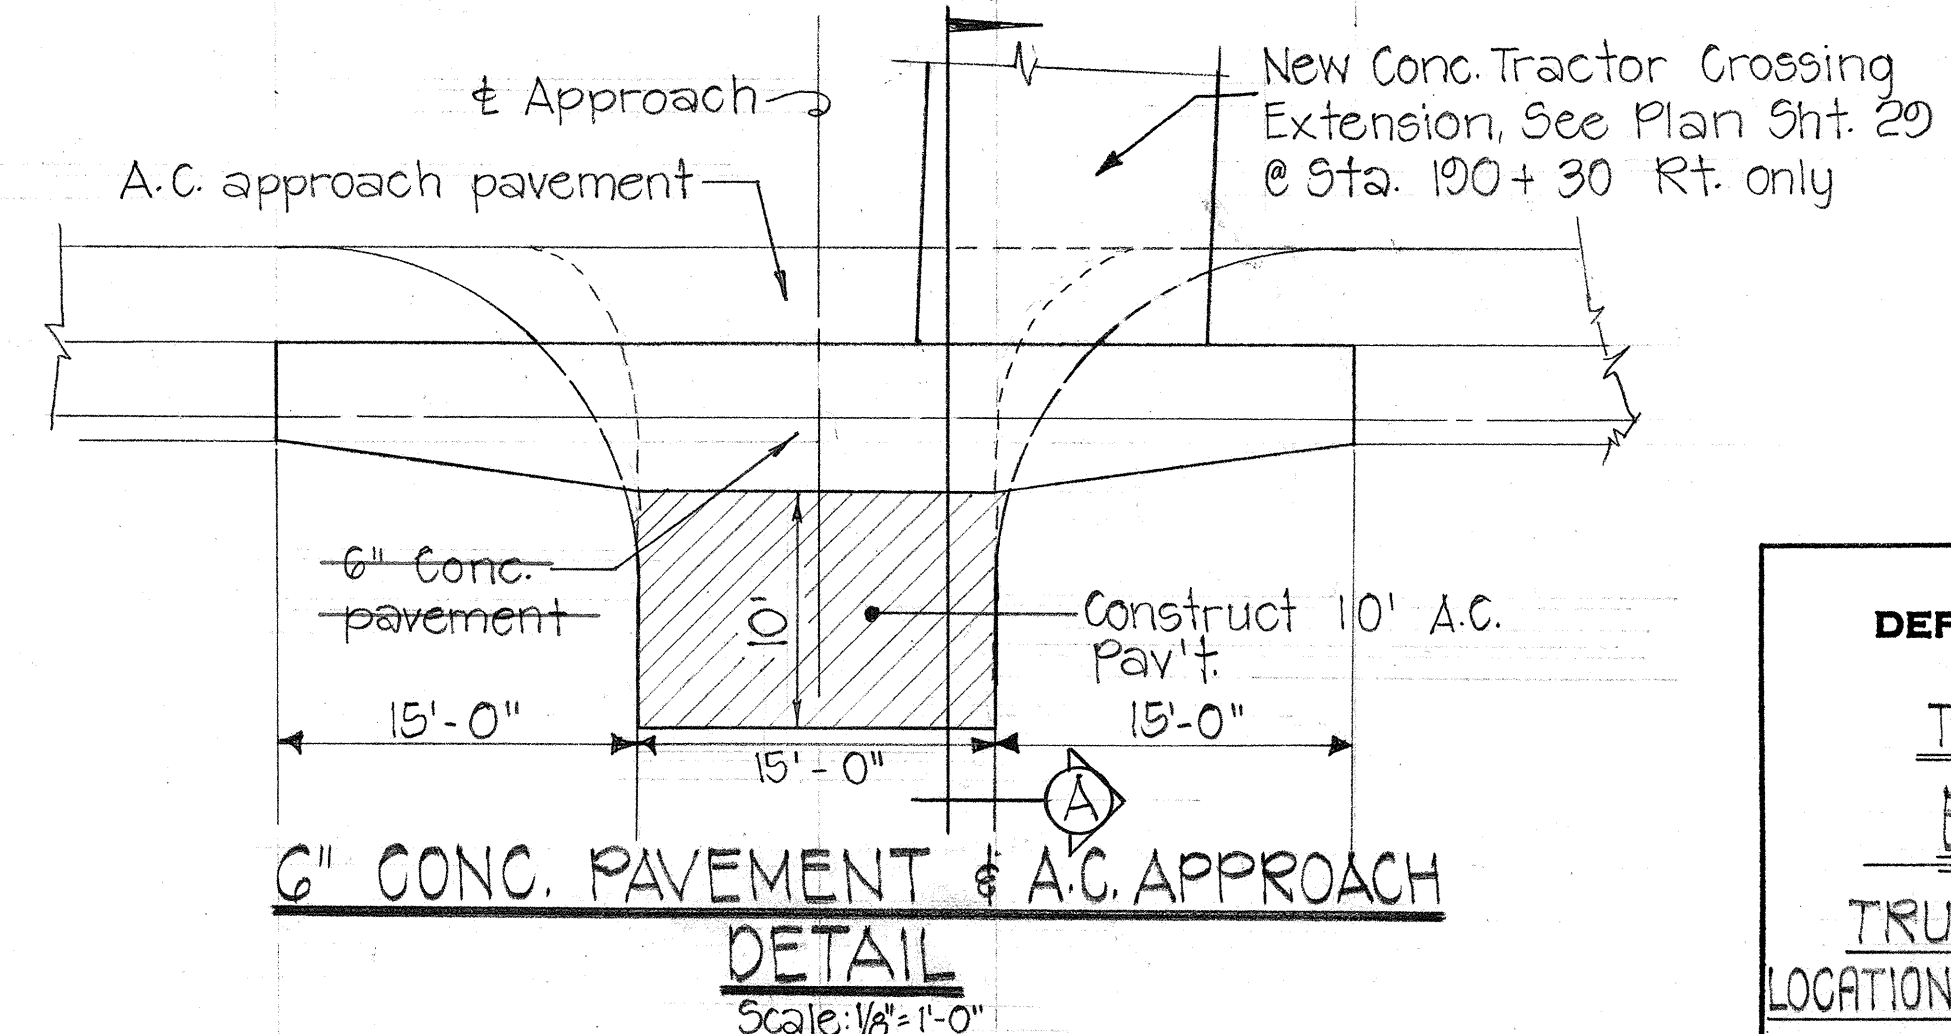

6" CONC. PAVEMENT & A.C. APPROACH DETAIL
Scale: 1/8" = 1'-0"