

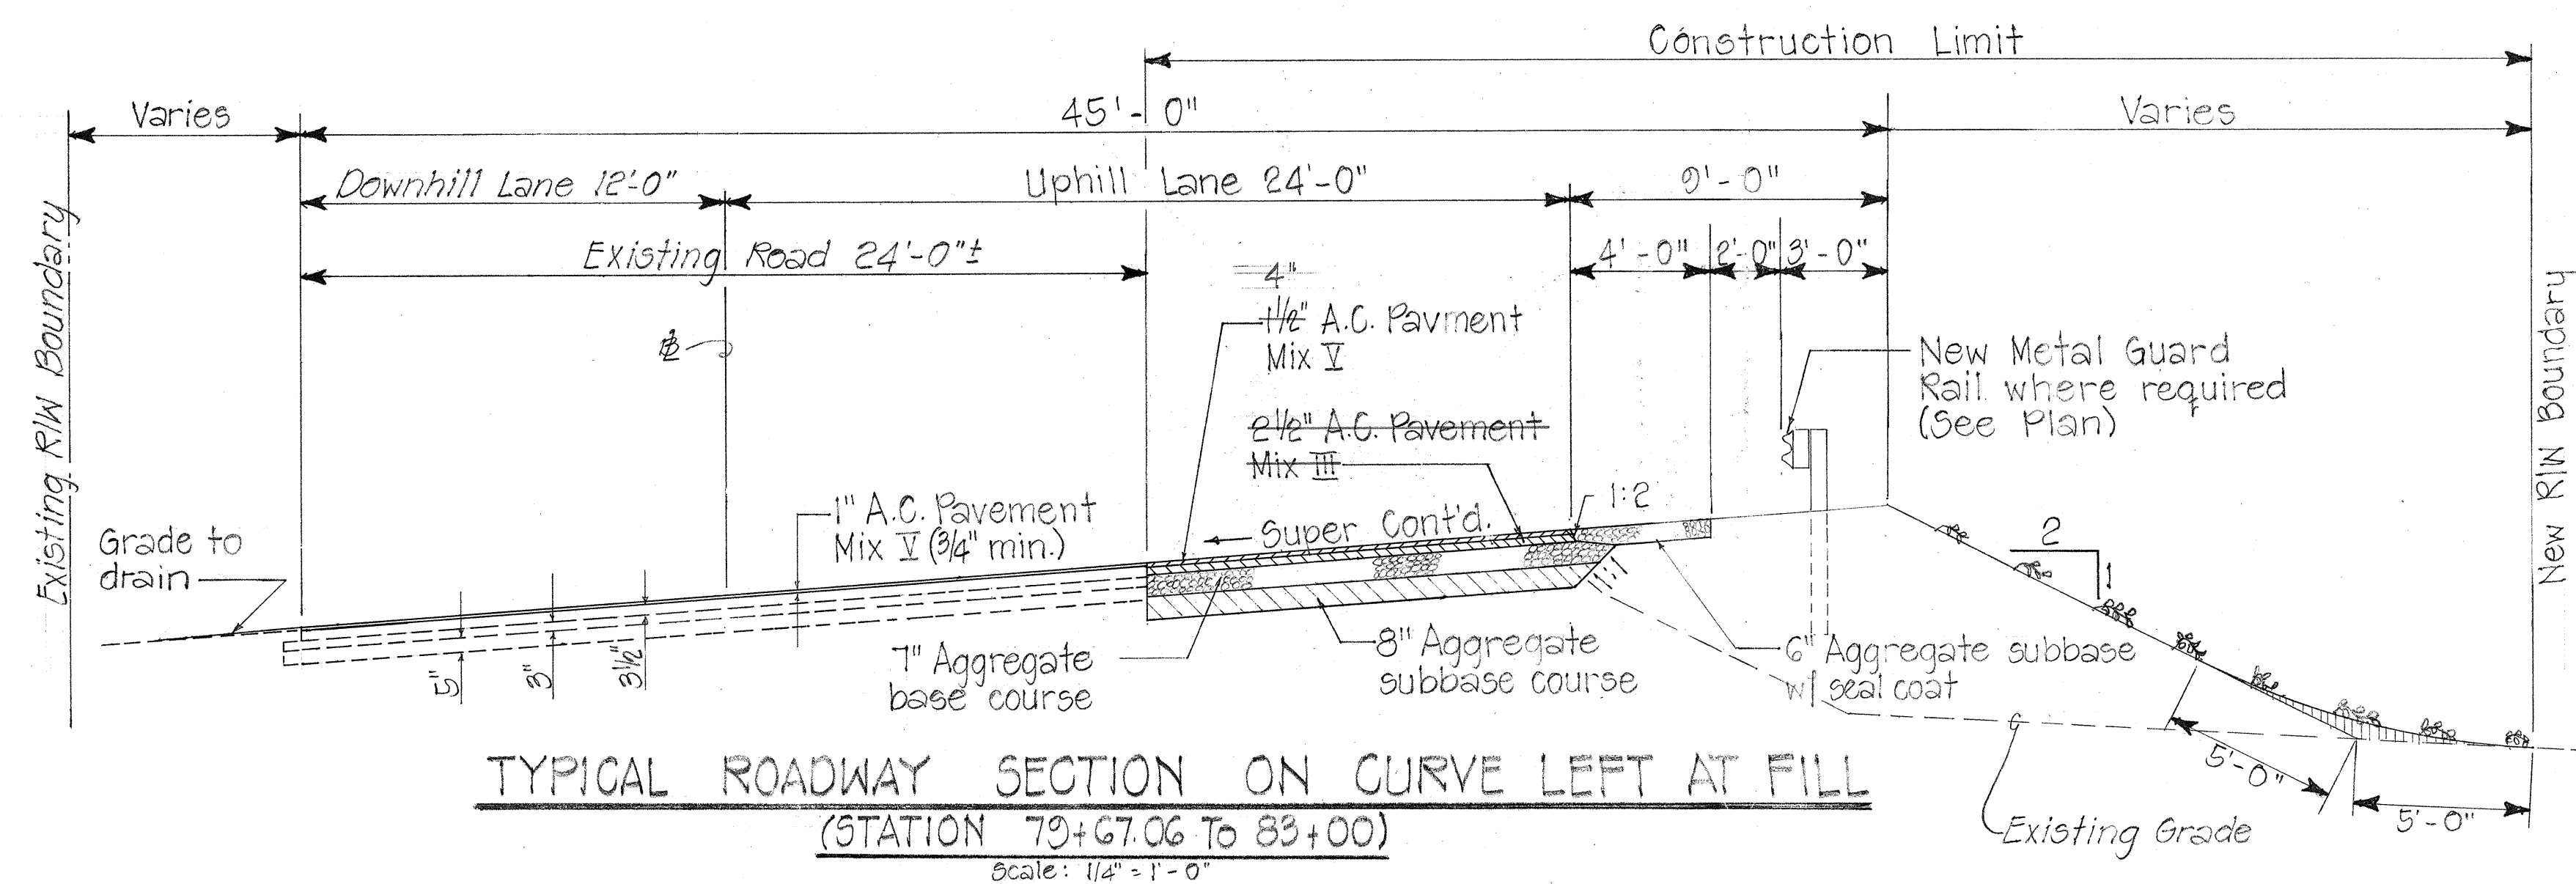
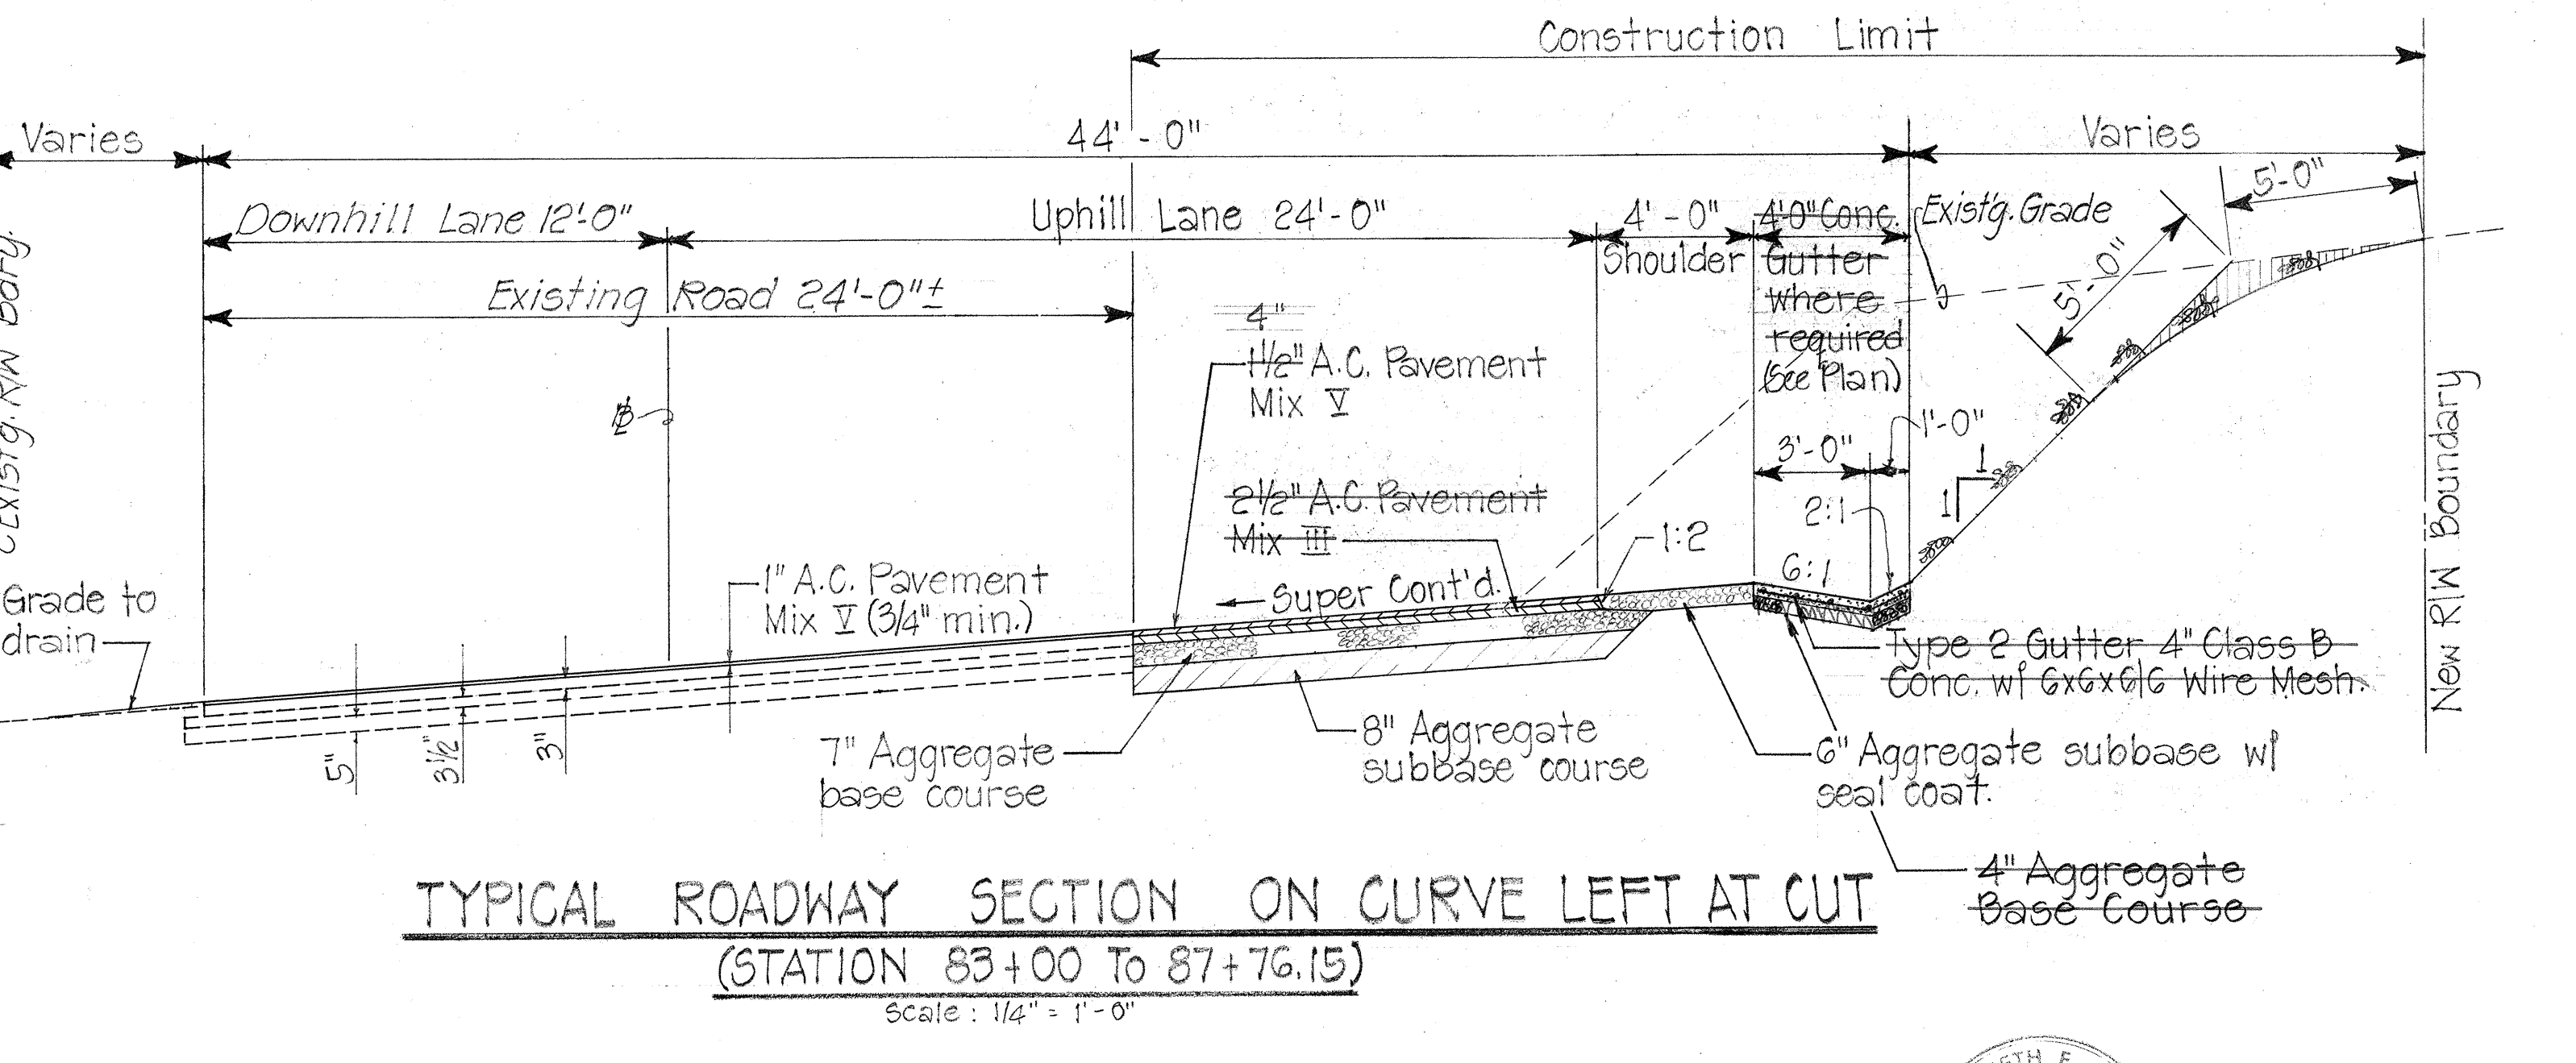
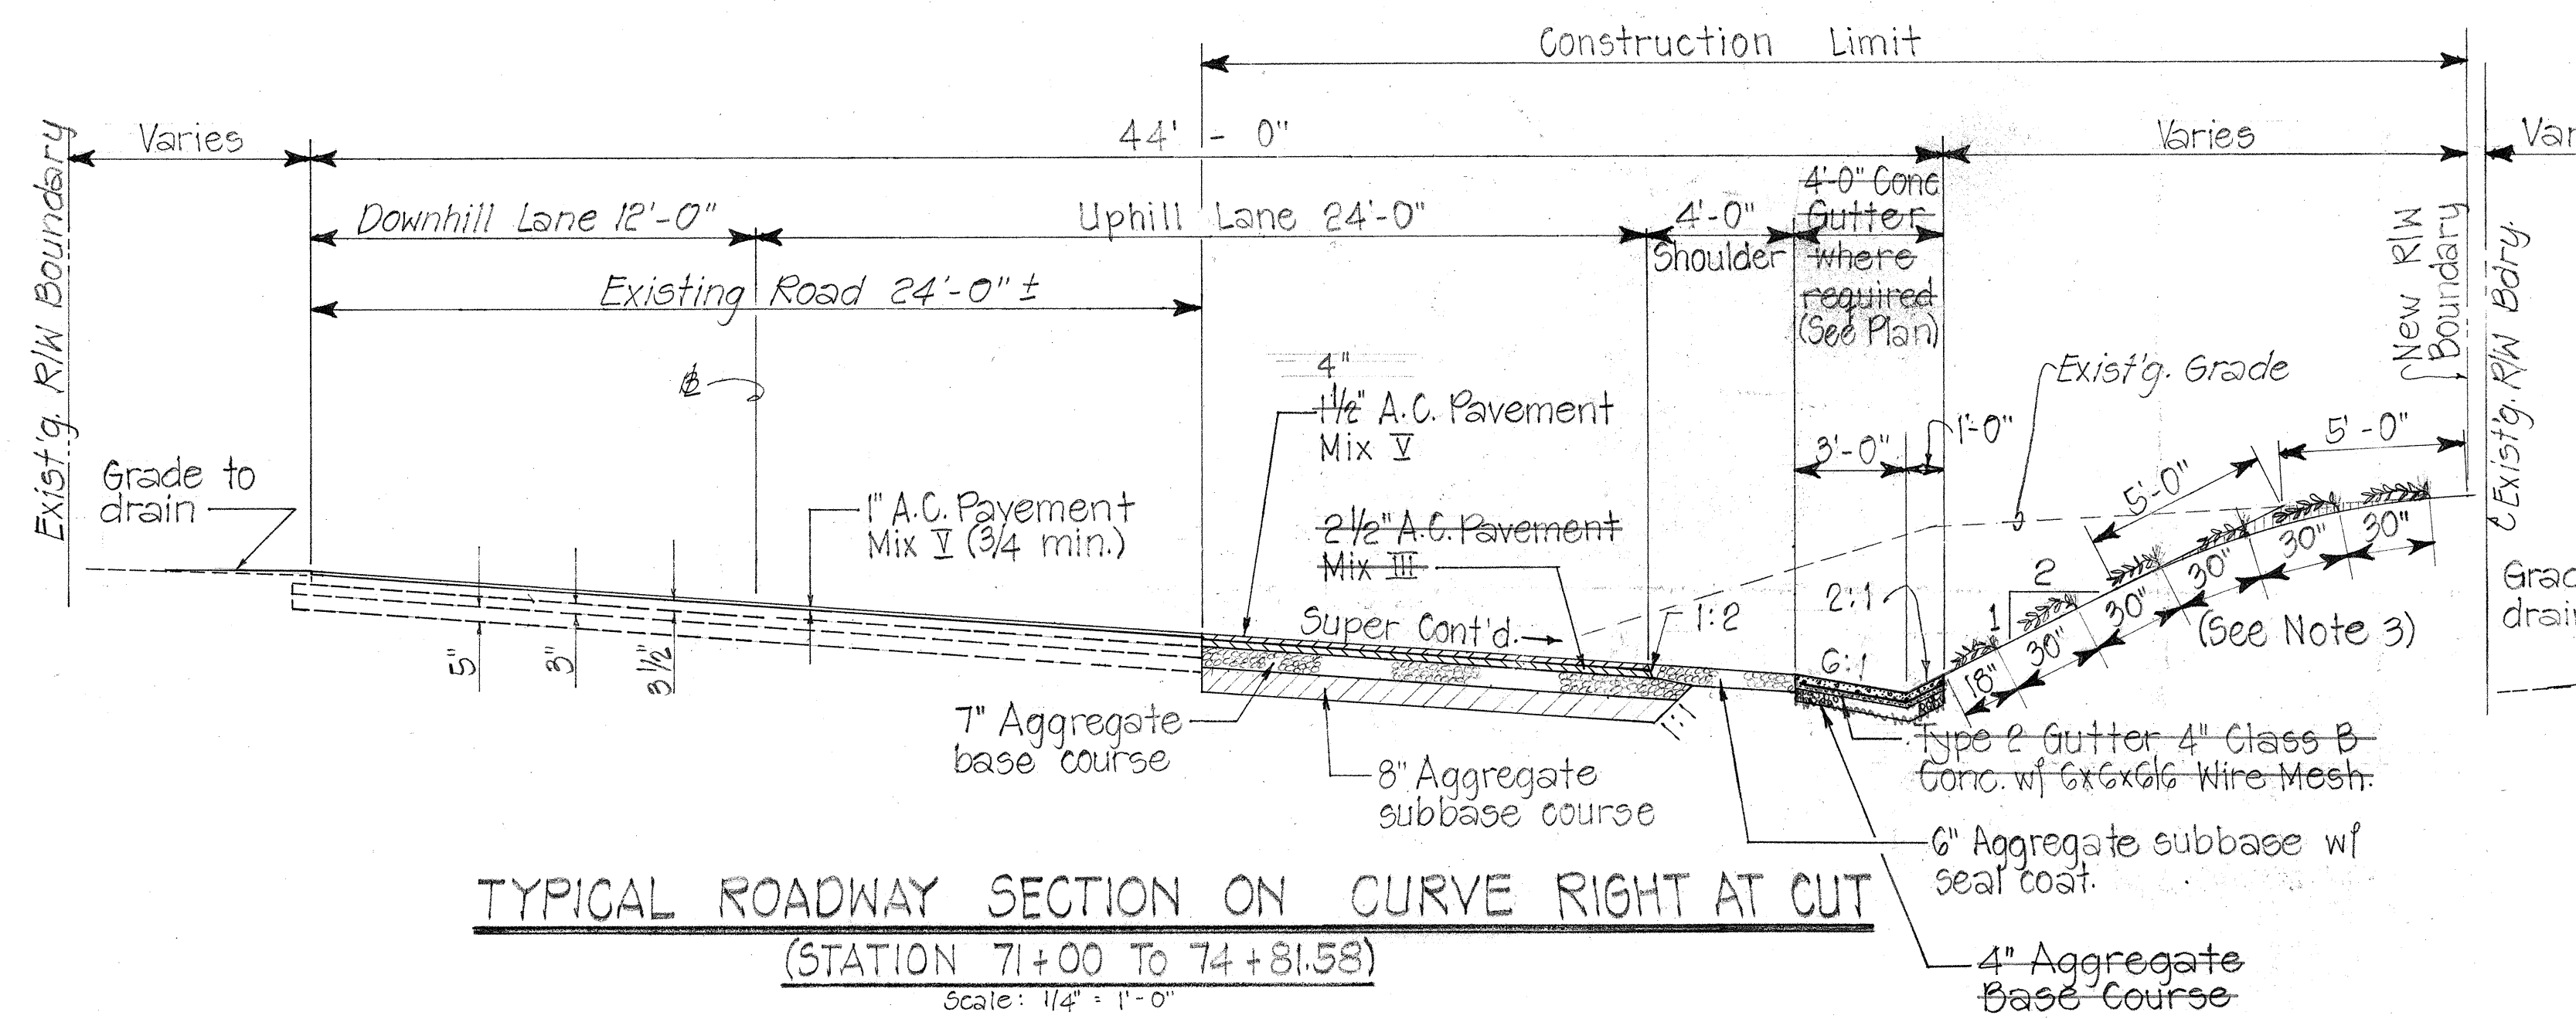
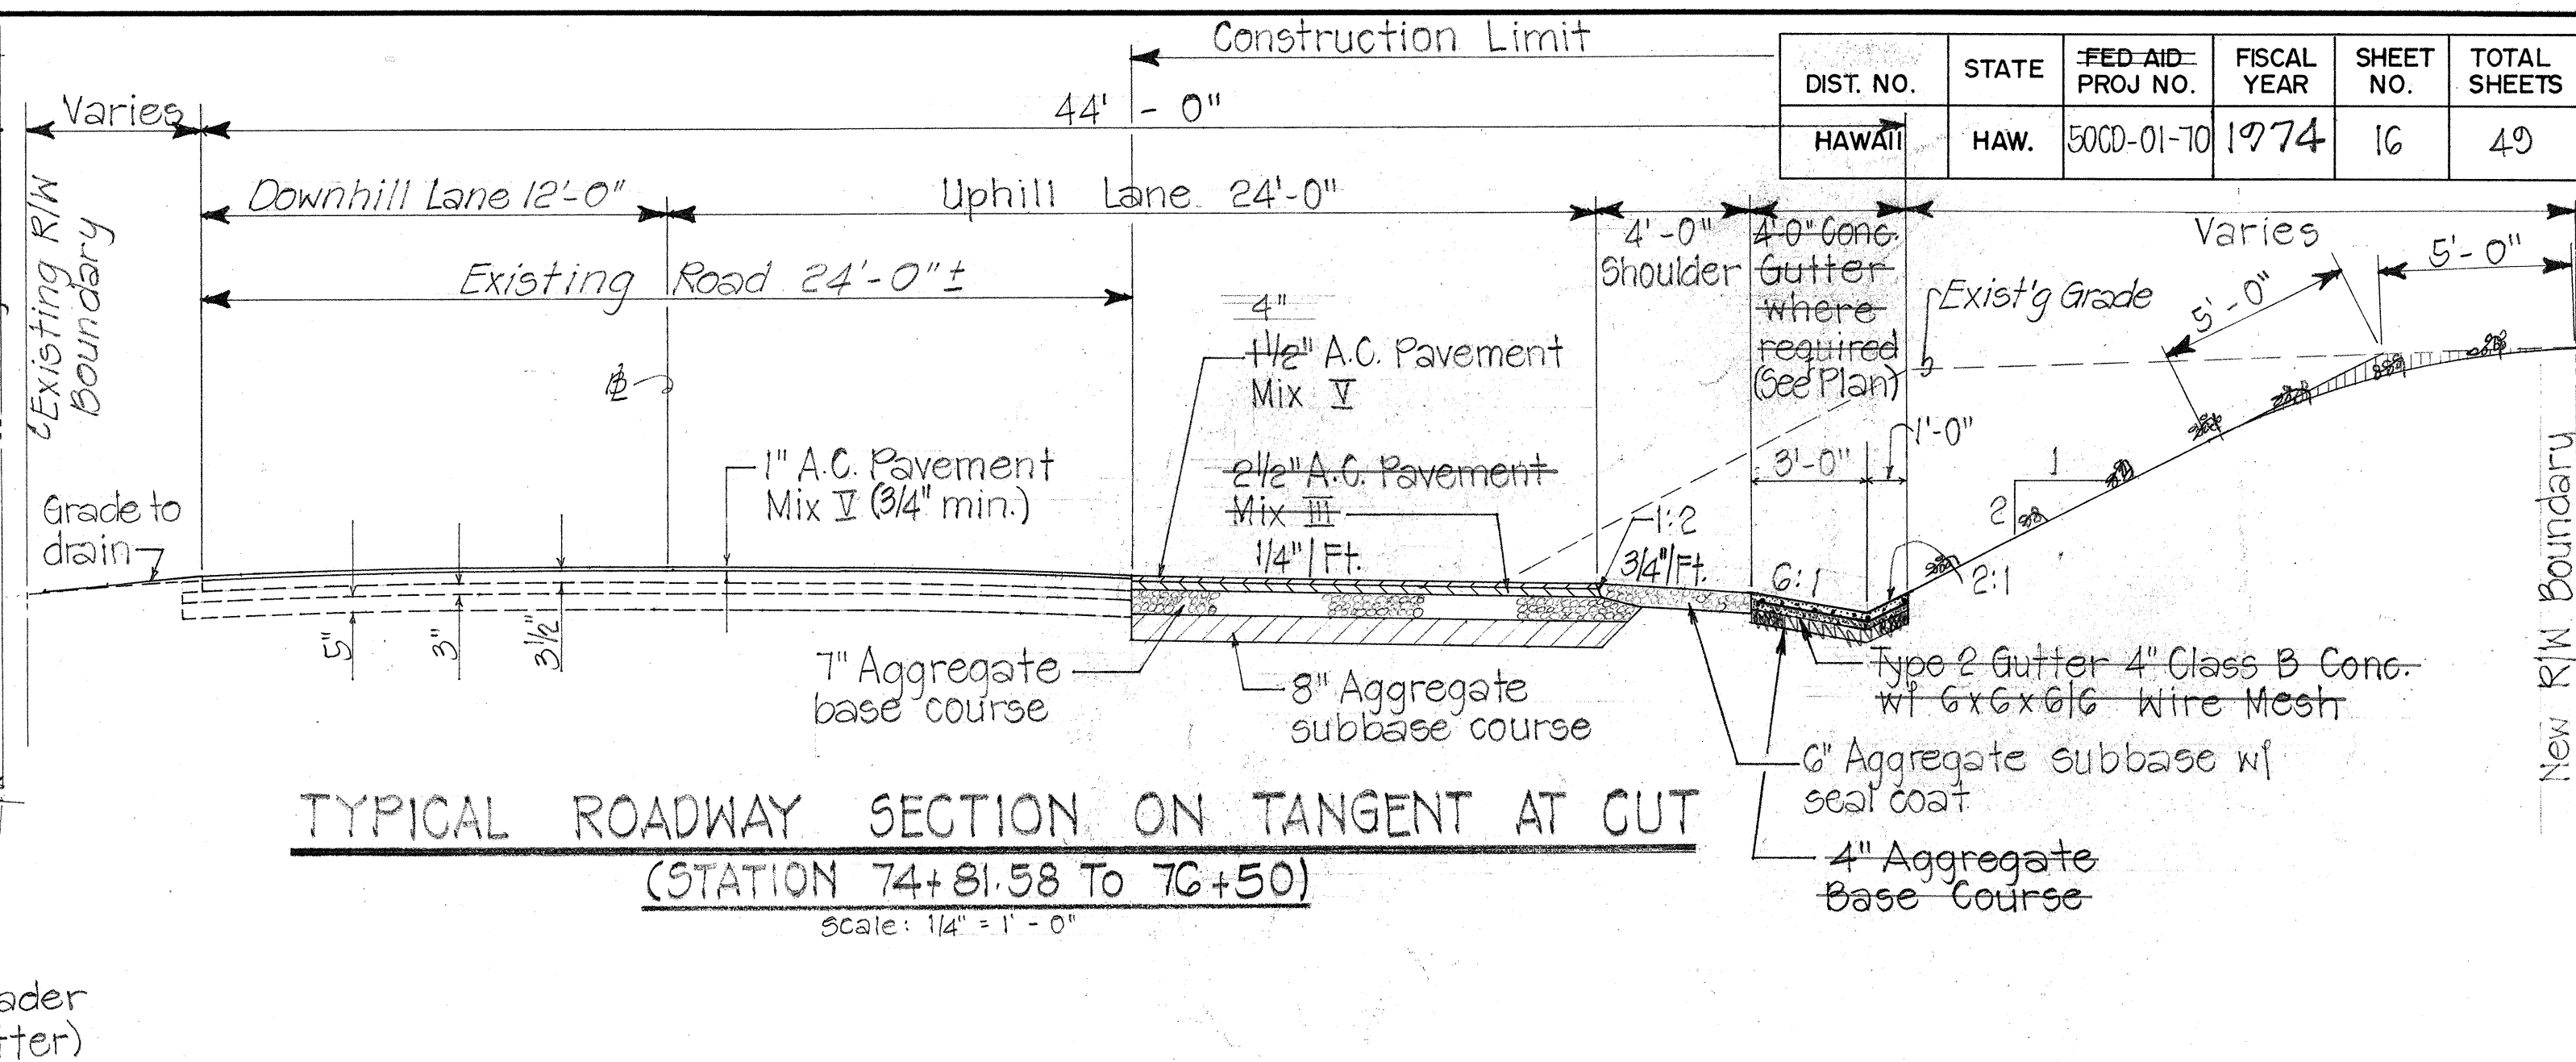


DIST. NO.	STATE	FED-AID- PROJ. NO.	FISCAL YEAR	SHEET NO.	TOTAL SHEETS
HAWAII	HAW.	5000-01-10	1974	16	49

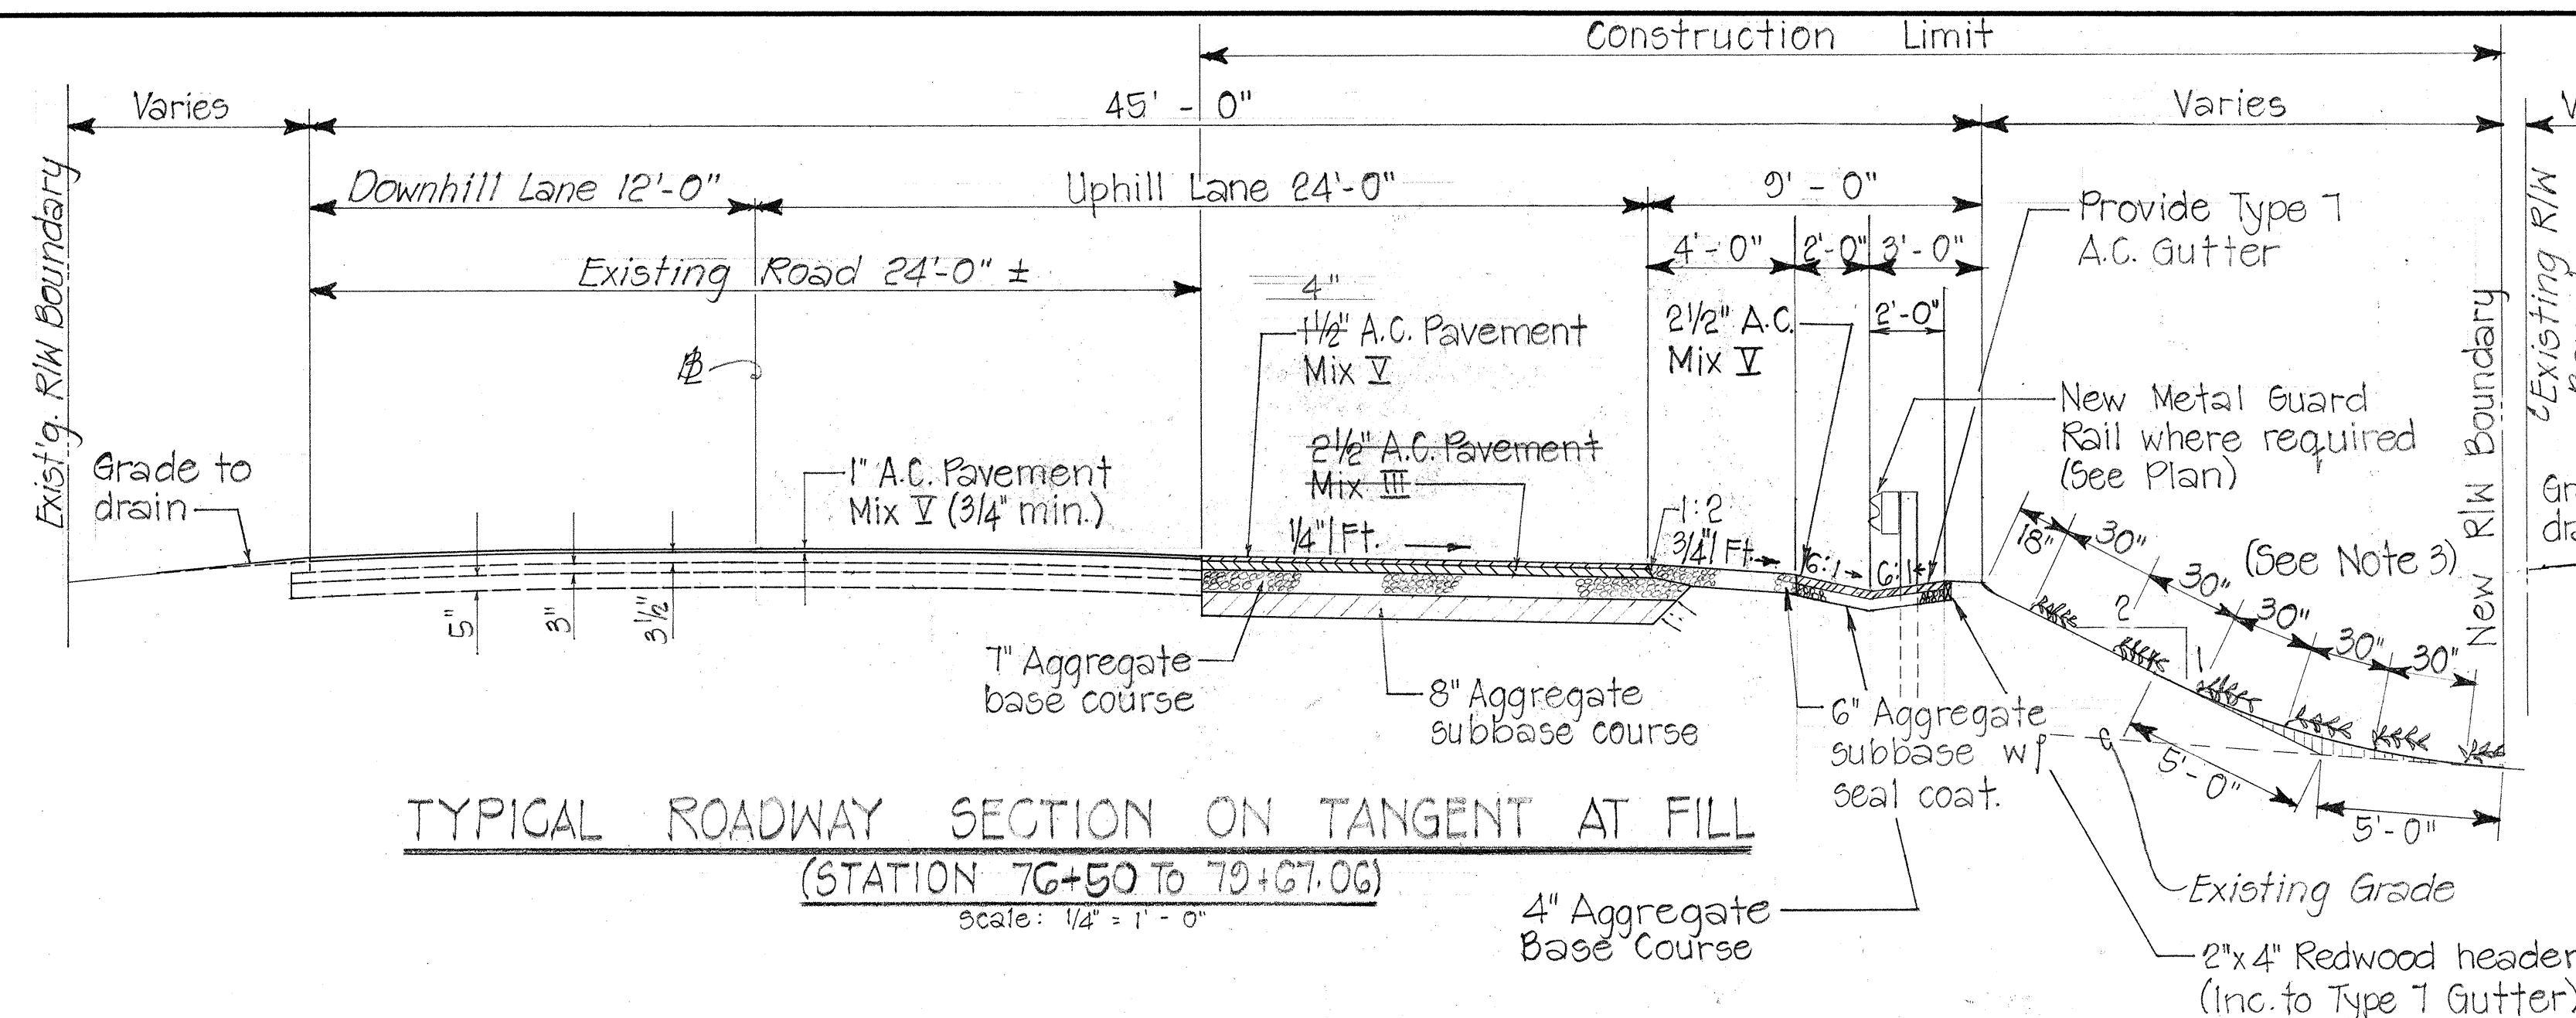

GENERAL NOTES:

- The typical sections shown are in general only and is not intended to depict any specific location.
- All wire mesh reinforcing shall be considered incidental to the various contract items.
- HA-1833 Dwarf Pangola Grass shall be planted in holes 4" Dia x 6" Deep at 30"x30" spacing. (Typical for all Cut and Fill Areas)

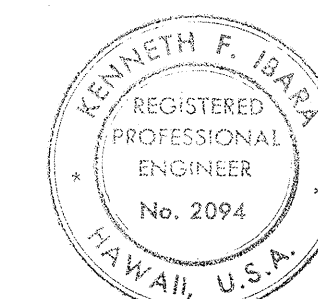

THIS WORK WAS PREPARED BY ME
OR UNDER MY SUPERVISION.

Kenneth F. Ihara
Signature
2/13/73

STATE OF HAWAII
DEPARTMENT OF TRANSPORTATION
HIGHWAYS DIVISION

TYPICAL ROADWAY SECTIONS
LAWAI SECTION

TRUCK CLIMBING LANES AT THREE
LOCATIONS (NAHIAWA LAWAI AND OMALO VALLEYS)

PROJ. NO. 50 00-01-10

SHEET NO. OF SHEETS