

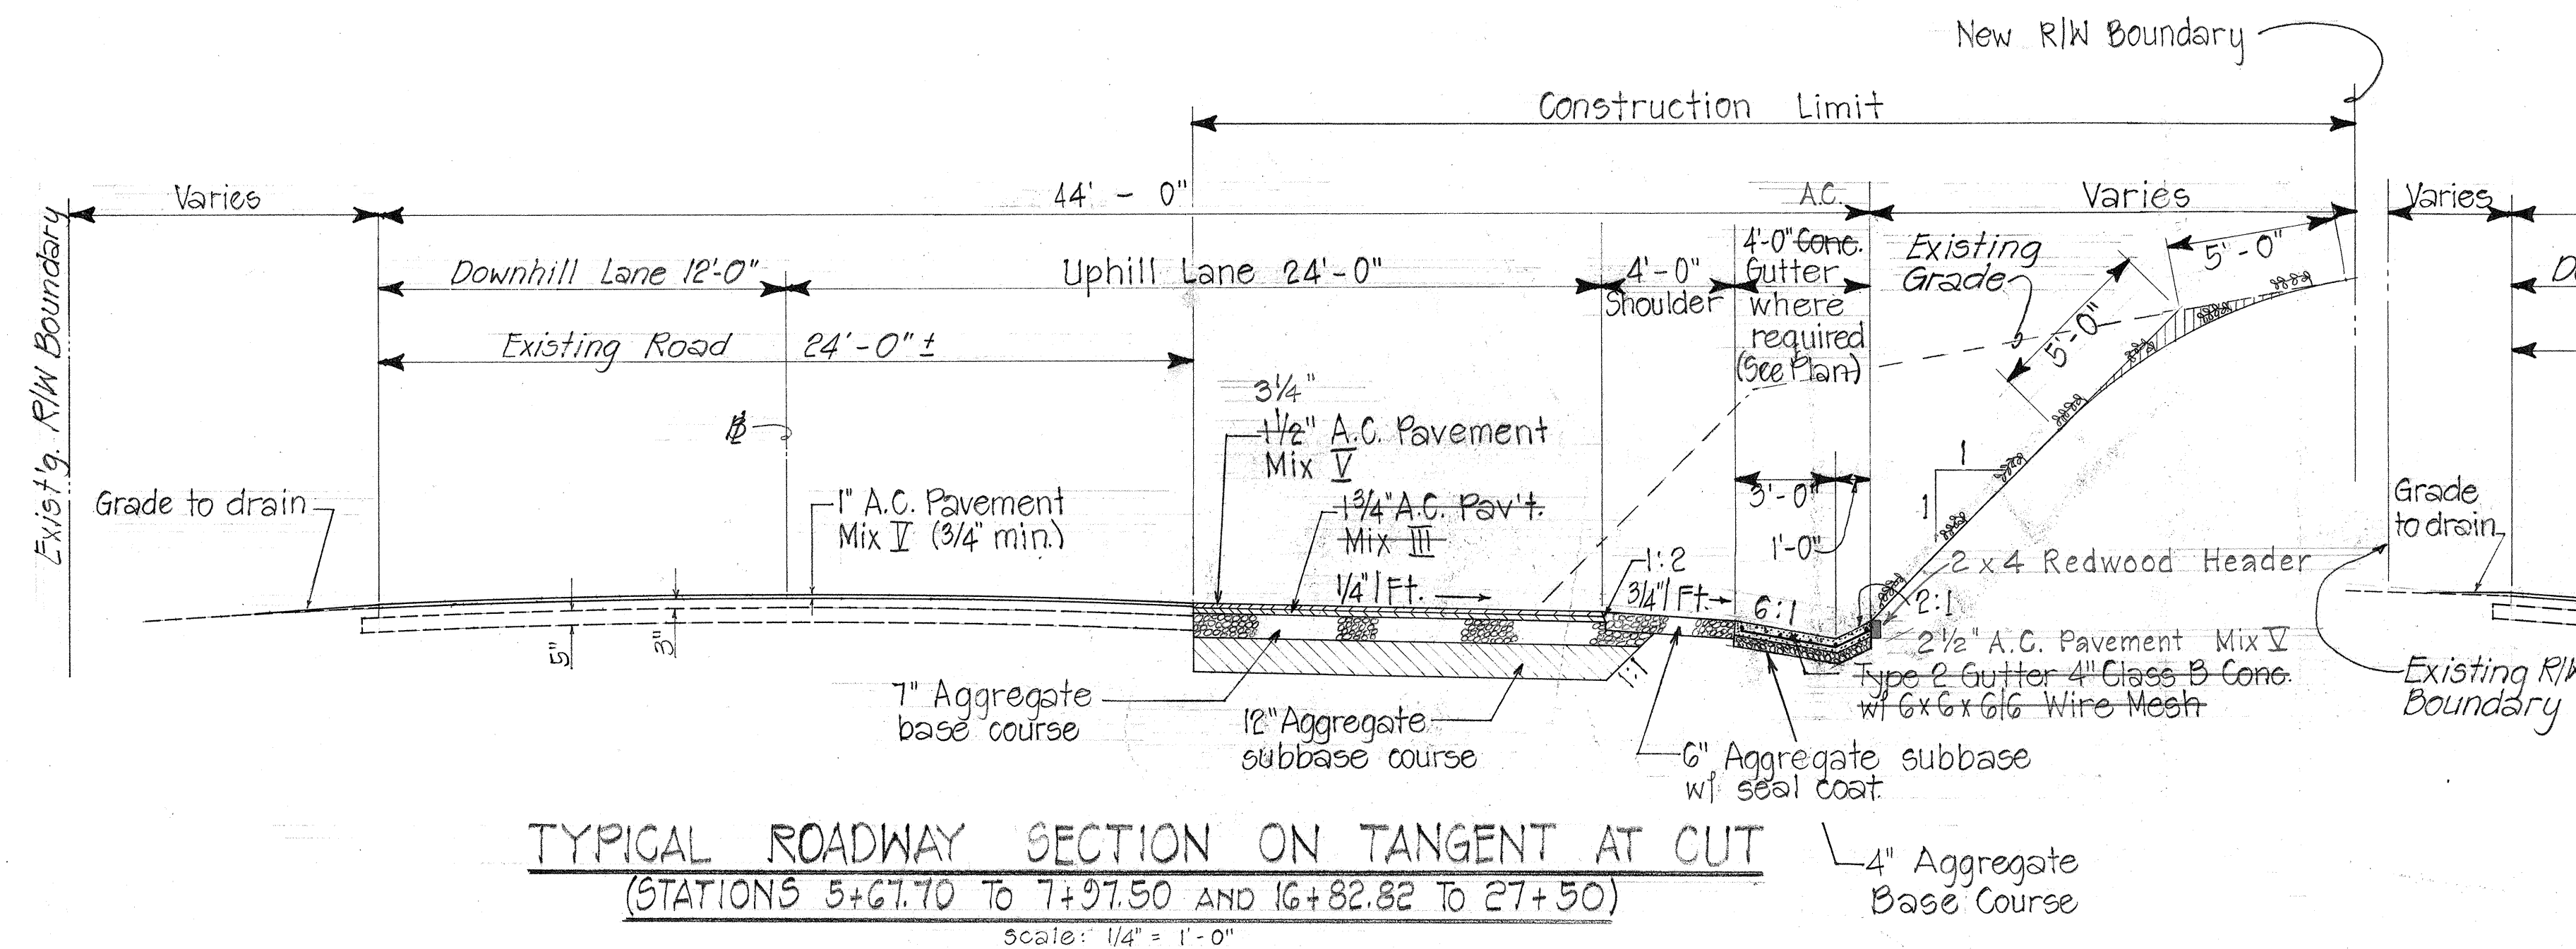


DIST. NO.	STATE	FED. AID PROJ. NO.	FISCAL YEAR	SHEET NO.	TOTAL SHEETS
HAWAII	HAW.	50CD-01-70	1974	5	49

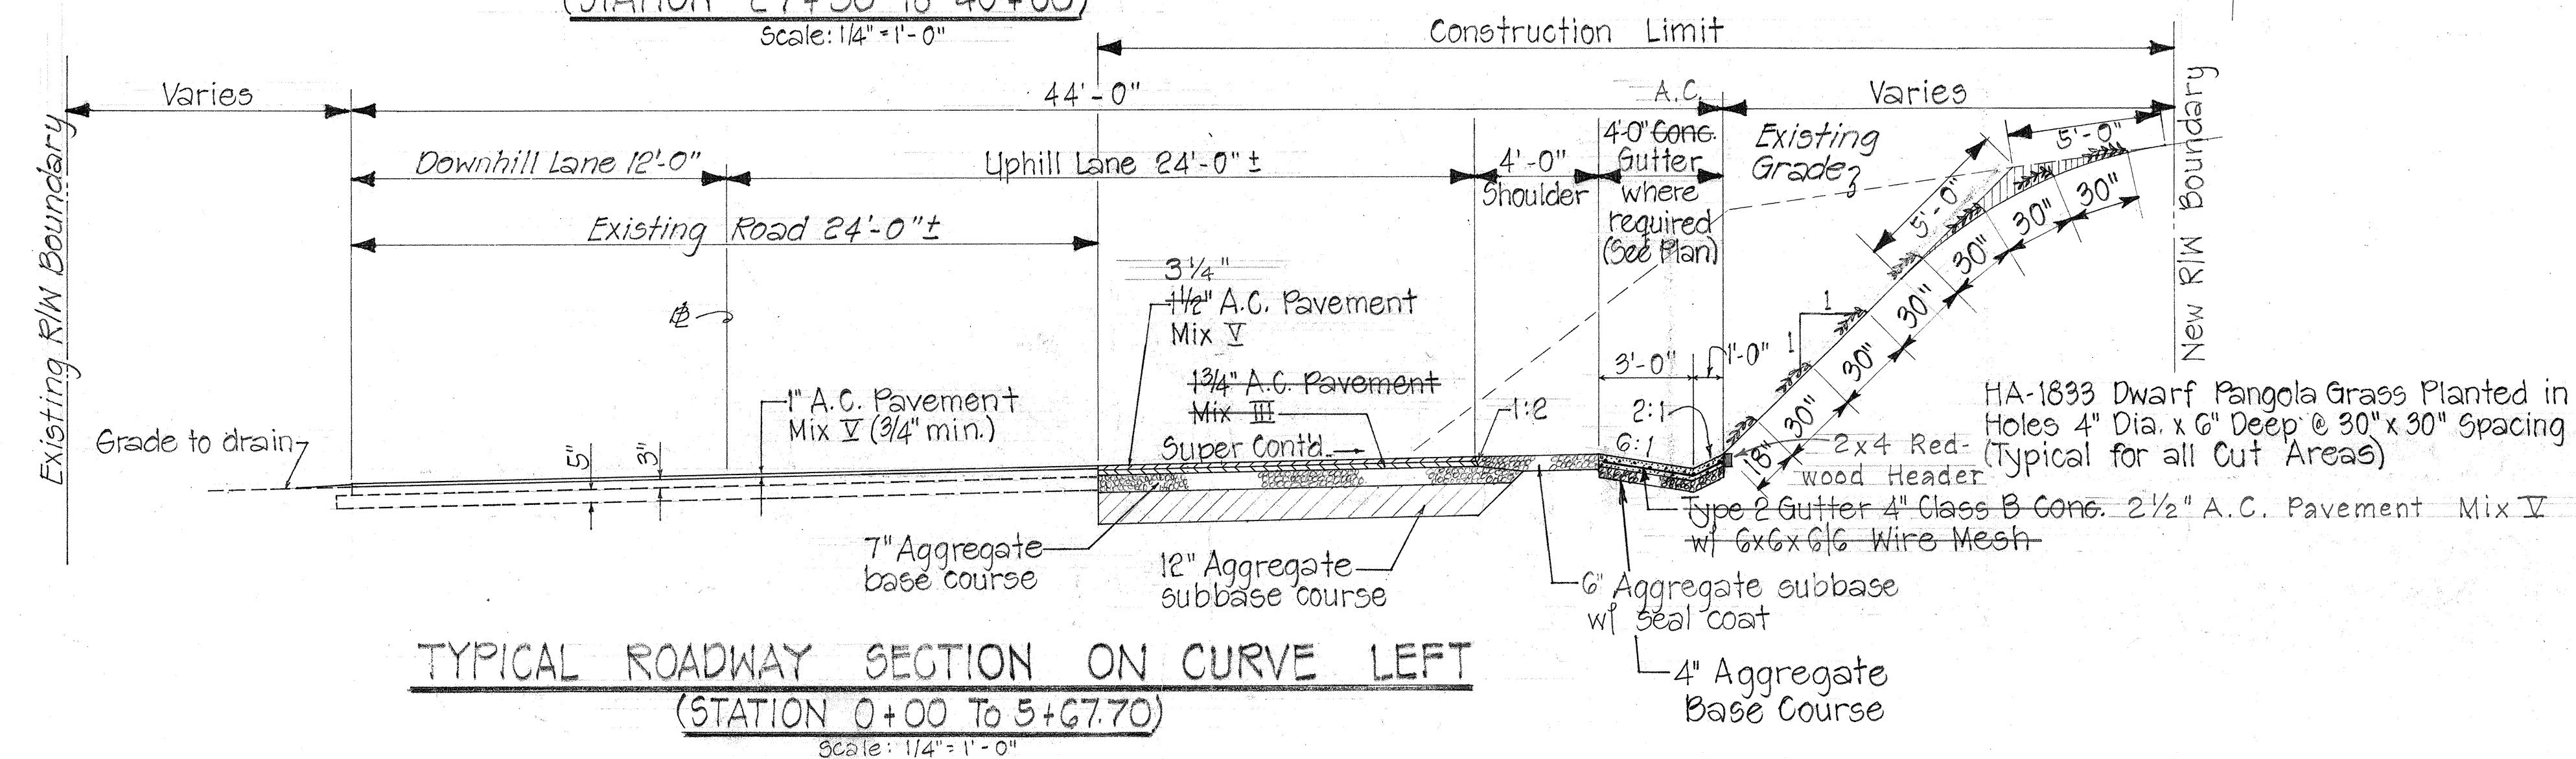

TYPICAL ROADWAY SECTION ON CURVE RIGHT
(STATION 7+97.50 TO 16+82.82)
Scale: 1/4" = 1'-0"

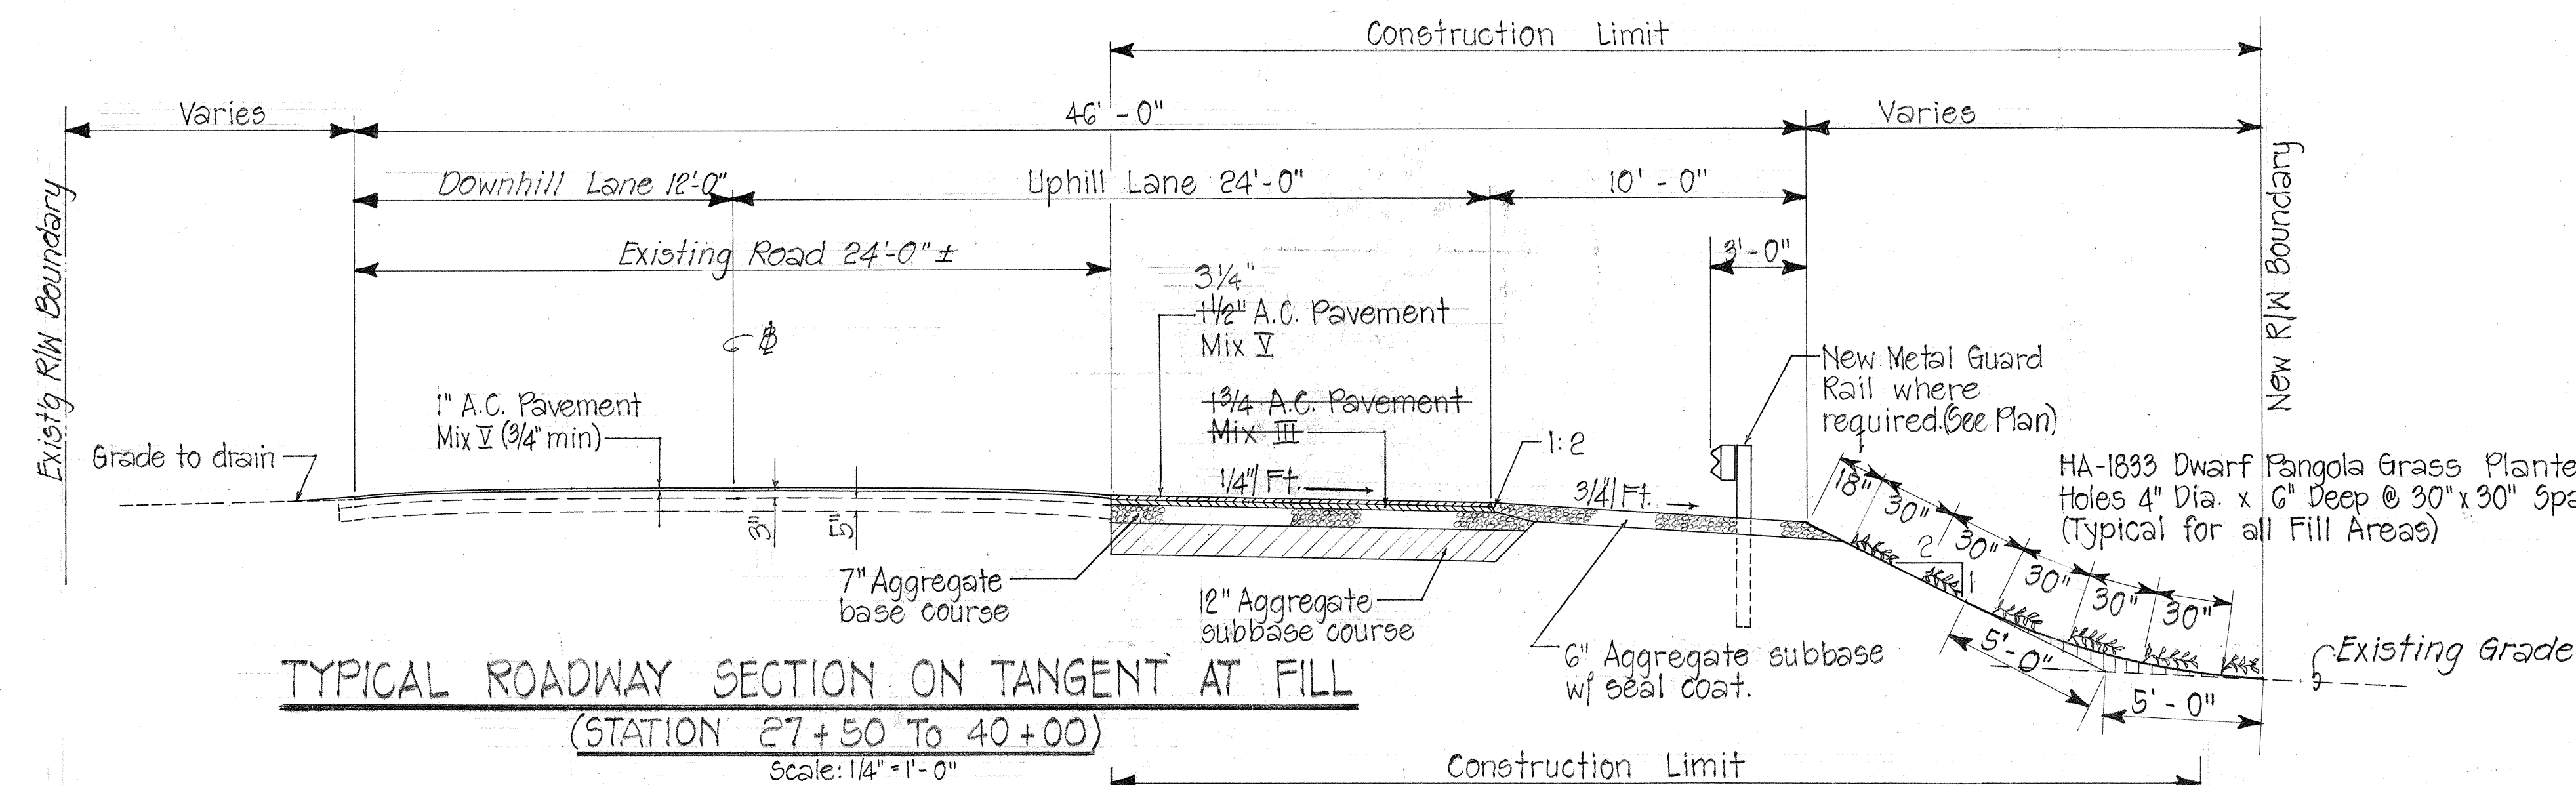

GENERAL NOTES:

1. Typical sections shown are in general only and is not intended to depict any specific location.
2. All wire mesh reinforcing shall be considered incidental to the various contract items.



THIS WORK WAS PREPARED BY ME OR UNDER MY SUPERVISION

Kenneth F. Isara
2/13/73

STATE OF HAWAII
DEPARTMENT OF TRANSPORTATION
HIGHWAYS DIVISION

TYPICAL ROADWAY SECTIONS
WAHIAWA SECTION

TRUCK CLIMBING LANES AT THREE
LOCATIONS (WAHIAWA, LAWAI AND OMAO VALLEYS)

PROJ. NO. 50 CD-01-70

SHEET NO. OF SHEETS