
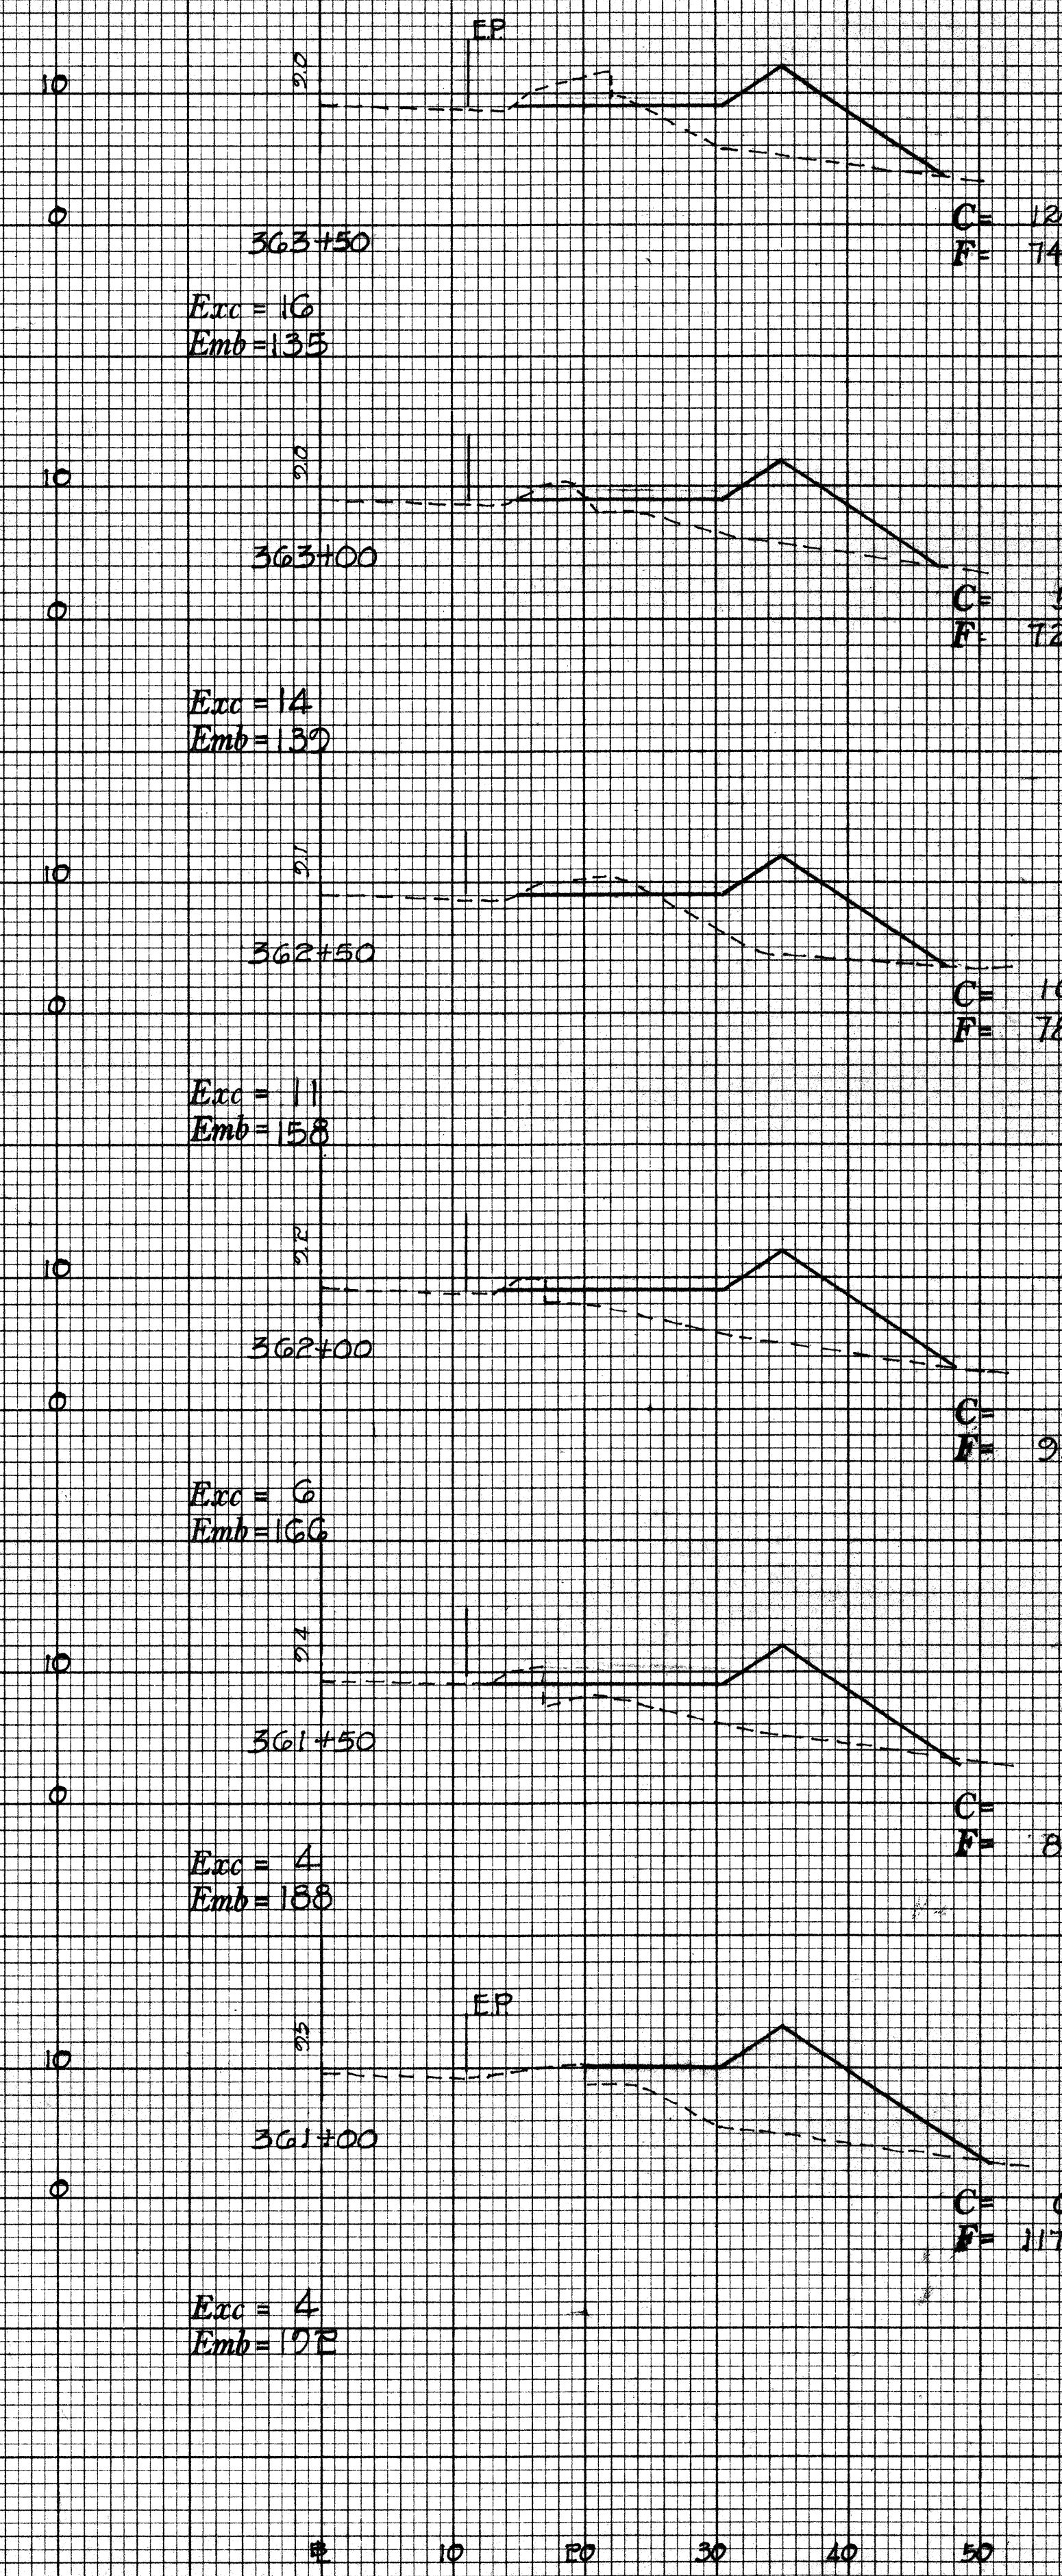
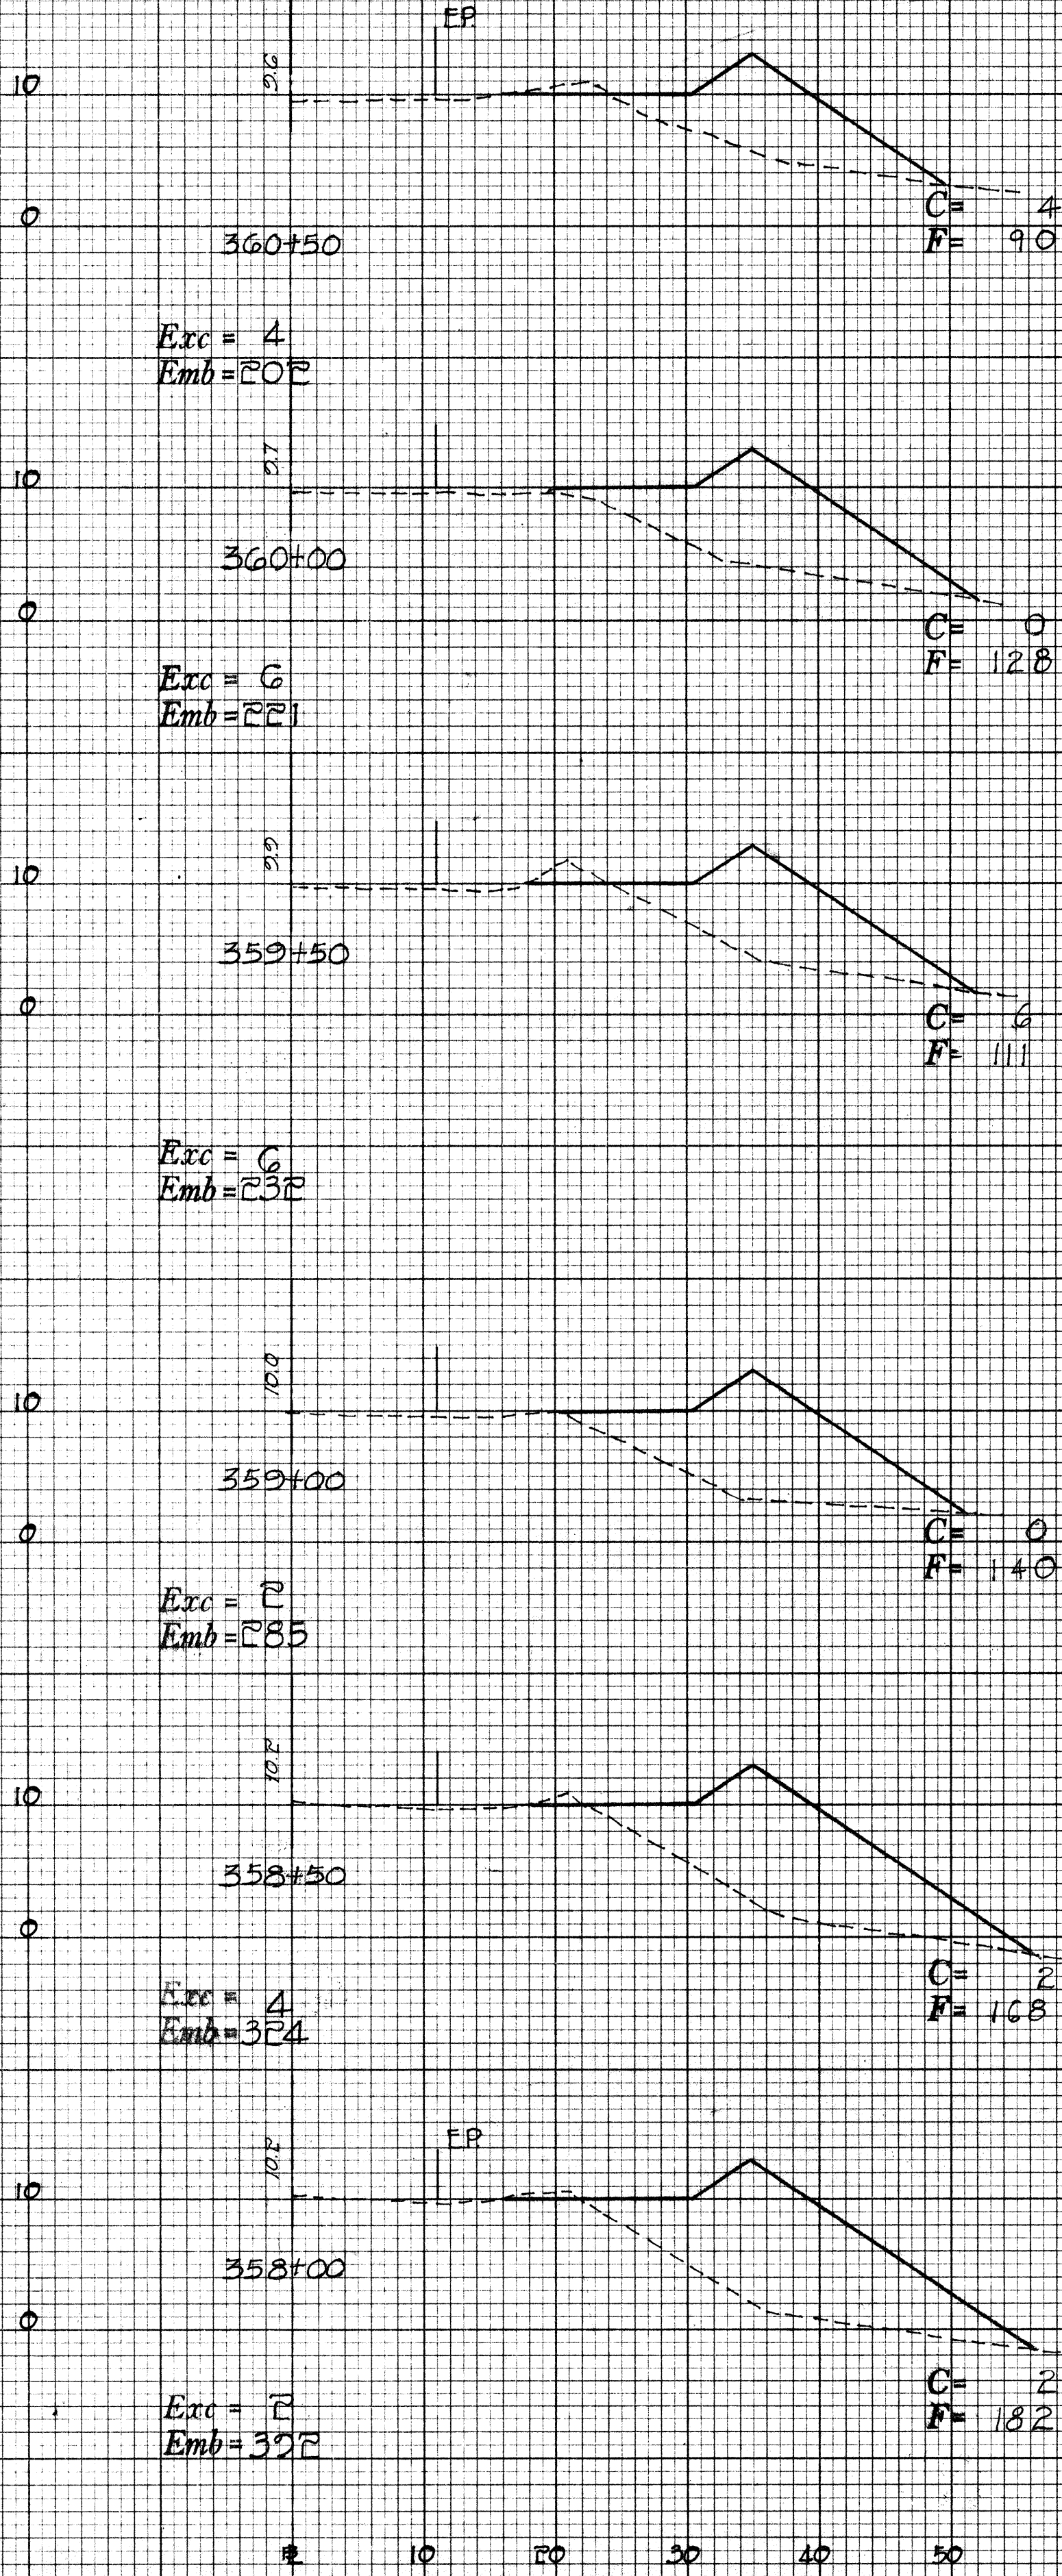


DIST. NO.	STATE	PROJ. NO.	FISCAL YEAR	SHEET NO.	TOTAL SHEETS
HAWAII	HAW.	50A-01-73	1974	4	7

DATE	BY	FINAL SURVEY	NOTED	PLOTTED	FILED	AREAS CHECKED


DATE	BY	ORIGINAL SURVEY	NOTED	PLOTTED	FILED	AREAS CHECKED

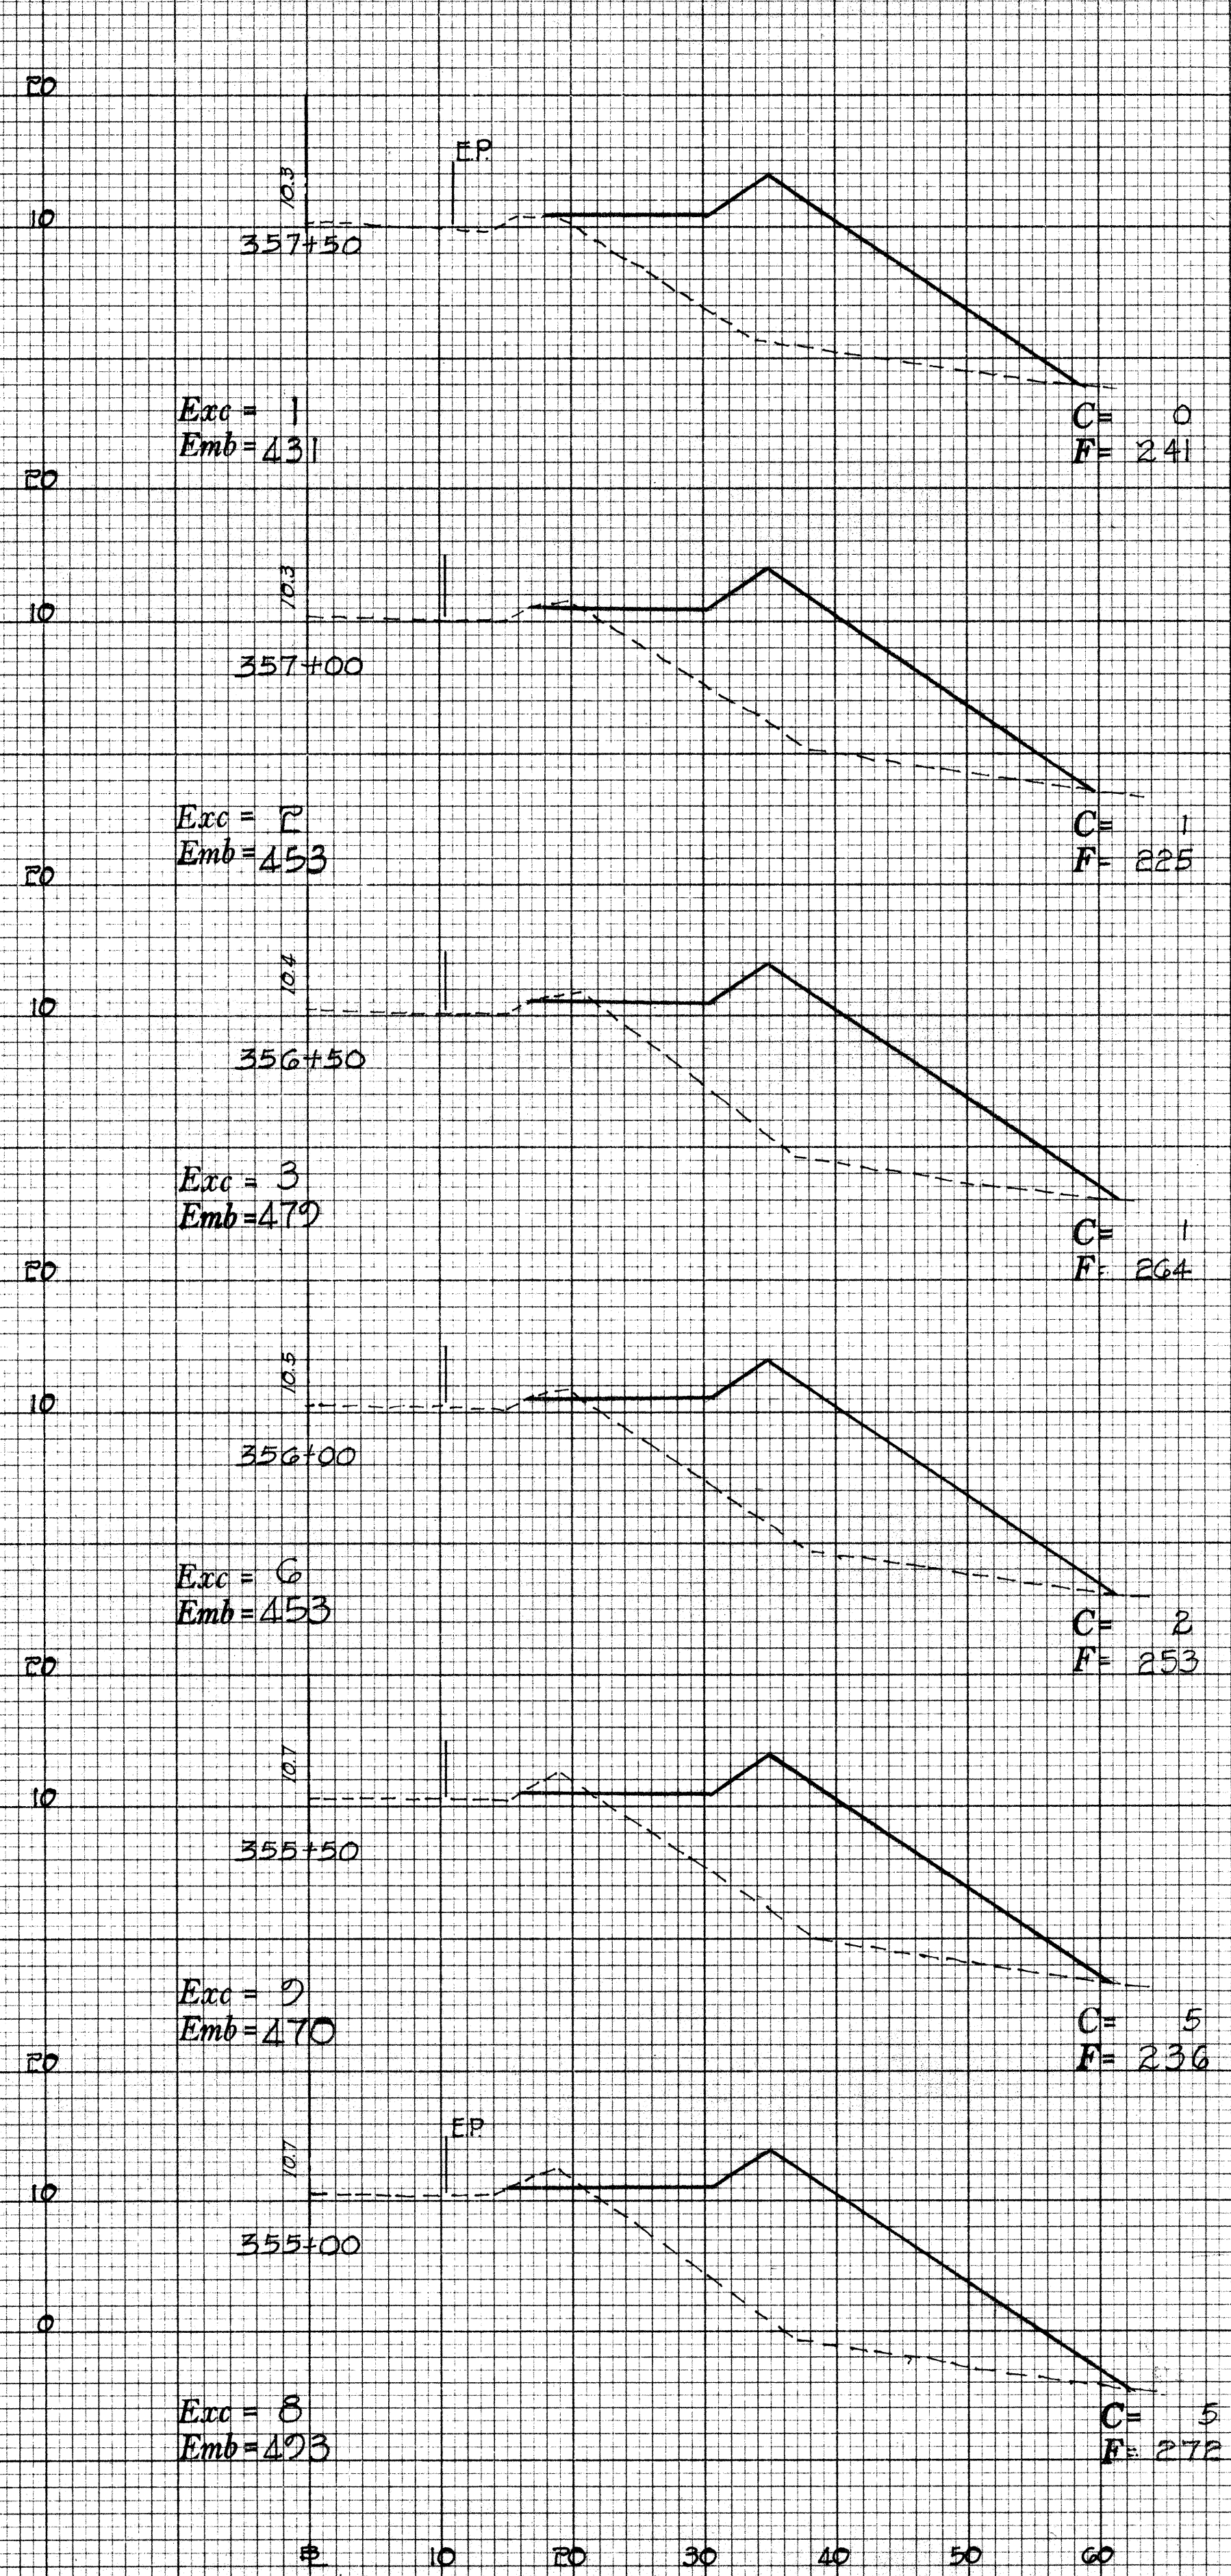

DIST. NO.	STATE	PROJ. NO.	FISCAL YEAR	SHEET NO.	TOTAL SHEETS
HAWAII	HAW.	50A-01-73	1974	5	7

FINAL SURVEY	DATE
SURVEYED	BY
PLOTTED	
TEMPERATURE	
WIND	
NO. OF AREAS CHECKED	

ORIGINAL SURVEY	DATE
SURVEYED	BY
PLOTTED	
TEMPERATURE	
WIND	
NO. OF AREAS CHECKED	

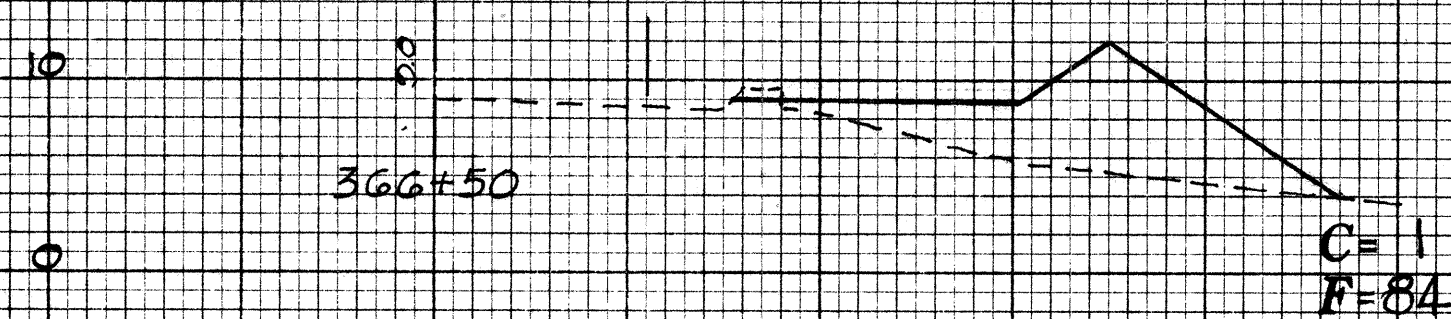

Exc = 2
Emb = 160

366+00

C = 1
F = 82

Exc = 1
Emb = 160

365+50

C = 1
F = 84

Exc = 1
Emb = 167

365+00

C = 1
F = 96

Exc = 2
Emb = 157

364+50


C = 1
F = 74

Exc = 2
Emb = 156

364+00

C = 1
F = 95

Exc = 15
Emb = 156

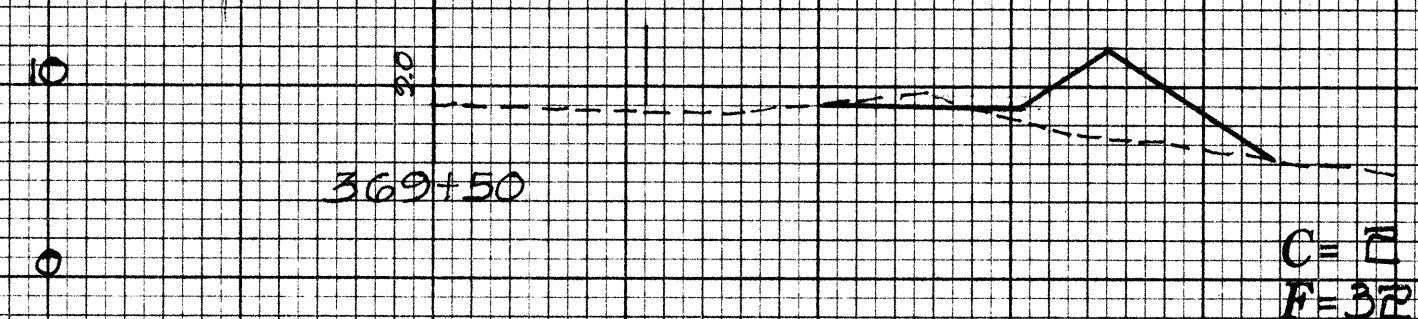

Exc = 0
Emb = 56

369+00

C = 8
F = 88

Exc = 7
Emb = 61

368+50

C = 0
F = 38

Exc = 0
Emb = 95

368+00

C = 0
F = 65

Exc = 11
Emb = 94

367+50


C = 12
F = 37

Exc = 13
Emb = 87

367+00

C = 5
F = 57

Exc = 3
Emb = 131

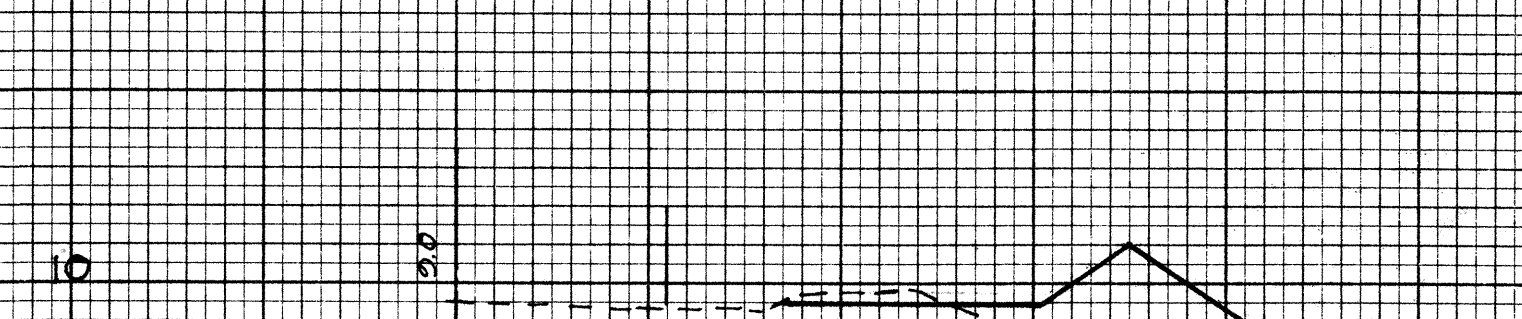

C = 4
F = 57

Exc = 5
Emb = 112

372+00

C = 1
F = 71

Exc = 1
Emb = 127

371+50

C = 0
F = 66

Exc = 6
Emb = 144

371+00

C = 7
F = 90

Exc = 12
Emb = 129

370+50

C = 6
F = 49

Exc = 9
Emb = 131

370+00


C = 4
F = 93

Exc = 6
Emb = 116

DIST. NO.	STATE	PROJ. NO.	FISCAL YEAR	SHEET NO.	TOTAL SHEETS
HAWAII	HAW.	50A-01-73	1974	6	7

DATE	BY	FINAL SURVEY	SURVEYED	PLOTTED	DATE	NO.
		NOTE BOOK	AREAS	CHECKED		

DATE	BY	ORIGINAL SURVEY	SURVEYED	PLOTTED	DATE	NO.
		NOTE BOOK	AREAS	CHECKED		

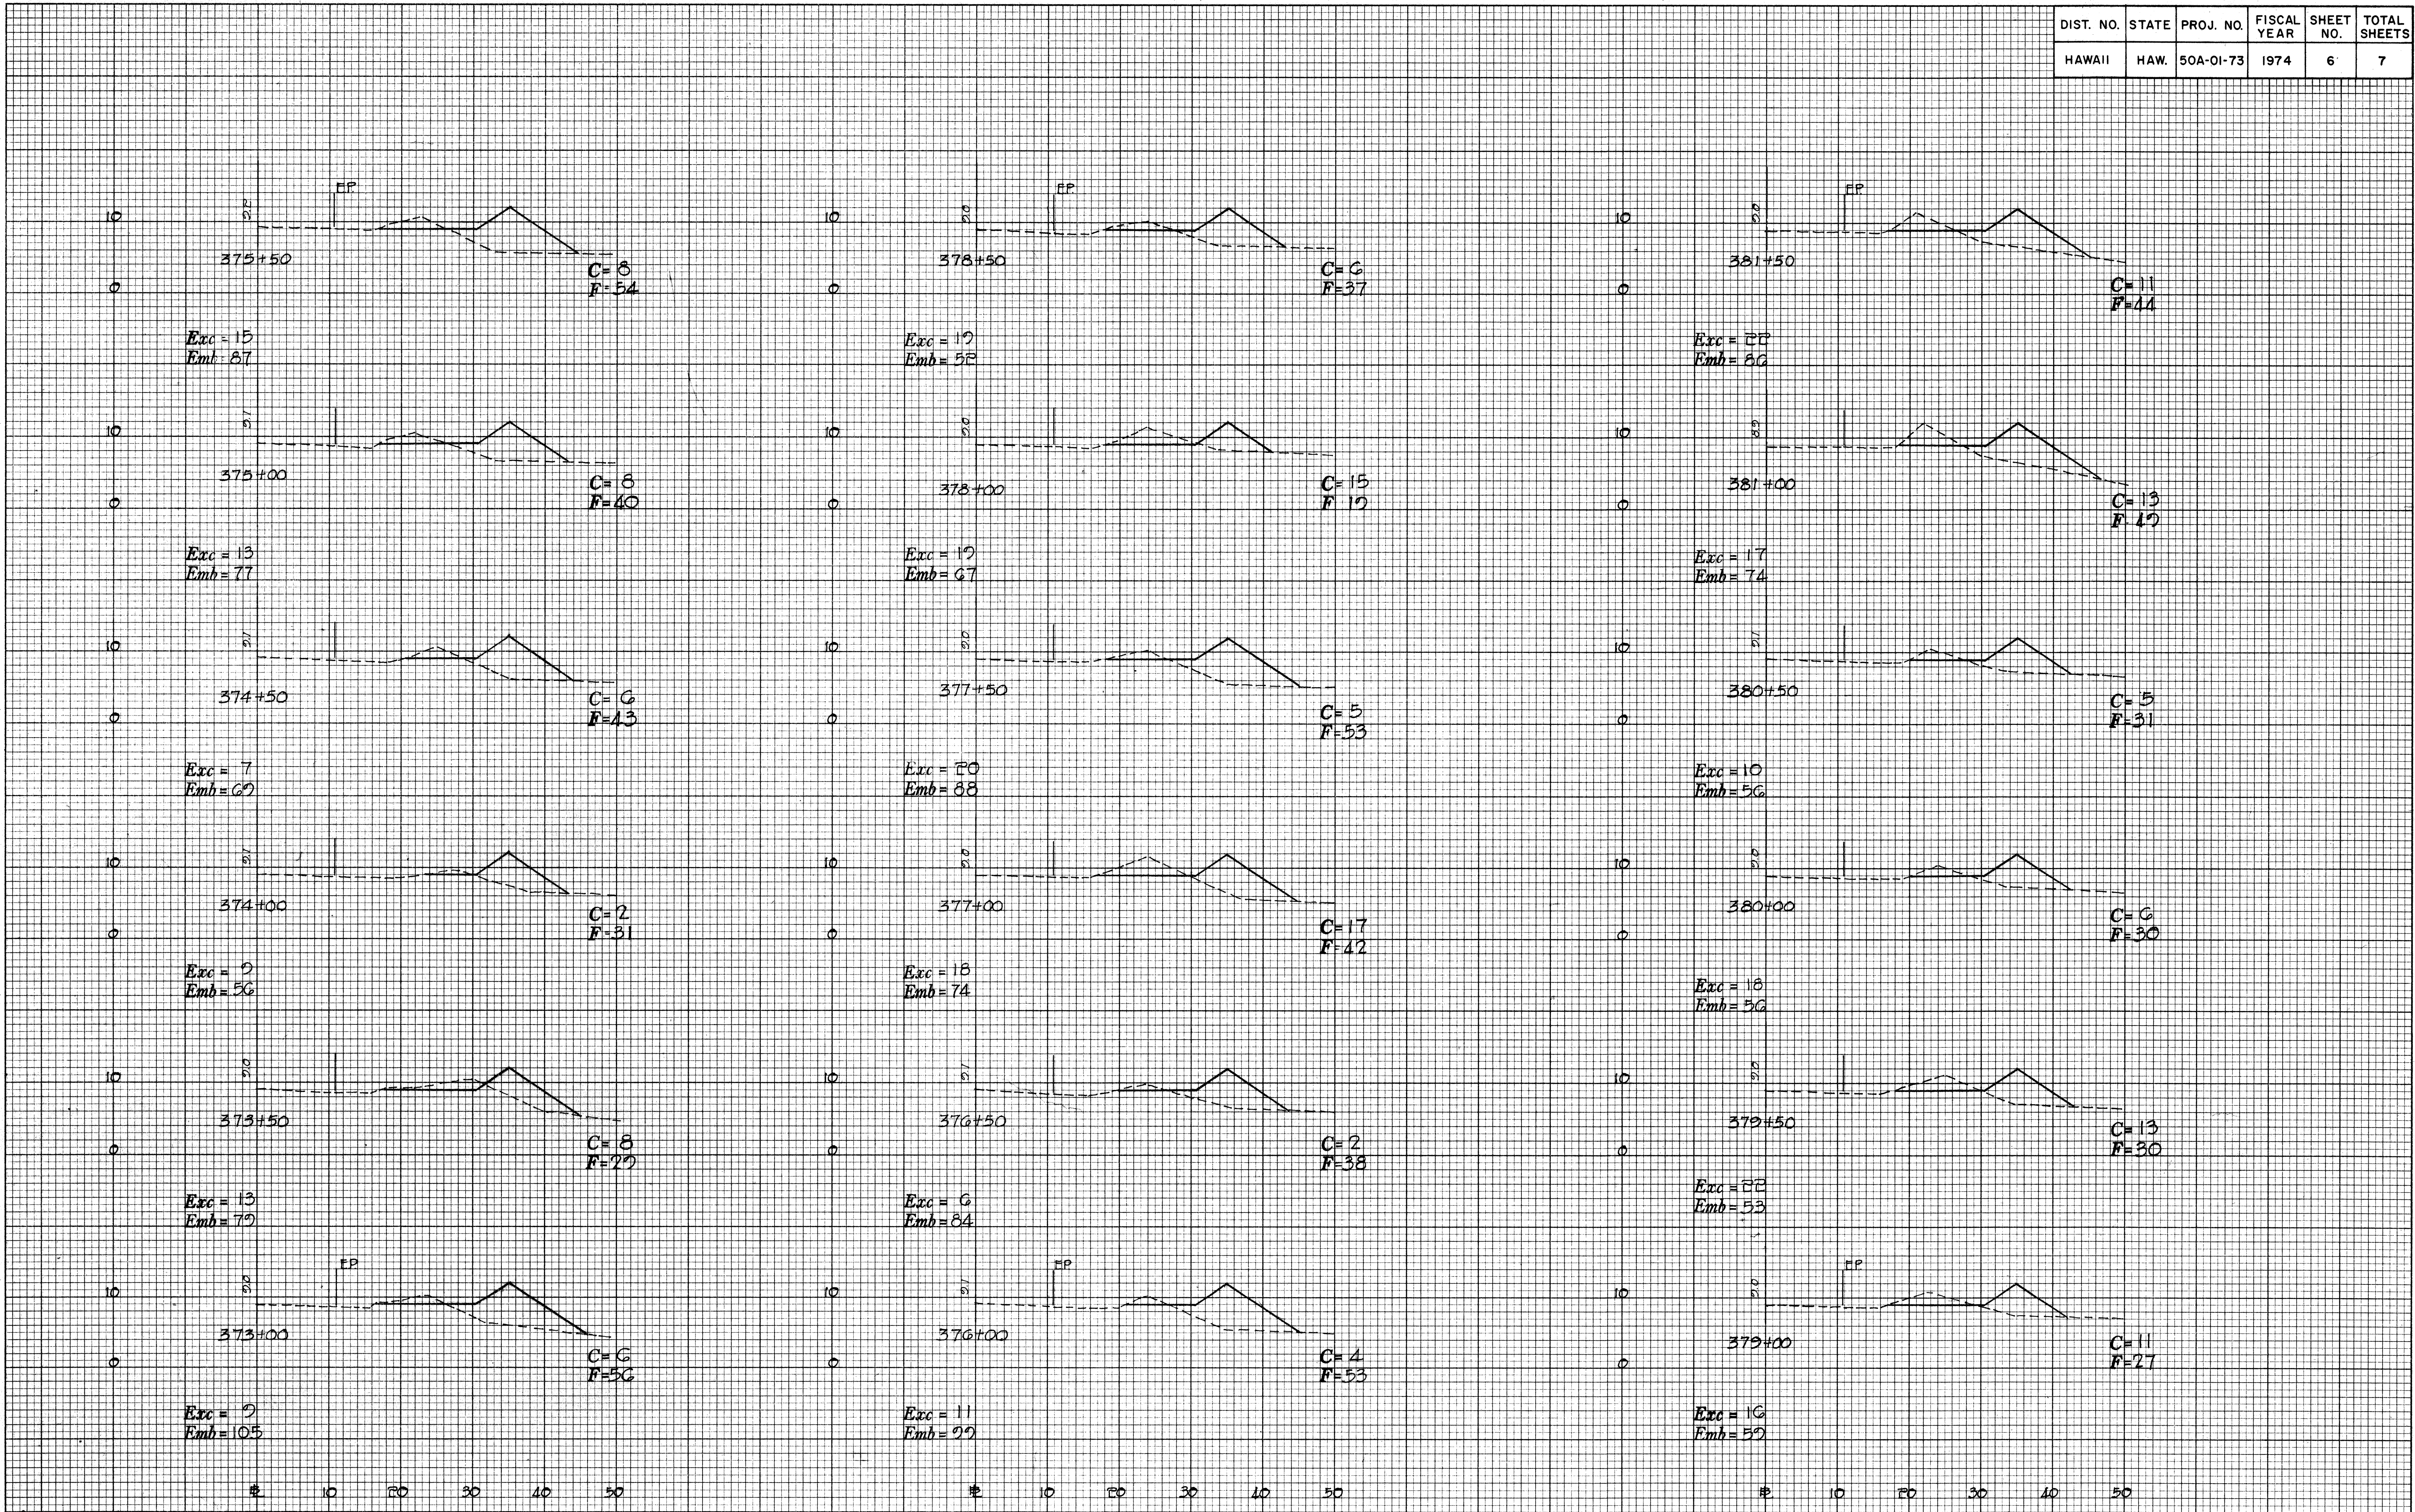

DIST. NO.	STATE	PROJ. NO.	FISCAL YEAR	SHEET NO.	TOTAL SHEETS
HAWAII	HAW.	50A-01-73	1974	7	7

DATE	BY	FINAL SURVEY	SURVEYED	PLOTTED	TEMPLATE	NO. OF AREAS CHECKED

DATE	BY	ORIGINAL SURVEY	SURVEYED	PLOTTED	TEMPLATE	NO. OF AREAS CHECKED

