


INDEX TO DRAWINGS	
SHEET NO.	DESCRIPTION
1	TITLE SHEET
2	TYPICAL SECTION & GENERAL NOTES
3	PLAN-STRIPING & RAISED PAV'T. MARKERS

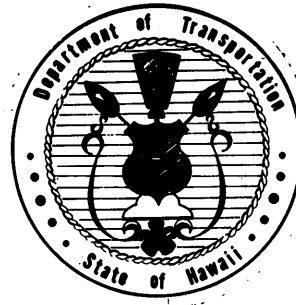


STATE OF HAWAII
DEPARTMENT OF TRANSPORTATION
HIGHWAYS DIVISION

"AS BUILT"
PLANS FOR
KAUMUALII HIGHWAY, RESURFACING
AT WEST OMAO

PROJECT NO. 50D-02-76

DISTRICT OF KOLOA

ISLAND OF KAUAI

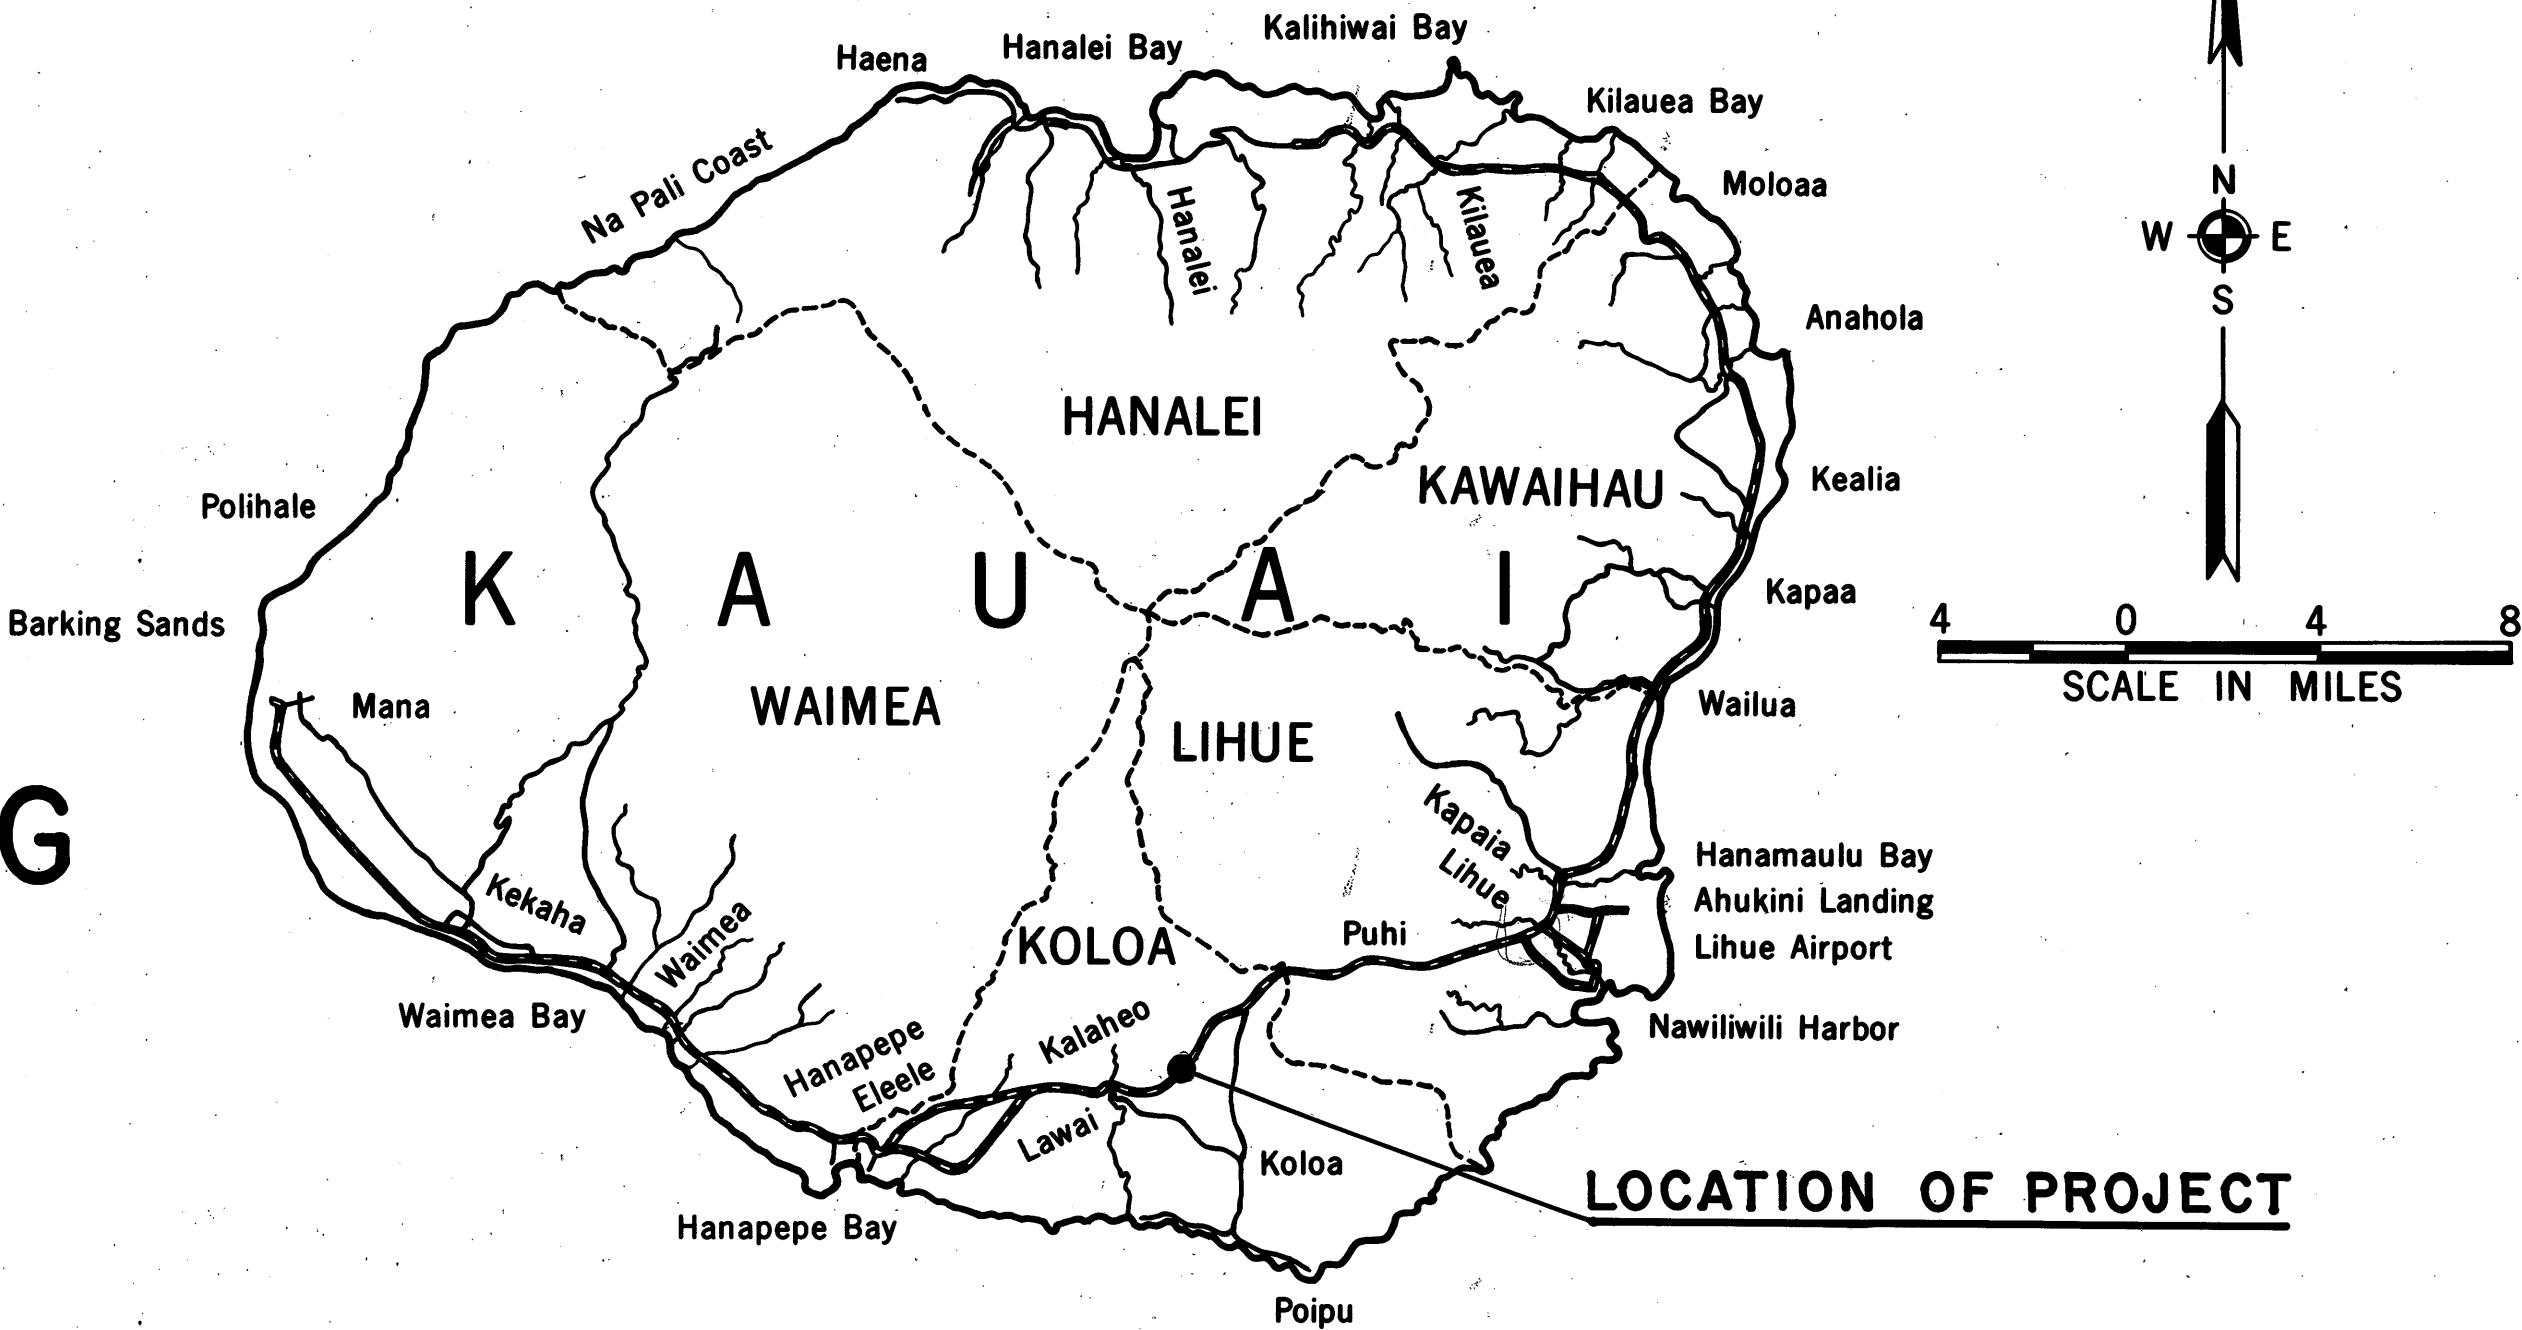

FEDERAL AID PROJECTS PREVIOUSLY CONSTRUCTED
OR UNDER CONSTRUCTION


NOTE:
ALL CHANGES MADE DURING CONSTRUCTION HAVE
BEEN NOTED IN RED ON THESE TRACINGS AND
CHECKED BY:

[Signature]
PROJECT ENGINEER

2-23-77
DATE

DEPARTMENT OF TRANSPORTATION STATE OF HAWAII	
APPROVED: <i>R. Higashionna</i>	3-19-76 DATE
for DIR. OF TRANSPORTATION	

KAUAI DISTRICT DESIGNED BY D. BEVIER 548-7537 5/16/76 DATE
P. S. & E. BY PHONE

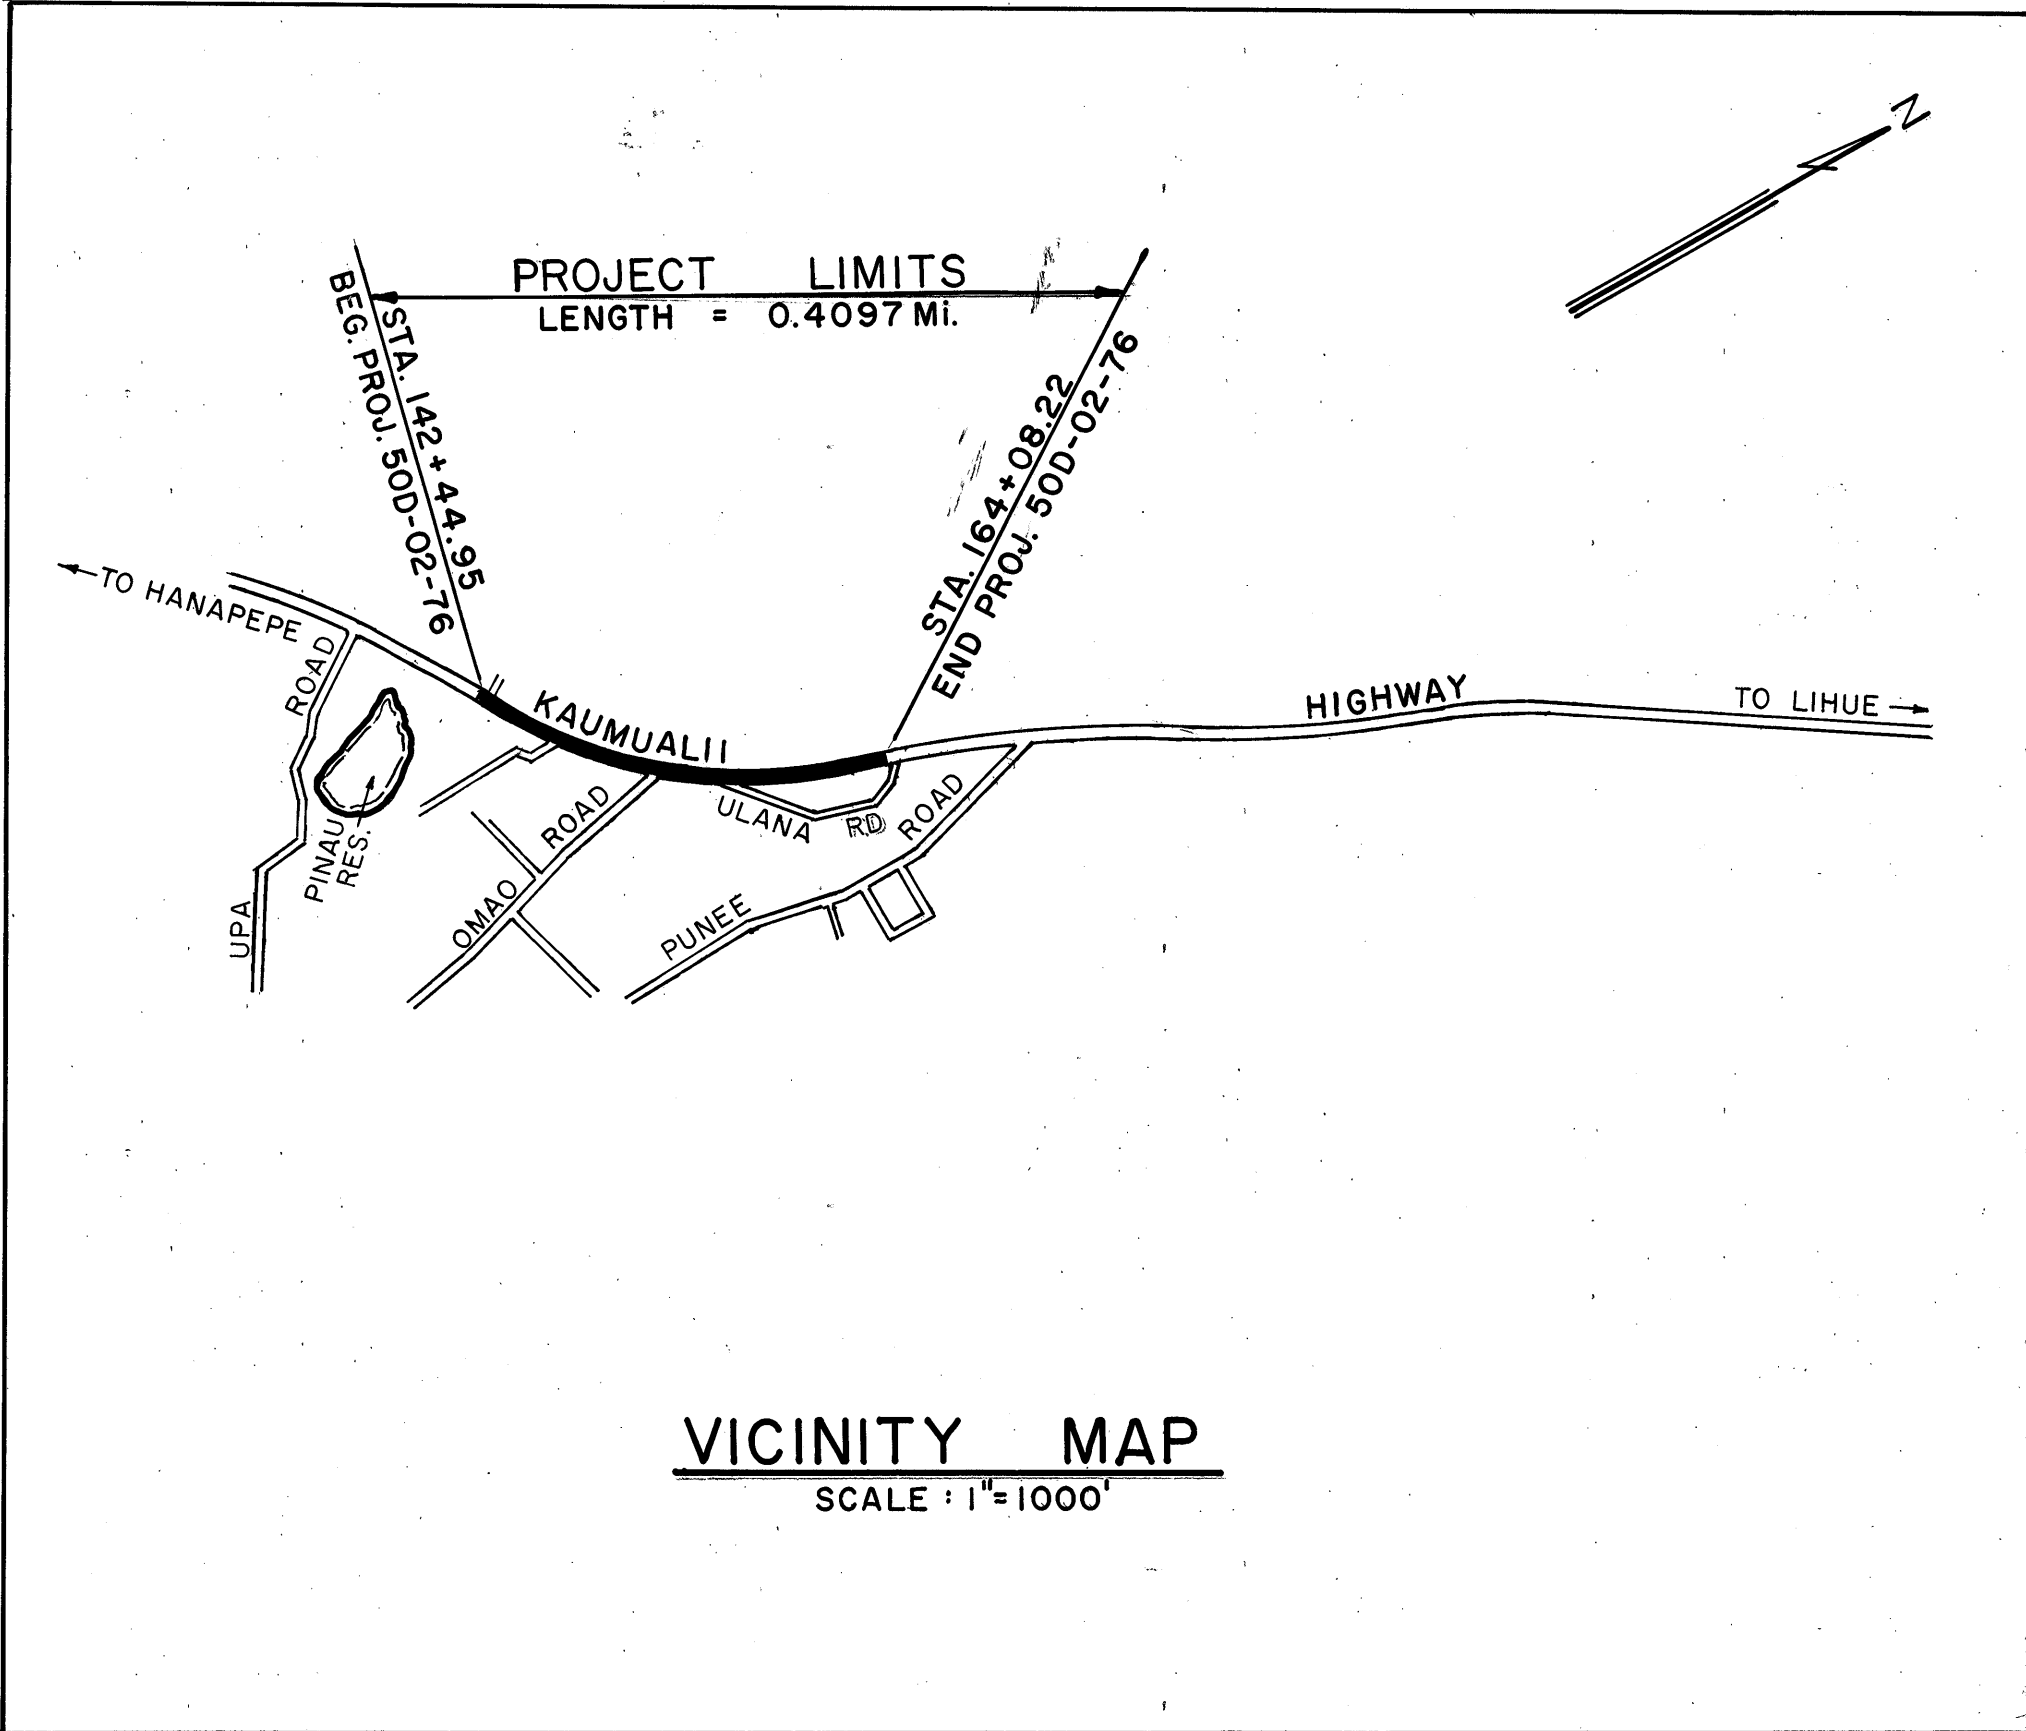

VICINITY MAP
SCALE: 1"=1000'