


INDEX TO DRAWINGS	
SHEET NO.	DESCRIPTION
1	TITLE SHEET
2-5	PLANS
6	GENERAL NOTE & QUANTITIES
7	MISCELLANEOUS DETAILS
8	DETAIL-BREAKAWAY CABLE
	TERMINAL (BCT)
9-15	STANDARD DETAILS

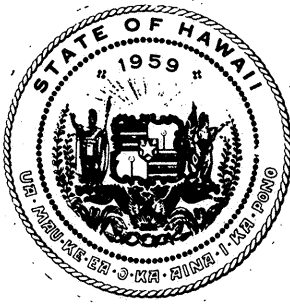

STATE OF HAWAII

DEPARTMENT OF TRANSPORTATION

LAND TRANSPORTATION FACILITIES DIVISION

AS-BUILT

PLANS FOR

ROUTE 50 - KAUMUALII HIGHWAY,

SAFETY IMPROVEMENTS AT VARIOUS



LOCATIONS BETWEEN HANAPEPE AND PUHI

PROJECT NO. ROS-050-1(2)

DISTRICT OF KOLOA

ISLAND OF KAUAI

FED. ROAD DIST. NO.	STATE	FED. AID PROJ. NO.	FISCAL YEAR	SHEET NO.	TOTAL SHEETS
HAWAII	HAW.	ROS-050-1(2)	1977	1	15

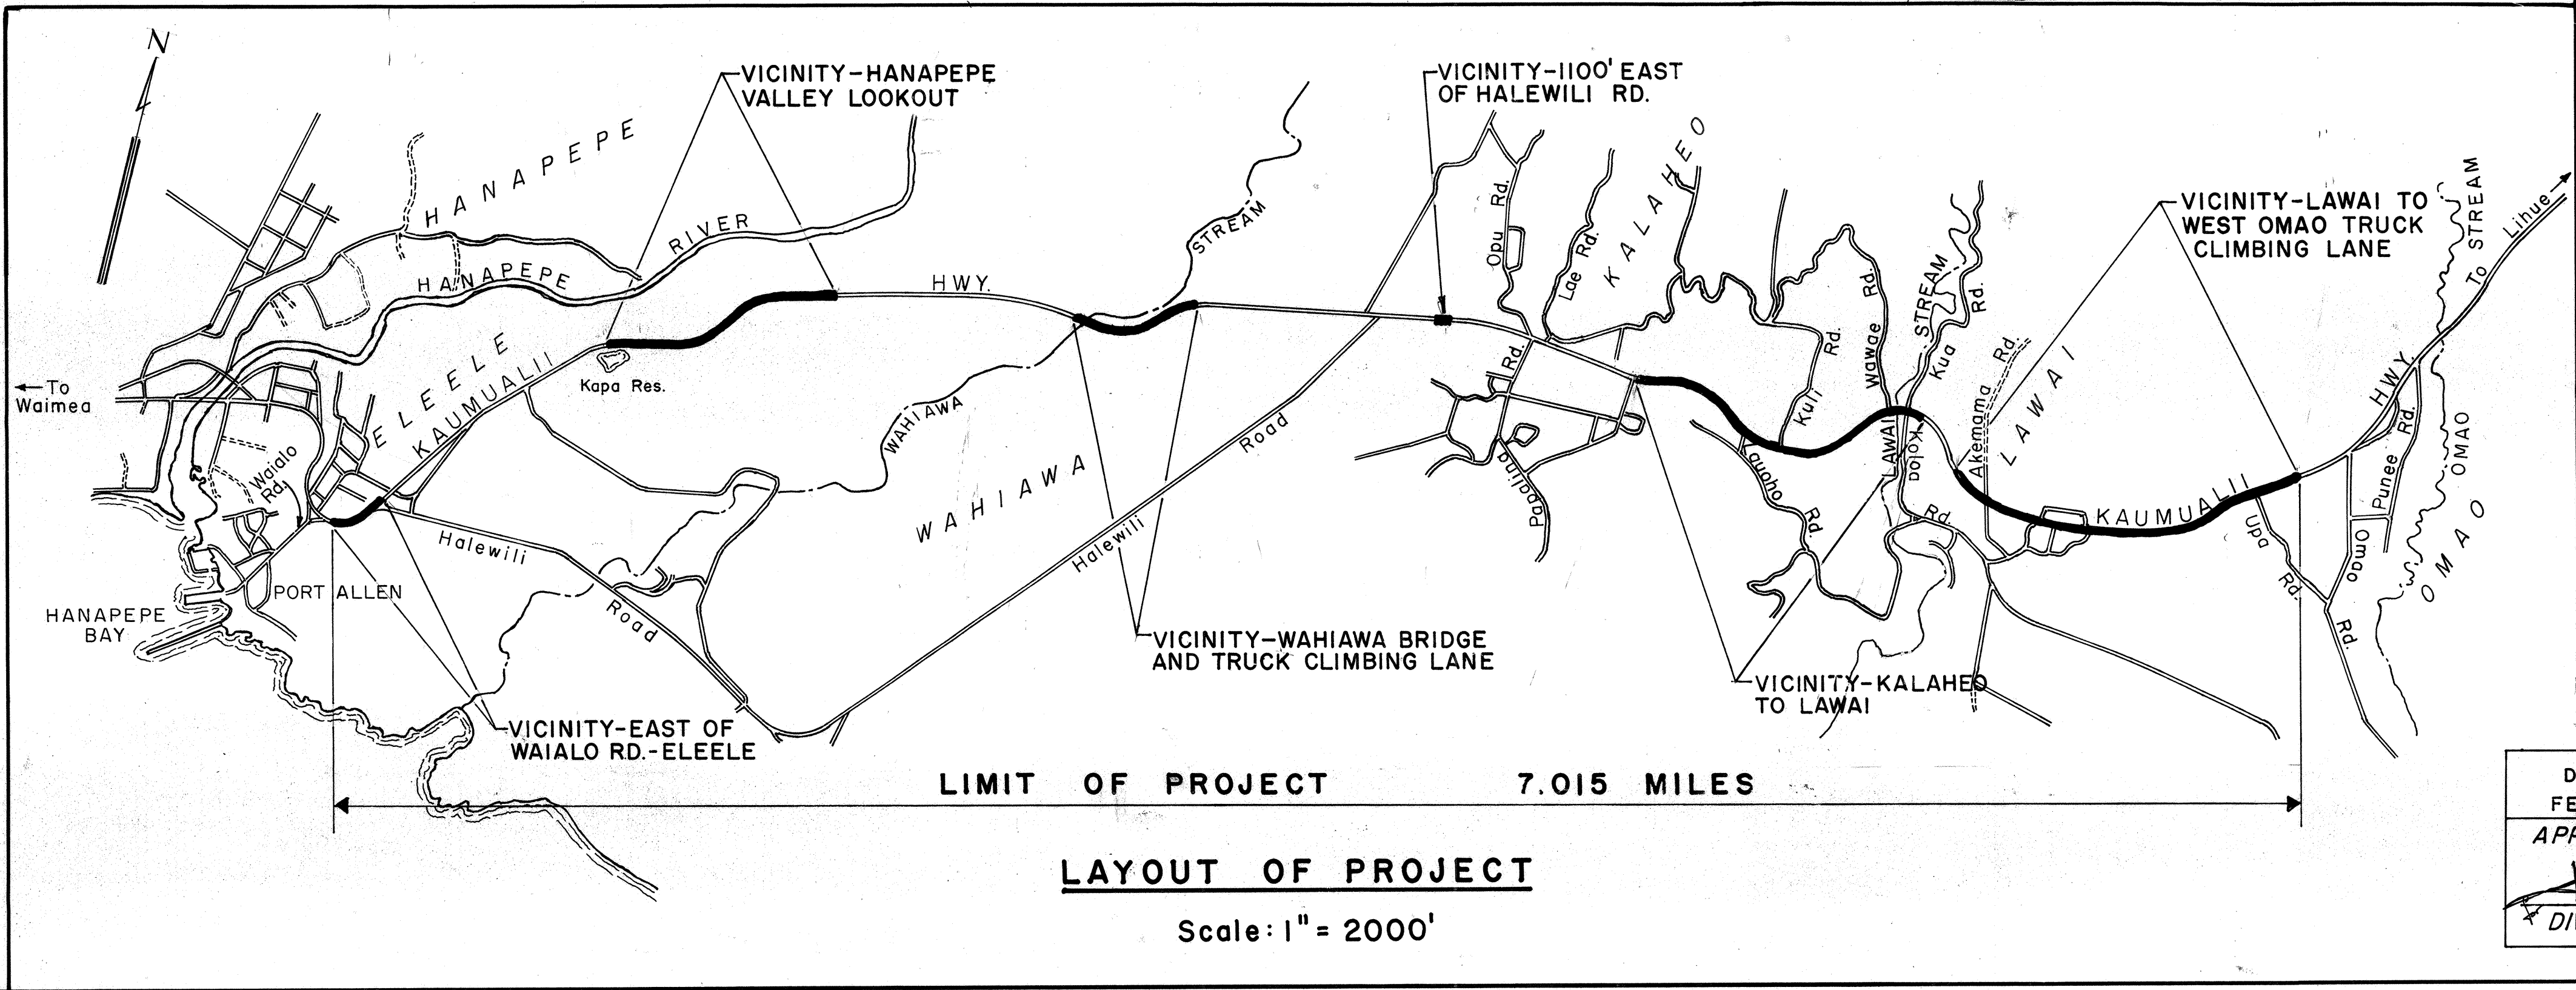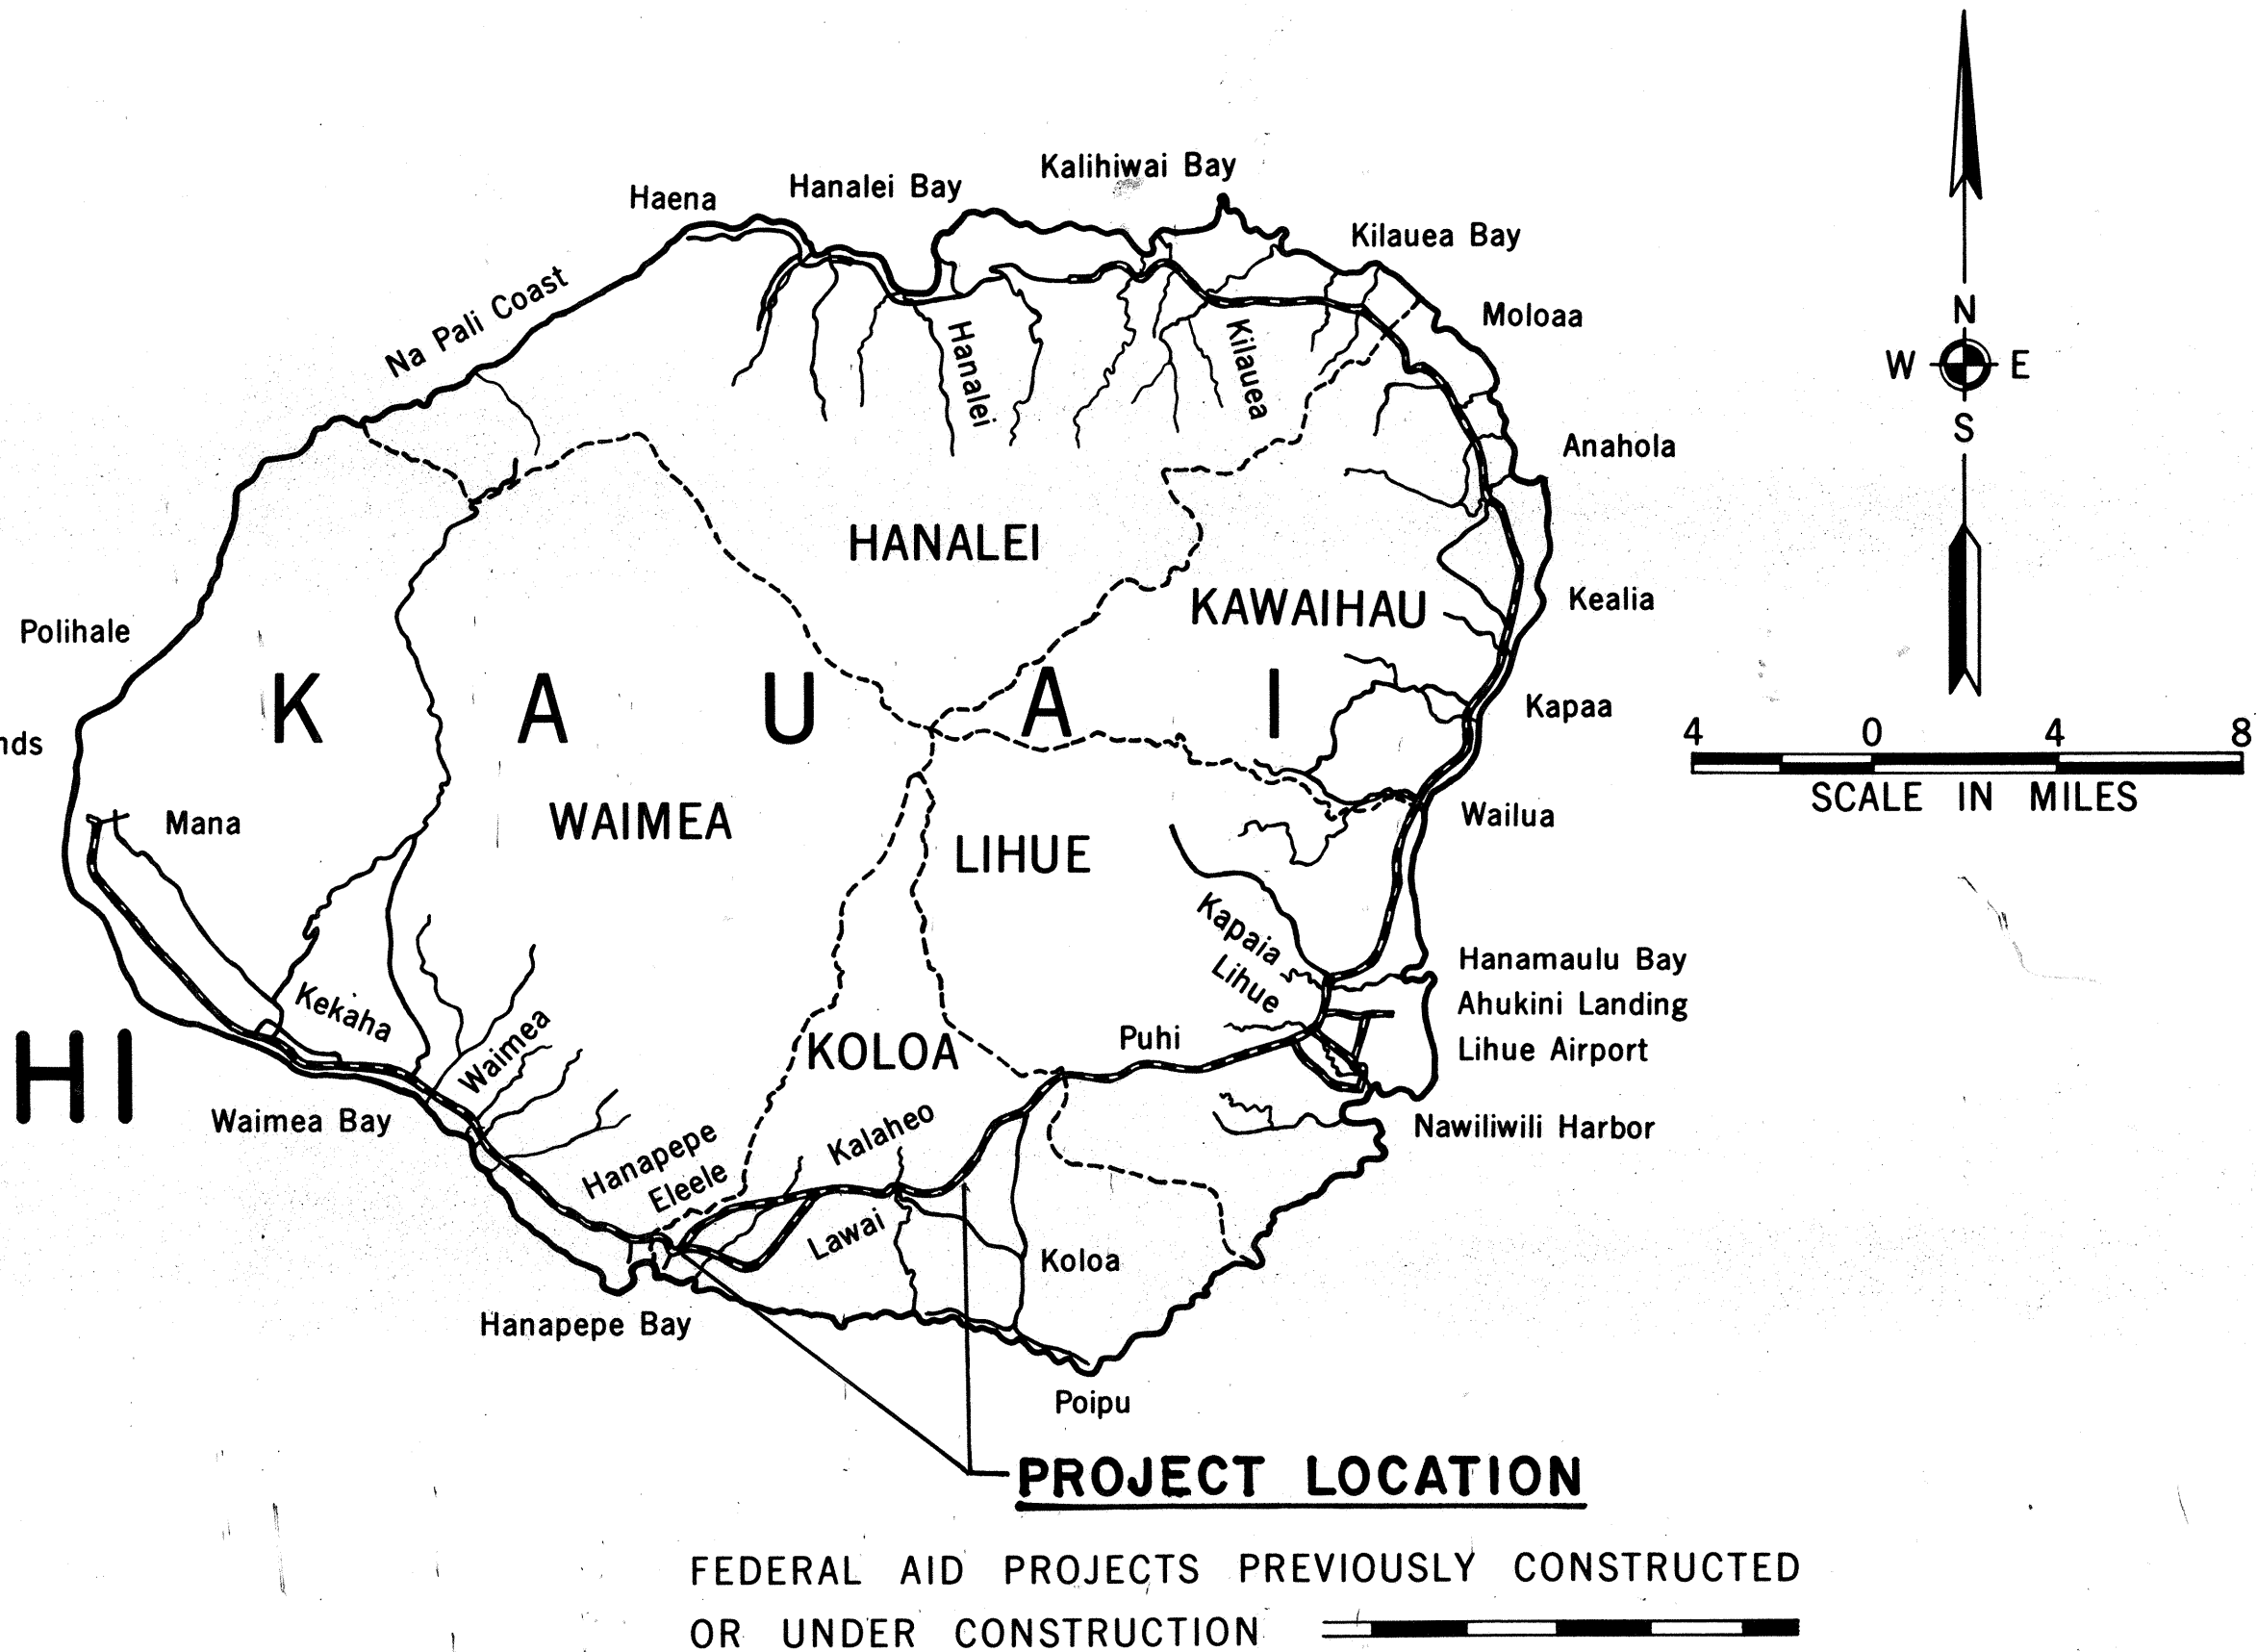

ALL CHANGES MADE DURING CONSTRUCTION HAVE BEEN NOTED IN RED ON THESE TRACINGS AND CHECKED BY

*[Signature]* **RESIDENT ENGINEER** **2-21-79** **DATE**

KAUAI DISTRICT

DESIGNED BY

A. NISHIMURA

548-7537

JULY, 1977

PHONE

DATE

DEPARTMENT OF TRANSPORTATION

FEDERAL HIGHWAY ADMINISTRATION

APPROVED:

*[Signature]*

DIVISION ADMINISTRATOR

8-25-77

DATE

DEPARTMENT OF TRANSPORTATION

STATE OF HAWAII

APPROVED:

*[Signature]*

8/25/77

DATE

DIR. OF TRANSPORTATION