


FED. ROAD DIST. NO.	STATE	FED. AID PROJ. NO.	FISCAL YEAR	SHEET NO.	TOTAL SHEETS
HAWAII	HAW.	ROS-050-1(3)	1979	3	19

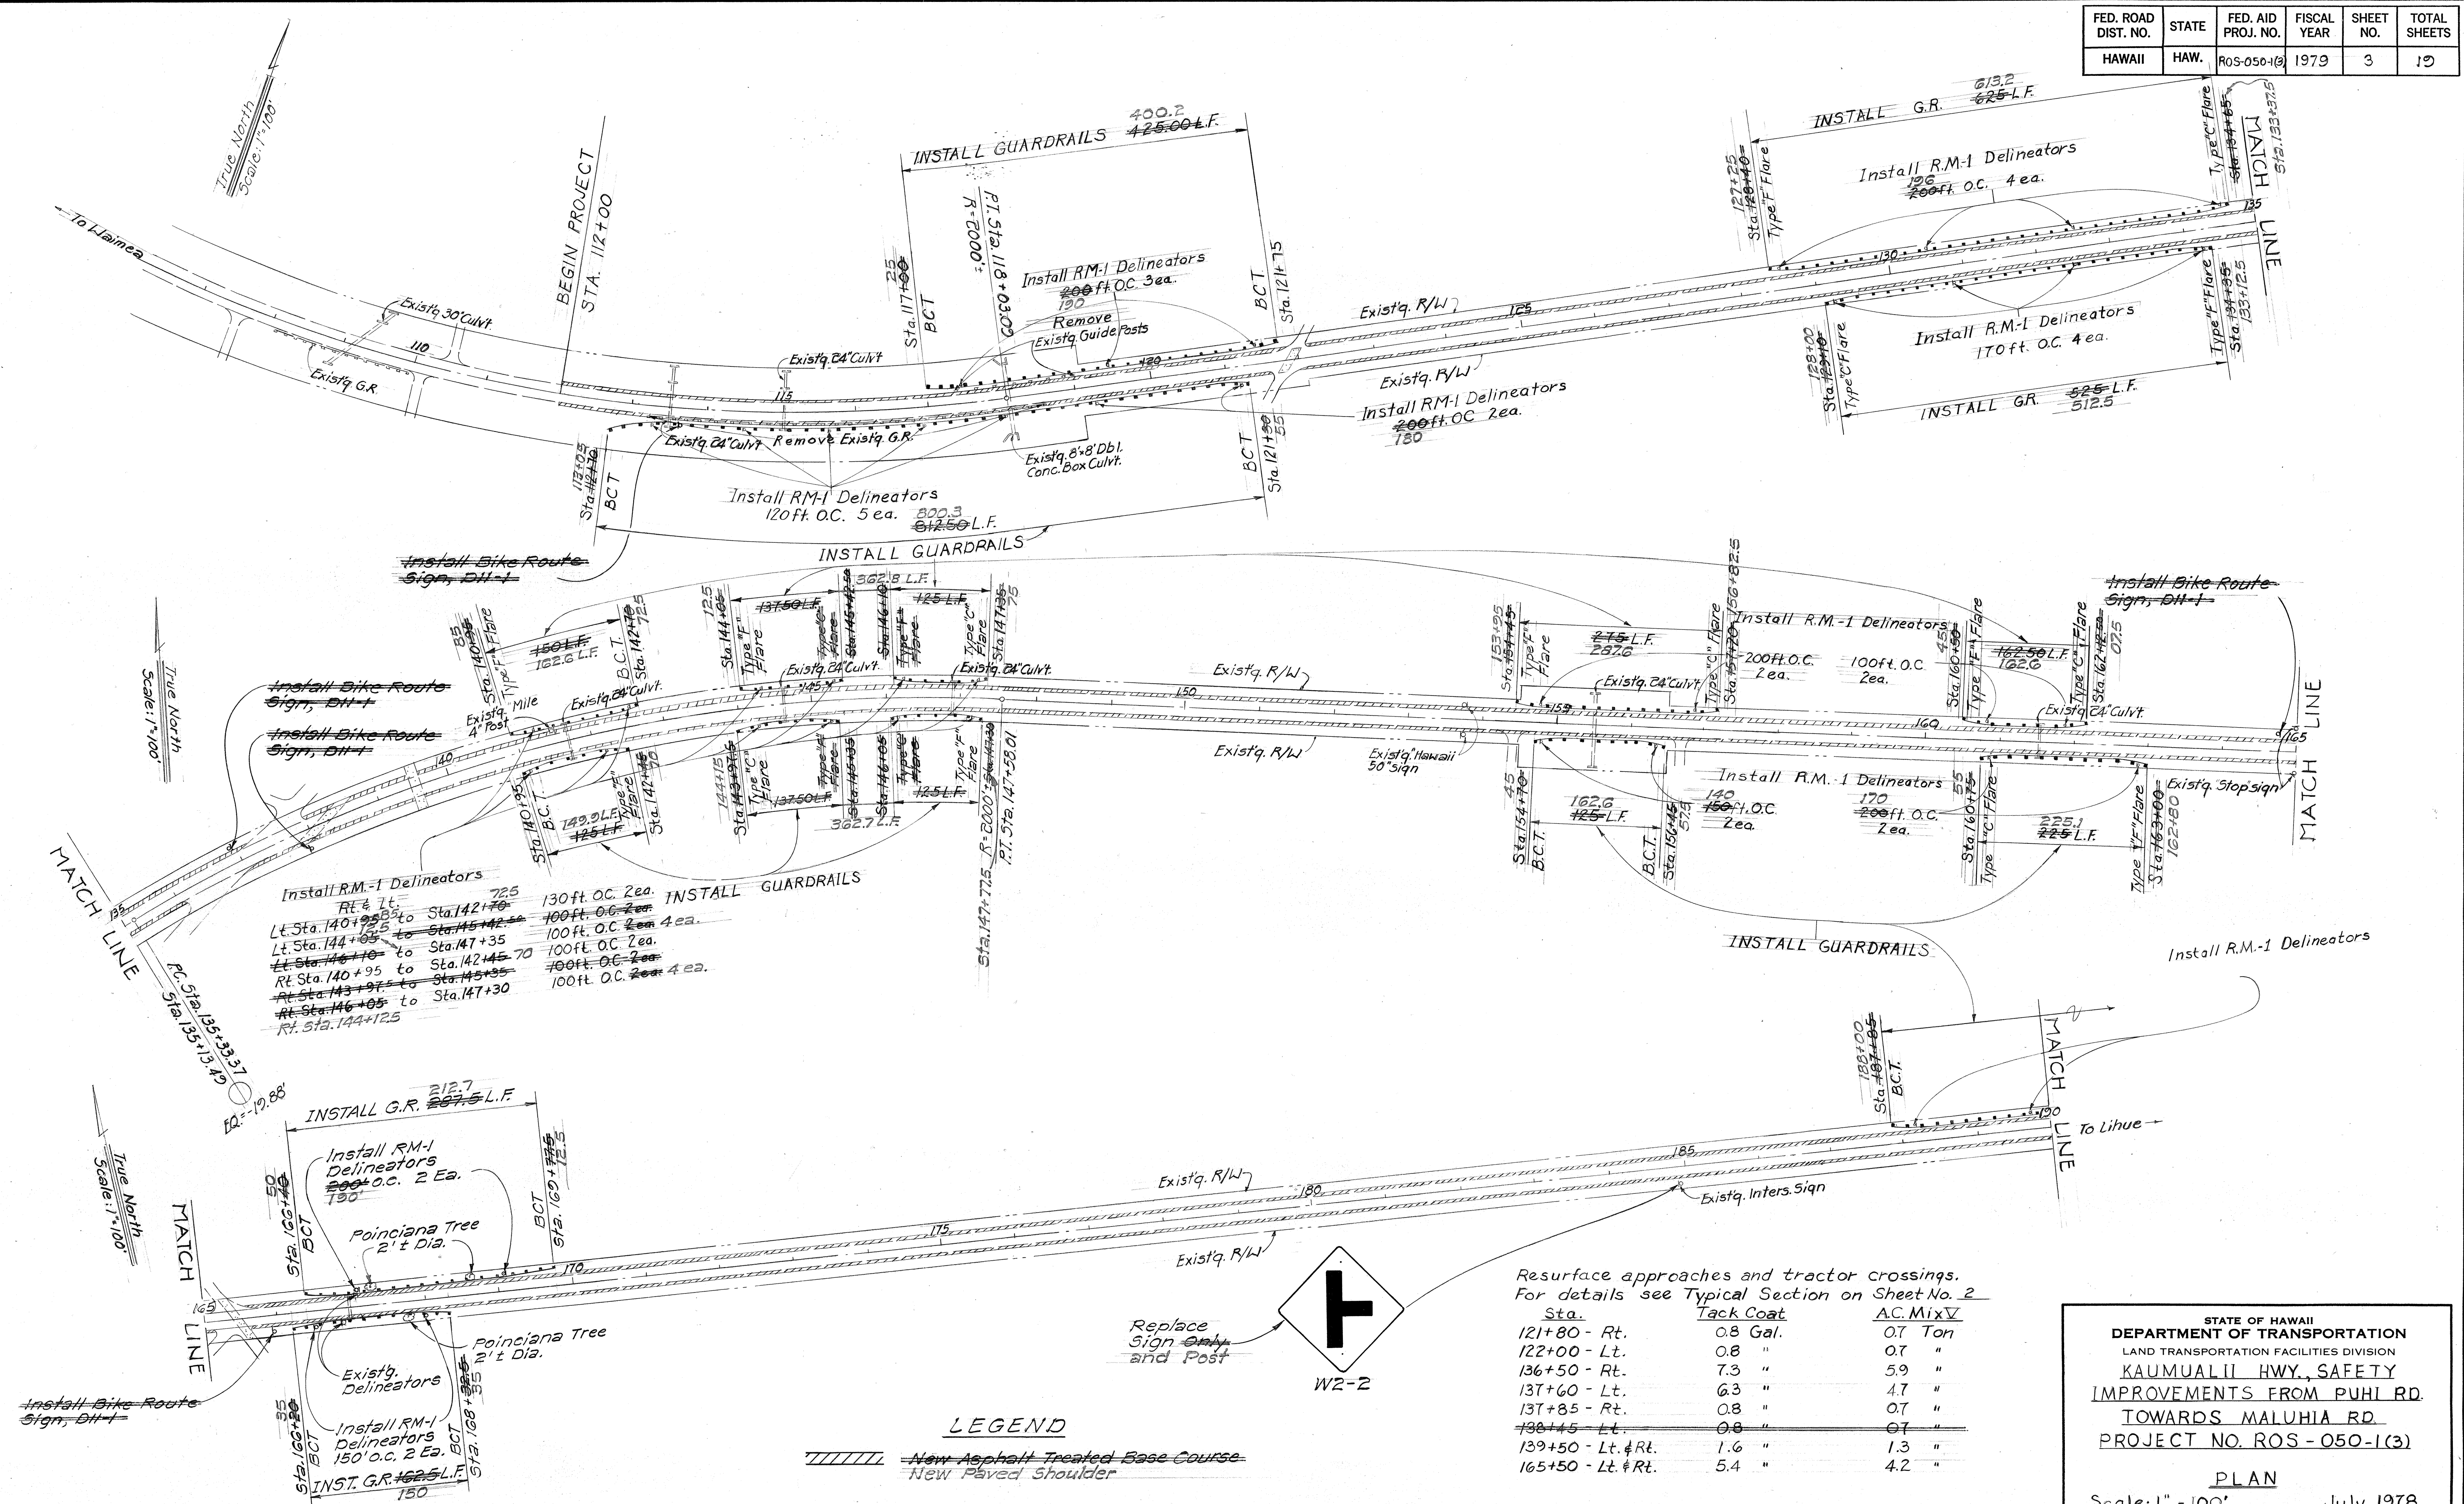

Resurface approaches and tractor crossings.
For details see Typical Section on Sheet No. 2

<u>Sta.</u>	<u>Tack Coat</u>	<u>A.C. Mix V</u>
121+80 - Rt.	0.8 Gal.	0.7 Ton
122+00 - Lt.	0.8 "	0.7 "
136+50 - Rt.	7.3 "	5.9 "
137+60 - Lt.	6.3 "	4.7 "
137+85 - Rt.	0.8 "	0.7 "
138+45 - Lt.	0.8 "	0.7 "
139+50 - Lt. & Rt.	1.6 "	1.3 "
165+50 - Lt. & Rt.	5.4 "	4.2 "

STATE OF HAWAII
DEPARTMENT OF TRANSPORTATION
LAND TRANSPORTATION FACILITIES DIVISION
KAUMUALII HWY., SAFETY
IMPROVEMENTS FROM PUHI RD.
TOWARDS MALUHIA RD.
PROJECT NO. ROS - 050-(3)


PLAN

Scale: 1" = 100' July, 1978

SHEET No. / OF 2 SHEETS

FED. ROAD DIST. NO.	STATE	FED. AID PROJ. NO.	FISCAL YEAR	SHEET NO.	TOTAL SHEETS
HAWAII	HAW.	ROS-050-1(3)	1979	4	10

ORIGINAL PLAN	DATE
SURVEY PLOTTED BY	
DRAWN BY	
DESIGNED BY	
QUANTITIES BY	
CHECKED BY	
NO.	

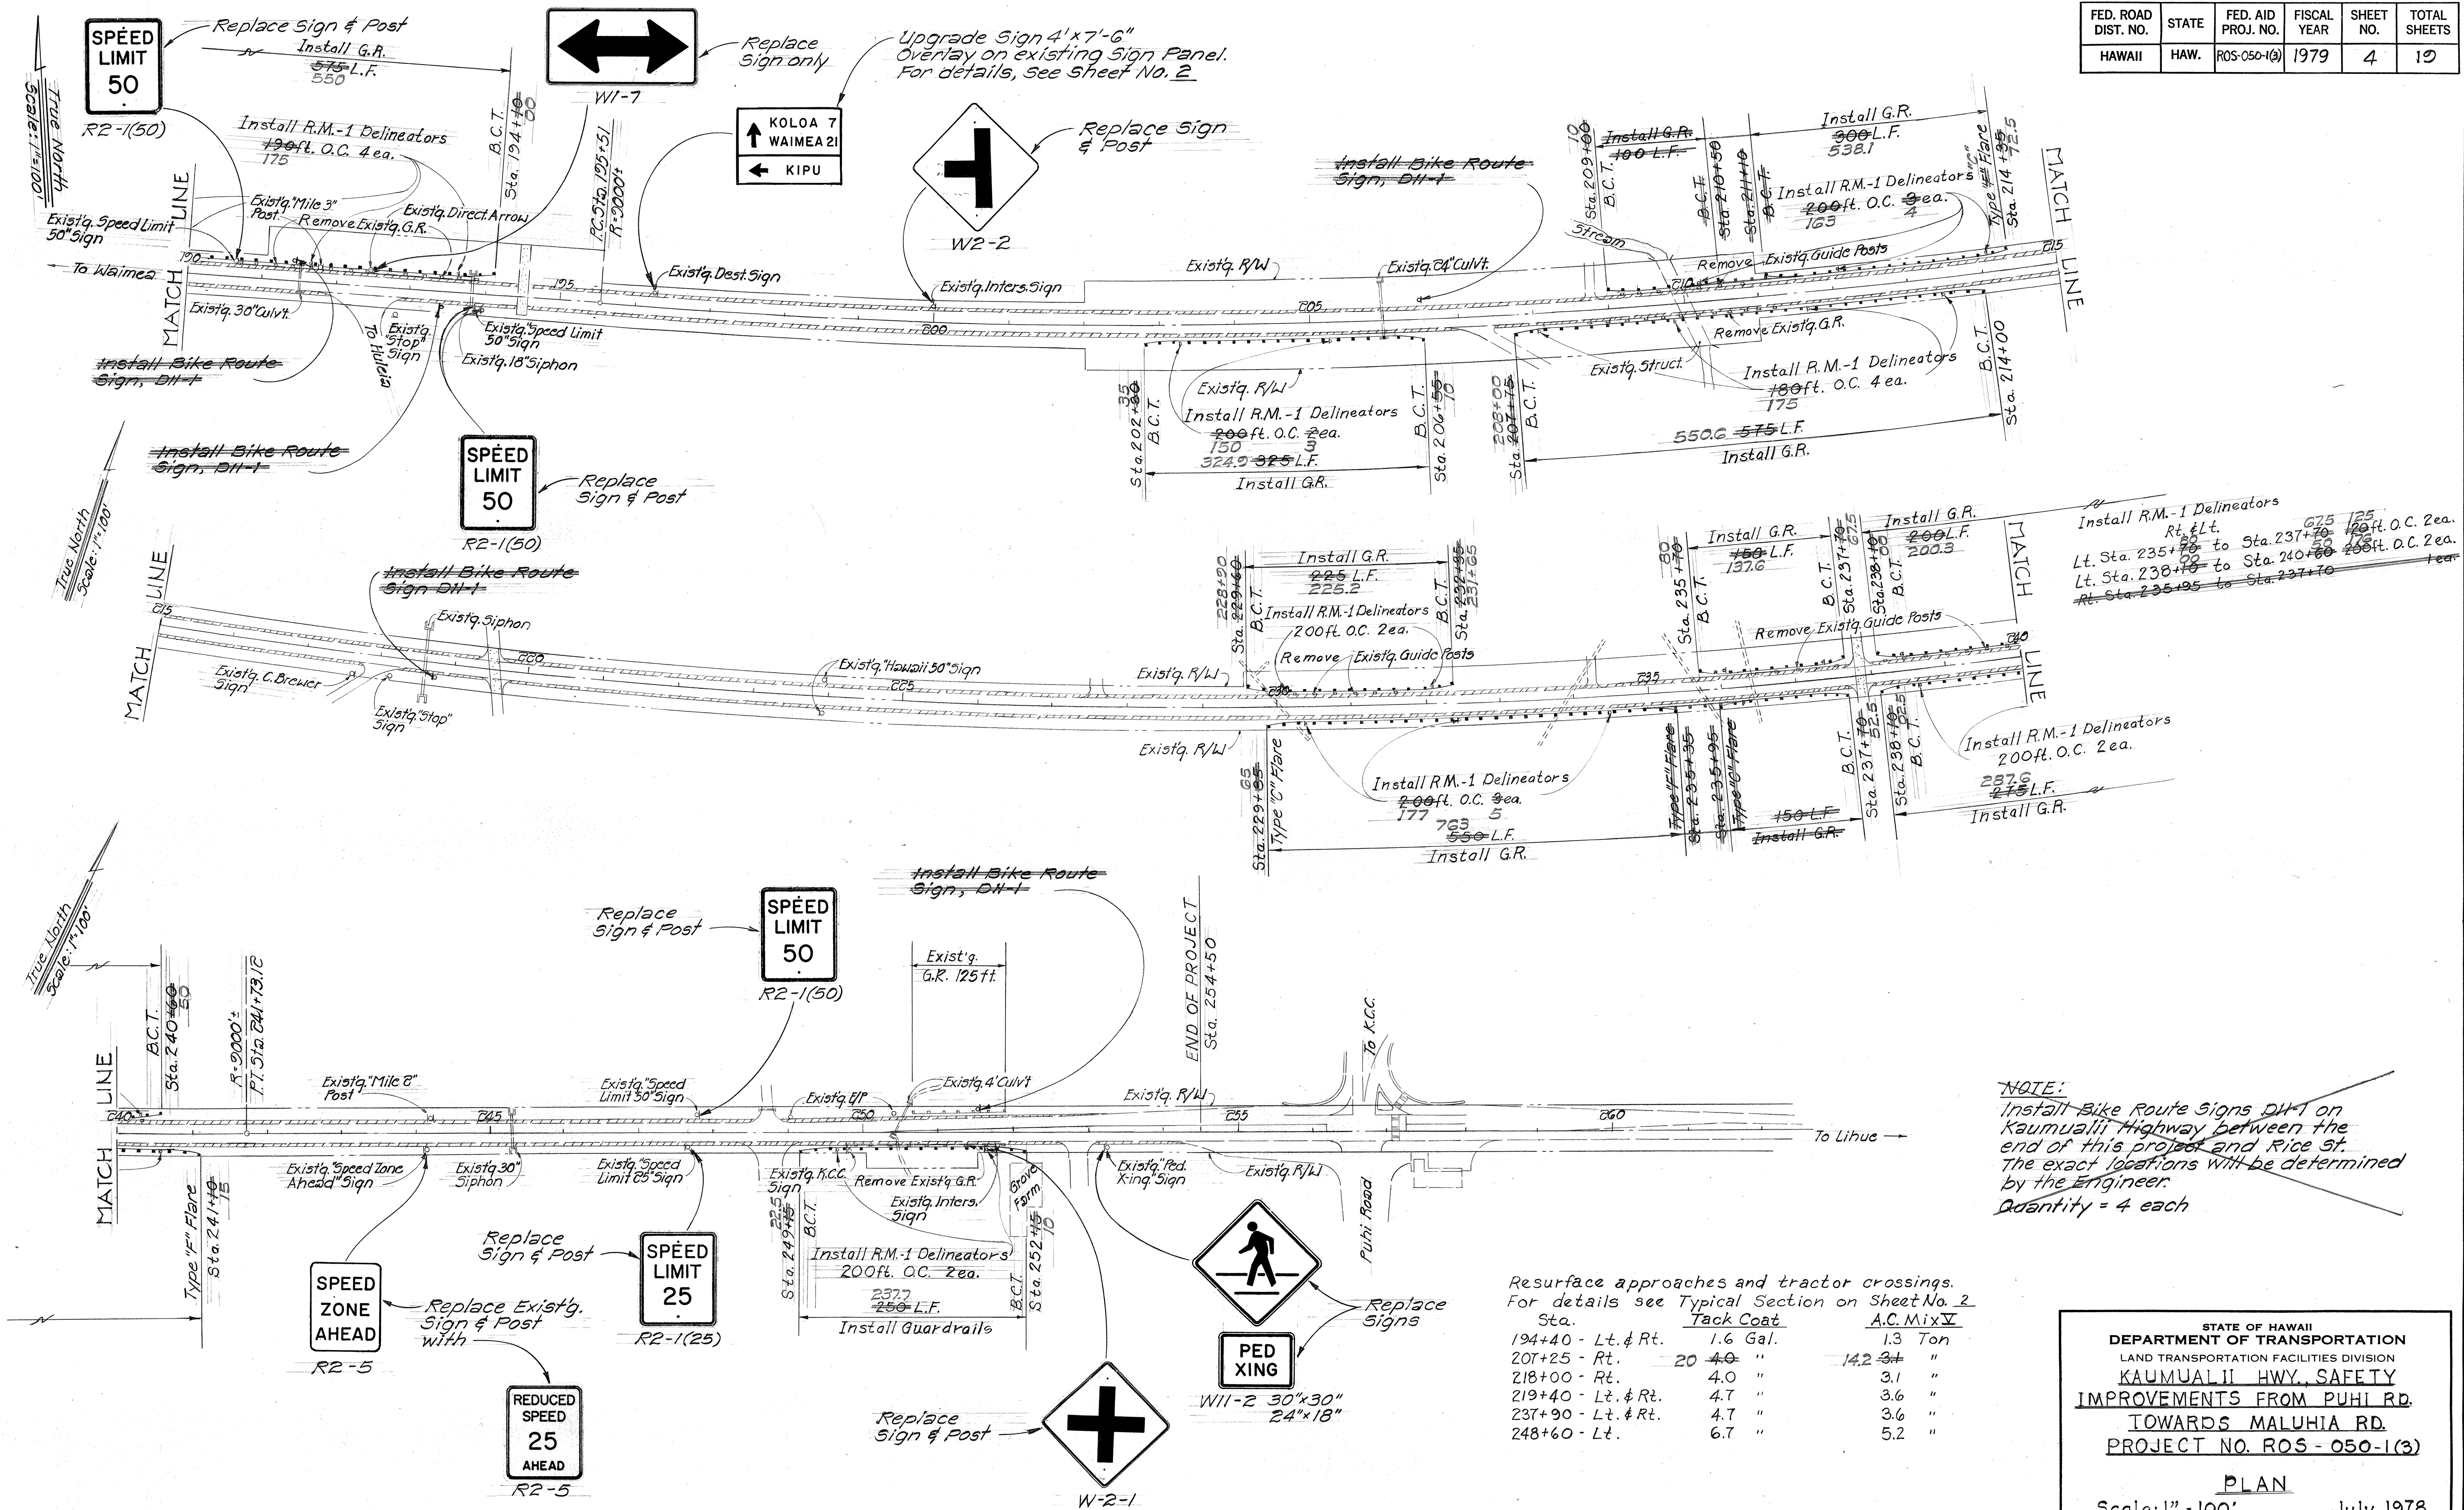

STATE OF HAWAII DEPARTMENT OF TRANSPORTATION LAND TRANSPORTATION FACILITIES DIVISION KAUMUALII HWY. SAFETY IMPROVEMENTS FROM PUHI RD. TOWARDS MALUHIA RD. PROJECT NO. ROS-050-1(3)		
PLAN		
Scale: 1" = 100'	July, 1978	
SHEET NO. 2 OF 2 SHEETS		