INDEX TO DRAWINGS	
	TITLE SHEET
2	PLAN & DETAILS
3	STANDARD DETAILS
1	

7/30/8I DATE

548-75 PHONE



STATE OF HAWAII

DEPARTMENT OF TRANSPORTATION

HIGHWAYS DIVISION


HONOLULU, HAWAII

"AS BUILT"

PLANS FOR


KAUMUALII HIGHWAY
REPAIRS TO HULEIA BRIDGE
PROJECT NO. 50D-01-82M

DISTRICT OF LIHUE ISLAND OF KAUAI

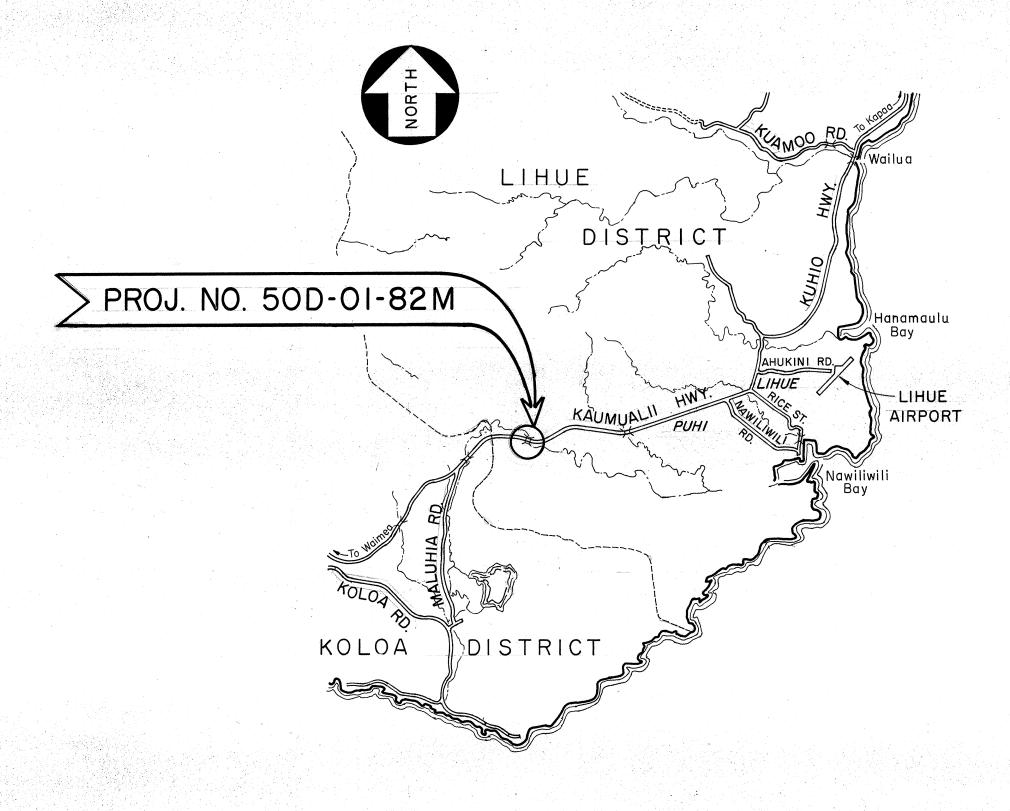

LAYOUT OF PROJECT

SCALE: I" = 2 MILES

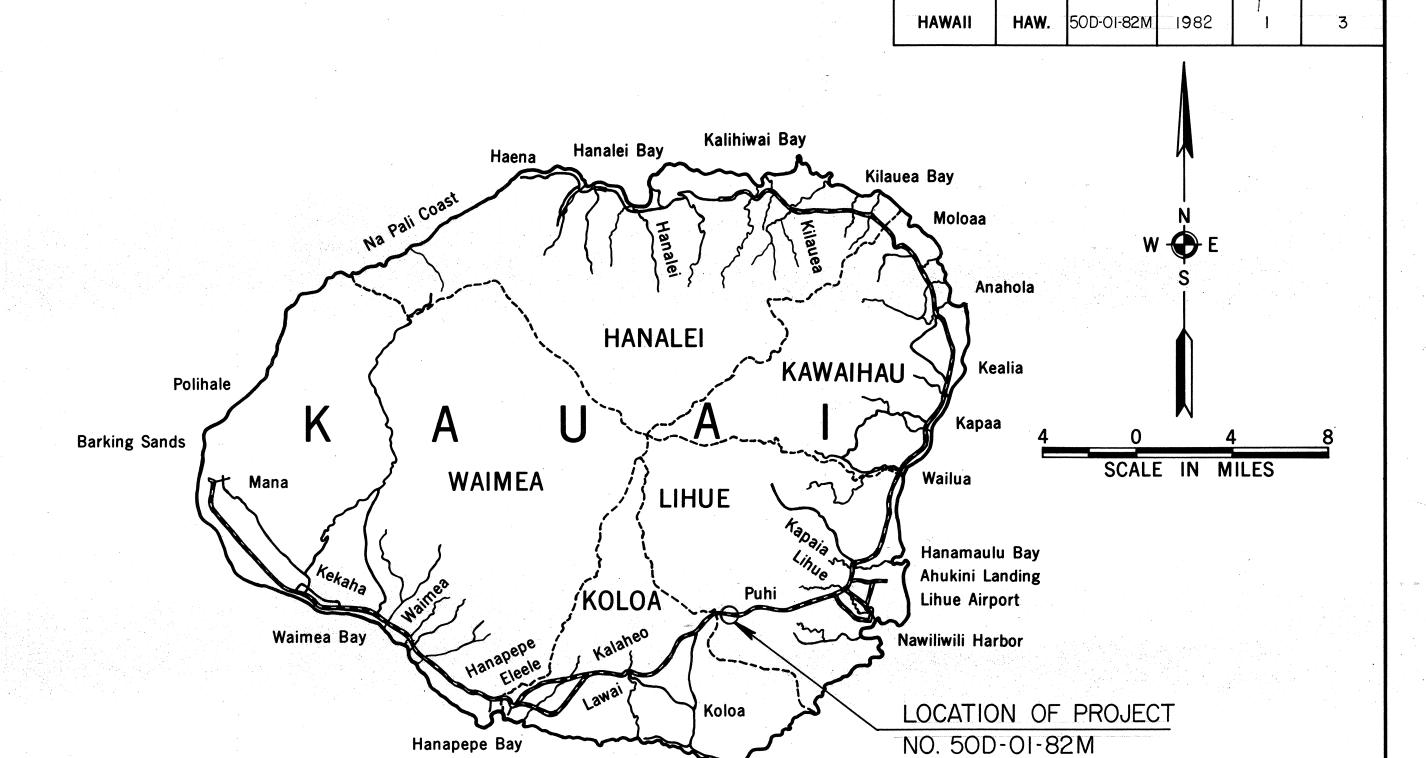

FEDERAL AID PROJECTS PREVIOUSLY CONSTRUCTED
OR UNDER CONSTRUCTION

NO CHANGES WERE MADE DURING CONSTRUCTION ON THESE PLANS EXCEPT CHANGES IN THE CRIGINAL THEORETICAL QUANTITIES. FOR ACTUAL QUANTITIES, REFER TO PROJECT LEDGER AND/OR COMPUTATION BOOK.

Donald Magamine RESIDENT ENGINEER 9 22 82 DATE

STATE PROJ. NO. FISCAL SHEET TOTAL YEAR NO. SHEETS

DEPARTMENT OF TRANSPORTATION STATE OF HAWAII
APPROVED:

James R. Carras FADIR. OF TRANSPORTATION