	INDEX TO DRAWINGS				
SHEET NO.	DESCRIPTION				
1	TITLE SHEET				
2	PLAN AND PROFILE				
3	DRAINAGE DETAILS				
4 - 5	STANDARD DETAILS				
	•				

DLNR DESIGNED BY



STATE OF HAWAII




DEPARTMENT OF TRANSPORTATION
HIGHWAYS DIVISION
"AS - BUILT"
PLANS FOR

## KAUMUALII HIGHWAY

SAFETY AND DRAINAGE IMPROVEMENTS
BETWEEN MOI ROAD AND HANAPEPE ROAD

FEDERAL AID PROJECT NO. DP-050-1(5)

DISTRICT OF WAIMEA ISLAND OF KAUAI

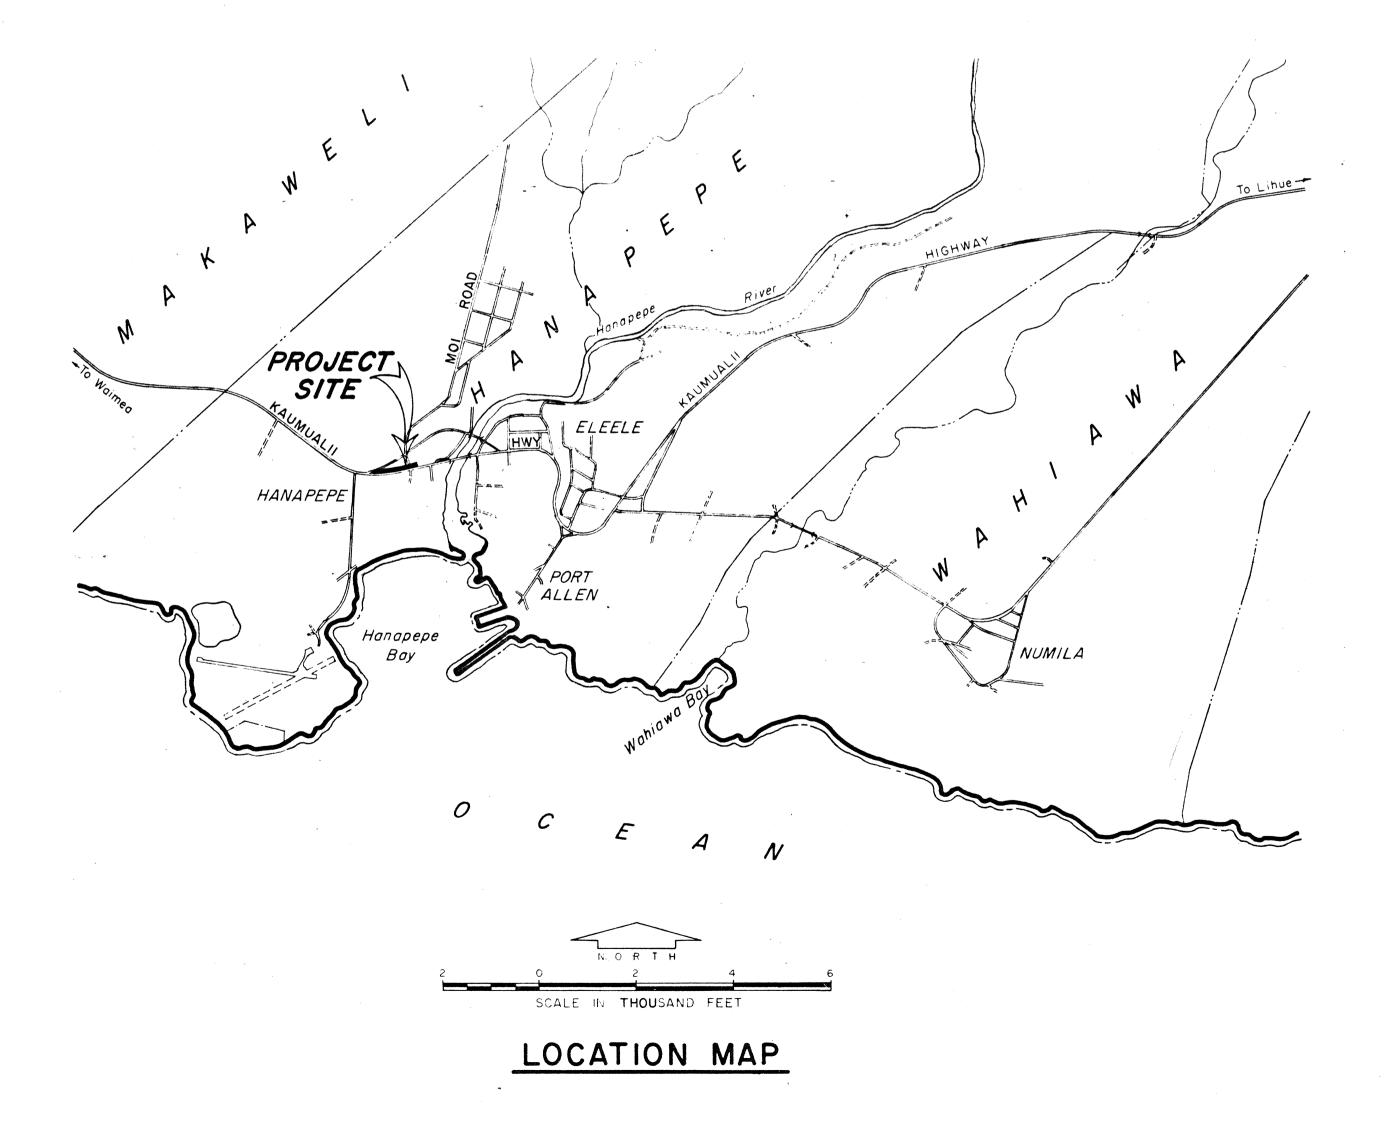


FED. ROAD DIST. NO. STATE FED. AID PROJ. NO. FISCAL SHEET NO. SHEETS

HAWAII HAW. DP-050-I(5) 1982 I 5



, 0.					П
NIHAU KA	UAI	OAHU			
		2	MOLOKAI		
		LANAI		MAUI	
				5	
STAT	E OF H	AWAII 	HAWAII	) }	
	(N)				

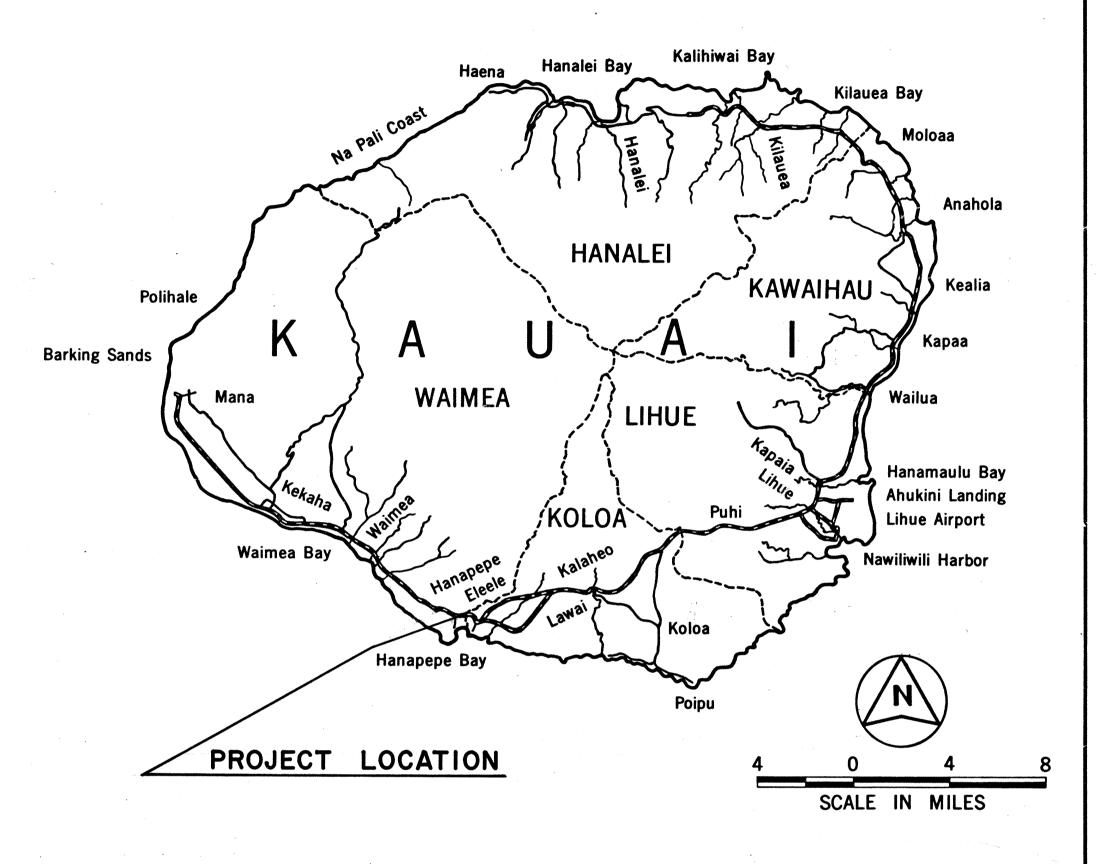

FEDERAL AID PROJECTS PREVIOUSLY CONSTRUCTED OR UNDER CONSTRUCTION

ALL CHANGES MADE DURING CONSTRUCTION HAVE BEEN INCORPORATED ON THESE PLANS IN RED EXCEPT CHANGES IN THE ORIGINAL THEORETICAL QUANTITIES. FOR ACTUAL QUANTITIES, REFER TO PROJECT LEDGER AND/OR COMPUTATION BOOK.

RESIDENT ENGINEER

2-24-83 DATE

DEPARTMENT OF TRANSPORTATION
FEDERAL HIGHWAY ADMINISTRATION

APPROVED:

5/13/82

DIVISION ADMINISTRATOR DATE

DEPARTMENT OF TRANSPORTATION
STATE OF HAWAII

APPROVED:

DIR. OF TRANSPORTATION

DATE