


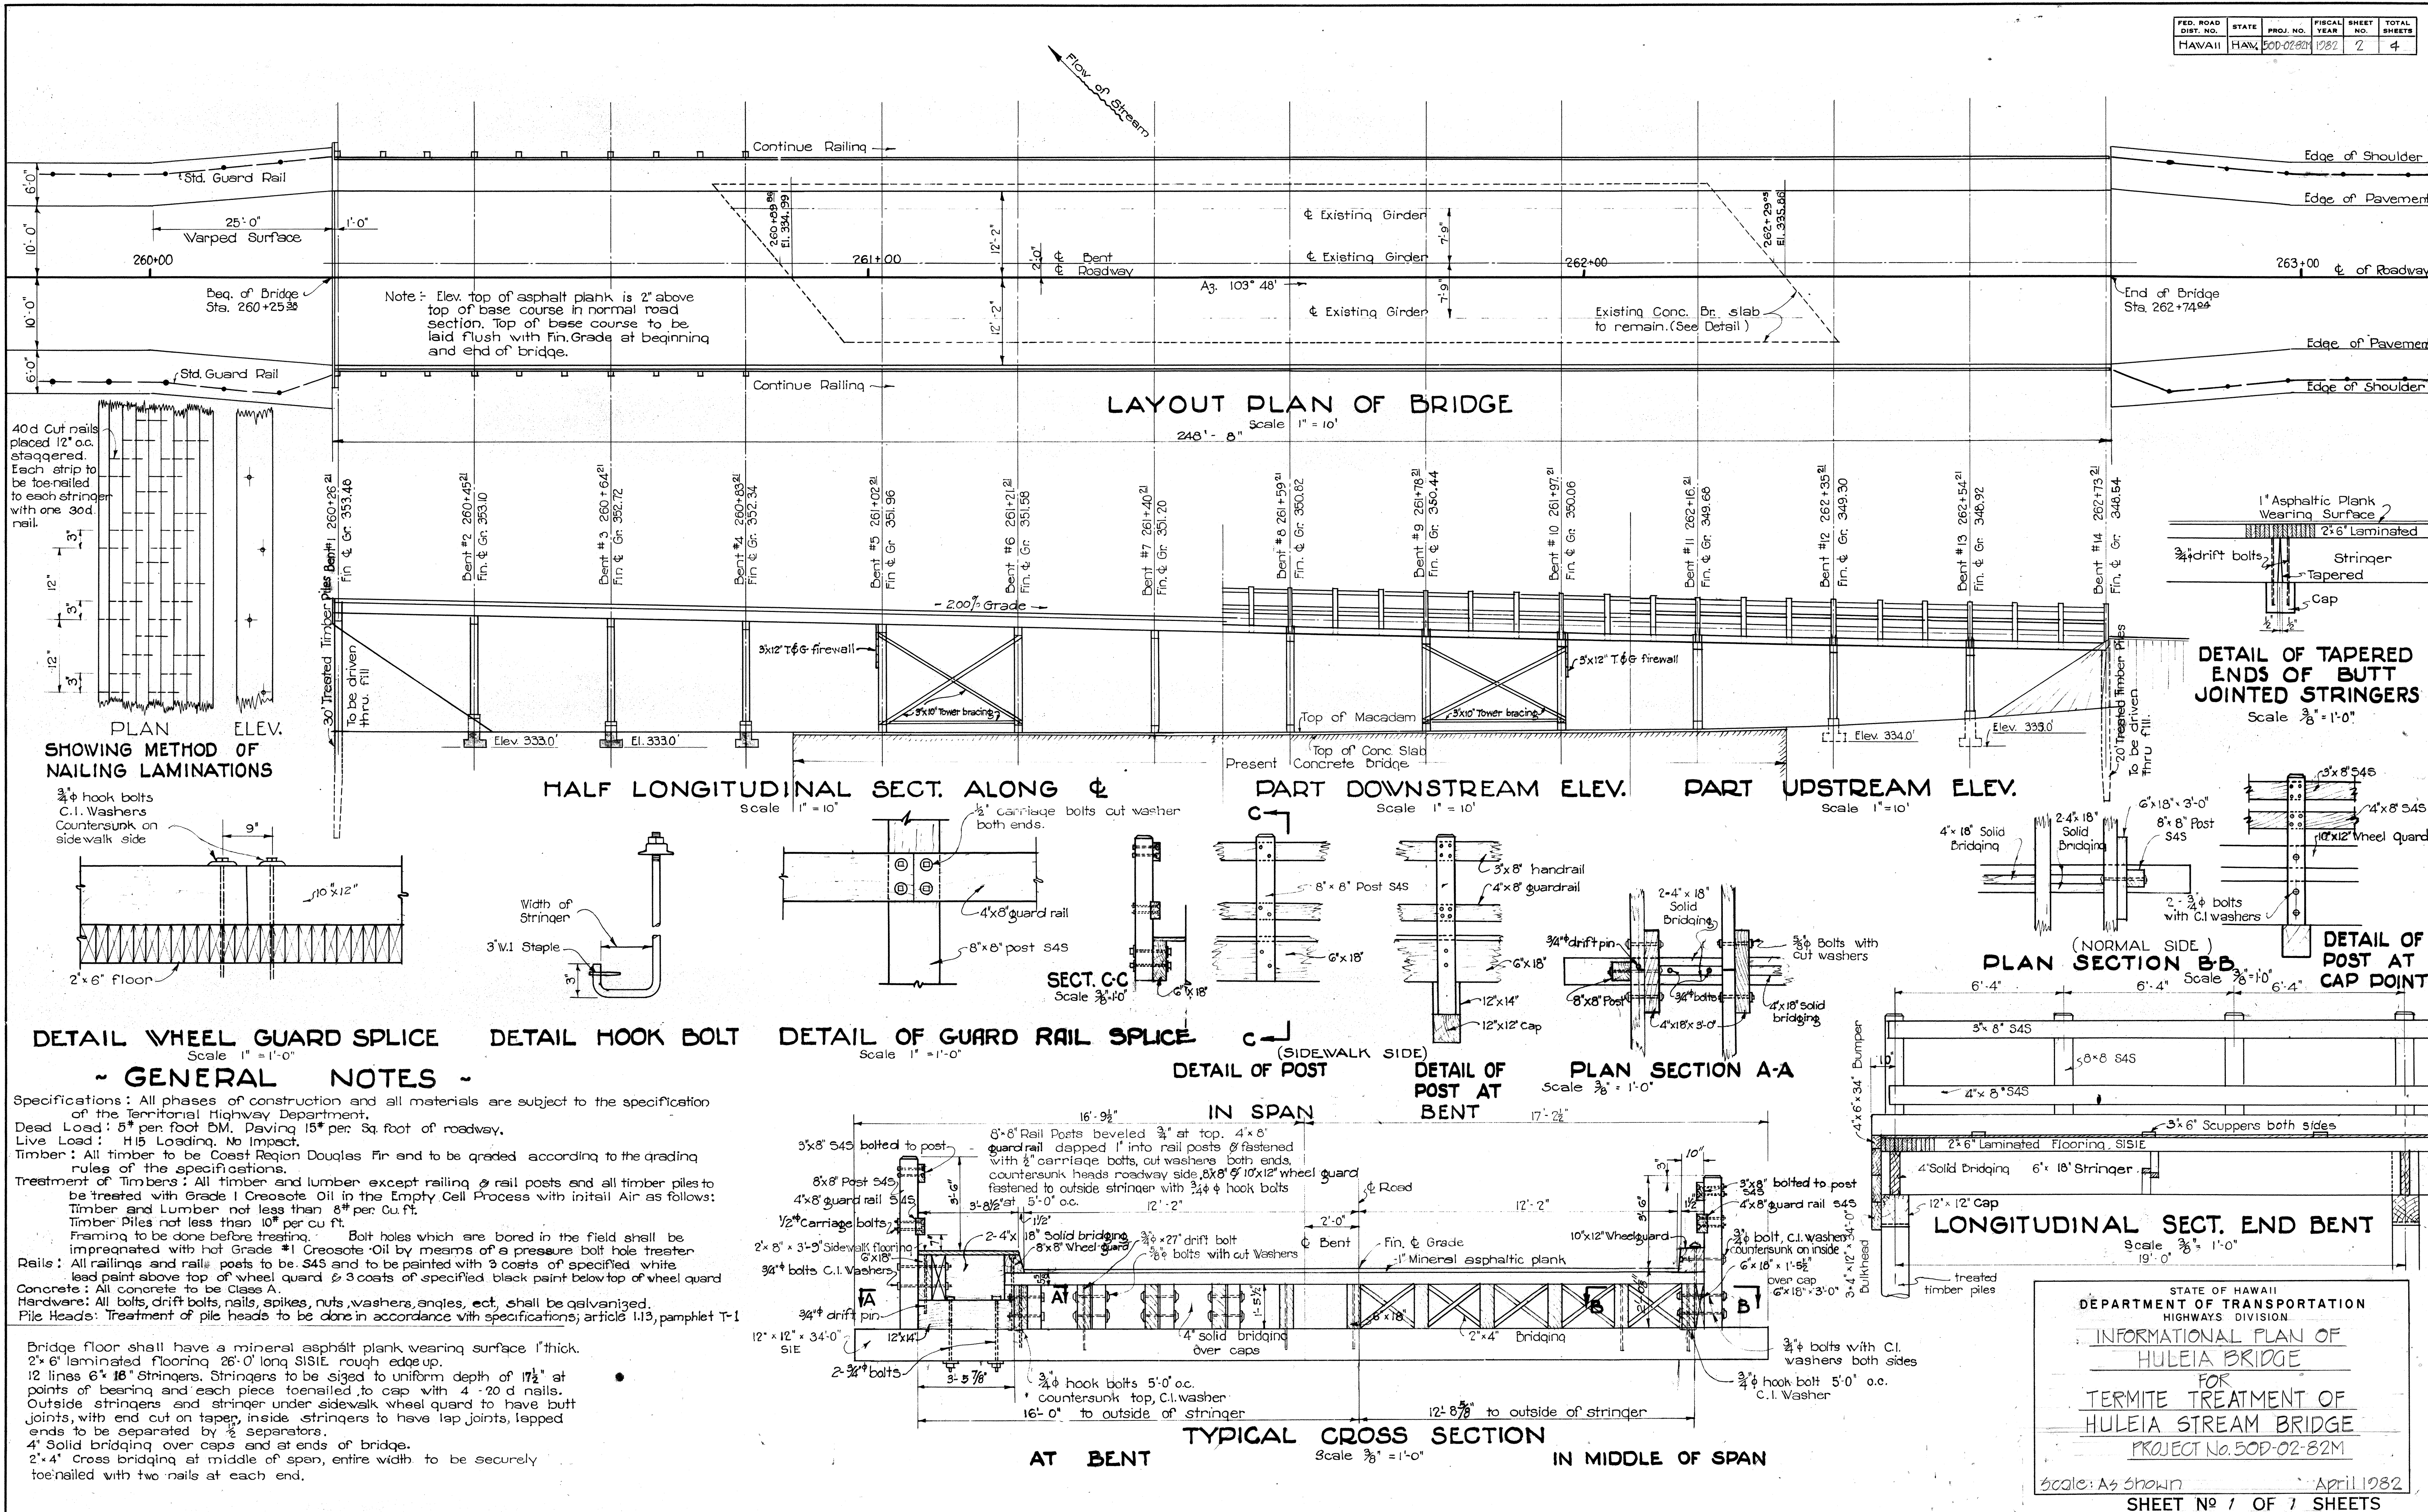

STATE OF HAWAII
DEPARTMENT OF TRANSPORTATION
HIGHWAYS DIVISION

INFORMATIONAL PLAN OF
HULEIA BRIDGE
FOR
TERMITE TREATMENT OF
HULEIA STREAM BRIDGE
PROJECT No. 50D-02-82M

Scale: As shown April 1982
SHEET No 1 OF 1 SHEETS