
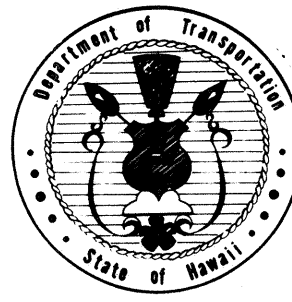


INDEX TO DRAWINGS	
SHEET NO.	DESCRIPTION
1	TITLE SHEET
2	INFORMATIONAL DETAILS
3 - 4	STANDARD DETAILS

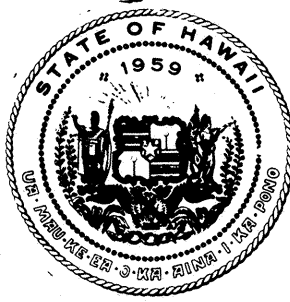

STATE OF HAWAII

DEPARTMENT OF TRANSPORTATION

HIGHWAYS DIVISION

HONOLULU, HAWAII

"AS-BUILT"

PLANS FOR

KAUMUALII HIGHWAY


TERMITE TREATMENT OF HULEIA STREAM BRIDGE

PROJECT NO. 50D-02-82M

DISTRICT OF LIHUE

ISLAND OF KAUAI

FED. ROAD DIST. NO.	STATE	PROJ. NO.	FISCAL YEAR	SHEET NO.	TOTAL SHEETS
HAWAII	HAW.	50D-02-82M	1982	1	4

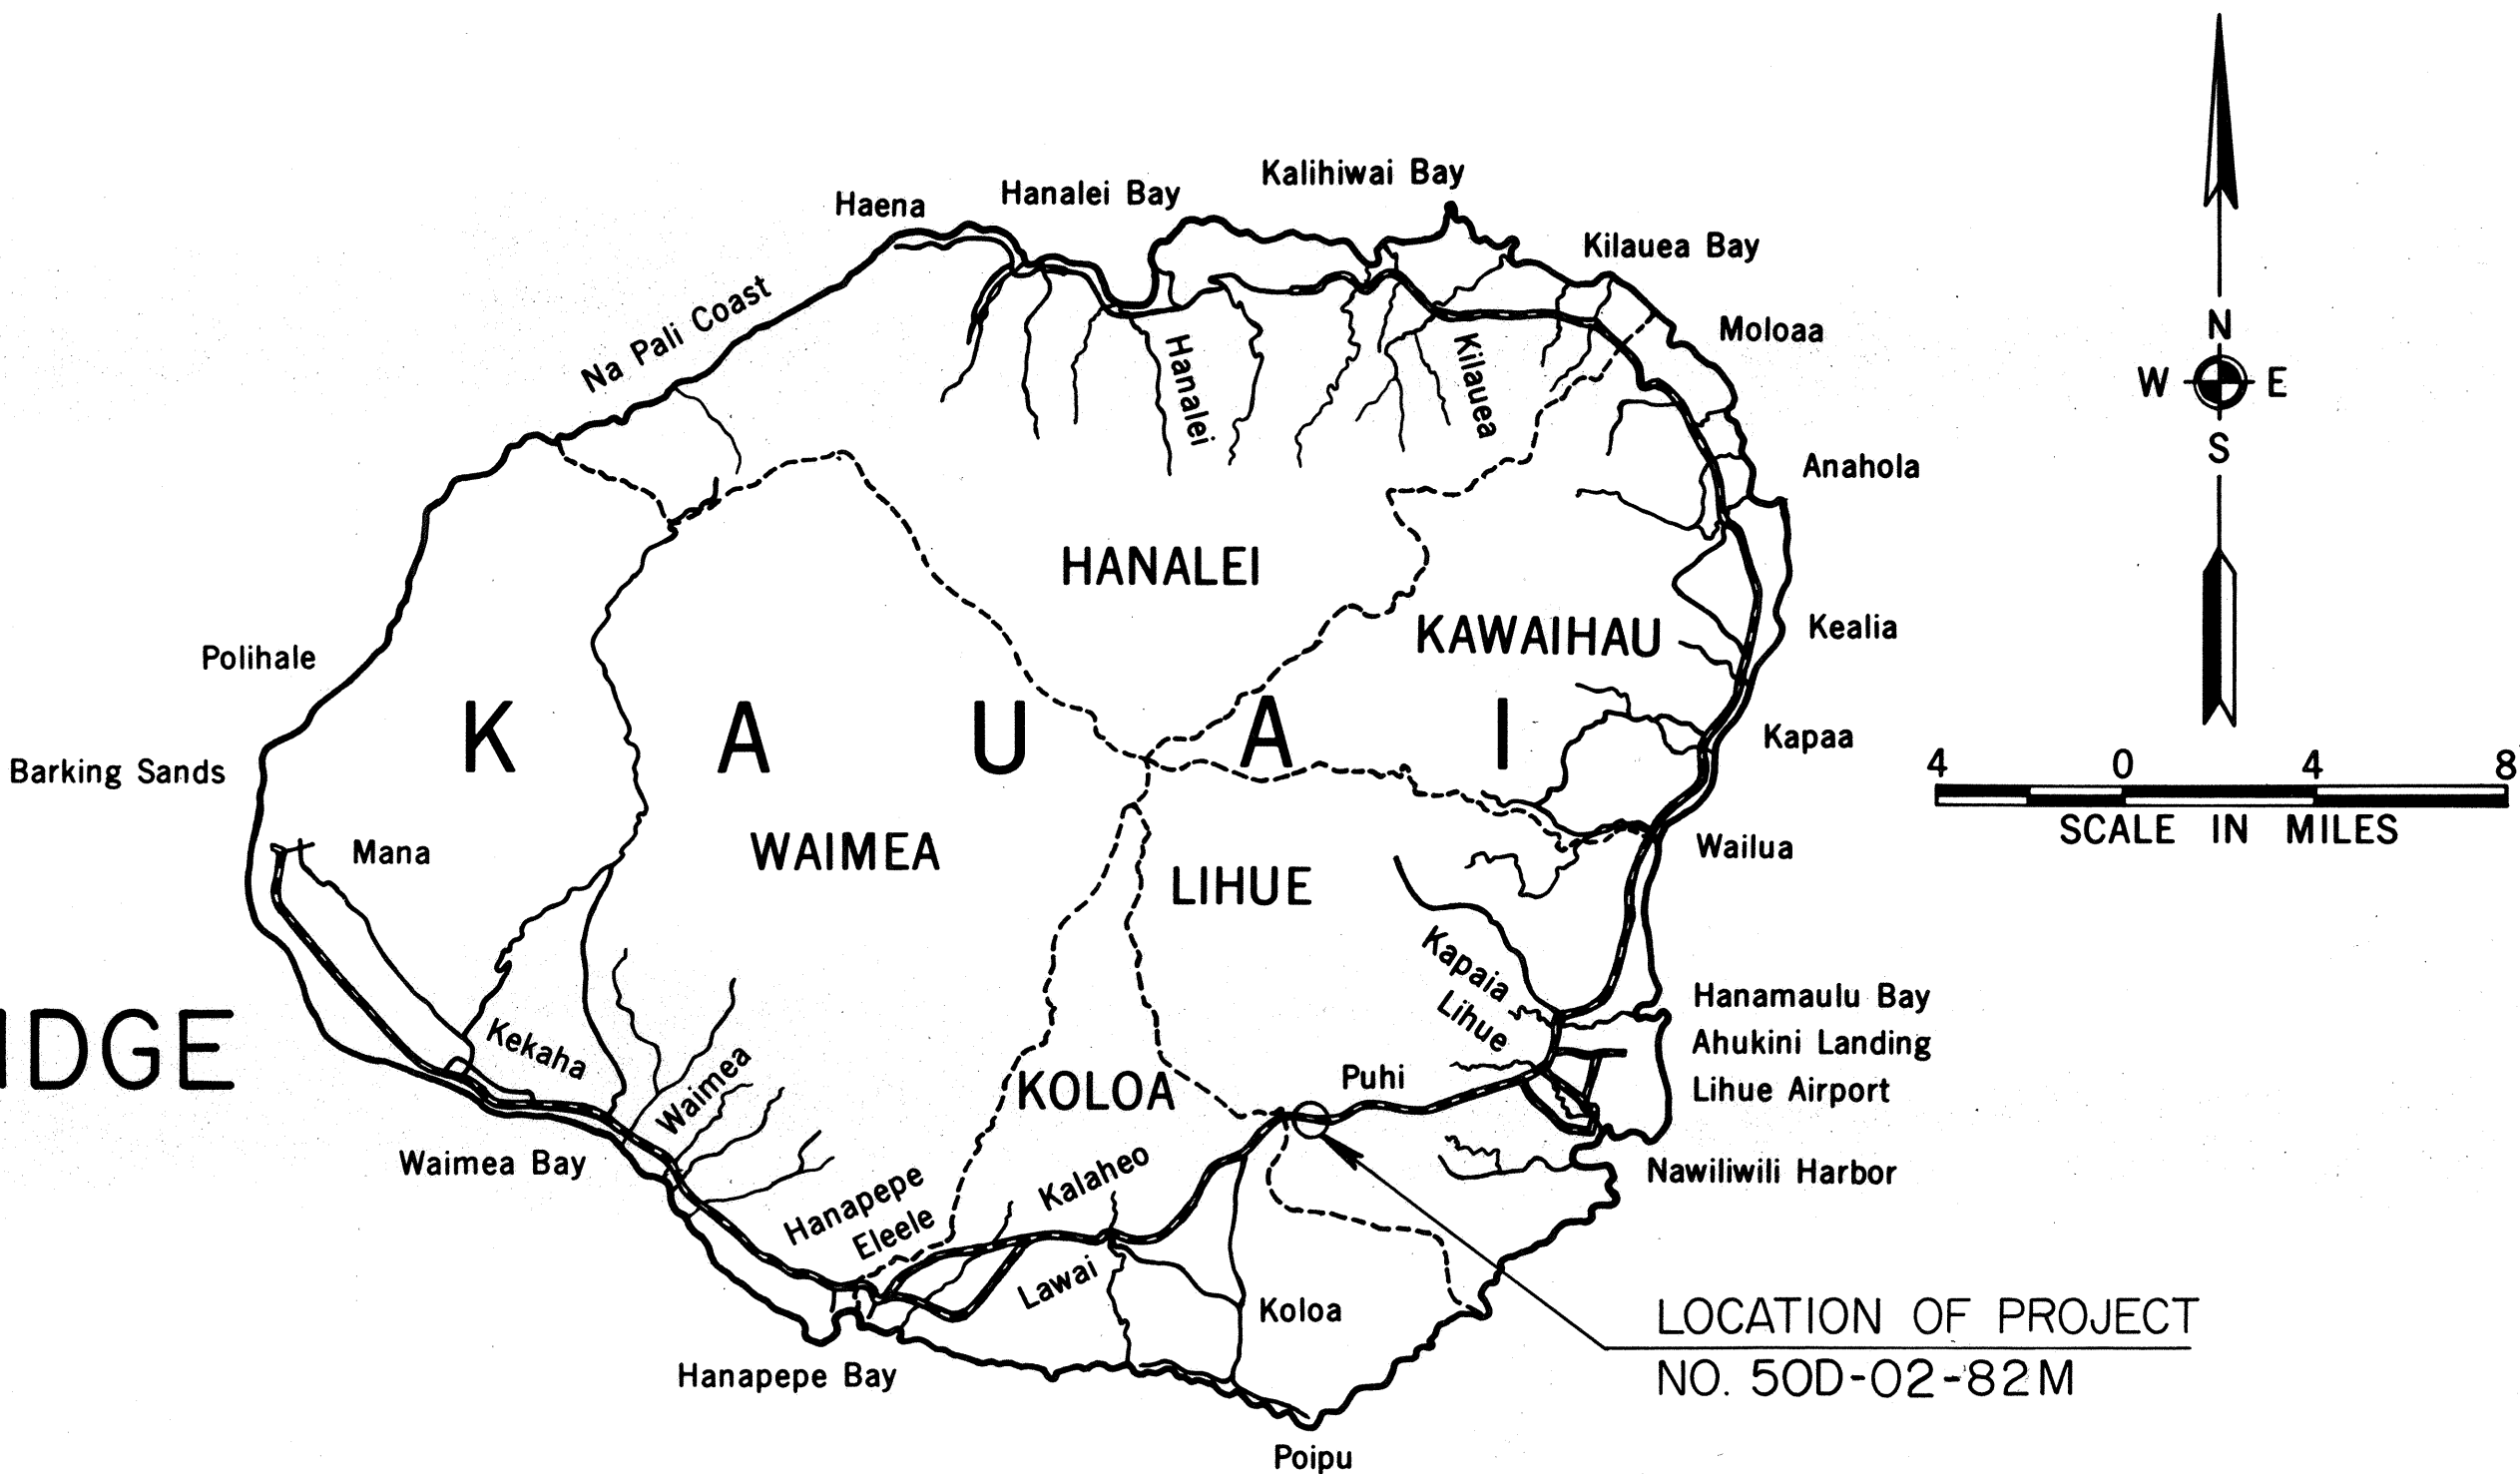

FEDERAL AID PROJECTS PREVIOUSLY CONSTRUCTED

OR UNDER CONSTRUCTION

GENERAL NOTES

- The project consists of termite treatment of Huleia Stream Bridge including all exposed timber, wooden deck, sidewalks, cross braces and railings. Ground treatment will not be required.

NO CHANGES WERE MADE DURING CONSTRUCTION


ON THESE PLANS

Donald Nagamine

RESIDENT ENGINEER

12-29-82

DATE

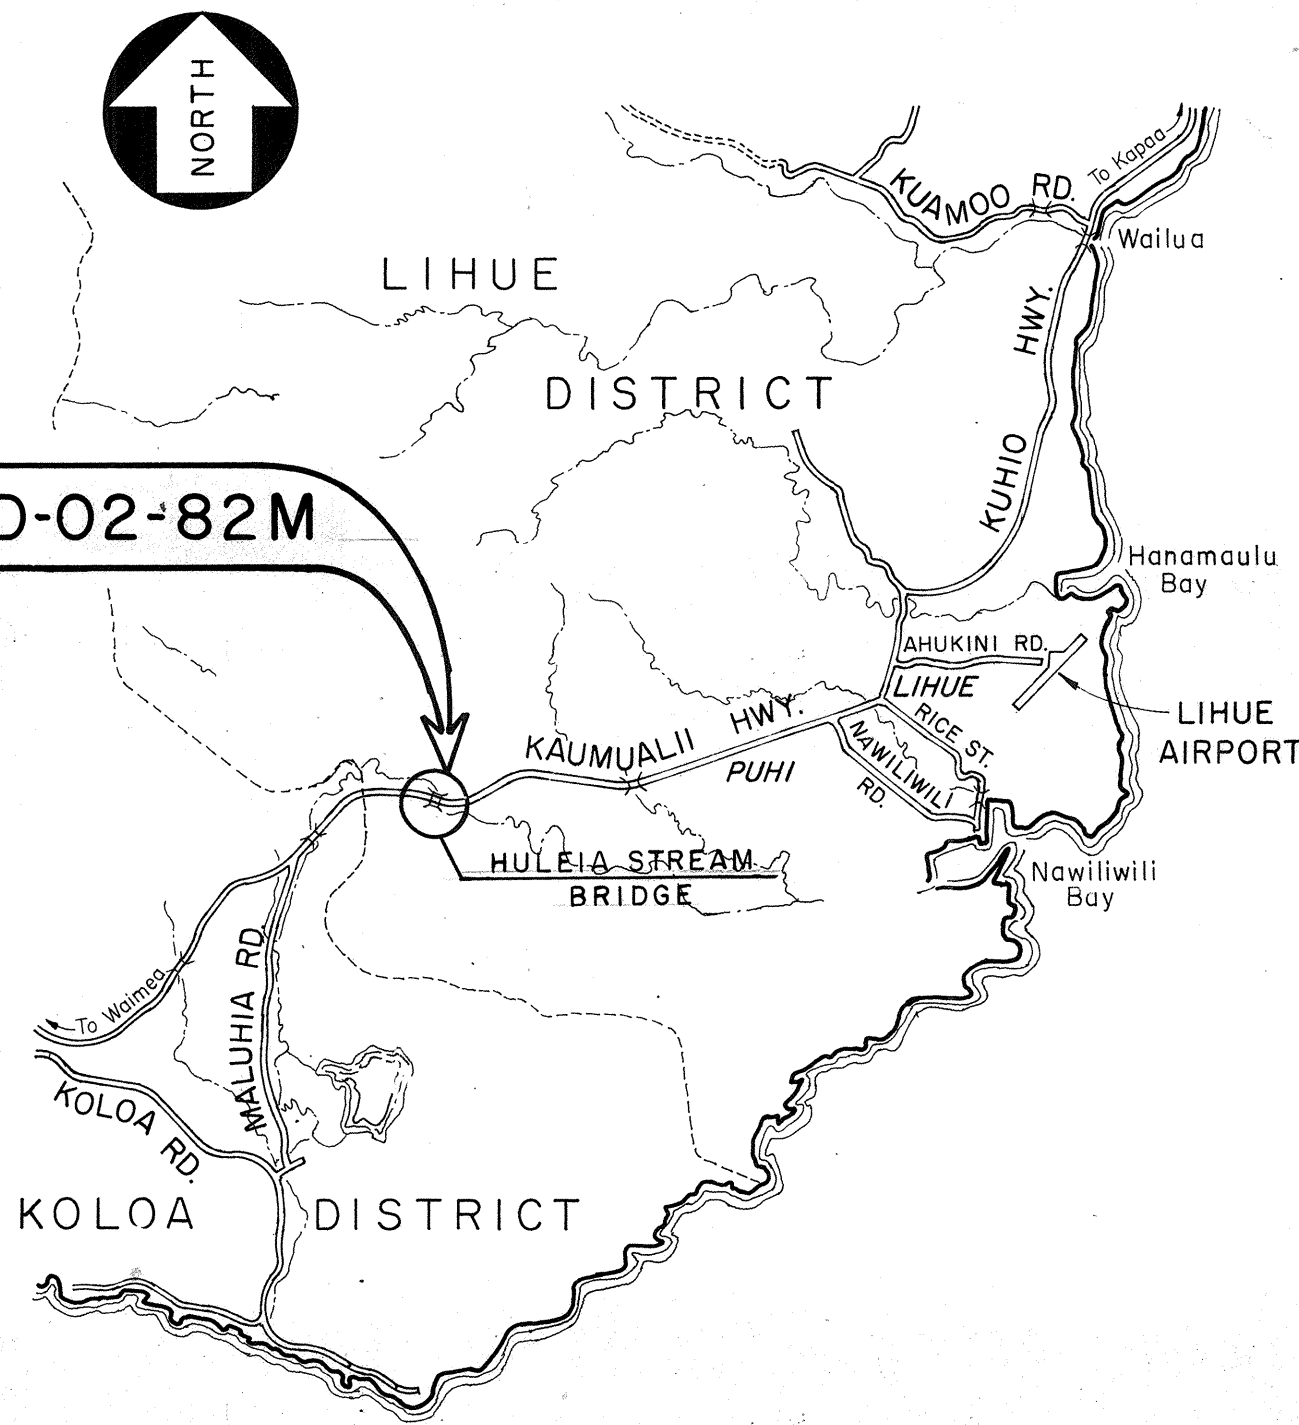

LAYOUT OF PROJECT

SCALE: 1" = 2 MILES

DEPARTMENT OF TRANSPORTATION STATE OF HAWAII	
APPROVED:	
James R. Carnas	5/13/82
DIR. OF TRANSPORTATION	DATE

DESIGNED BY

A. Yamaguchi

548-4125

MAY, 1982

DATE

PHONE

P. S. & E. BY

DESIGNED BY

A. Yamaguchi

548-4125

MAY, 1982

DATE

PHONE

P. S. & E. BY