	INDEX TO DRAWINGS
SHEET NO.	DESCRIPTION
1 7 7	TITLE SHEET
2	LAYOUT PLAN & SCALE PAD
	DETAIL
3	STANDARD DETAIL
	•
÷ :	
	
-	
<u></u>	
 	

MAY, 1982 DATE

548-7537 PHONE

R. Sigrot



STATE OF HAWAII

DEPARTMENT OF TRANSPORTATION

HIGHWAYS DIVISION

HONOLULU, HAWAII


PLANS FOR

KAUMUALII HIGHWAY

VEHICLE SIZE & WEIGHT ENFORCEMENT STA. AT PUHI MILEPOST 1.44, INBOUND & MILEPOST 1.25, OUTBOUND

PROJECT NO. 50E-01-82

DISTRICT OF LIHUE ISLAND OF KAUAI

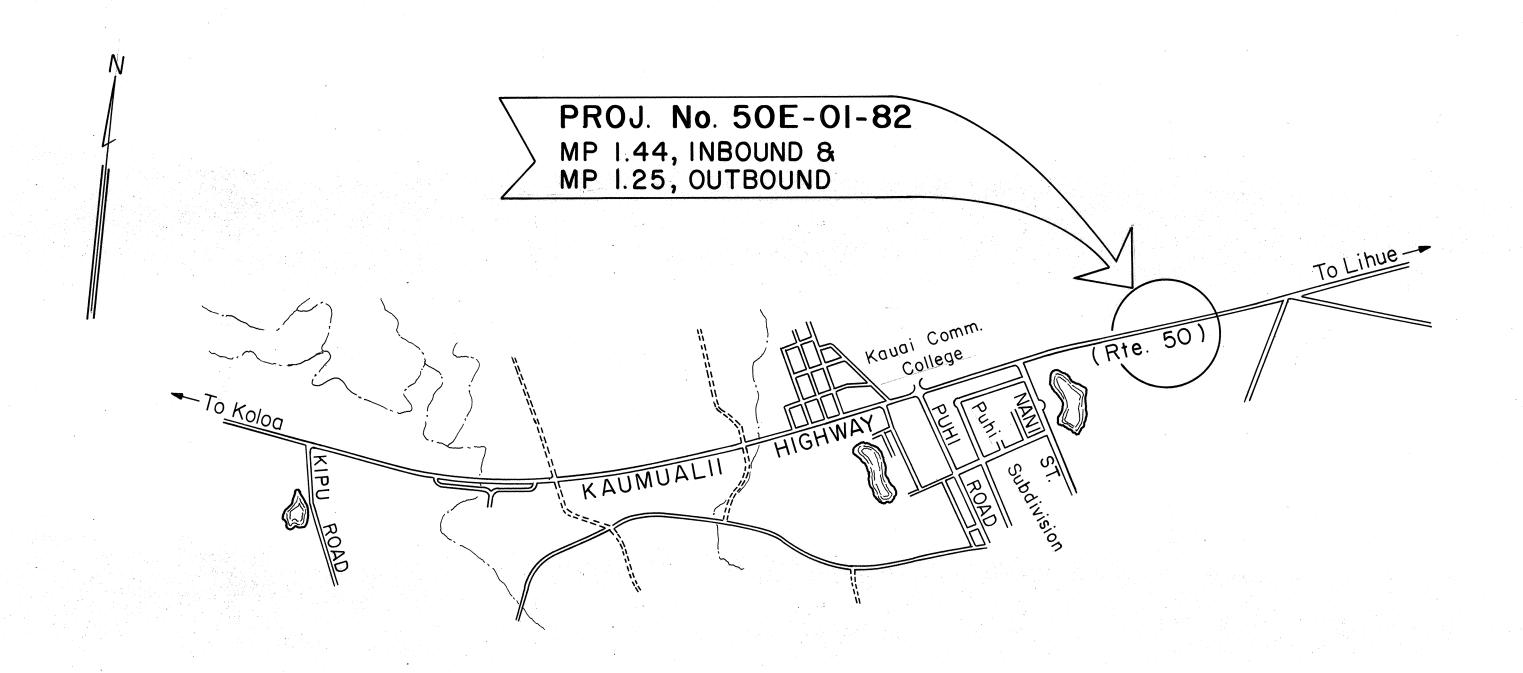



LAYOUT OF PROJECT


SCALE: I" = 1,000'

FED. ROAD DIST. NO. STATE PROJ. NO. FISCAL SHEET NO. SHEETS

HAWAII HAW. 50E-01-82 1982 1

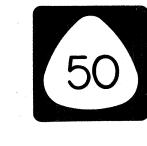

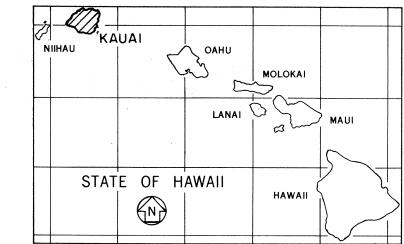

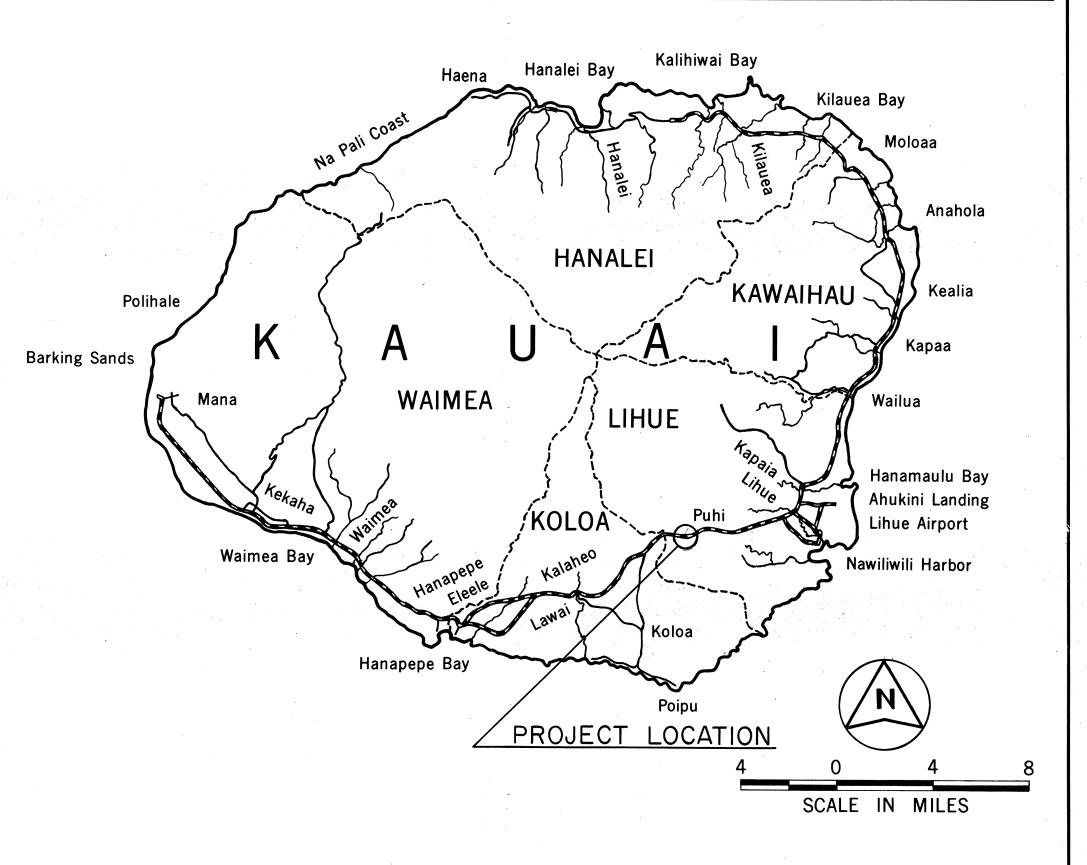

FEDERAL AID PROJECTS PREVIOUSLY CONSTRUCTED
OR UNDER CONSTRUCTION

ALL CHANGES MADE DURING CONSTRUCTION
HAVE BEEN NOTED IN RED ON THESE TRACINGS
AND CHECKED BY

Ponald Magamine RESIDENT ENGINEER

12-29-82 DATE

DEPARTMENT OF TRANSPORTATION
STATE OF HAWAII

APPROVED:

Sames R. Carras 6/3/82

DIR. OF TRANSPORTATION

SPORTATION DAT