

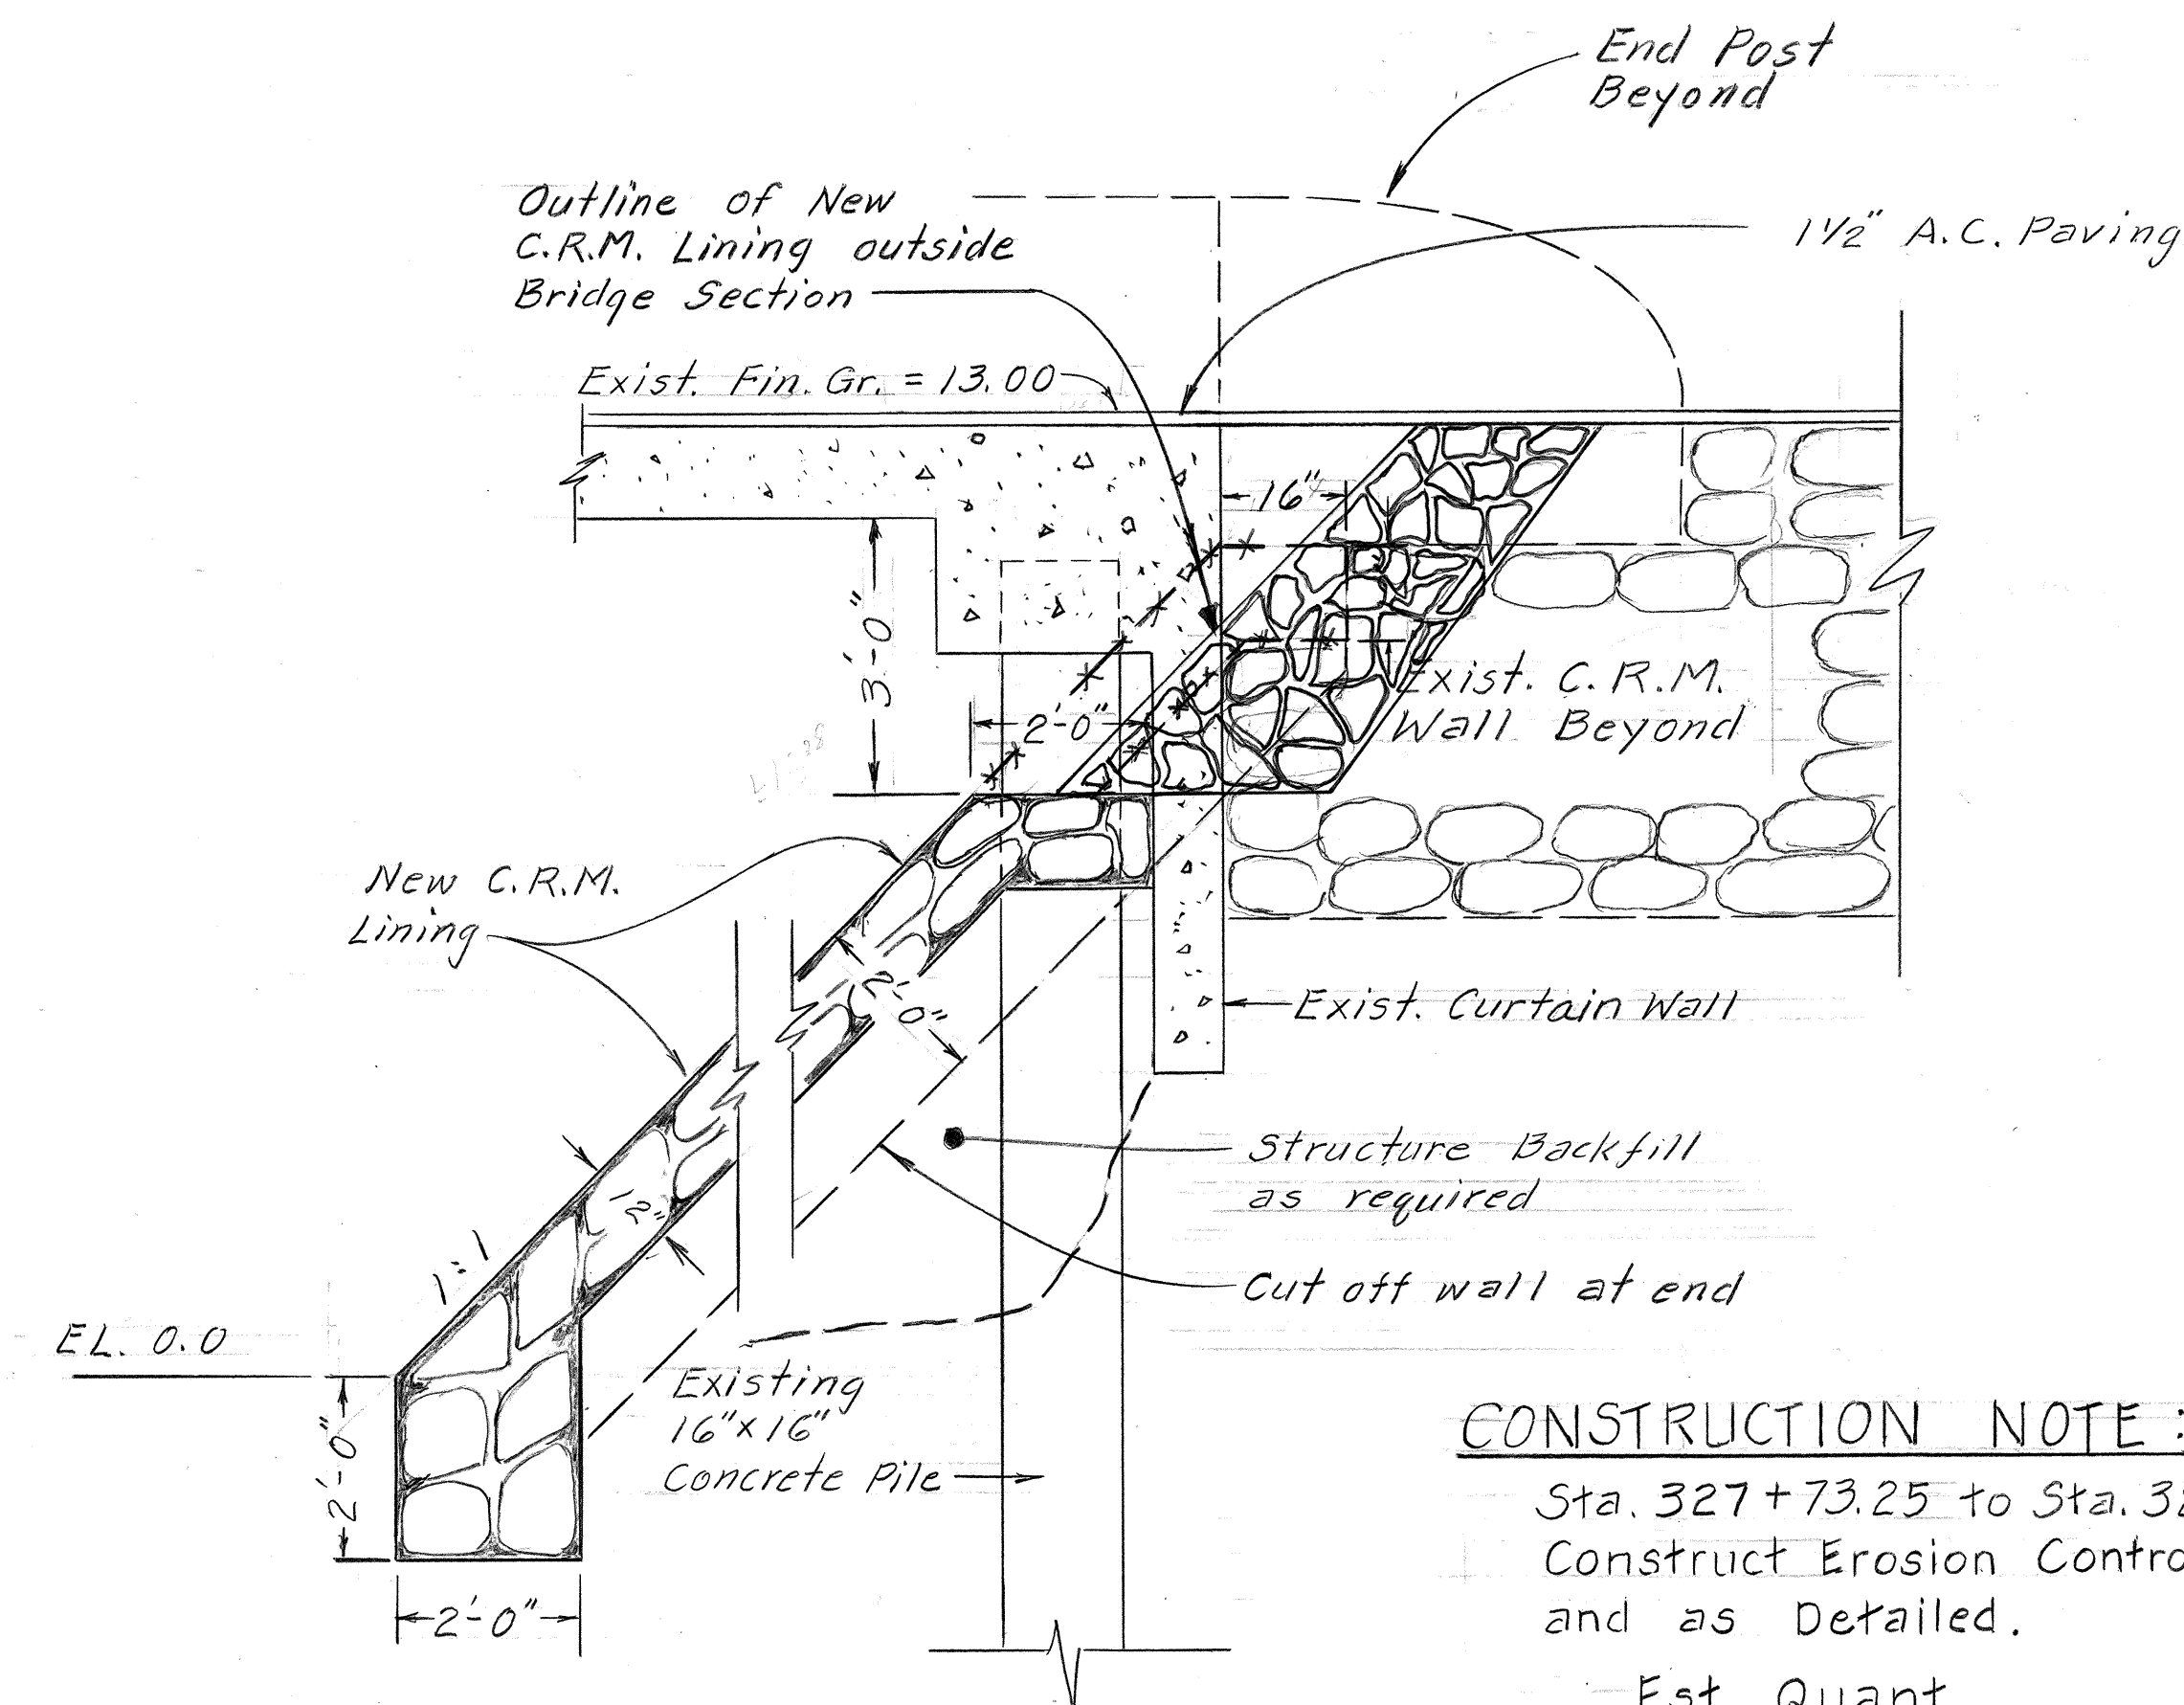
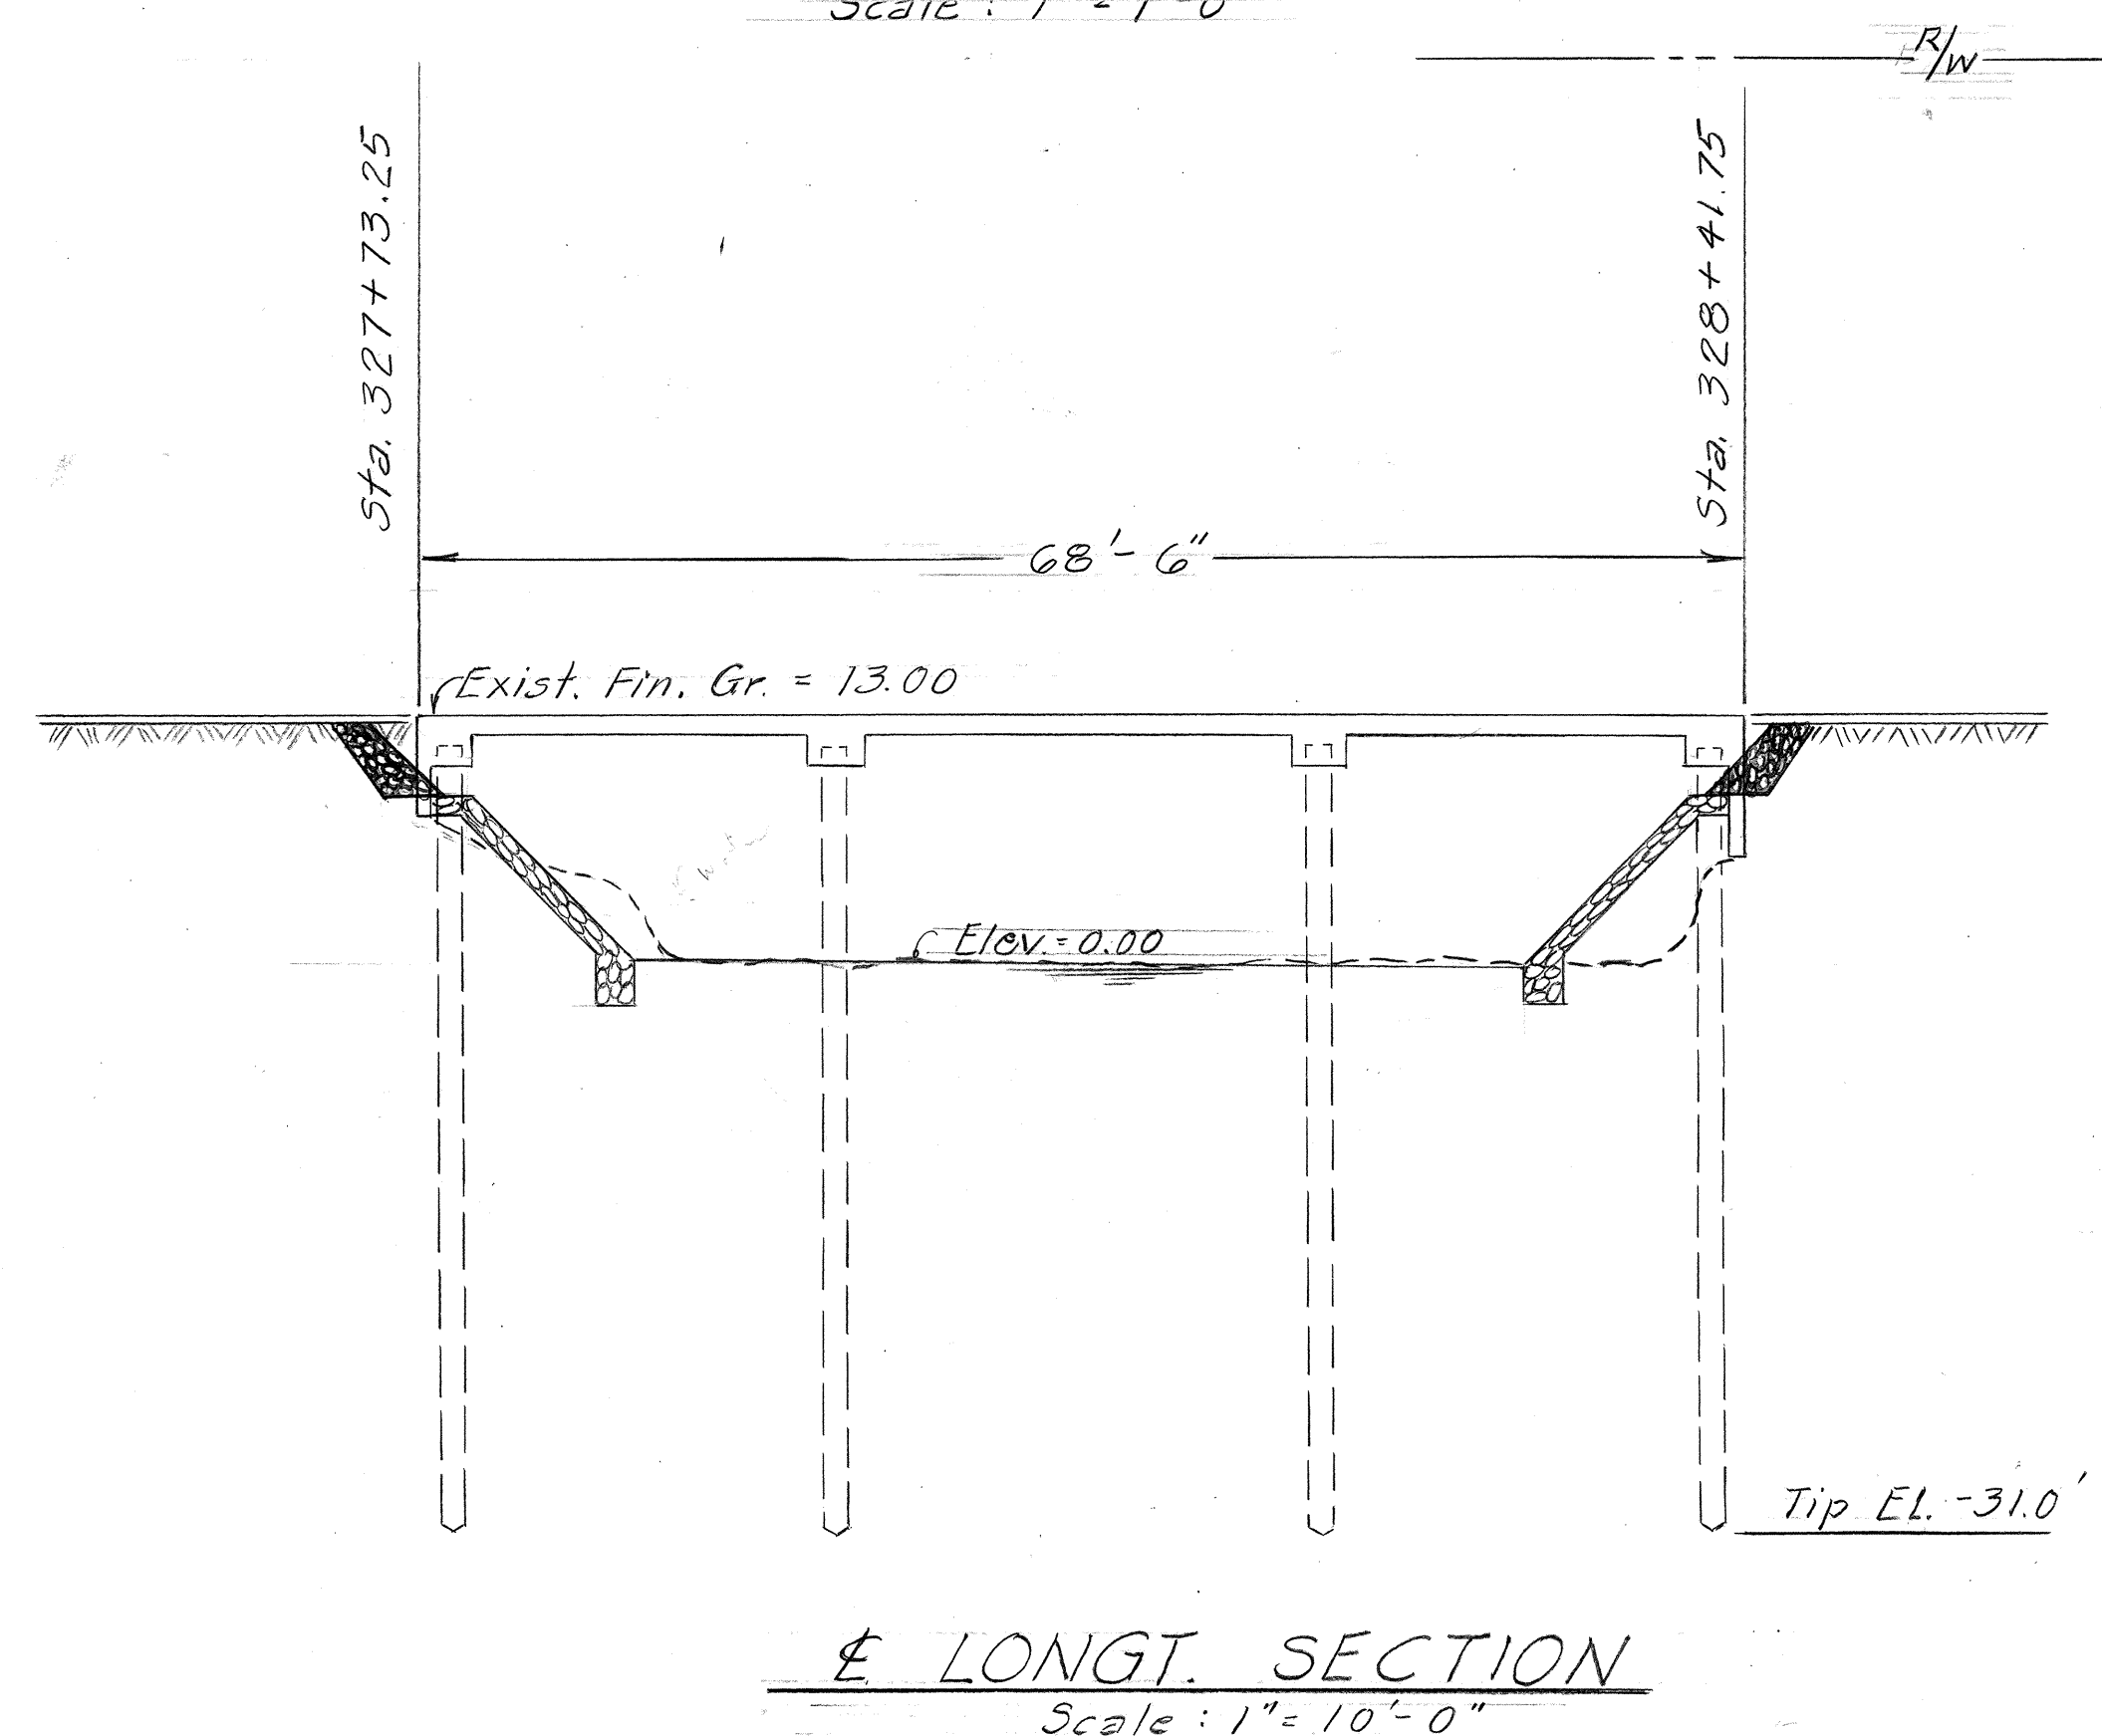


FED. ROAD DIST. NO.	STATE	FED. AID PROJ. NO.	FISCAL YEAR	SHEET NO.	TOTAL SHEETS
HAWAII	HAW.	ER-10(2)	1984	28	34

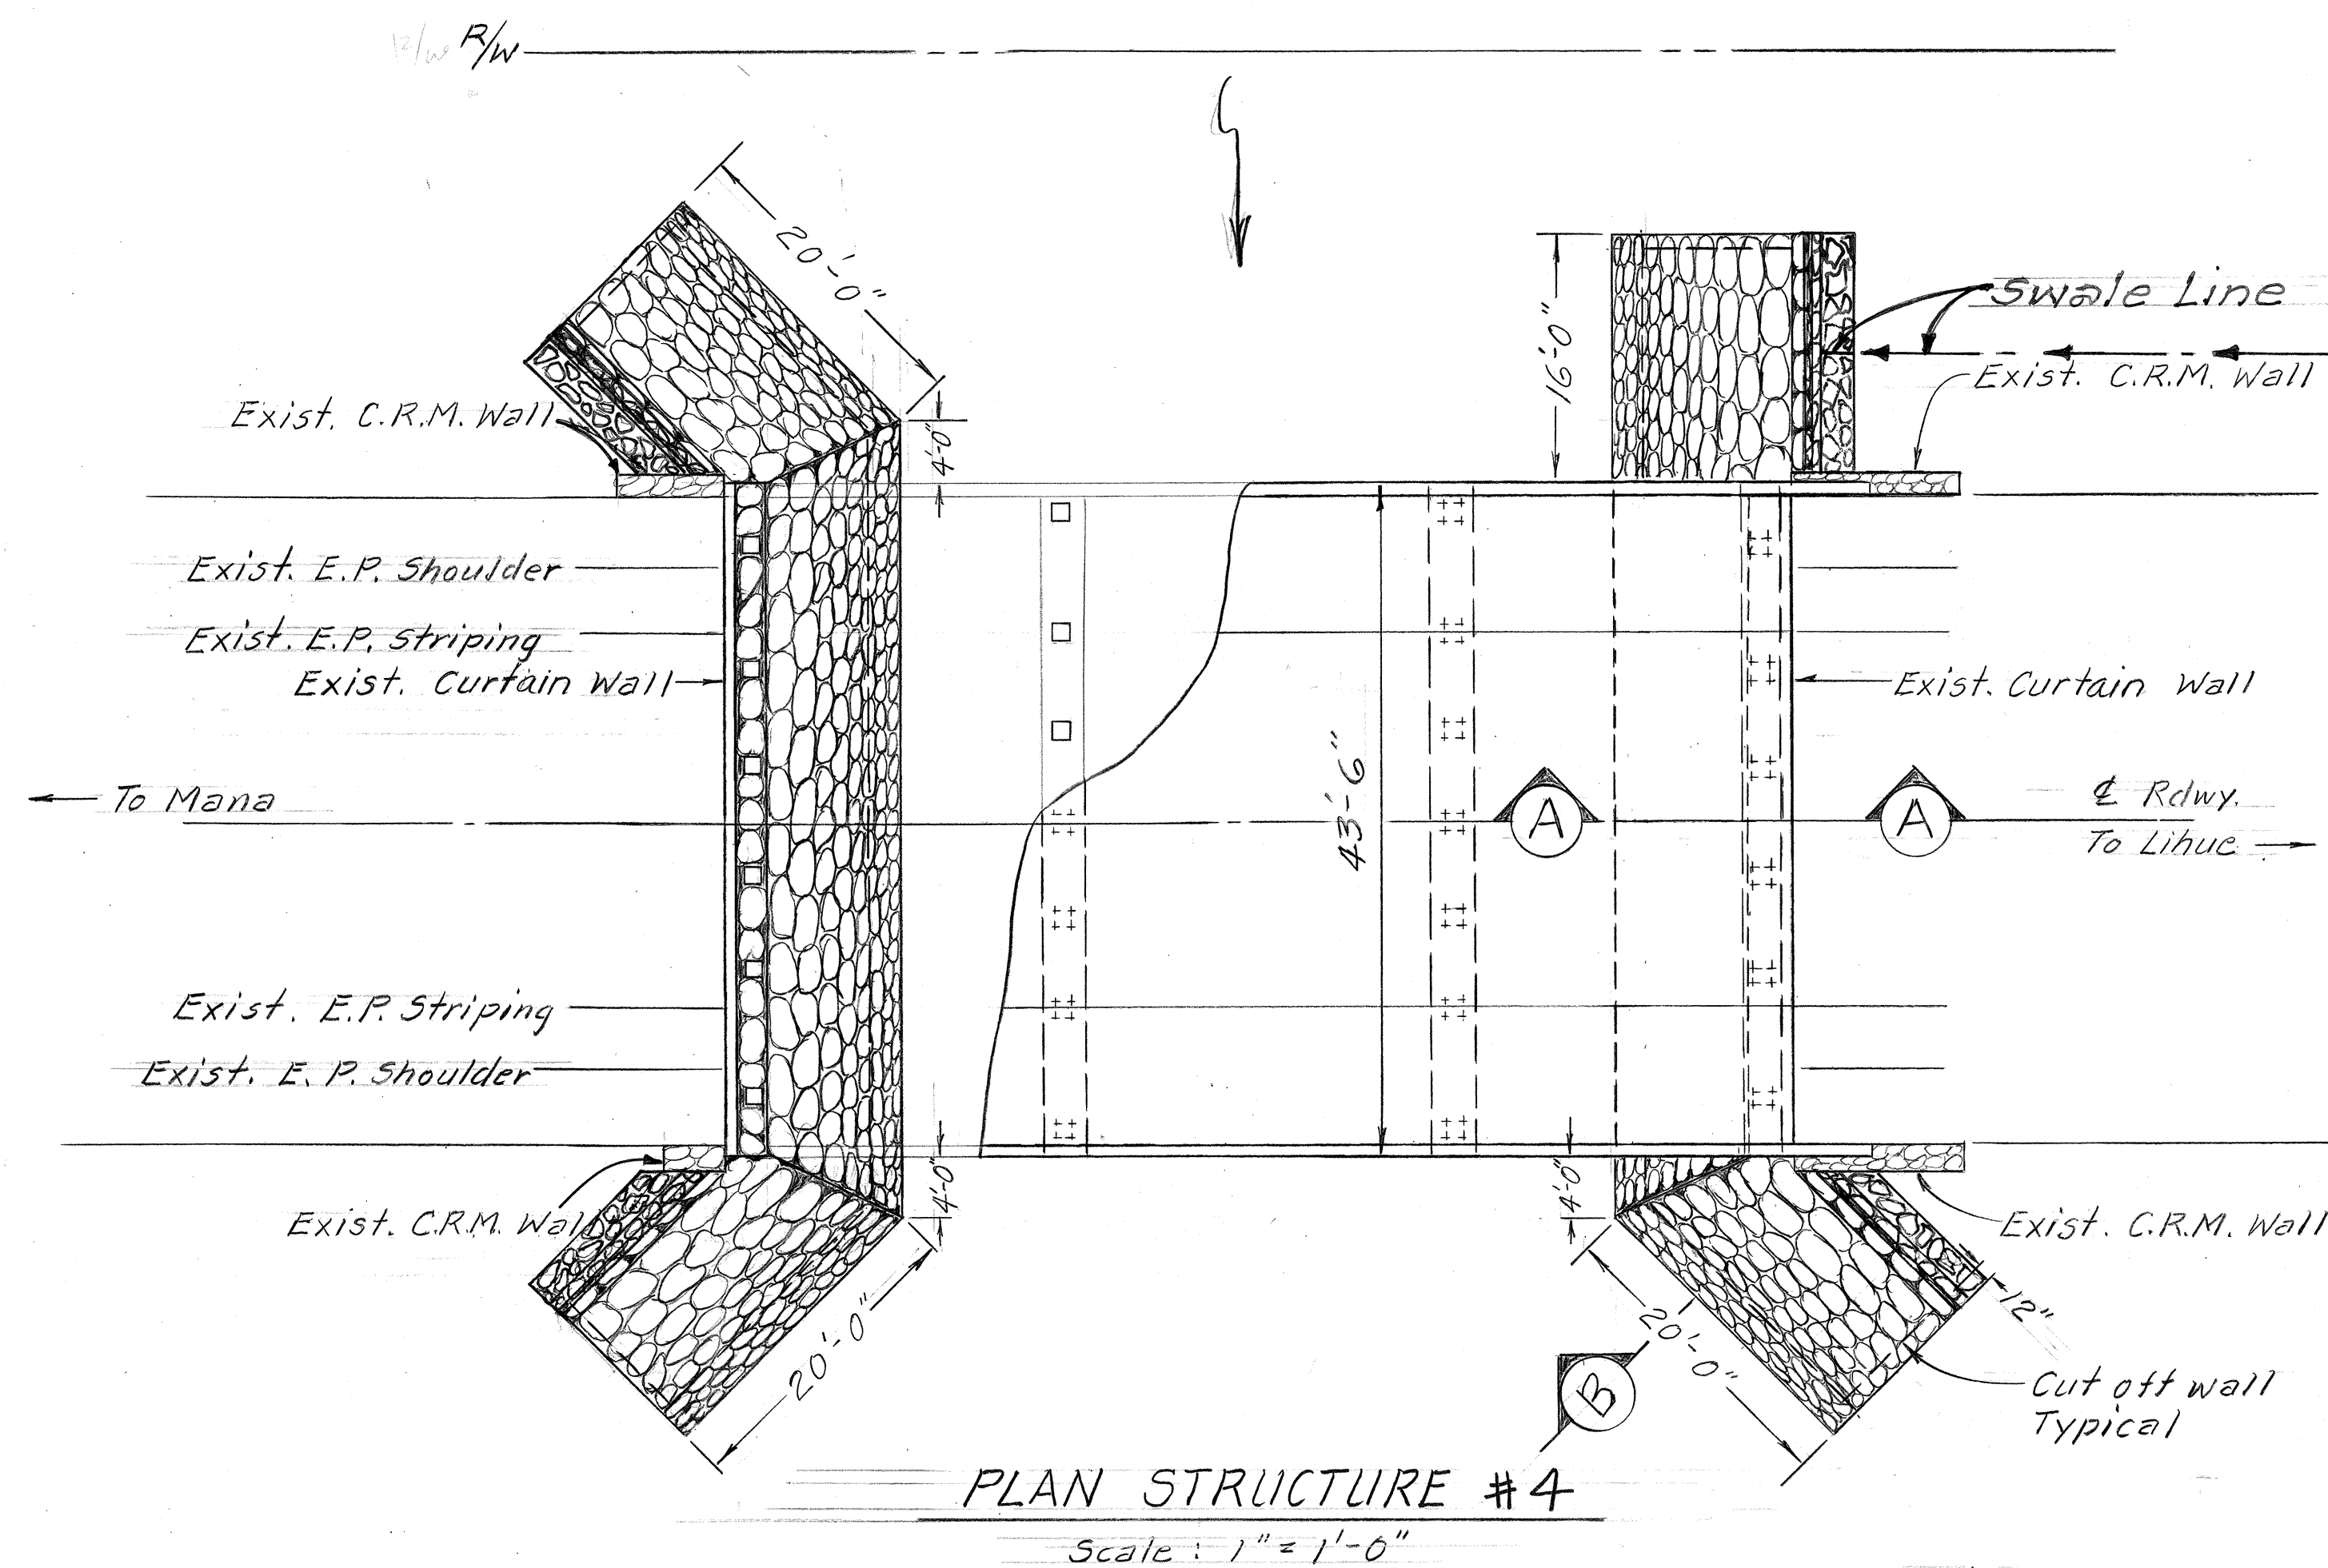

A - TYPICAL SECTION
Scale: 1/2" = 1'-0"

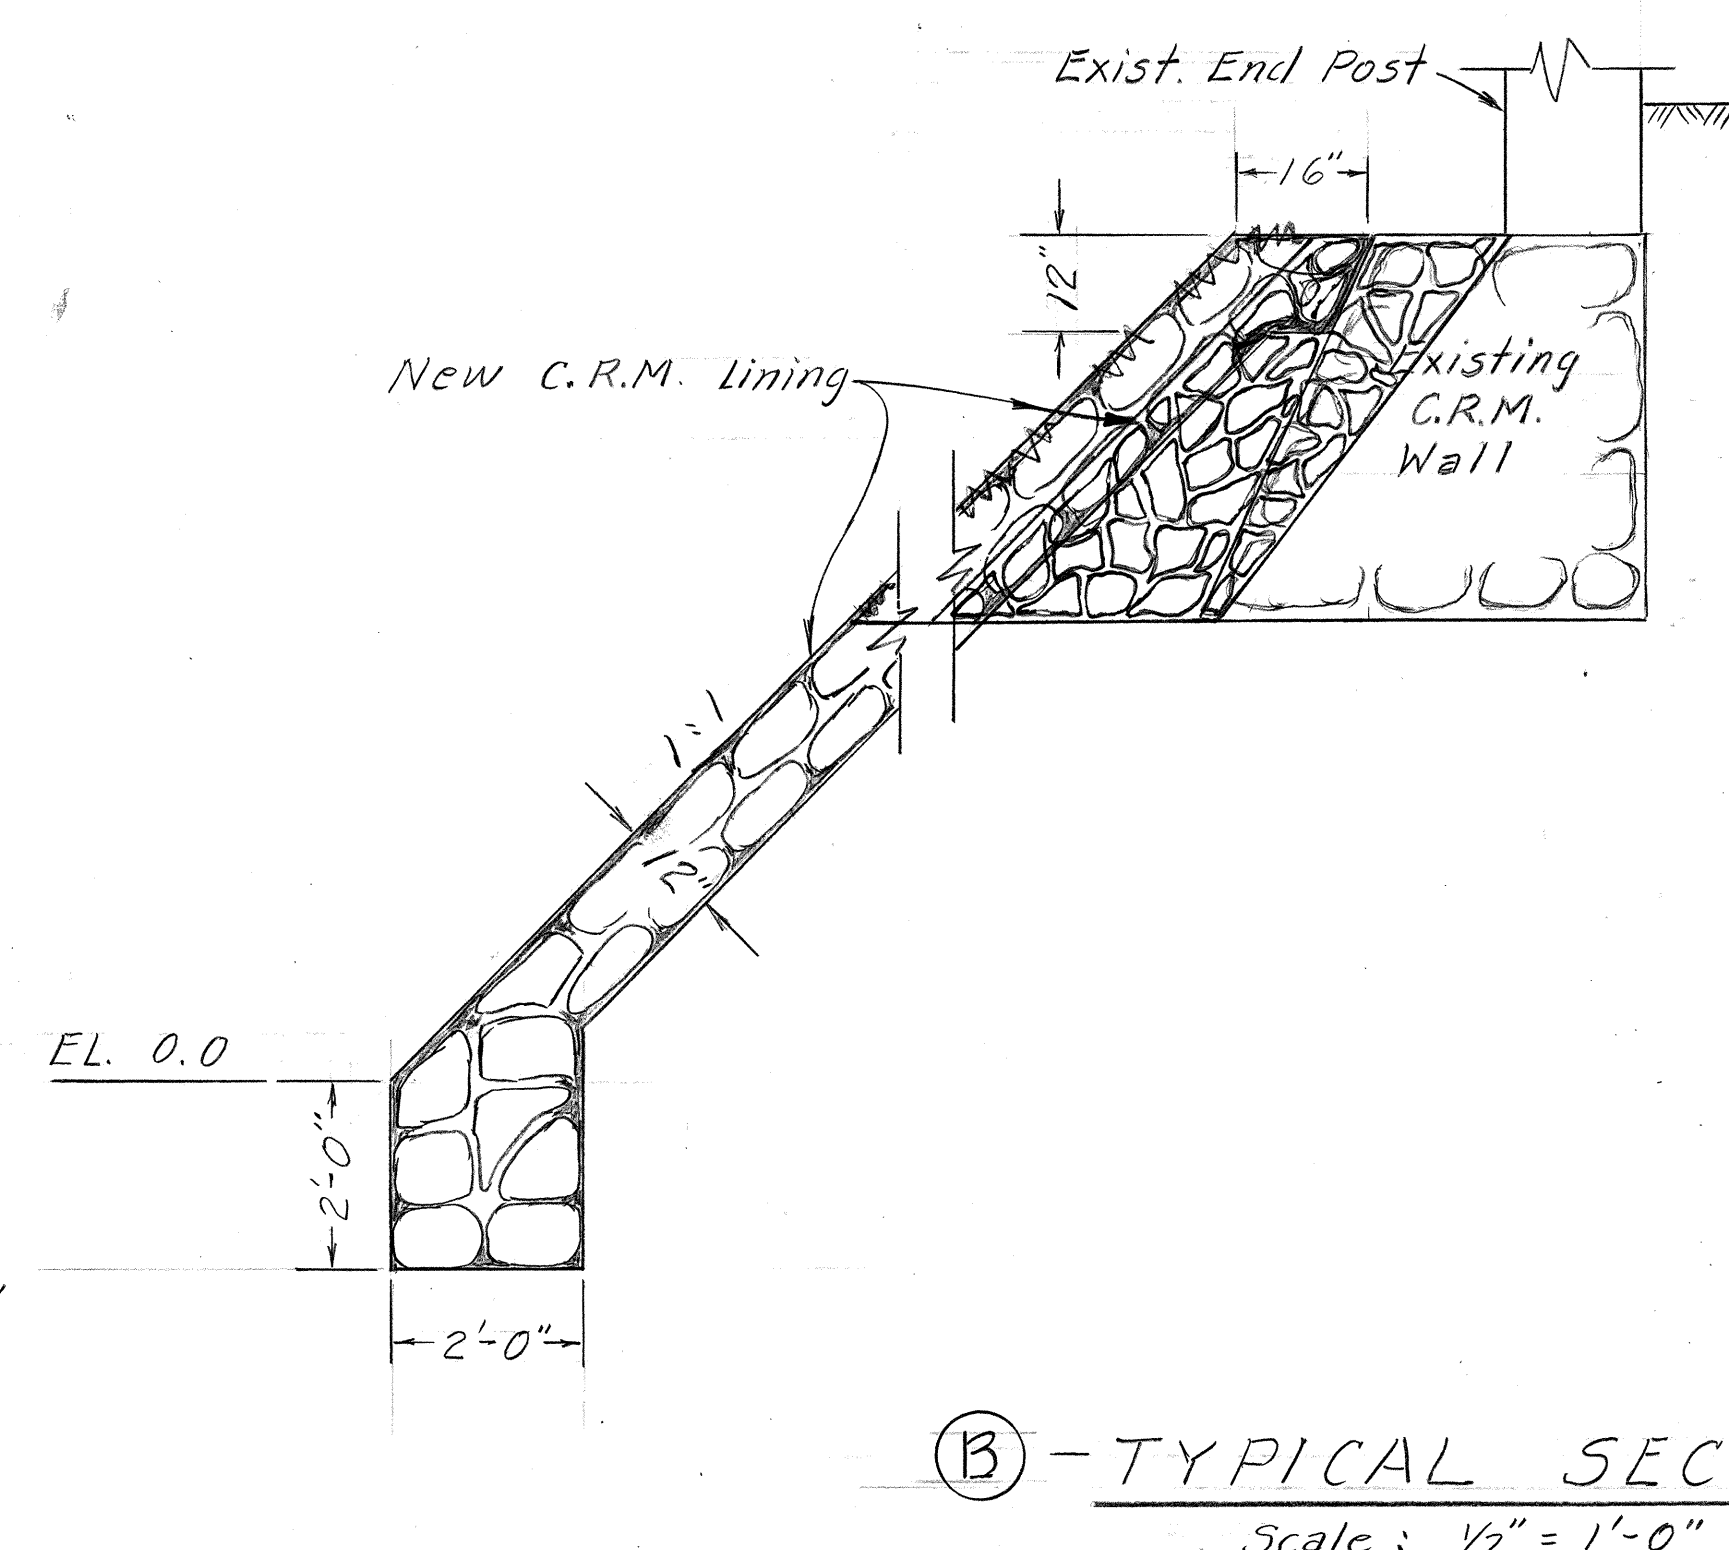

B - TYPICAL SECTION
Scale: 1/2" = 1'-0"

CONSTRUCTION NOTE:
Sta. 327+73.25 to Sta. 328+41.75 (STRUCTURE #4)
Construct Erosion Control C.R.M. Lining as shown and as Detailed.
Est. Quant.
C.R.M. = ~~120 C.Y.~~ 128 C.Y.

- NOTE:**
- 1.- Temporary erosion control sand/ rock fill shall be removed, stockpiled and reused for construction of new C.R.M. Lining. This work shall not be measured or paid for directly but shall be considered incidental to "Item C.R.M."
 - 2.- Structure excavation and backfill shall be incidental to "Item C.R.M."
 - 3.- Care shall be exercised for existing water-line during construction. Any damages to pipe shall be repaired and paid for by the contractor.
 - 4.- C.R.M. lined wingwall alignment as shown is approximate. Wingwall shall in all intent be constructed to follow existing ground condition or as directed by the Engineer.

STATE OF HAWAII
DEPARTMENT OF TRANSPORTATION
LAND TRANSPORTATION FACILITIES DIVISION
REPAIR TO STRUCTURE #4
Sta. 327+73.25 to 328+41.75
KAUMUALII HIGHWAY
RECONSTRUCTION & PROTECTIVE
MEASURES AT KEKAHA (PHASE I)
FEDERAL AID PROJECT NO. ER-10(2)
Scale: As Shown Date: June, 1983
SHEET No. OF SHEETS