
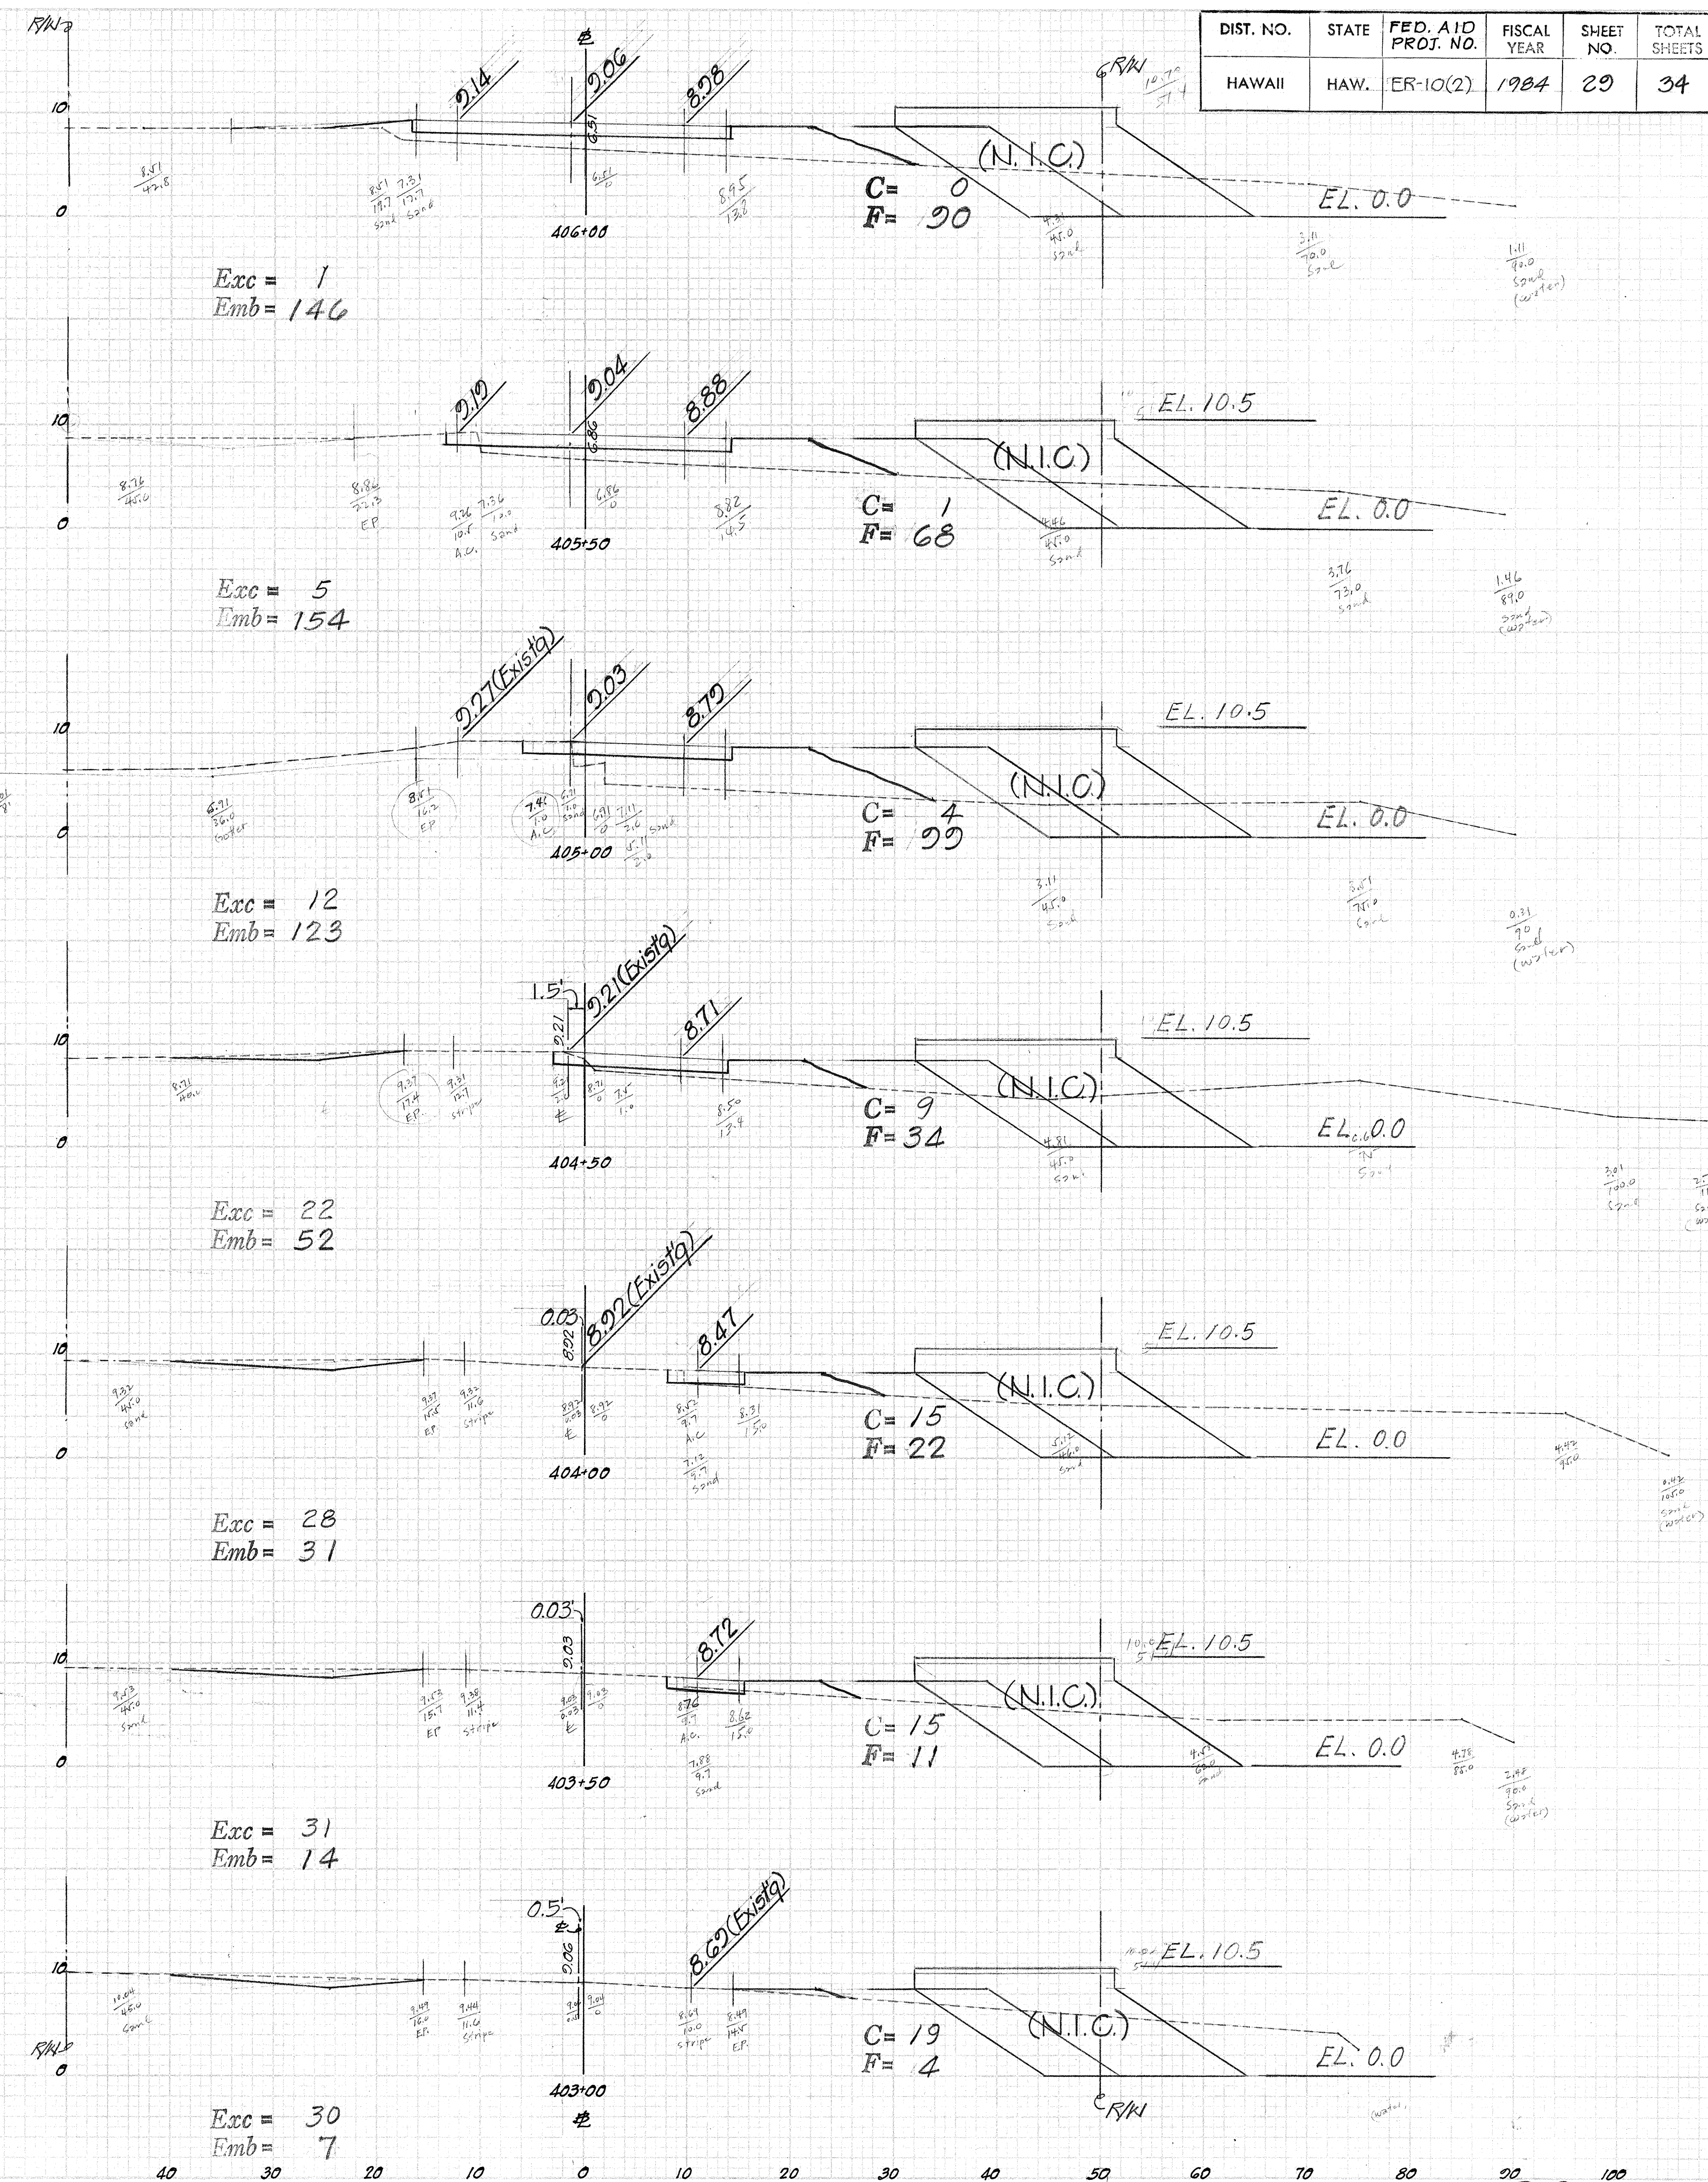


FINAL SURVEY
BY
DATE
SHEET NO.
PROJECT NO.
SHEET NO.
PROJECT NO.
SHEET NO.
PROJECT NO.

ORIGINAL SURVEY
BY
DATE
SHEET NO.
PROJECT NO.
SHEET NO.
PROJECT NO.
SHEET NO.
PROJECT NO.



DIST. NO.	STATE	FED. AID PROJ. NO.	FISCAL YEAR	SHEET NO.	TOTAL SHEETS
HAWAII	HAW.	ER-10(2)	1984	29	34

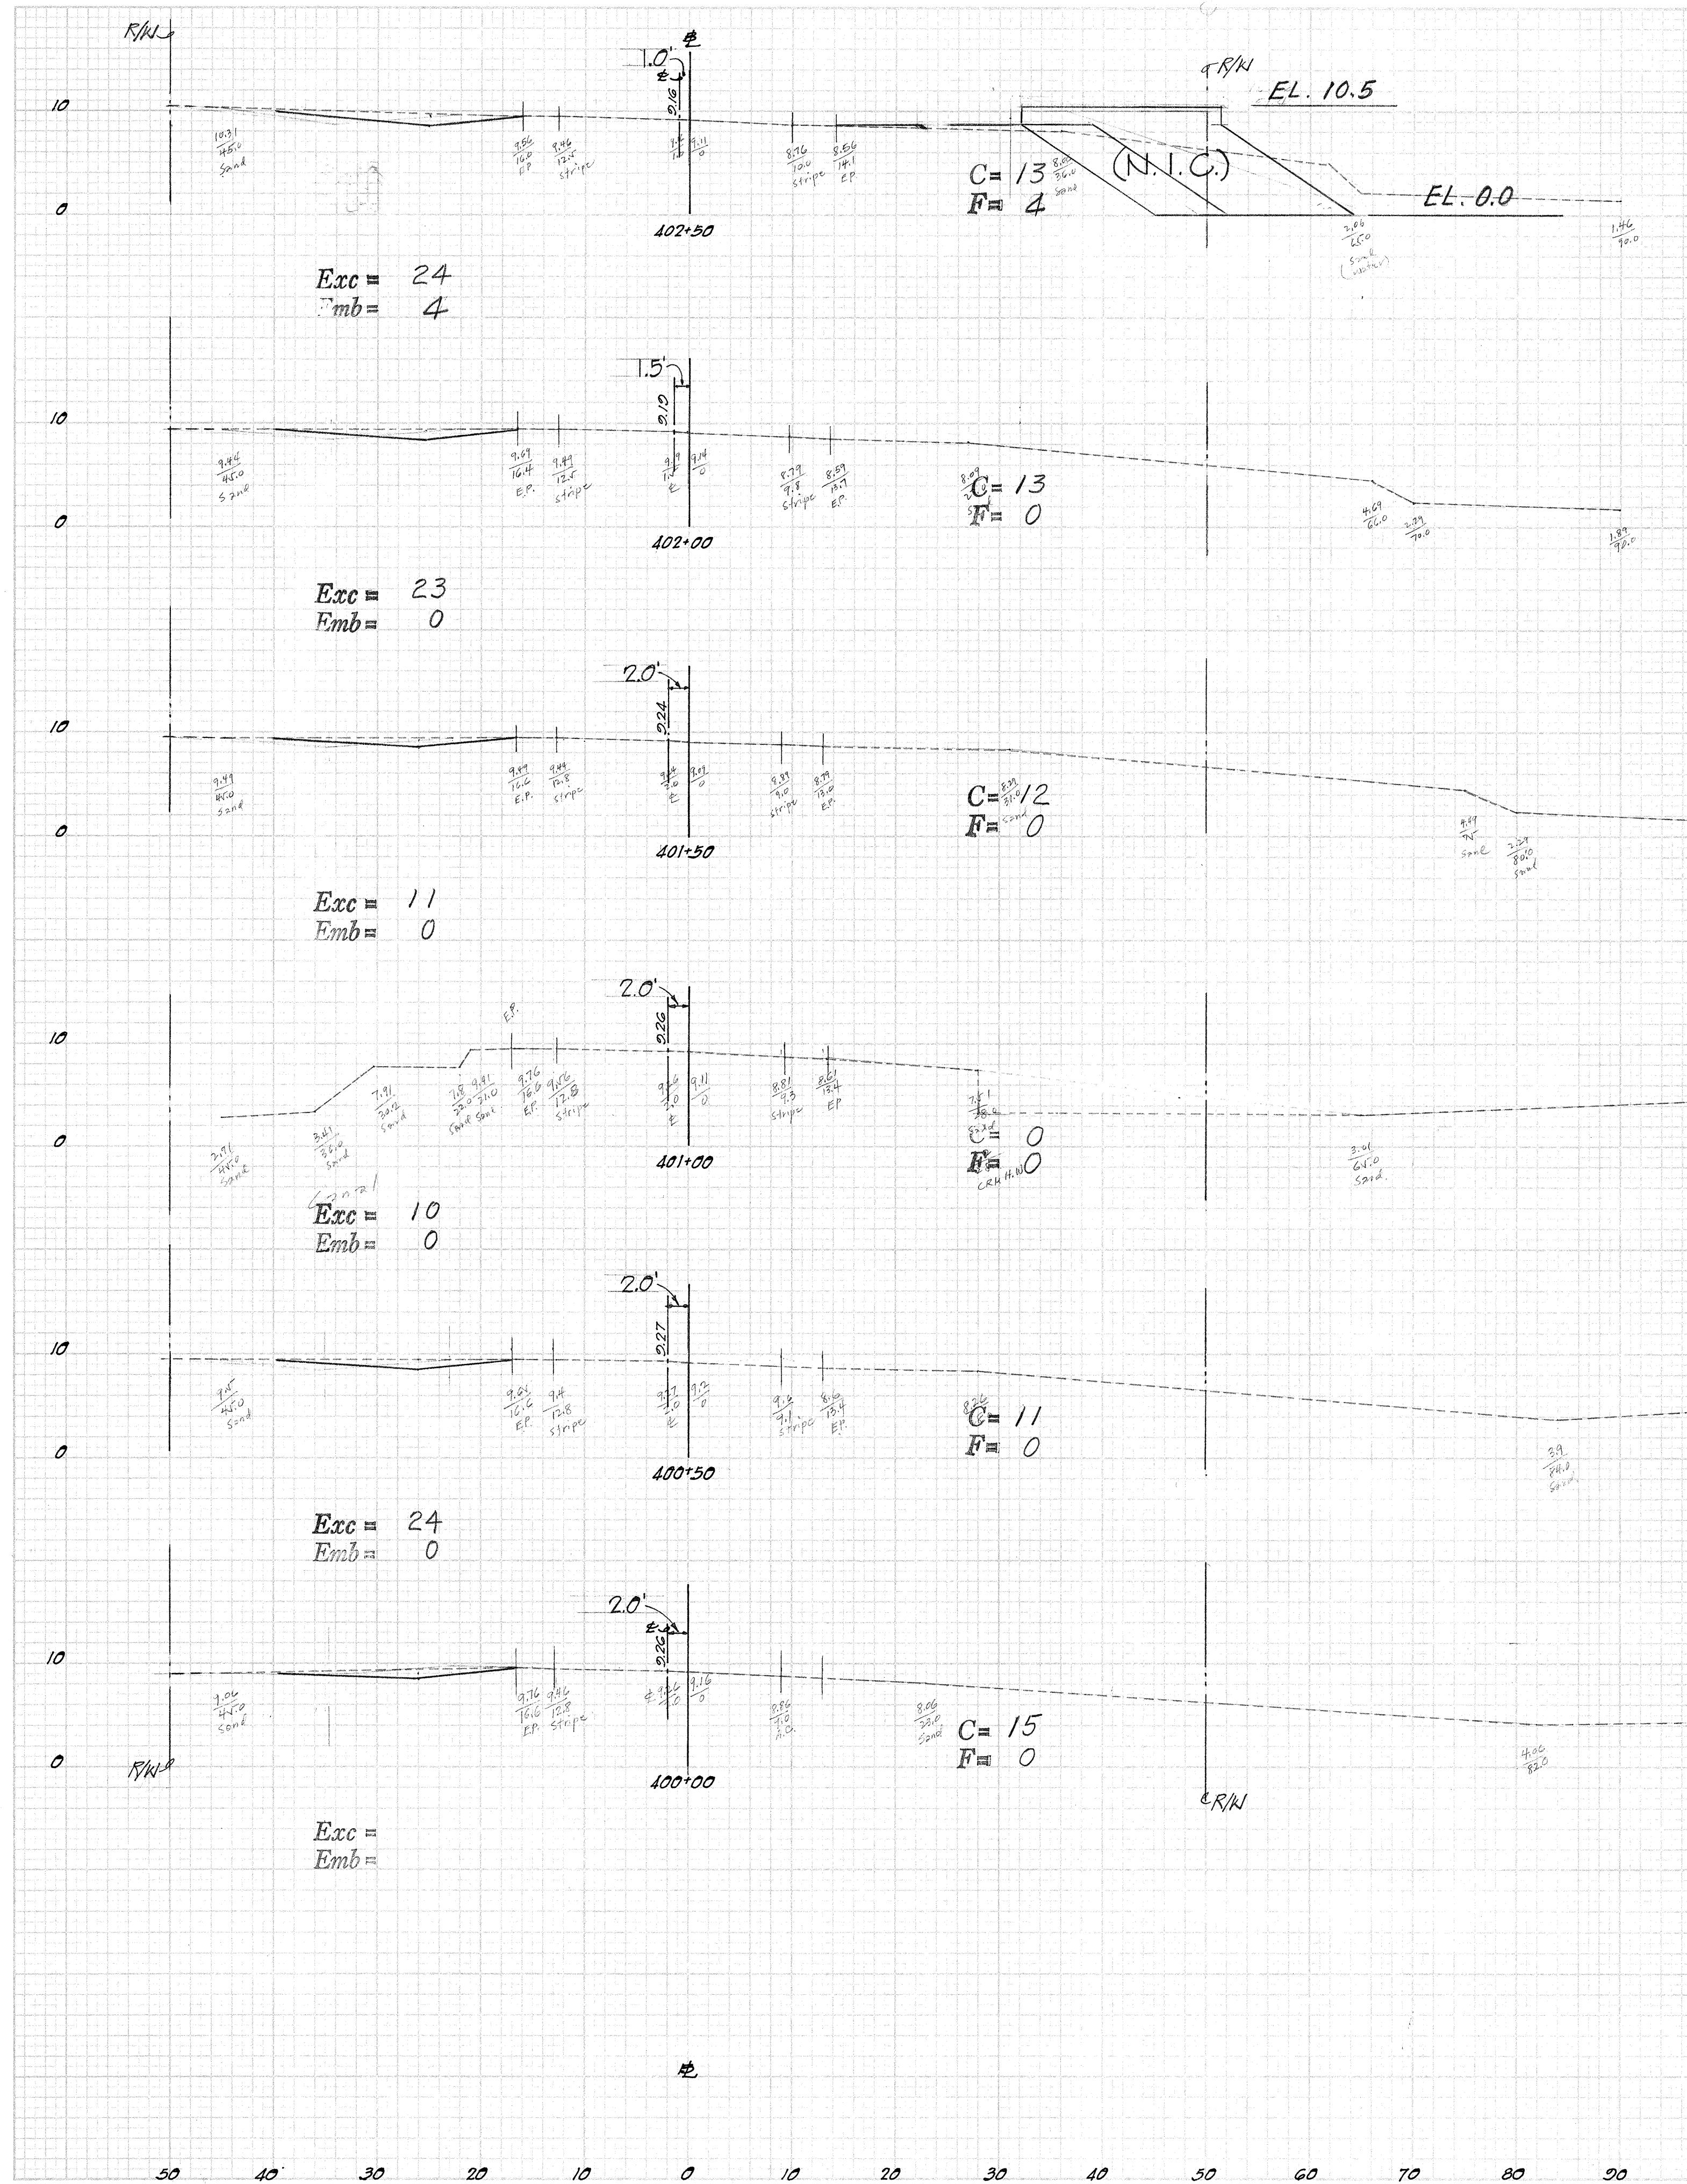



DIST. NO.	STATE	FED. AID PROJ. NO.	FISCAL YEAR	SHEET NO.	TOTAL SHEETS
HAWAII	HAW.	ER-10(2)	1984	30	34

FINAL SURVEY	DATE
SURVEYED	BY
PLOTTED	BY
NOTED	BY
AREAS CHECKED	BY

ORIGINAL SURVEY	DATE
SURVEYED	BY
PLOTTED	BY
NOTED	BY
AREAS CHECKED	BY

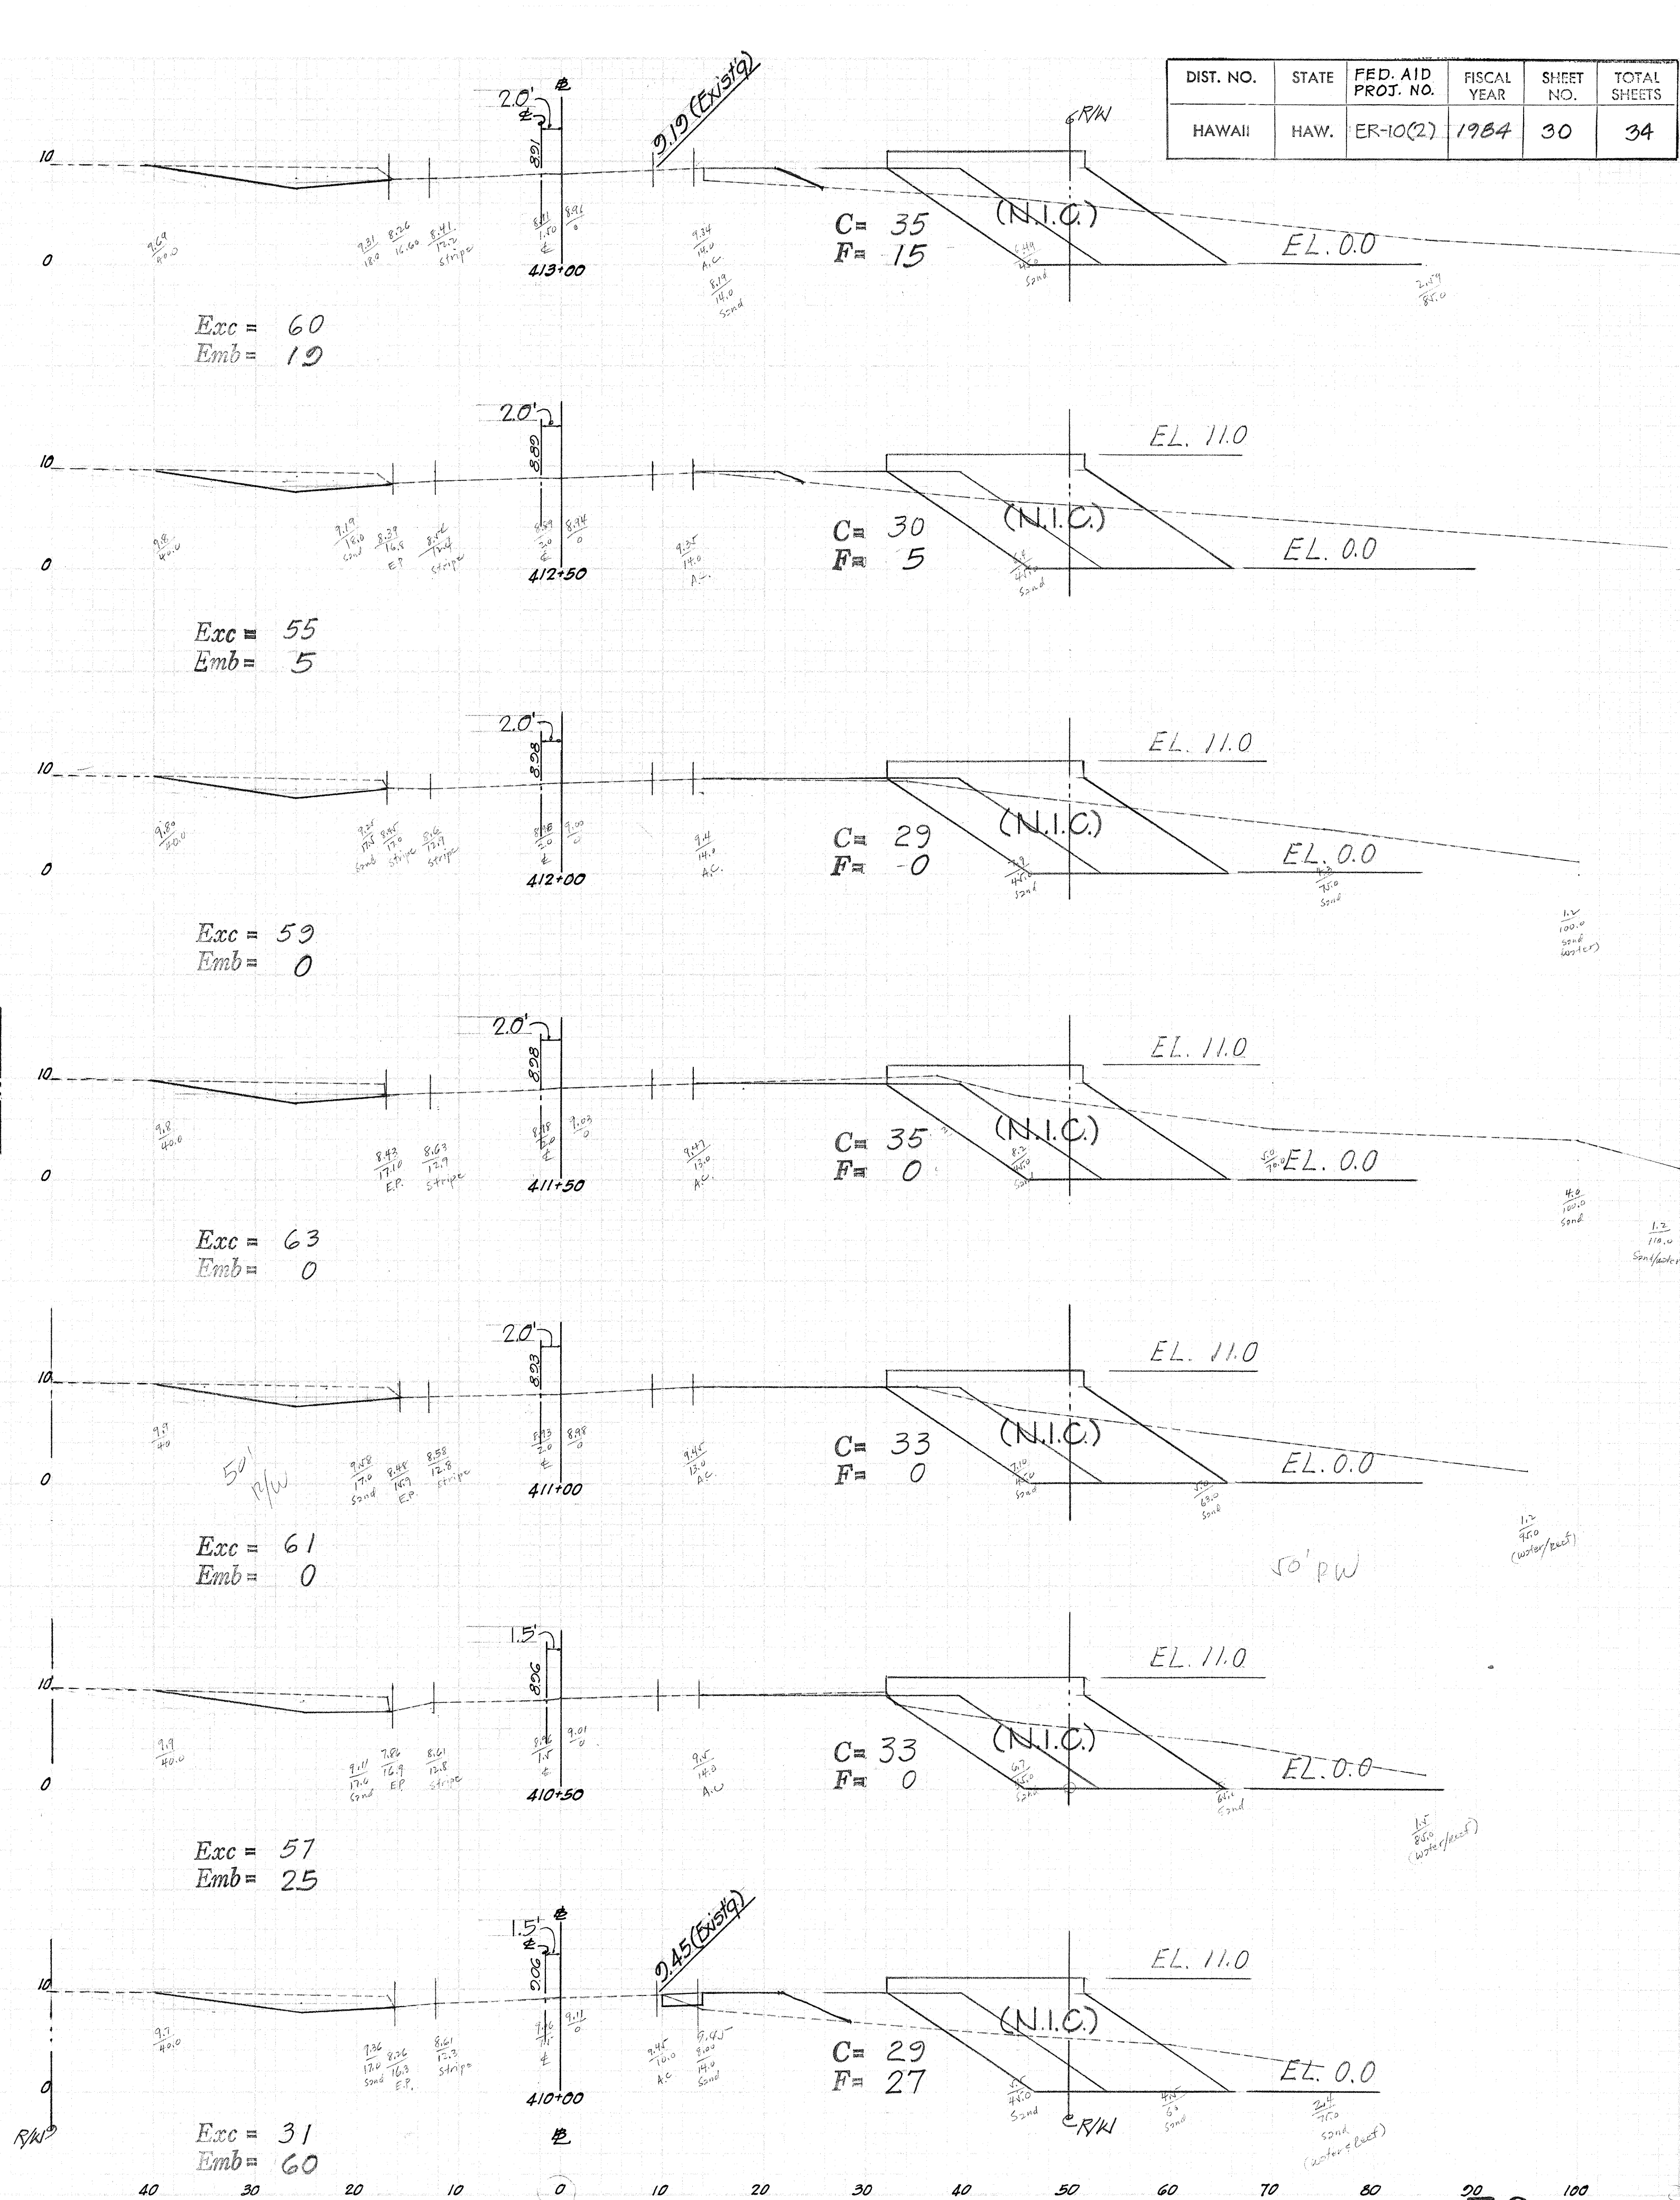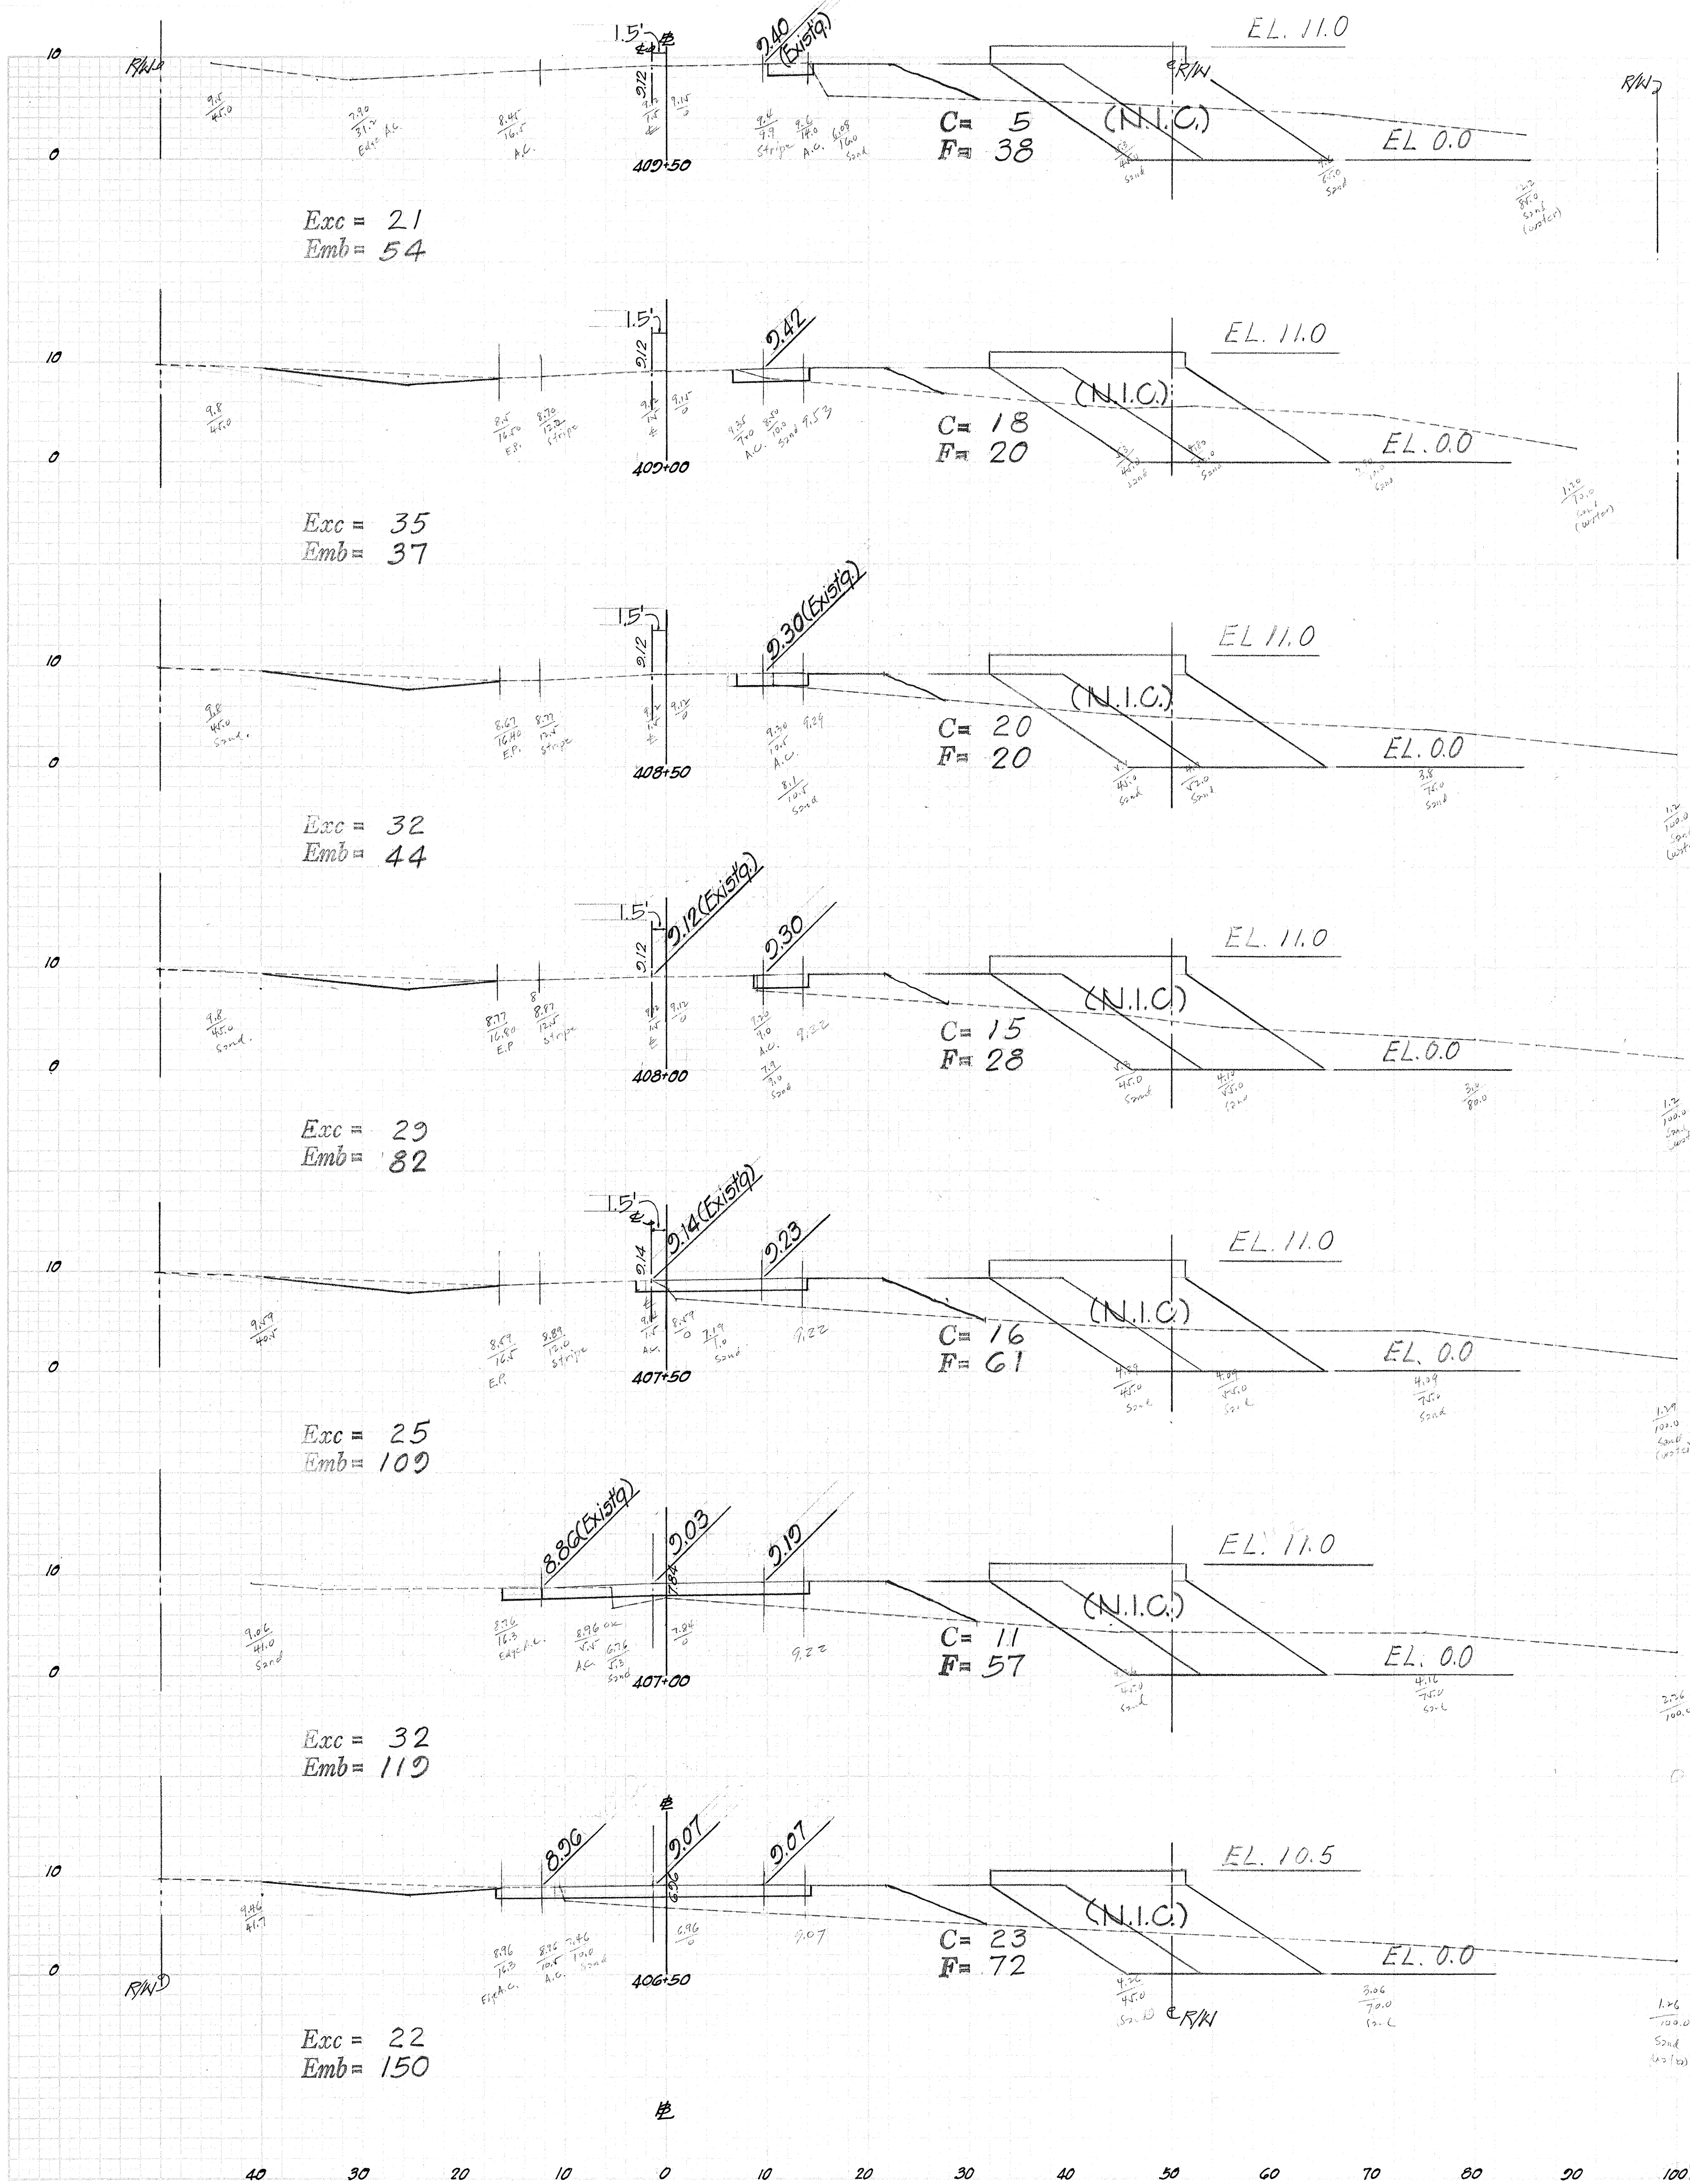



DIST. NO.	STATE	FED. AID PROJ. NO.	FISCAL YEAR	SHEET NO.	TOTAL SHEETS
HAWAII	HAW.	ER-10(2)	1984	31	34

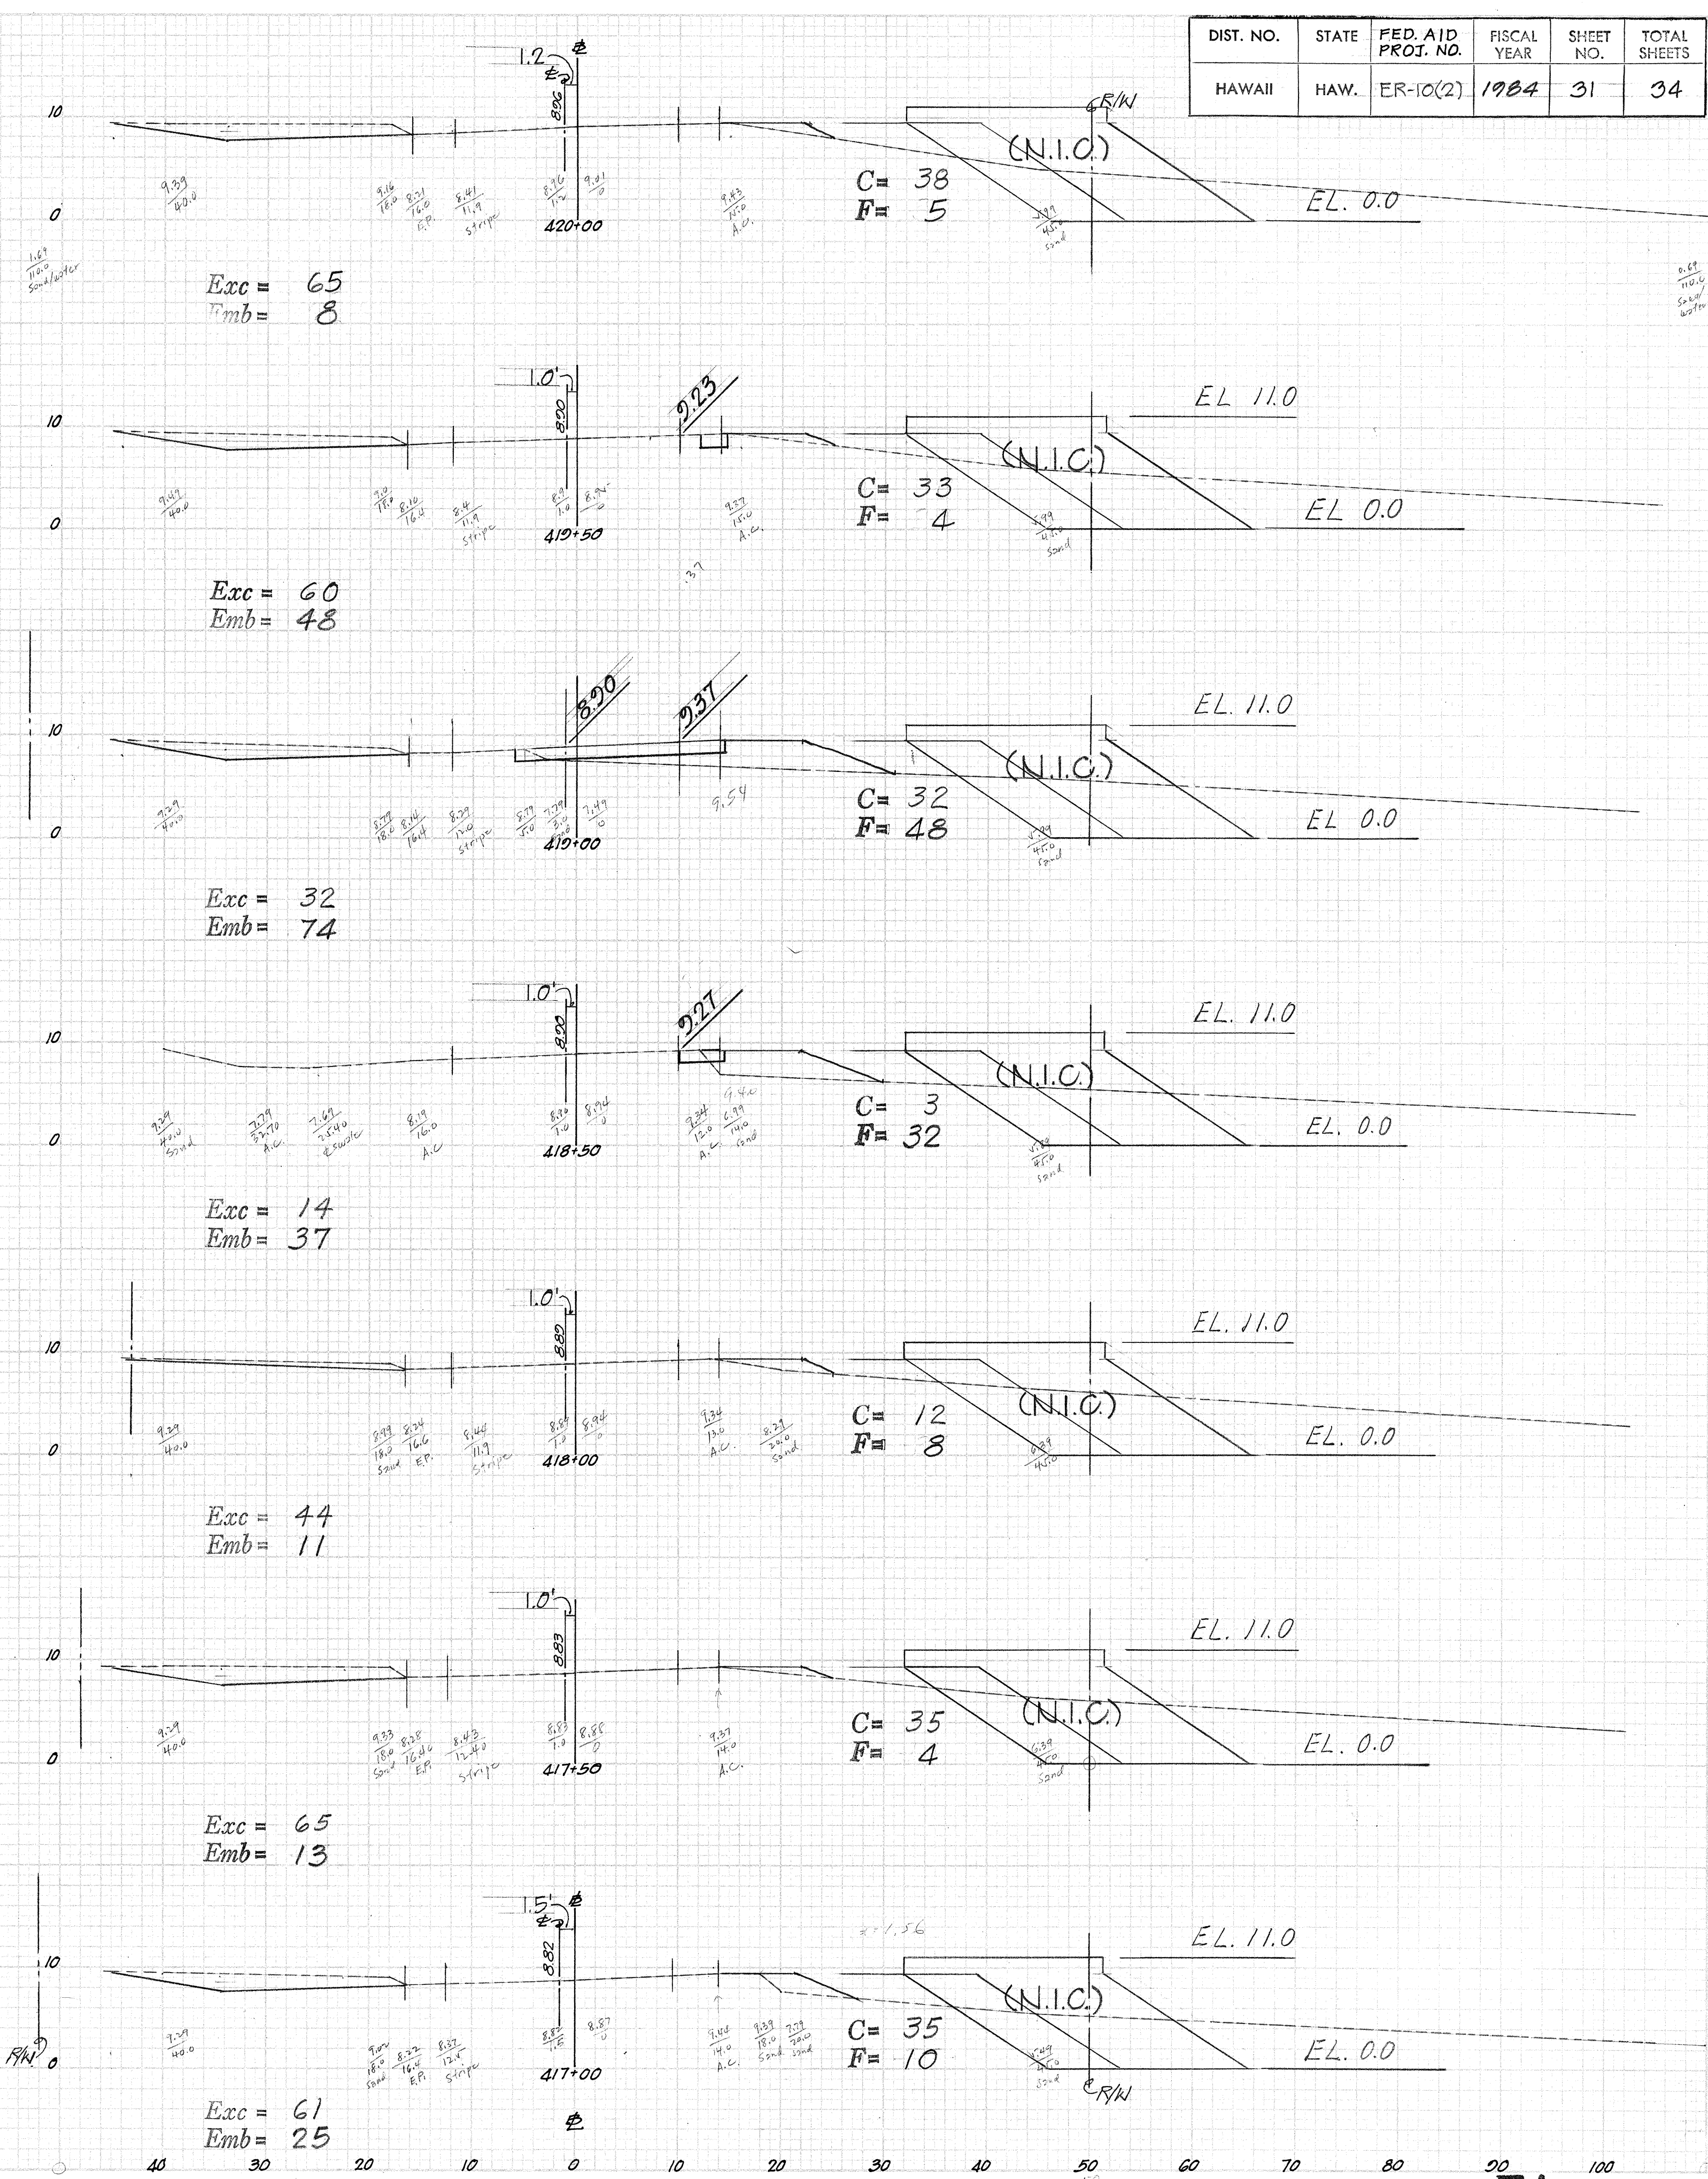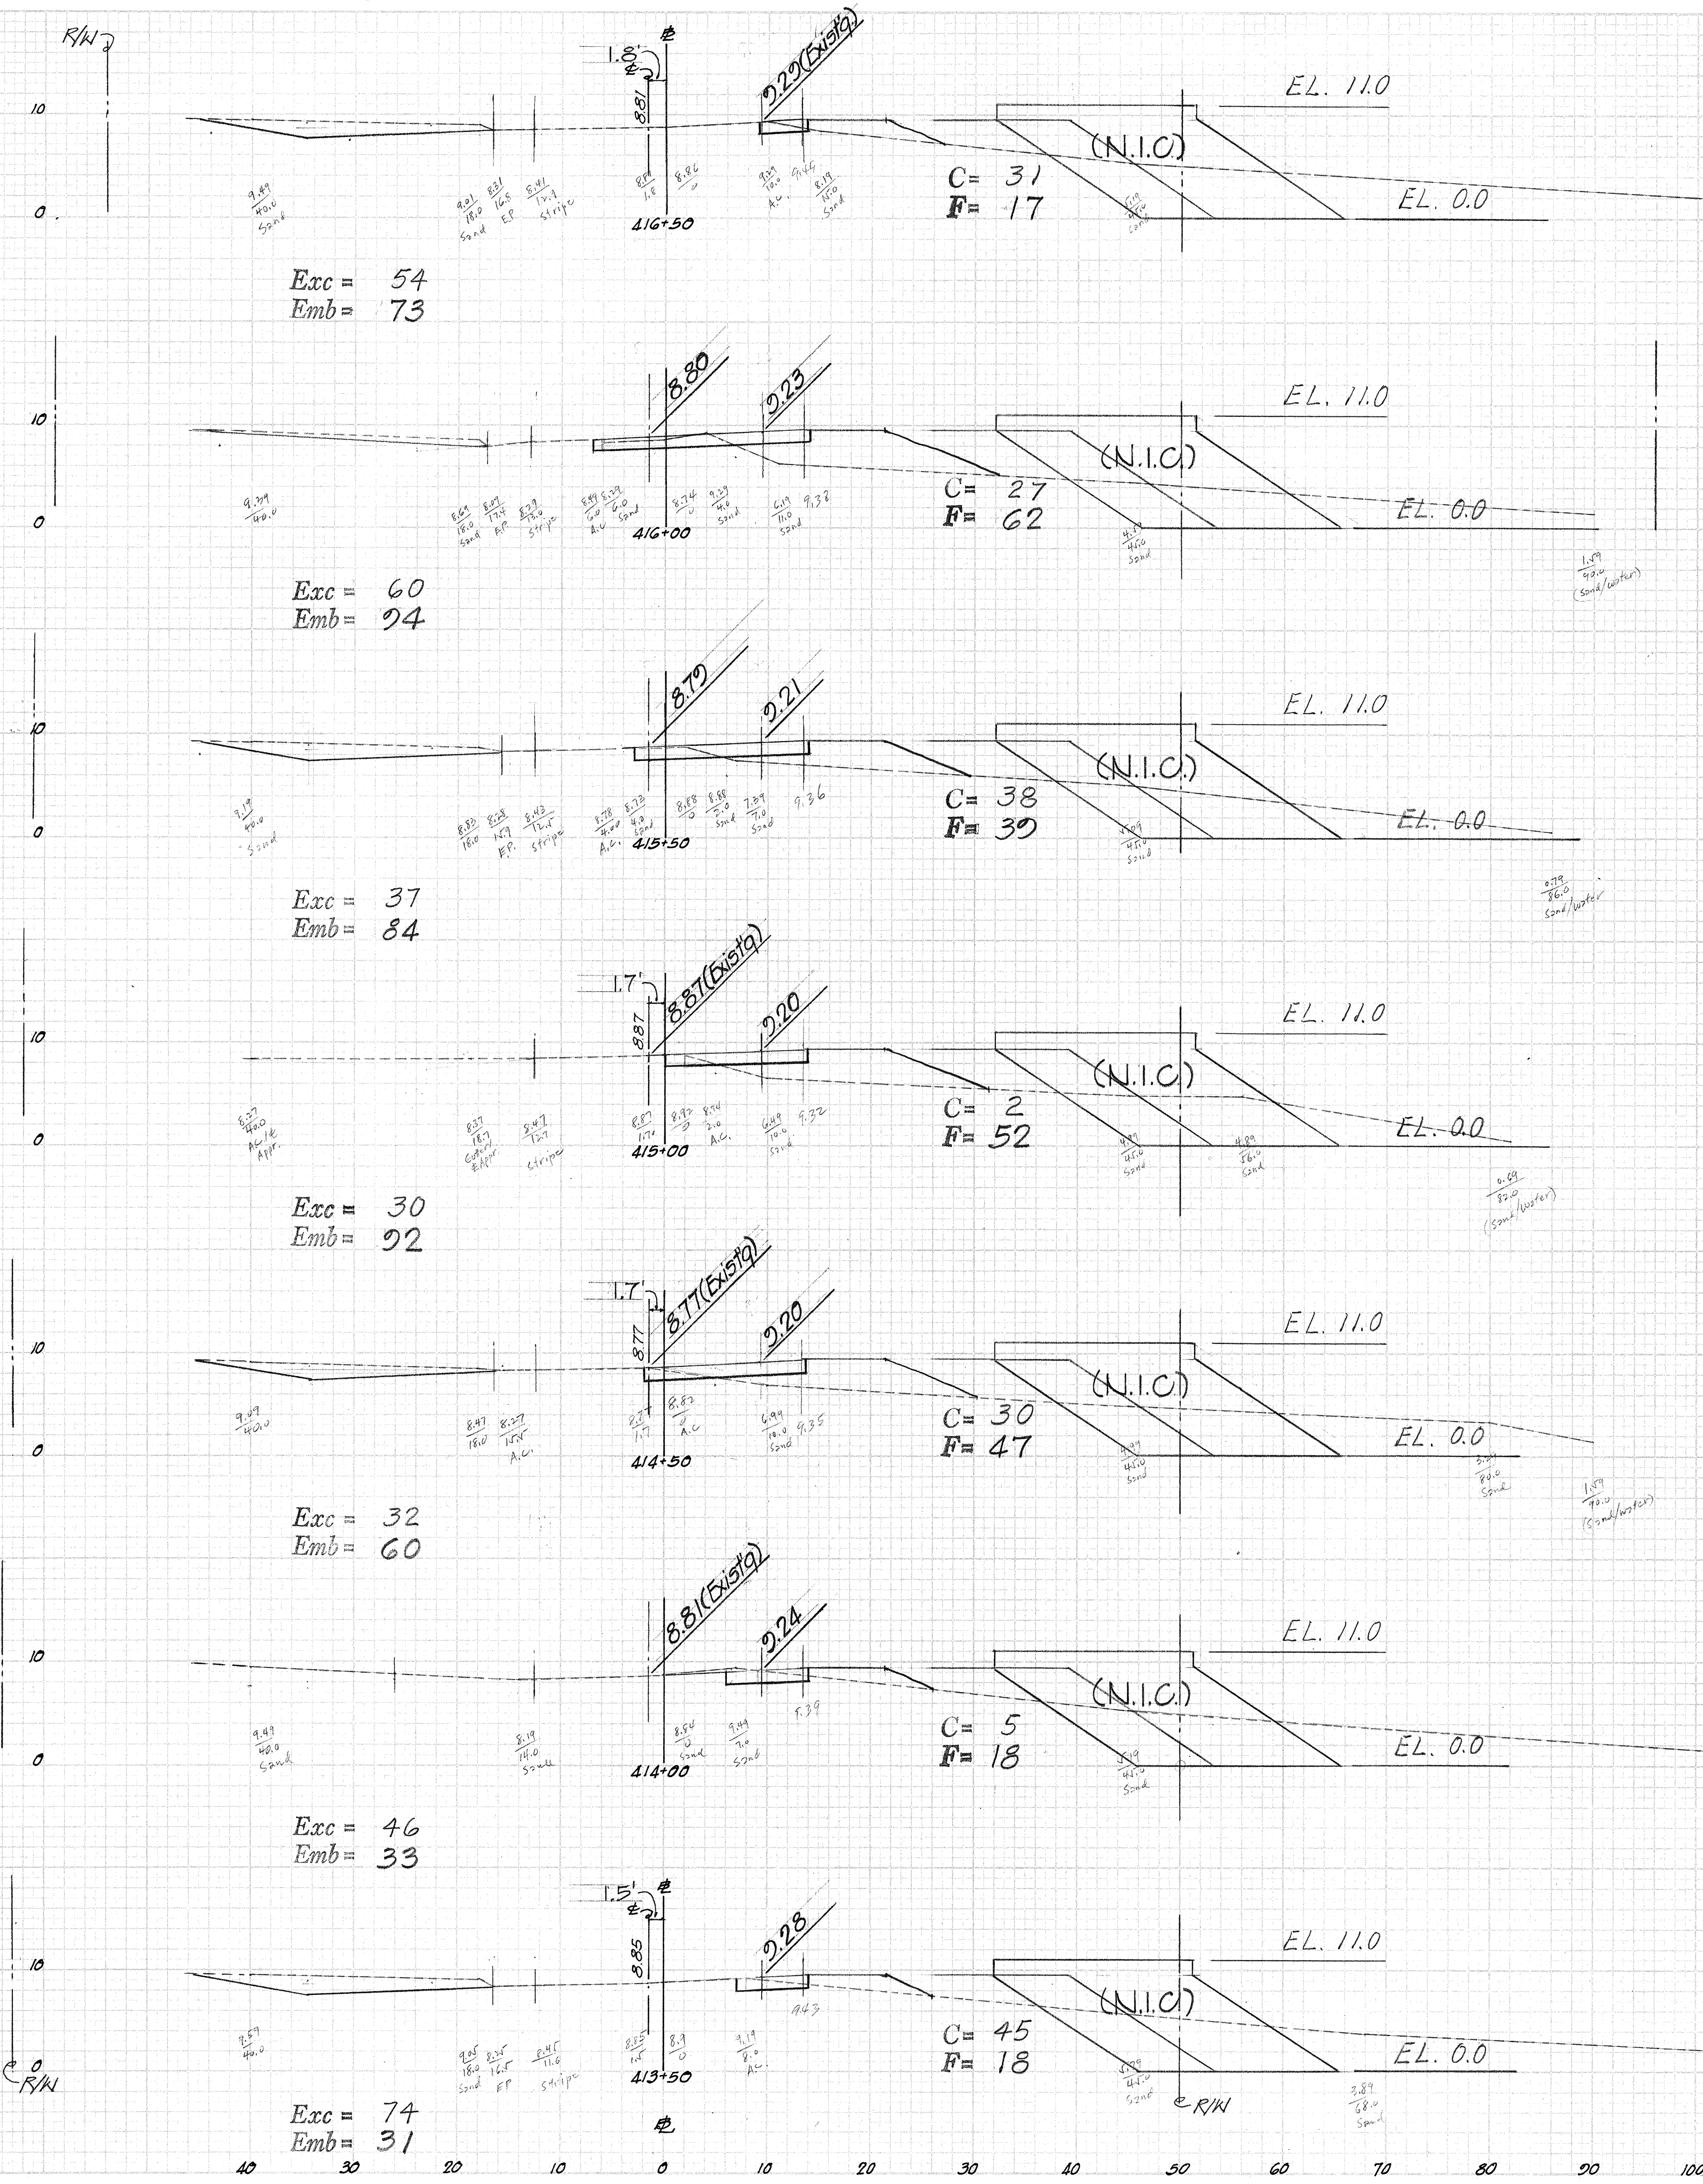

DIST. NO.	STATE	FED. AID PROJ. NO.	FISCAL YEAR	SHEET NO.	TOTAL SHEETS
HAWAII	HAW.	ER-10(2)	1964	32	34

FINAL	DATE
SURVEYED	
BY	
NO. _____	
ORIGINAL	
SURVEY	
NOTE BOOK	
TEMPLATE	
AREAS	
CHECKED	

DATE	
BY	
NO. _____	
ORIGINAL	
SURVEY	
NOTE BOOK	
TEMPLATE	
AREAS	
CHECKED	

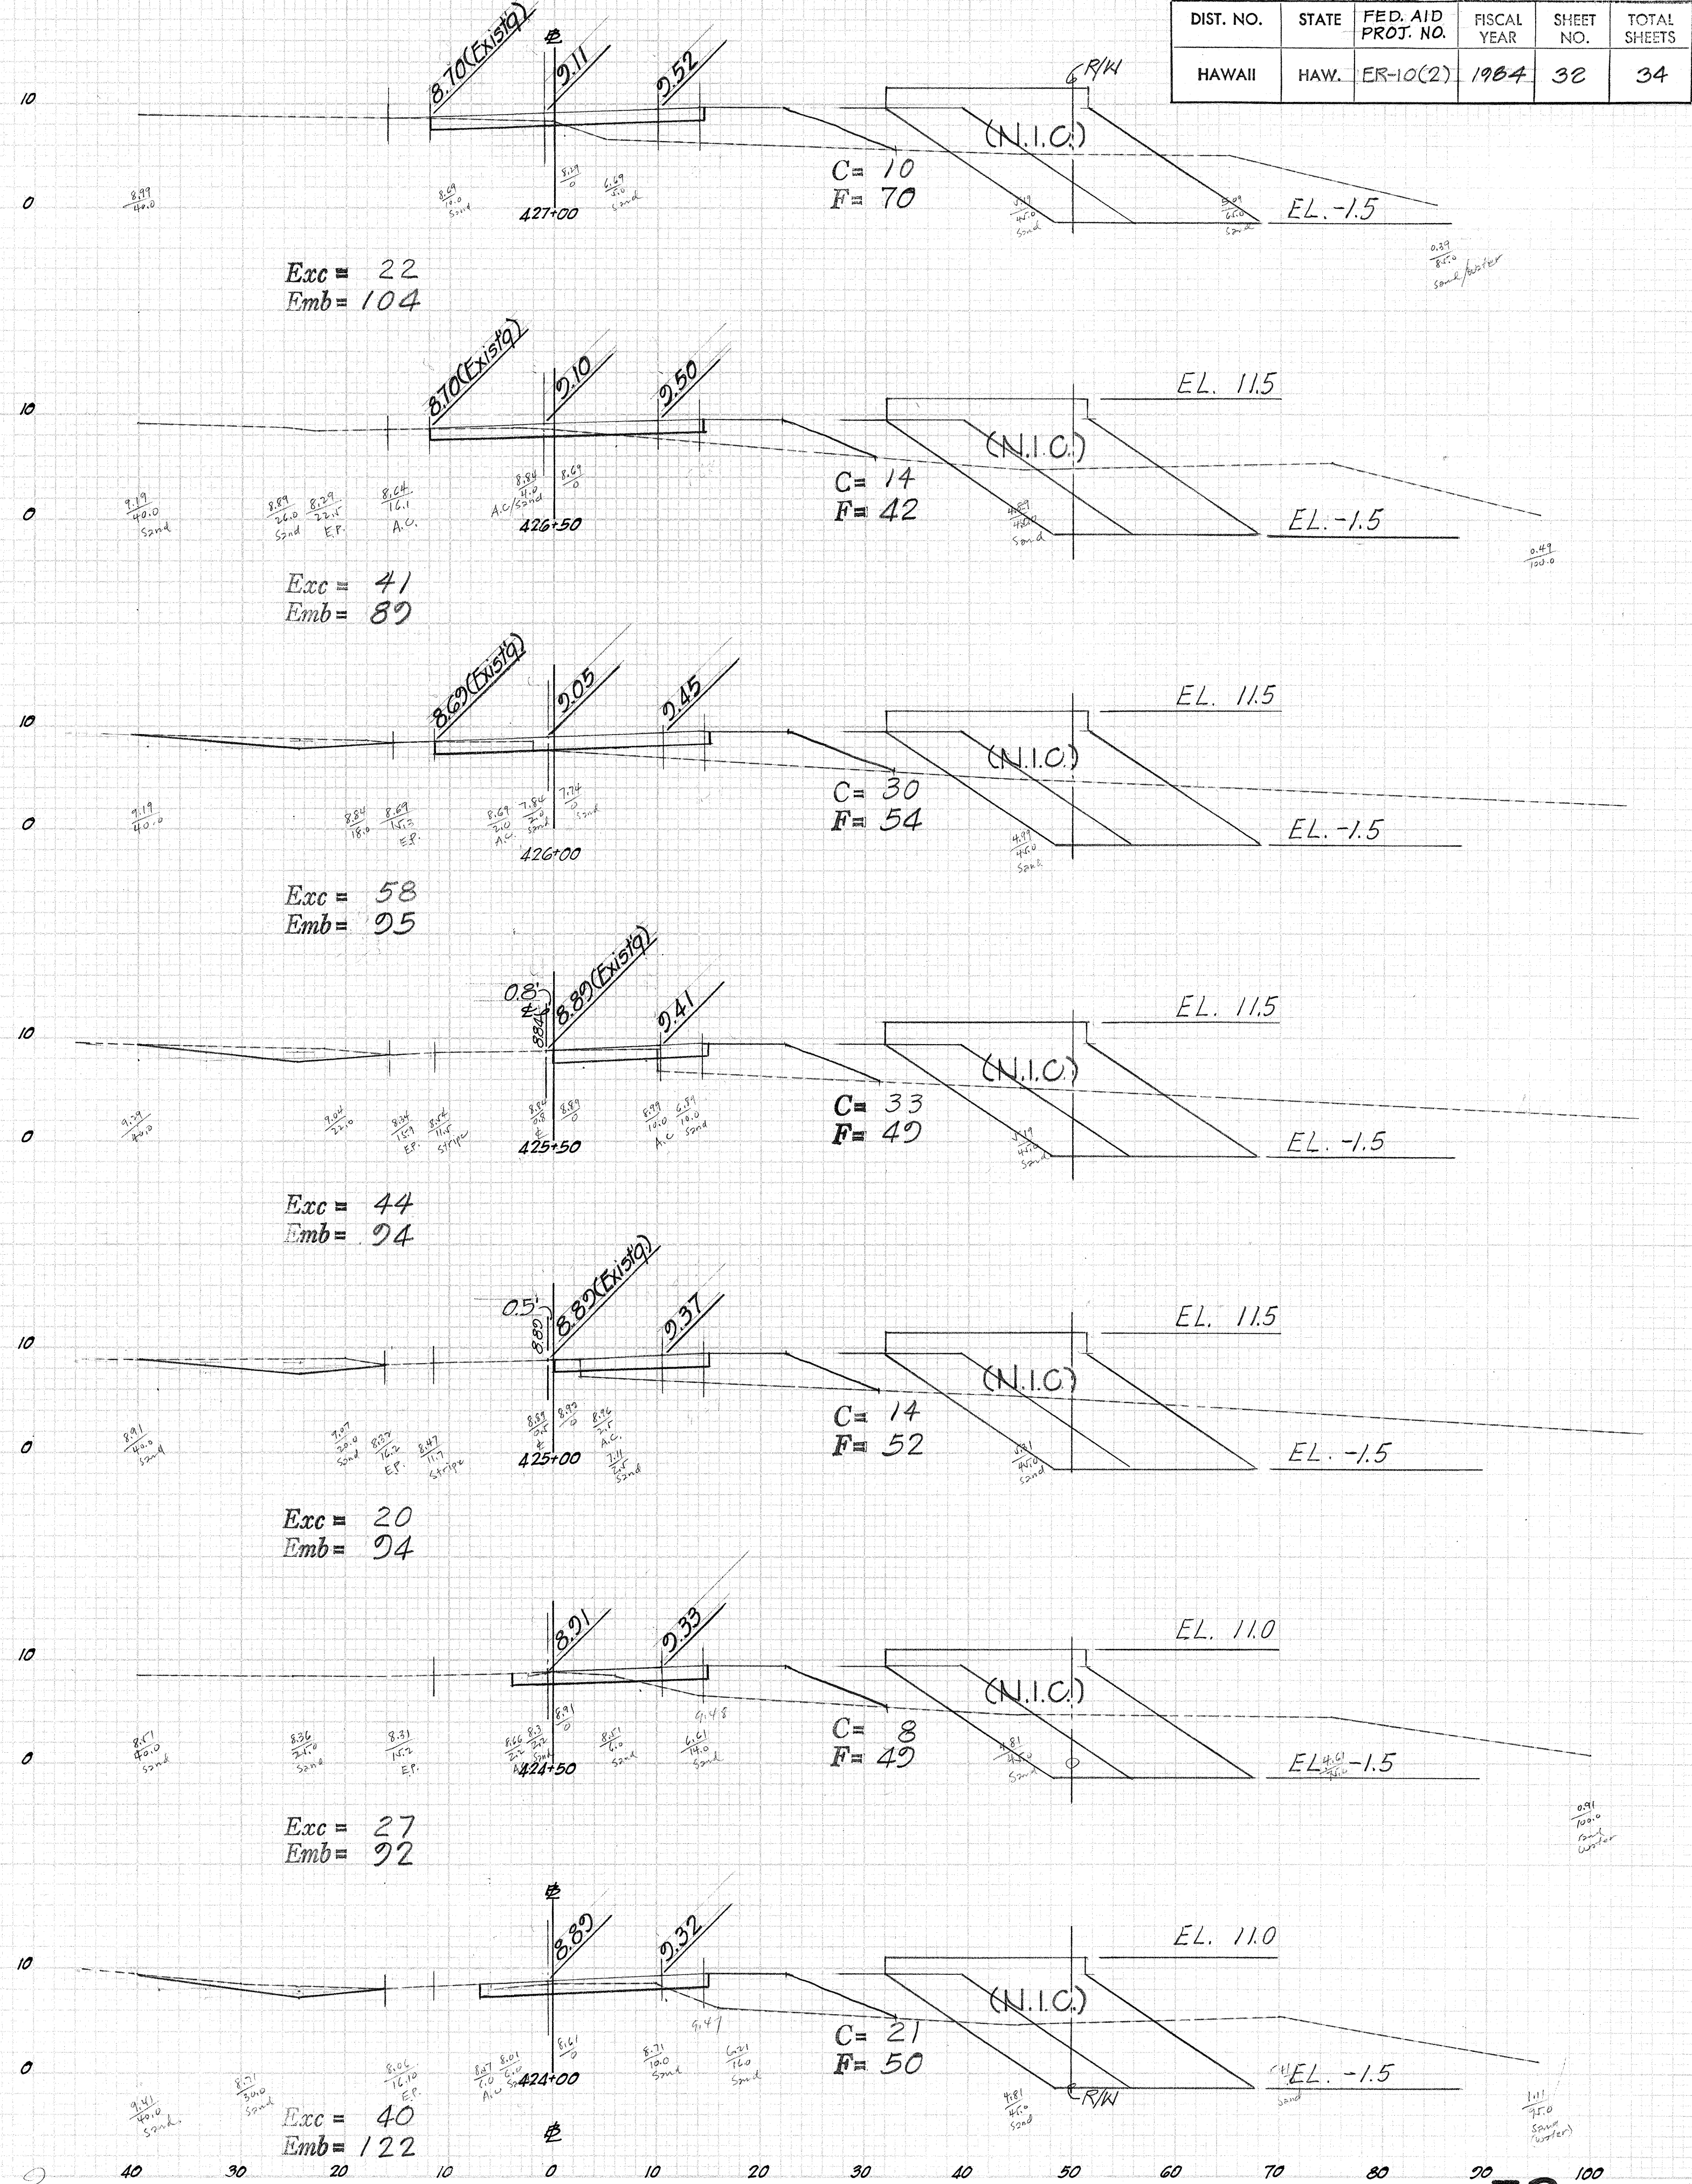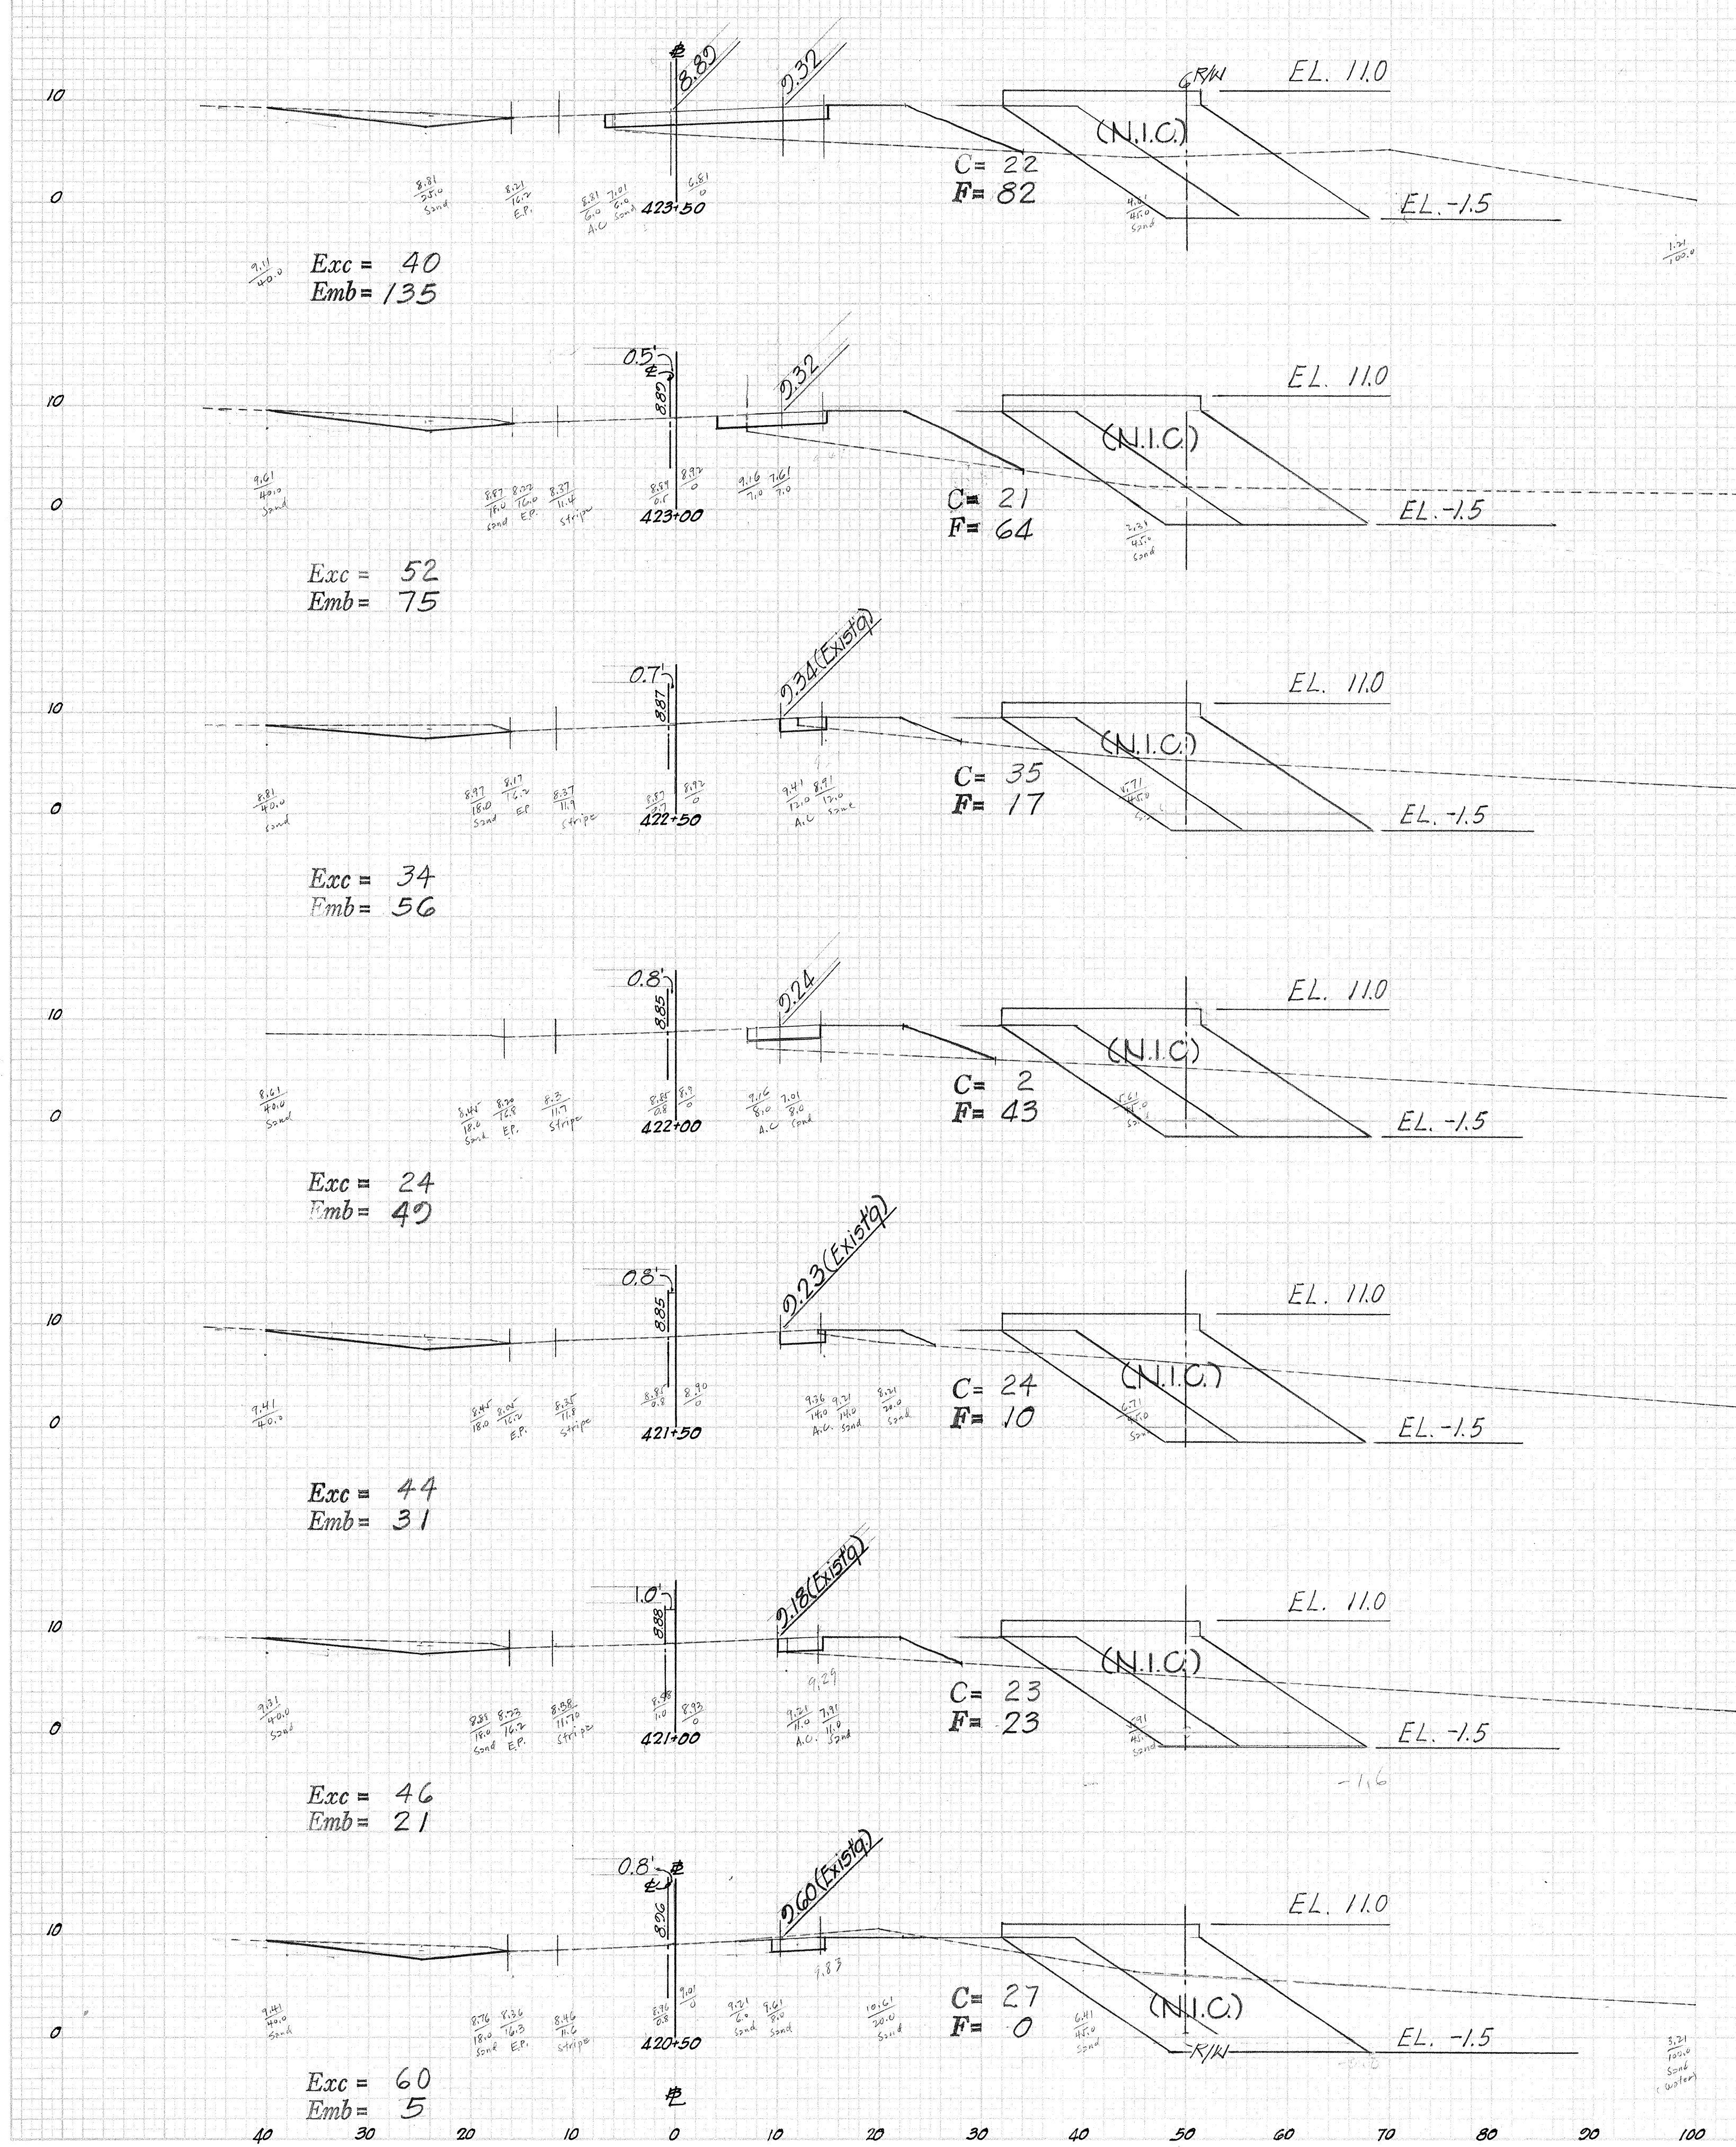

DIST. NO.	STATE	FED. AID PROJ. NO.	FISCAL YEAR	SHEET NO.	TOTAL SHEETS
HAWAII	HAW.	ER-10(2)	1984	34	34

DATE

BY

NO.

FINAL SURVEY

NOTES

NO. CHECKED

DATE

BY

NO.

ORIGINAL SURVEY

NOTES

NO. CHECKED

