


KAUAL DISTRICT	R. SIAROT	548-7537	June.1983
DESIGNED BY	P. S. & E. BY	PHONE	DATE

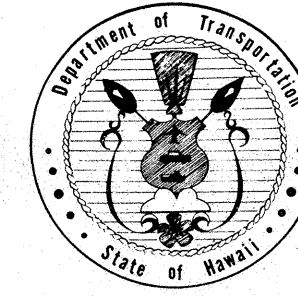


LAYOUT OF PROJECT
SCALE: 1"=1000'

The map illustrates the project layout for a highway section. Key features include:

- Project Limits:** The project begins at STA. 327+73 and ends at STA. 441+40, with a total length of 2.153 miles.
- Local Roads:** Akialoa Rd., Amakahi Rd., Alae Rd., Kala Rd., Ima Rd., Elepno Rd., Mohono Rd., Weine Rd., Pueo Rd., Aukuu Rd., and Manu Rd.
- Landmarks:** Kekaha Beach, Kekaha Sch., Elepno Cem., and various residential areas (K, F, H, A).
- Scale and Orientation:** The scale is 1 inch = 1000 feet. A north arrow is located in the upper right corner.

A map of the Hawaiian Islands. The islands are labeled: NIIHAU, KAUAI, OAHU, MOLOKAI, LANAI, MAUI, and HAWAII. A compass rose shows North (N) and South (S). The islands are arranged in a chain from northwest to southeast.

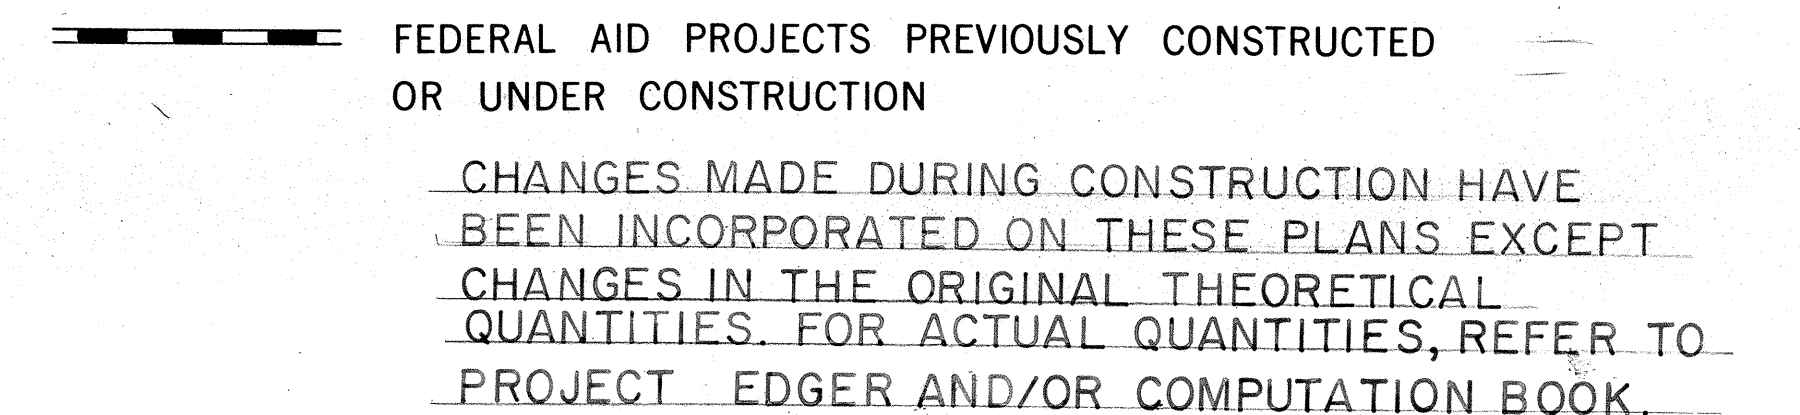

CURRENT ADT (1983) . . .	4,740
DESIGN ADT (2003) . . .	7,900
DHV	830
D	65/35
T	14%
V	45 M.P.H.

APPROVED: _____
Cheryl D. Poole 8/15/83

 DIR. OF TRANSPORTATION DATE