



FED. ROAD DIST. NO.	STATE	FED. AID PROJ. NO.	FISCAL YEAR	SHEET NO.	TOTAL SHEETS
HAWAII	HAW.	ER-10(2)	1984	2	34

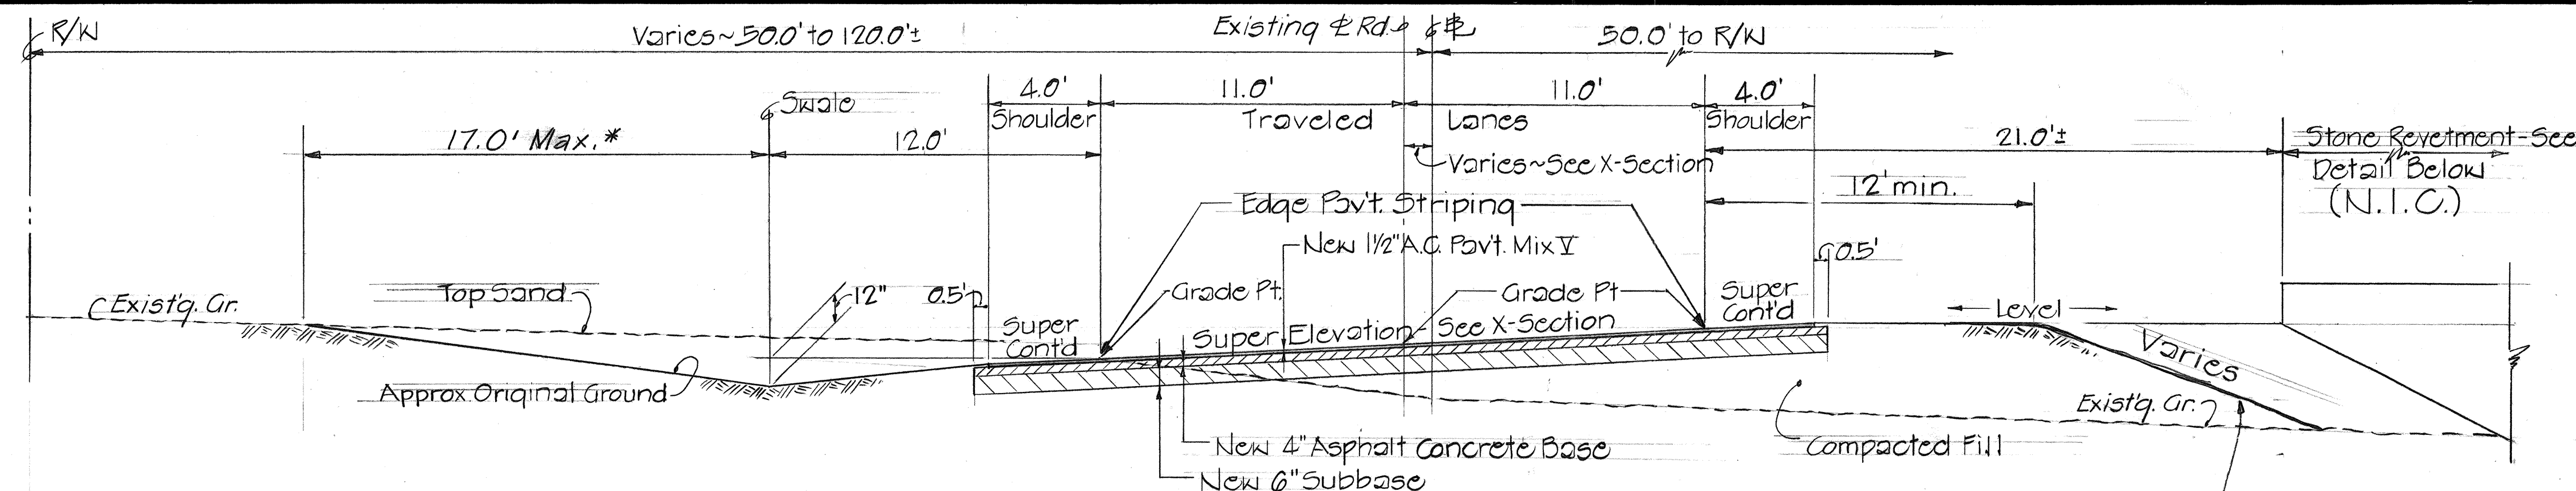


TYPICAL SECTION ~ NEW 22.0' TRAVELED LANES & 4.0' SHOULDERS
STA. 405+60± to STA. 406+50±, STA. 427+00± to STA. 428+60± & STA. 433+50± to STA. 434+65±

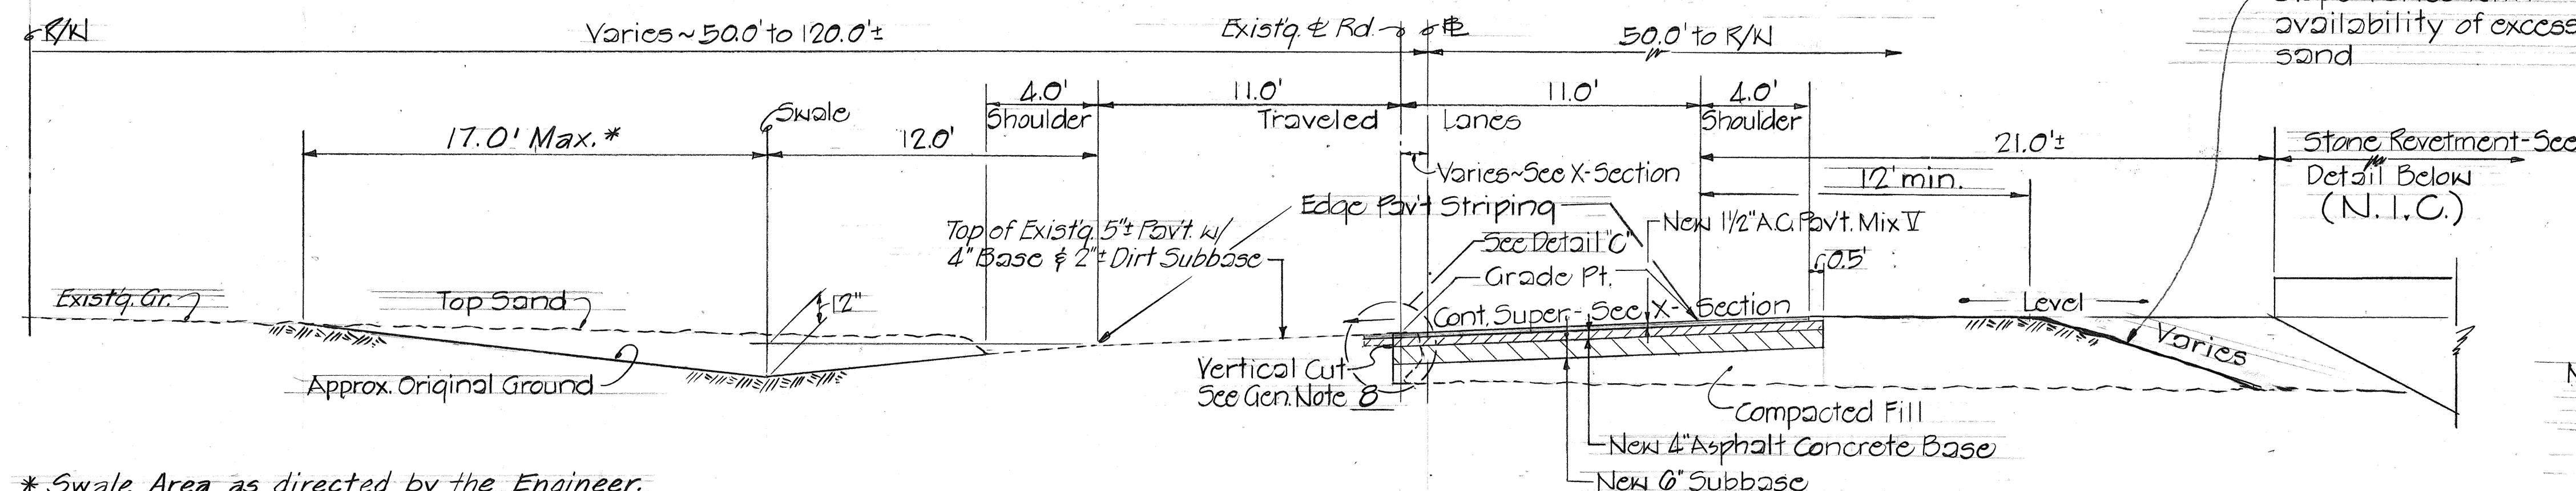

TYPICAL SECTION ~ MATCHING NEW PAVEMENT INTO EXISTING PAVEMENT


Scale: 1/4" = 1'-0"

* Swale Area as directed by the Engineer.
Grading to avoid Existing Trees.

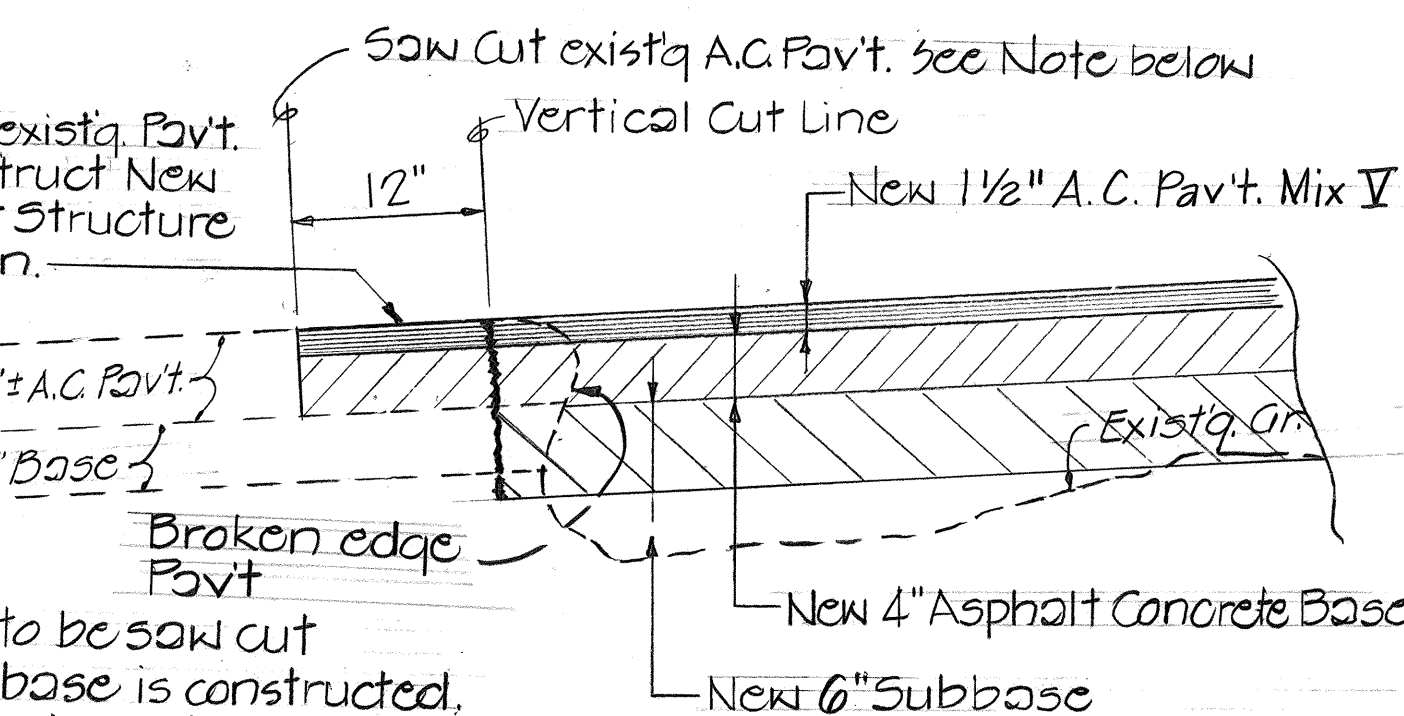

DETAIL "C" ~ MATCHING OF NEW PAVEMENT TO EXISTING PAVEMENT

Scale: 1" = 1'-0"

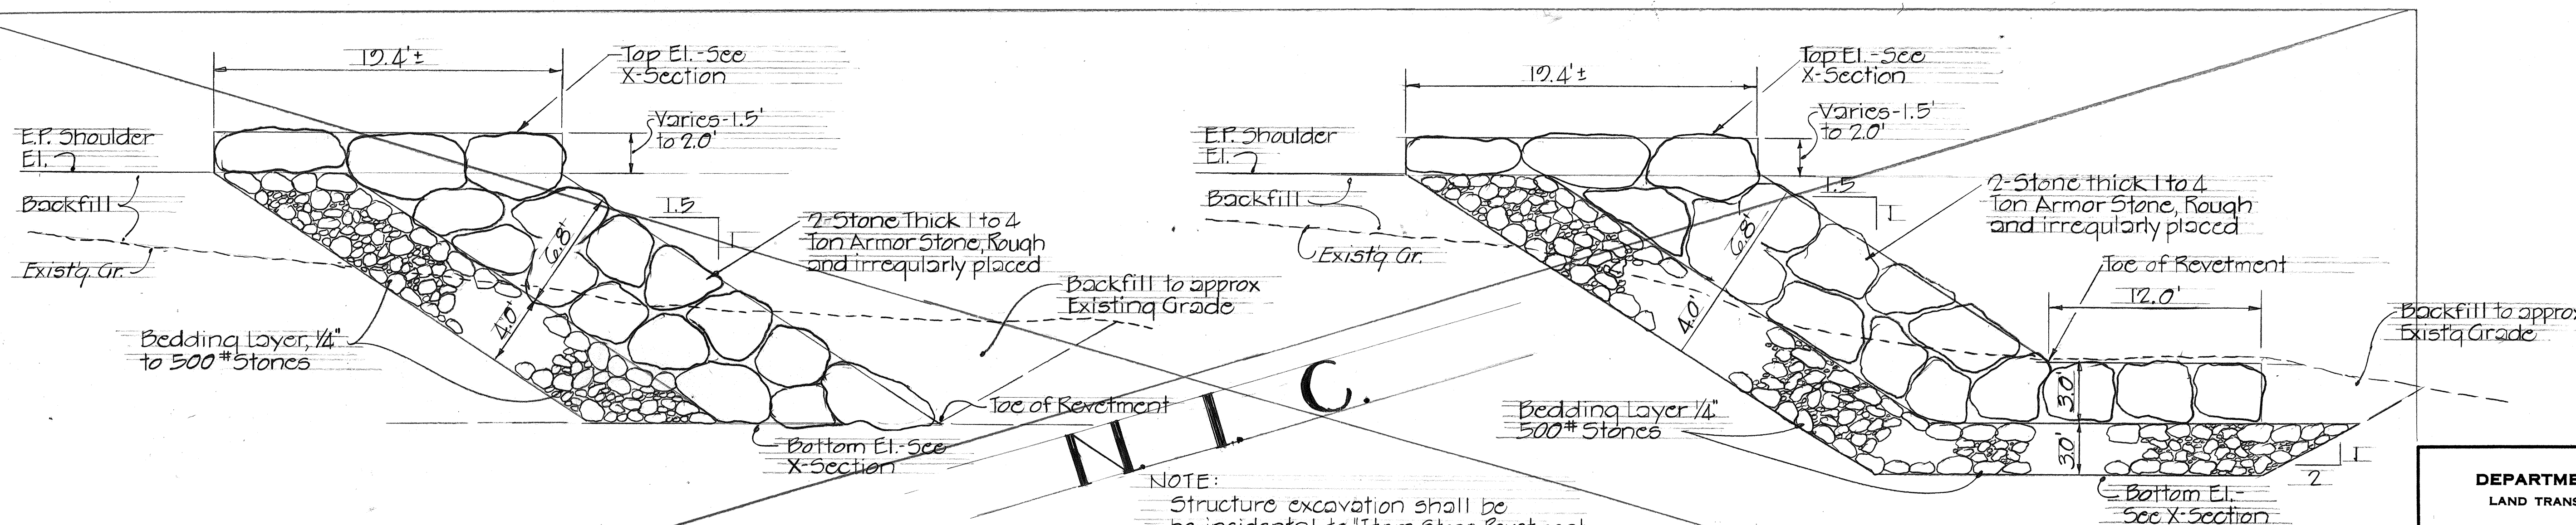

TYPICAL SECTION ~ STA. 402+50 TO STA. 432+00

TYPICAL SECTION ~ STA. 432+00 TO STA. 436+50

DETAILS ~ STONE REVETMENT Scale: 1" = 5'-0"

NOTE:
Structure excavation shall be
be incidental to "Item Stone Revetment."

STATE OF HAWAII DEPARTMENT OF TRANSPORTATION LAND TRANSPORTATION FACILITIES DIVISION
TYPICAL SECTIONS
KAUMUALII HIGHWAY RECONSTRUCTION & PROTECTIVE MEASURES AT KEKAHA (PHASE I) FEDERAL AID PROJECT NO. ER-10(2)
Scale: As Shown Date: Mar. 1983
SHEET NO. 1 OF 1 SHEETS