


FED. ROAD DIST. NO.	STATE	PROJ. NO.	FISCAL YEAR	SHEET NO.	TOTAL SHEETS
HAWAII	HAW.	50C-01-85	1985	4	13

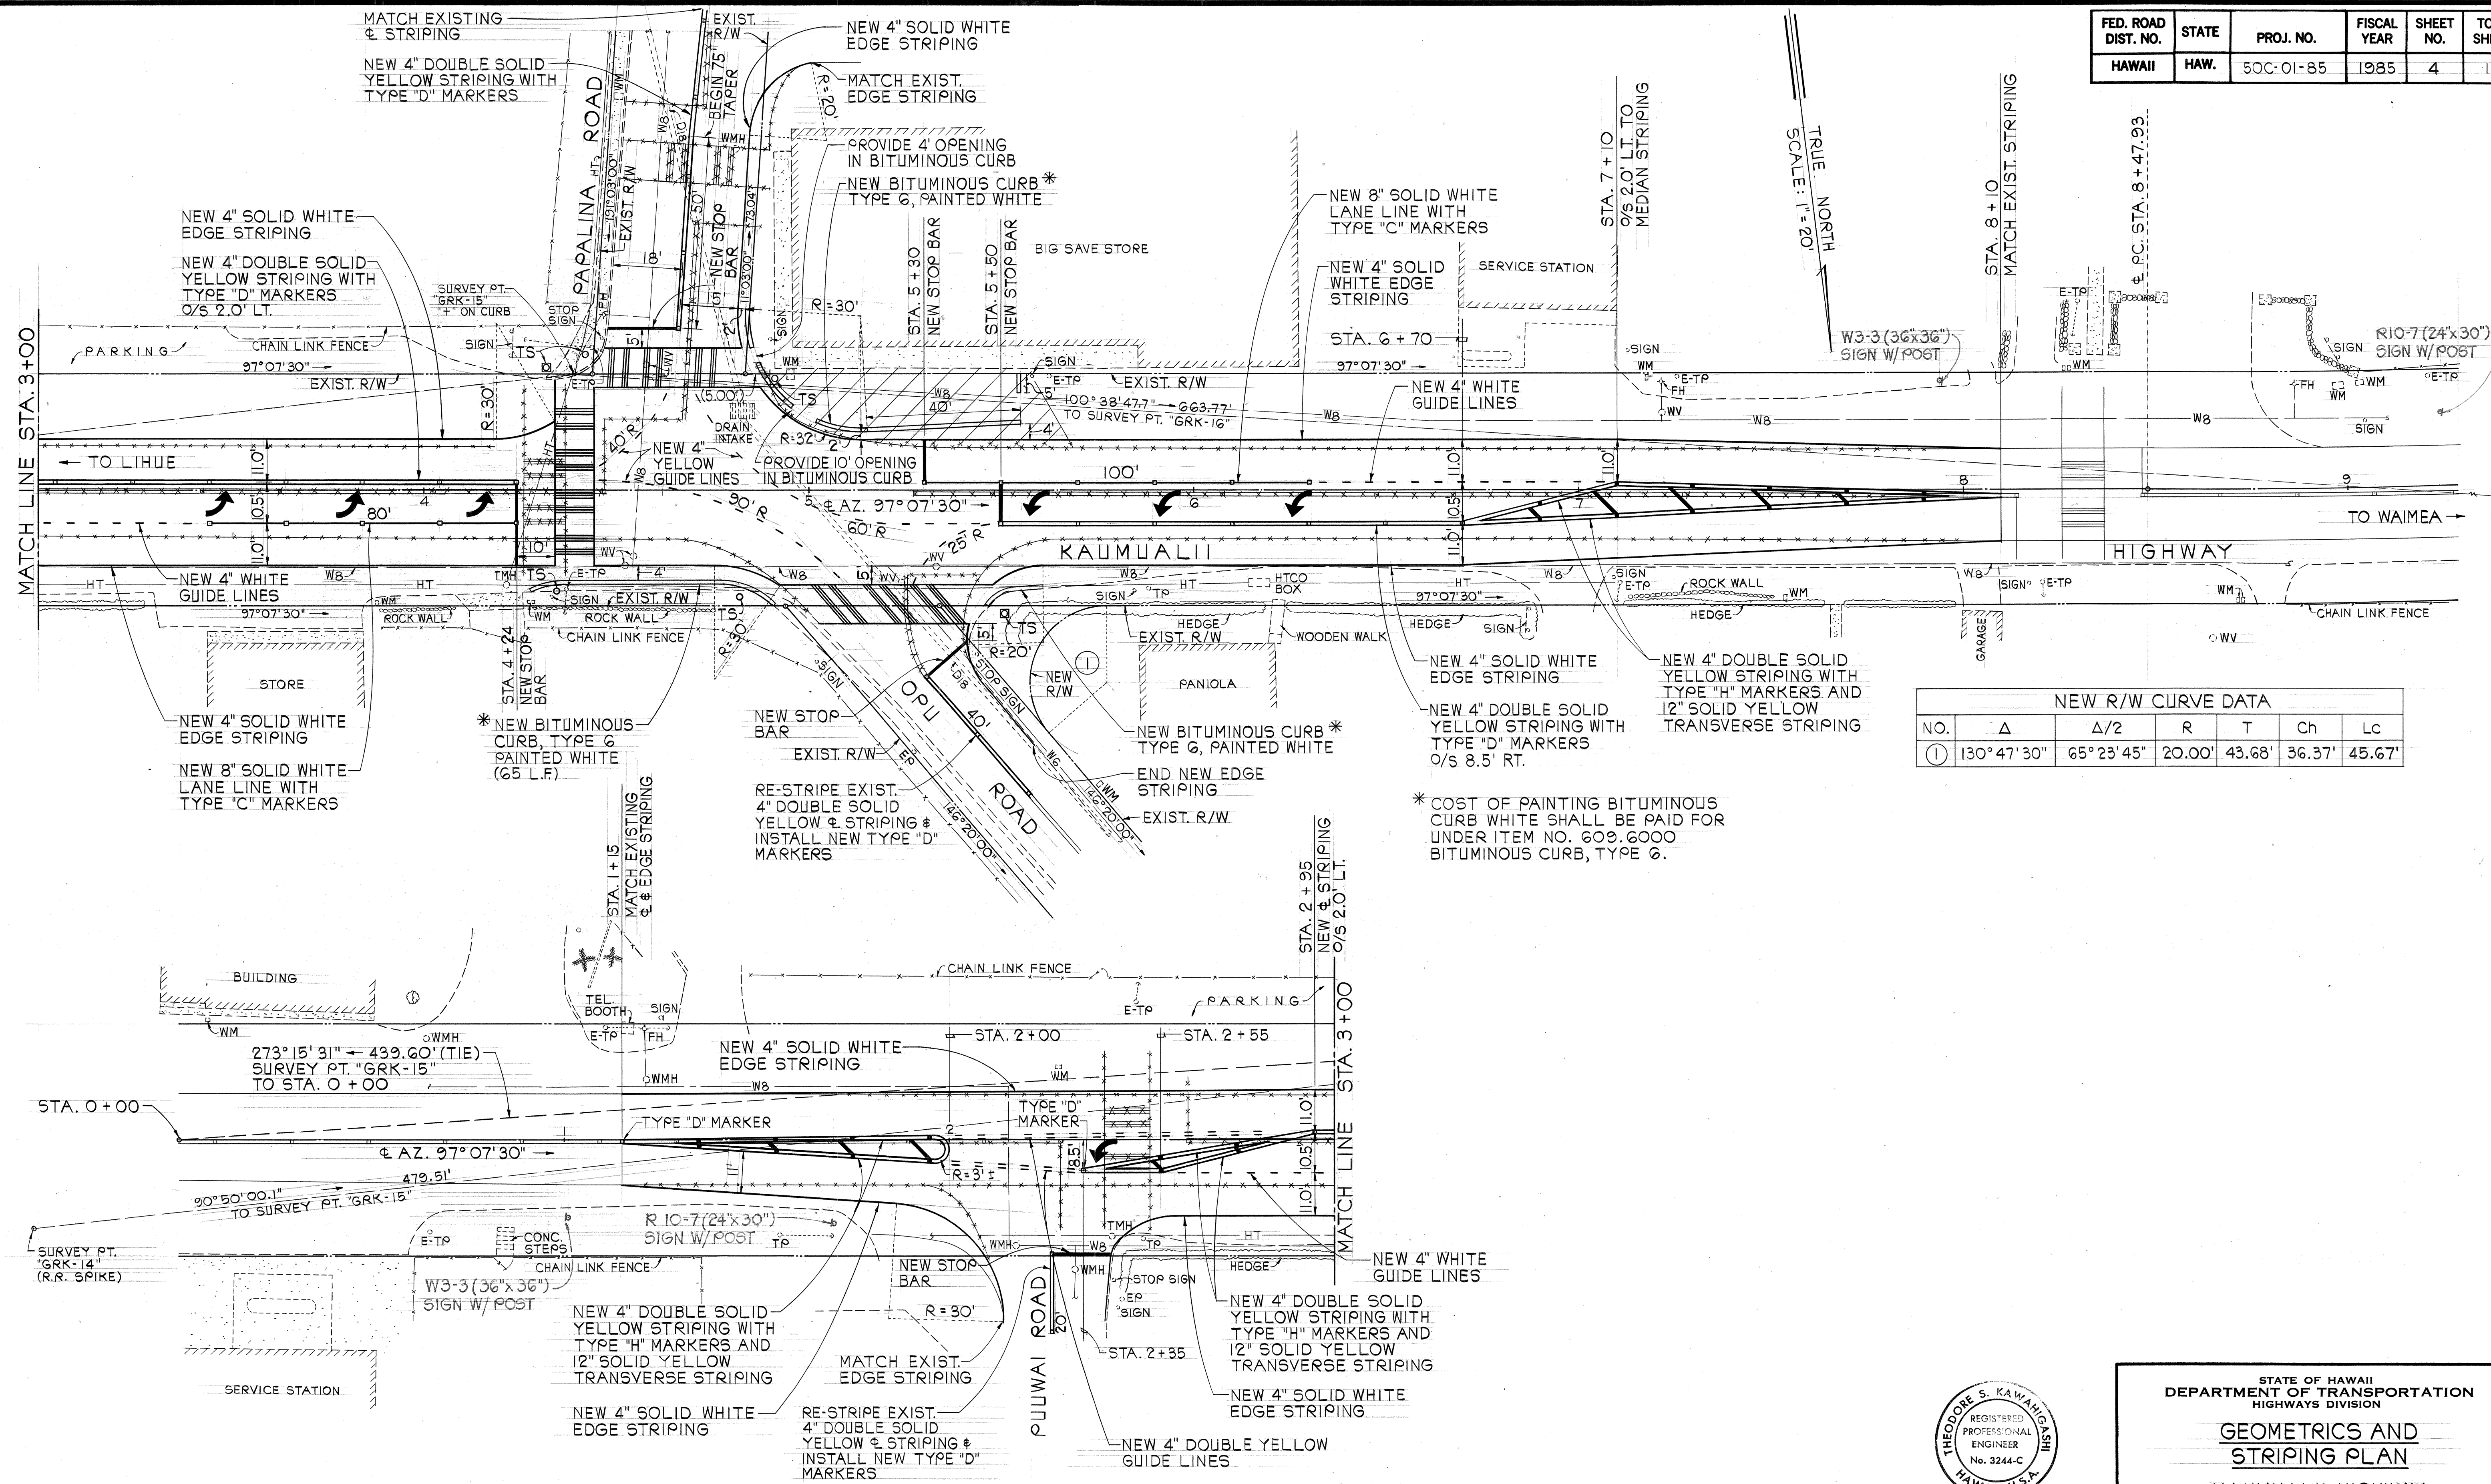

NEW R/W CURVE DATA					
NO.	Δ	Δ/2	R	T	Lc
①	130° 47' 30"	65° 23' 45"	20.00'	43.68'	36.37'

* COST OF PAINTING BITUMINOUS CURB WHITE SHALL BE PAID FOR UNDER ITEM NO. 603.6000 BITUMINOUS CURB, TYPE 6.

DATE	
SURVEY PLOTTED BY	
DRAWN BY	
DESIGNED BY	
CHECKED BY	
ORIGINAL PLAN	
NOTE BOOK	

THEODORE S. KAWAHIGASHI
REGISTERED PROFESSIONAL ENGINEER
No. 3244-C
HAWAII, U.S.A.

THIS WORK WAS PREPARED BY ME OR UNDER MY SUPERVISION

Theodore S. Kawahigashi
Signature

STATE OF HAWAII
DEPARTMENT OF TRANSPORTATION
HIGHWAYS DIVISION

GEOMETRICS AND STRIPING PLAN

KAUMUALII HIGHWAY
TRAFFIC SIGNALS AT
PAPALINA ROAD
PROJ. NO. 50C-01-85

SCALE: AS SHOWN DATE: 10-25-84

SHEET NO. 1 OF 1 SHEETS