	INDEX TO DRAWINGS
SHEET NO.	DESCRIPTION
1	TITLE SHEET
2	LEGEND AND NOTES
3	TRAFFIC CONTROL PLAN
4	GEOMETRICS AND STRIPING PLAN
5	TRAFFIC SIGNAL PLAN
6-19	STANDARD DETAILS



STATE OF HAWAII



## DEPARTMENT OF TRANSPORTATION HIGHWAYS DIVISION


HONOLULU, HAWAII

"AS-BUILT"


PLANS FOR


## KAUMUALII HIGHWAY TRAFFIC SIGNALS AT PAPALINA ROAD PROJECT NO. 50C-01-85

DISTRICT OF KOLOA ISLAND OF KAUAI

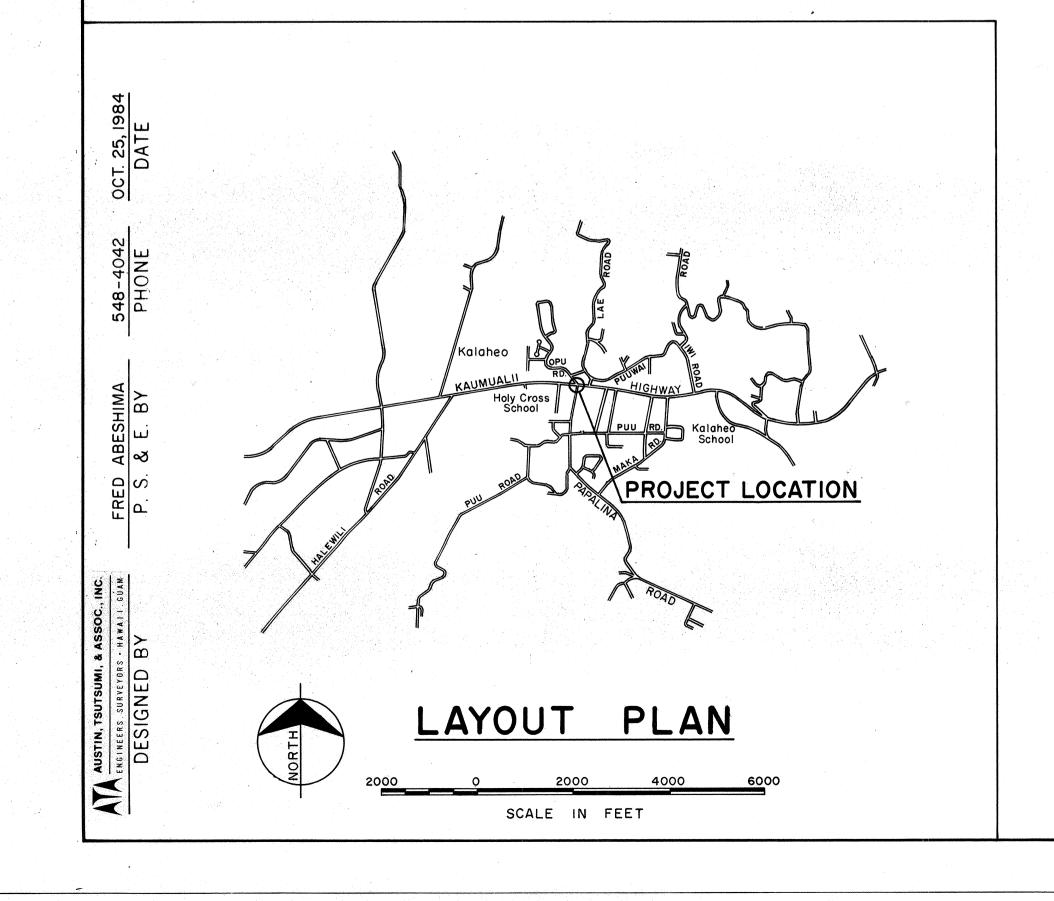

FED. ROAD DIST. NO. STATE PROJ. NO. FISCAL YEAR HAWAII HAW. 50C-01-85 1985

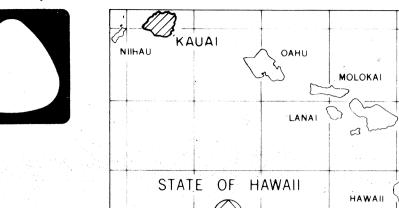

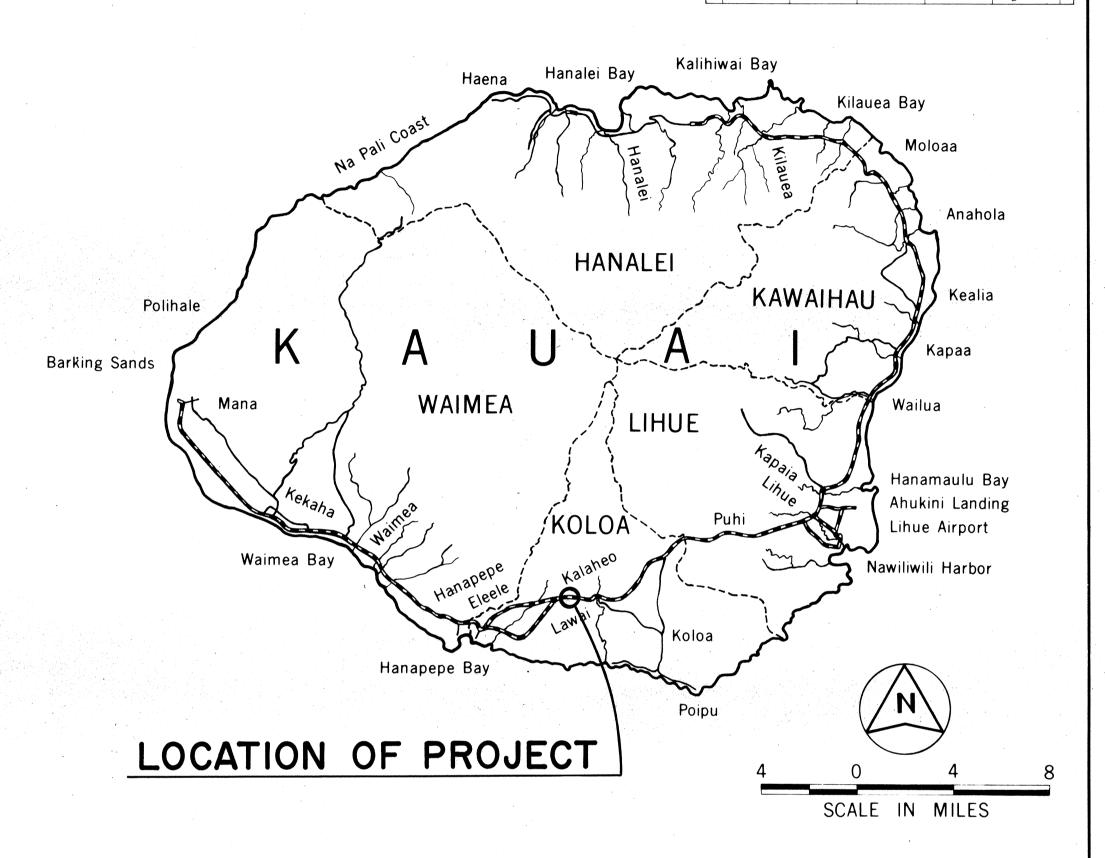

FEDERAL AID PROJECTS PREVIOUSLY CONSTRUCTED
OR UNDER CONSTRUCTION

CHANGES MADE DURING CONSTRUCTION HAVE
BEEN INCORPORATED ON THESE PLANS EXCEPT
CHANGES IN THE ORIGINAL THEORETICAL
QUANTITIES. FOR ACTUAL QUANTITIES, REFER TO
PROJECT LEDGER AND/OR COMPUTATION BOOK.

RESIDENT ZNGINEER DATE

DEPARTMENT OF TRANSPORTATION
STATE OF HAWAII

APPROVED:

Chey B. Joan 18/84
DIR. OF TRANSPORTATION DATE