r A	
	INDEX TO DRAWINGS
SHEET NO.	DESCRIPTION
	TITLE SHEET
2	PLAN, TYPICAL SECTION AND GENERAL NOTES
3	STANDARD DETAILS - CONSTRUCTION SIGNS
₩.	
	-

Mar. 1985 DATE

548-7490 PHONE

KAUAI DISTRICT
DESIGNED BY



STATE OF HAWAII

DEPARTMENT OF TRANSPORTATION HIGHWAYS DIVISION

"AS-BUILT"


PLANS FOR

KAUMUALII HIGHWAY, SHOULDER IMPROVEMENTS AT KALAHEO TO HALEWILI ROAD

PROJECT NO. 50C-02-85

DISTRICT OF KOLOA


ISLAND OF KAUAI

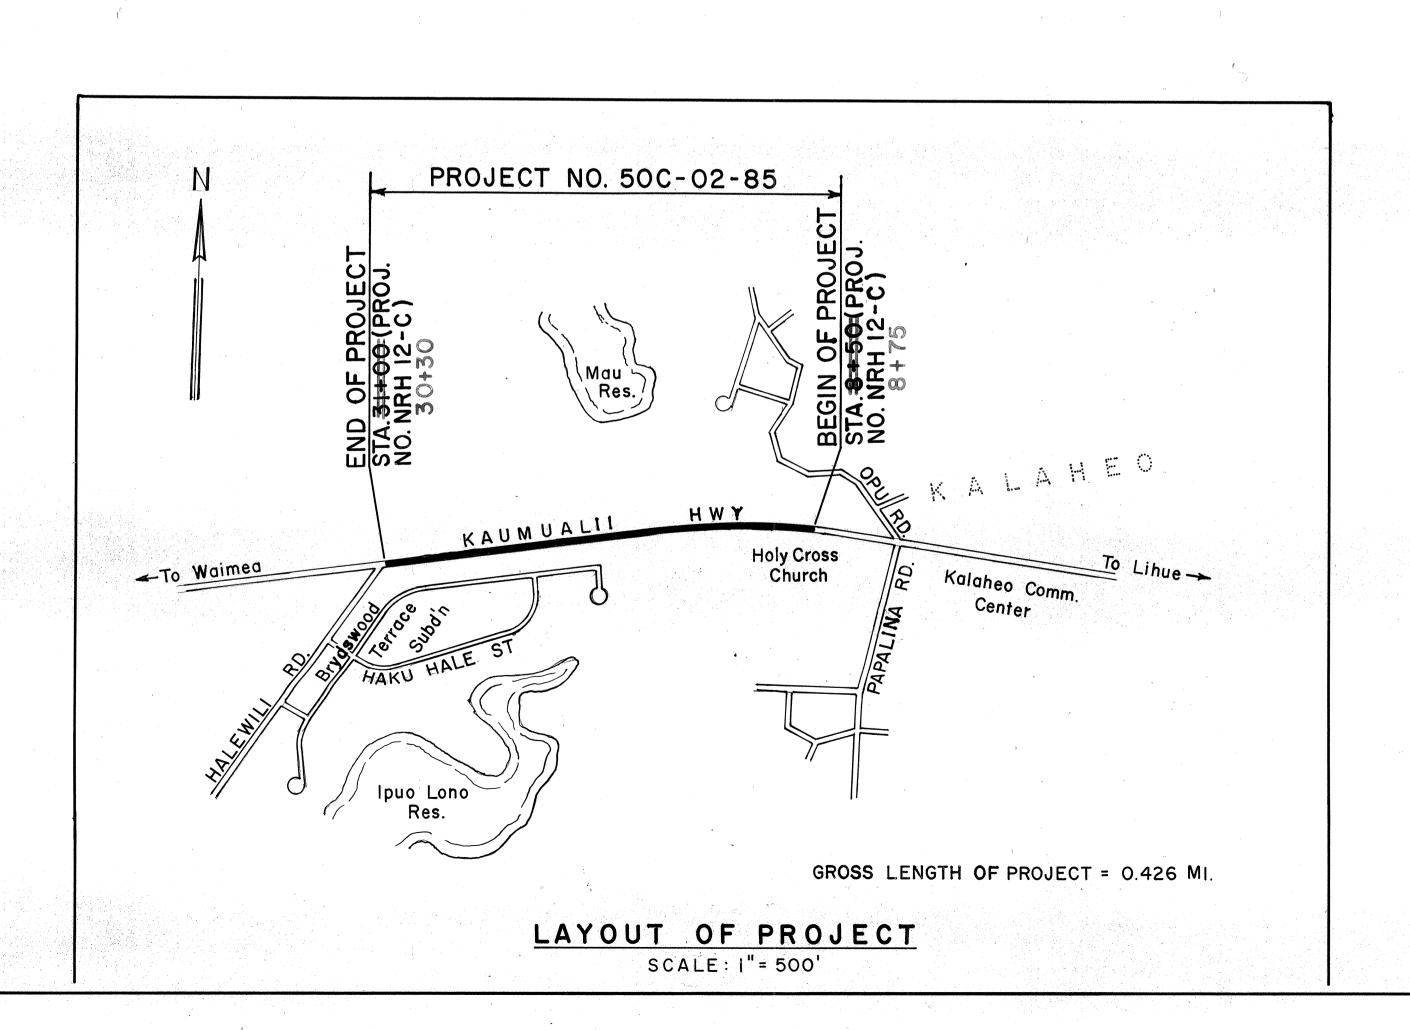


FED. ROAD DIST. NO. STATE PROJ. NO. FISCAL SHEET TOTAL YEAR NO. SHEETS

HAWAII HAW. 50C-02-85 1985 1 3



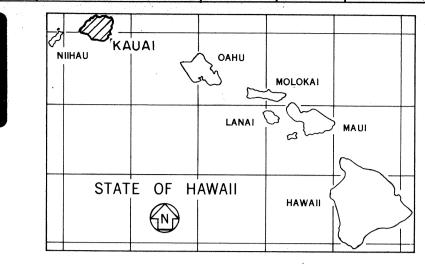

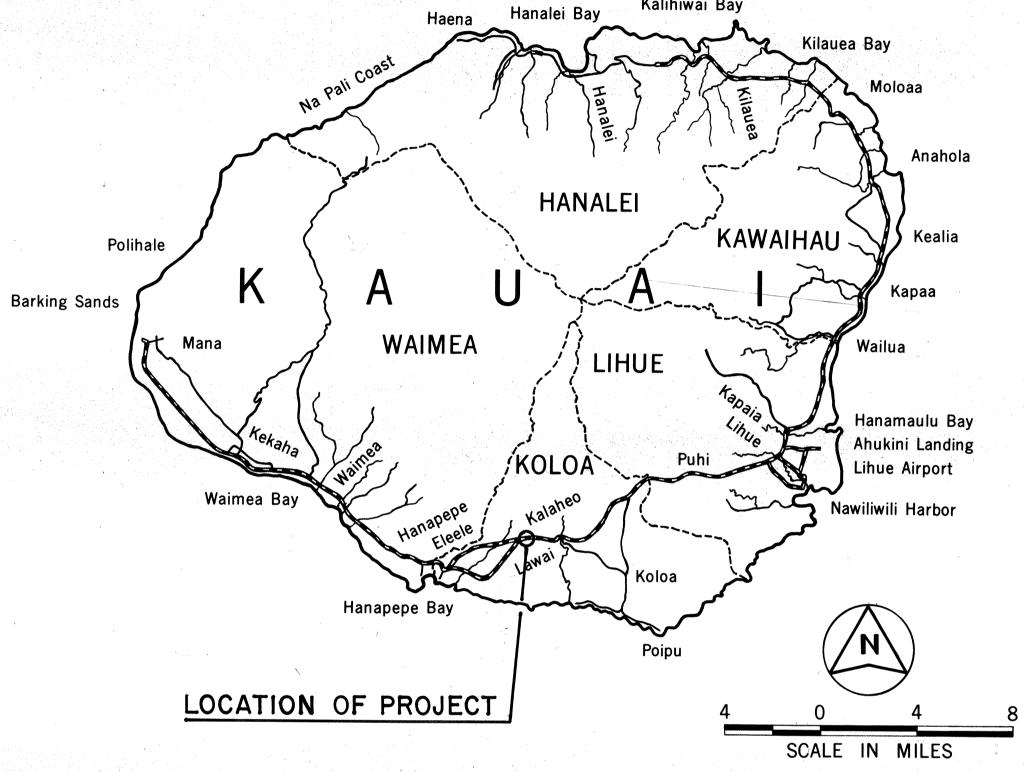

FEDERAL AID PROJECTS PREVIOUSLY CONSTRUCTED
OR UNDER CONSTRUCTION

CHANGES MADE DURING CONSTRUCTION HAVE BEEN INCORPORATED ON THESE PLANS EXCEPT CHANGES IN THE ORIGINAL THEORETICAL QUANTITIES, FOR ACTUAL QUANTITIES, REFER TO PROJECT LEDGER AND/OR COMPUTATION BOOK.

RESIDENT ENGINEER

DATE

DEPARTMENT OF TRANSPORTATION
STATE OF HAWAII

APPROVED:

1 March 10: Down 4/8/85

ZDIR. OF TRANSPORTATION [