


FED. ROAD DIST. NO.	STATE	PROJ. NO.	FISCAL YEAR	SHEET NO.	TOTAL SHEETS
HAWAII	HAW.	50DE-01-8GM	1986	3	12

Sta. 111+00 to Sta. 126+00
 Sta. 126+00 to Sta. 129+00
 Est. Quant.
 Reinforcing Fabric = 4,600 S.Y. 8,106.7 S.Y.
 SS-1 Tack Coat = 6,580 Gal. 3,005 Gal.
 A.C. Mix I = 4,000 Tons 4,725 Tons
 Striping (Paint) = 150 Gal. 210 Gal.
 (Yellow 55 Gal. & White 55 Gal.)
 Crosswalks (Tape) = 12 Lanes
 Stoplines (Tape) = 280 L.F. 277 L.F.
 Pavt Arrows (Tape) = 23 Ea. 22 Ea.
 (Single 19 Ea. & Double 4 Ea.)
 For Raised Pavement Markers and
 Striping, see "Summary Table"
 right.

SUMMARY ~ RAISED PAVEMENT MARKERS & STRIPING						
Station	Striping L.F.		Pavement Markers Ea.			Zone
	E	E.P.	Type D	Type H	Type J	
111+00 to 117+20	620	1240	32			No Pass
117+20 to 124+40	720	1440	18	18	72	No Pass/Pass
124+40 to 126+00		320	4		16	Pass
126+00 to 129+00	"EXCEPTION"					
129+00 to 137+40	100	200	3	3	12	Pass/No Pass
137+40 to 140+00	25	50	2			No Pass
140+00 to 142+75		50	2			50' Opening KIPU RD.
142+75 to 145+20	245	490	13			No Pass
145+20 to 203+20	800	1600	20	20	80	No Pass/Pass
203+20 to 210+40		1440	17		72	Pass
210+40 to 217+60	720	1440	18	18	72	Pass/No Pass
217+60 to 224+80	720	1440	37			No Pass
224+80 to 232+00	720	1440	18	18	72	No Pass/Pass
232+00 to 236+80		260	12		44	Pass
236+80 to 242+00	520	1040	13	13	52	Pass/No Pass
242+00 to 265+00	"SEE SHEET No. 5"					
265+00 to 267+35	235	470	13			No Pass
267+35 to 267+85		50	2			50' Opening NANI ST.
267+85 to 268+00	100	200	6			No Pass
268+00 to 270+50	160	320	4	4	16	No Pass/Pass
270+50 to 291+70		4240	53	52	208	Pass
291+70 to 298+00	630	1260	16	17	68	Pass/No Pass
TOTAL	6315	12630	303	163	784	
	7685	22490	347	185	900	

Station	Striping L.F.		Pavement Markers Ea.			Zone
	E	E.P.	Type D	Type H	Type J	
126+00 to 129+00		600	8		28	Pass
129+00 to 137+40	845	1680	22	22	88	Pass/No Pass
137+40 to 140+00	525	520	14			No Pass

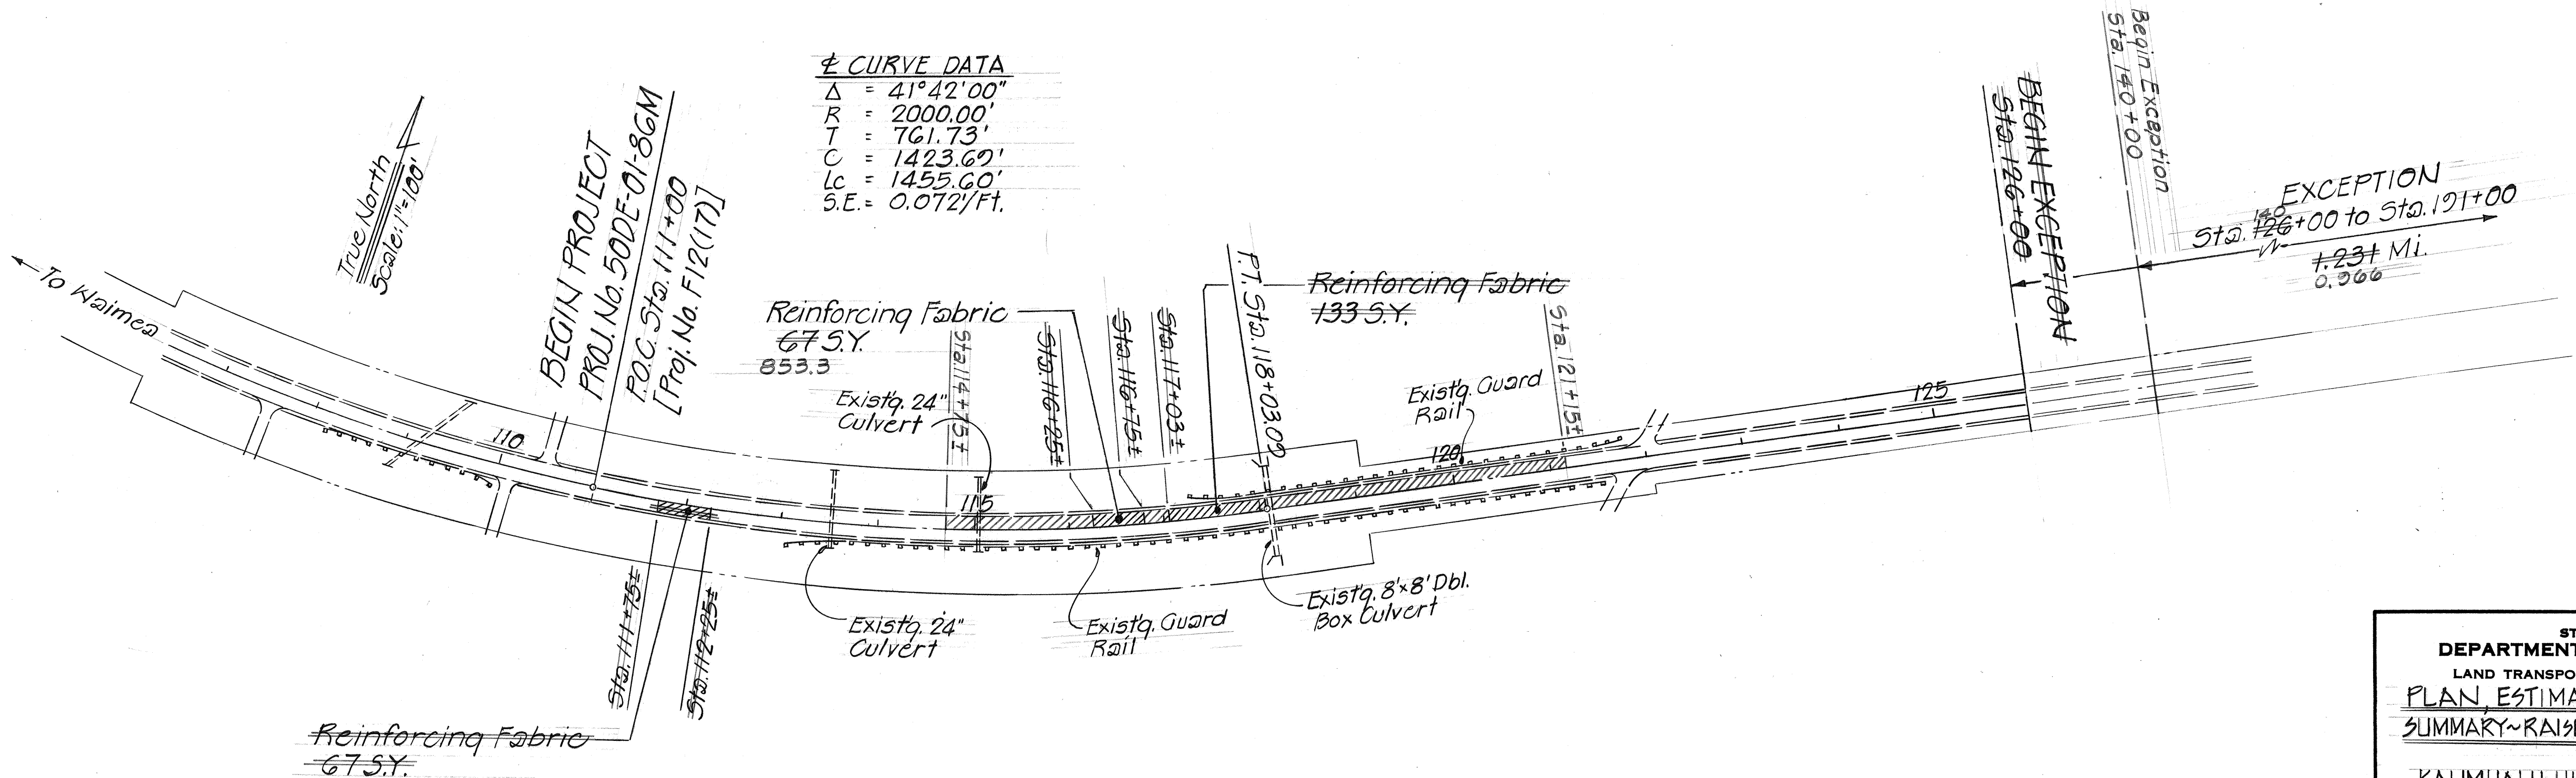

SURVEY PLOTTED BY	DATE
DRAWN BY	
TRACED BY	
QUANTITIES BY	
CHECKED BY	

STATE OF HAWAII
 DEPARTMENT OF TRANSPORTATION
 LAND TRANSPORTATION FACILITIES DIVISION
 PLAN, ESTIMATED QUANTITIES AND
 SUMMARY-RAISED PAVT. MARKERS & STRIPING
 KAUNUAU HIGHWAY RESURFACING
 LIHUE TO PUHI
 PROJ. No. 50DE-01-8GM
 Scale: As shown
 Aug. 1985
 SHEET No. 1 OF 1 SHEETS