

INDEX TO DRAWINGS	
SHEET NO.	DESCRIPTION
1	TITLE SHEET
2	TYPICAL SECTIONS & GENERAL NOTES
3	PLAN, EST. QUANT. & SUMMARY-RAISED PAV'T. MARKERS & STRIPING
4	PLAN
5	ROADWAY STRIPING & PAVEMENT MARKER (KOMOHANA SUBDIV'N.)
6	ROADWAY STRIPING & PAVEMENT MARKER (KAUAI COMM. COLLEGE)
7-12	STANDARD DETAILS

STATE OF HAWAII

DEPARTMENT OF TRANSPORTATION

HIGHWAYS DIVISION

"AS-BUILT"

PLANS FOR

KAUMUALII HIGHWAY RESURFACING,





LIHUE TO PUHI

PROJECT NO. 50DE-01-86M

DISTRICT OF LIHUE

ISLAND OF KAUAI

FED. ROAD DIST. NO.	STATE	PROJ. NO.	FISCAL YEAR	SHEET NO.	TOTAL SHEETS
HAWAII	HAW.	50DE-01-86M	1986	1	12

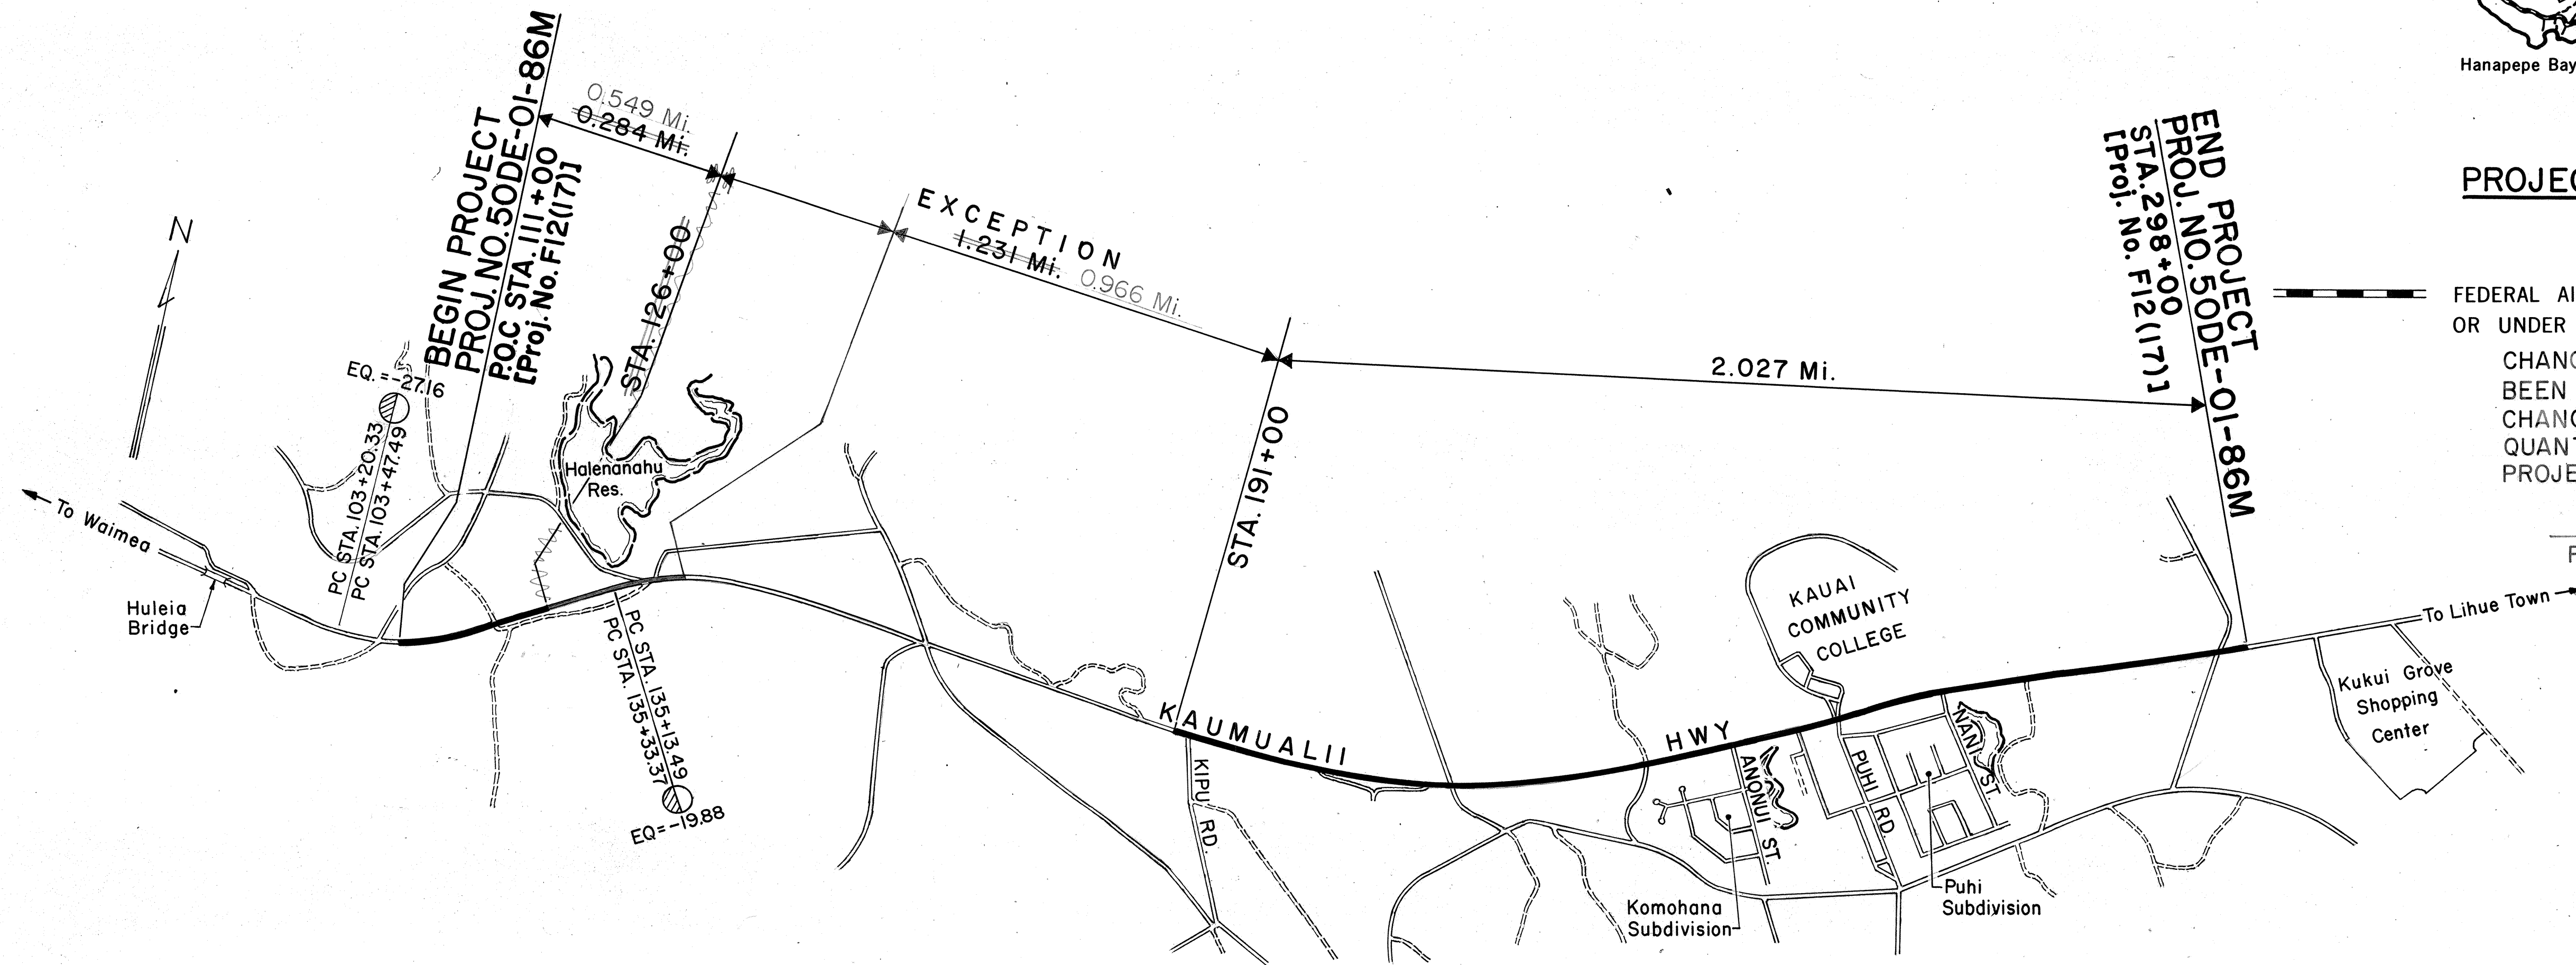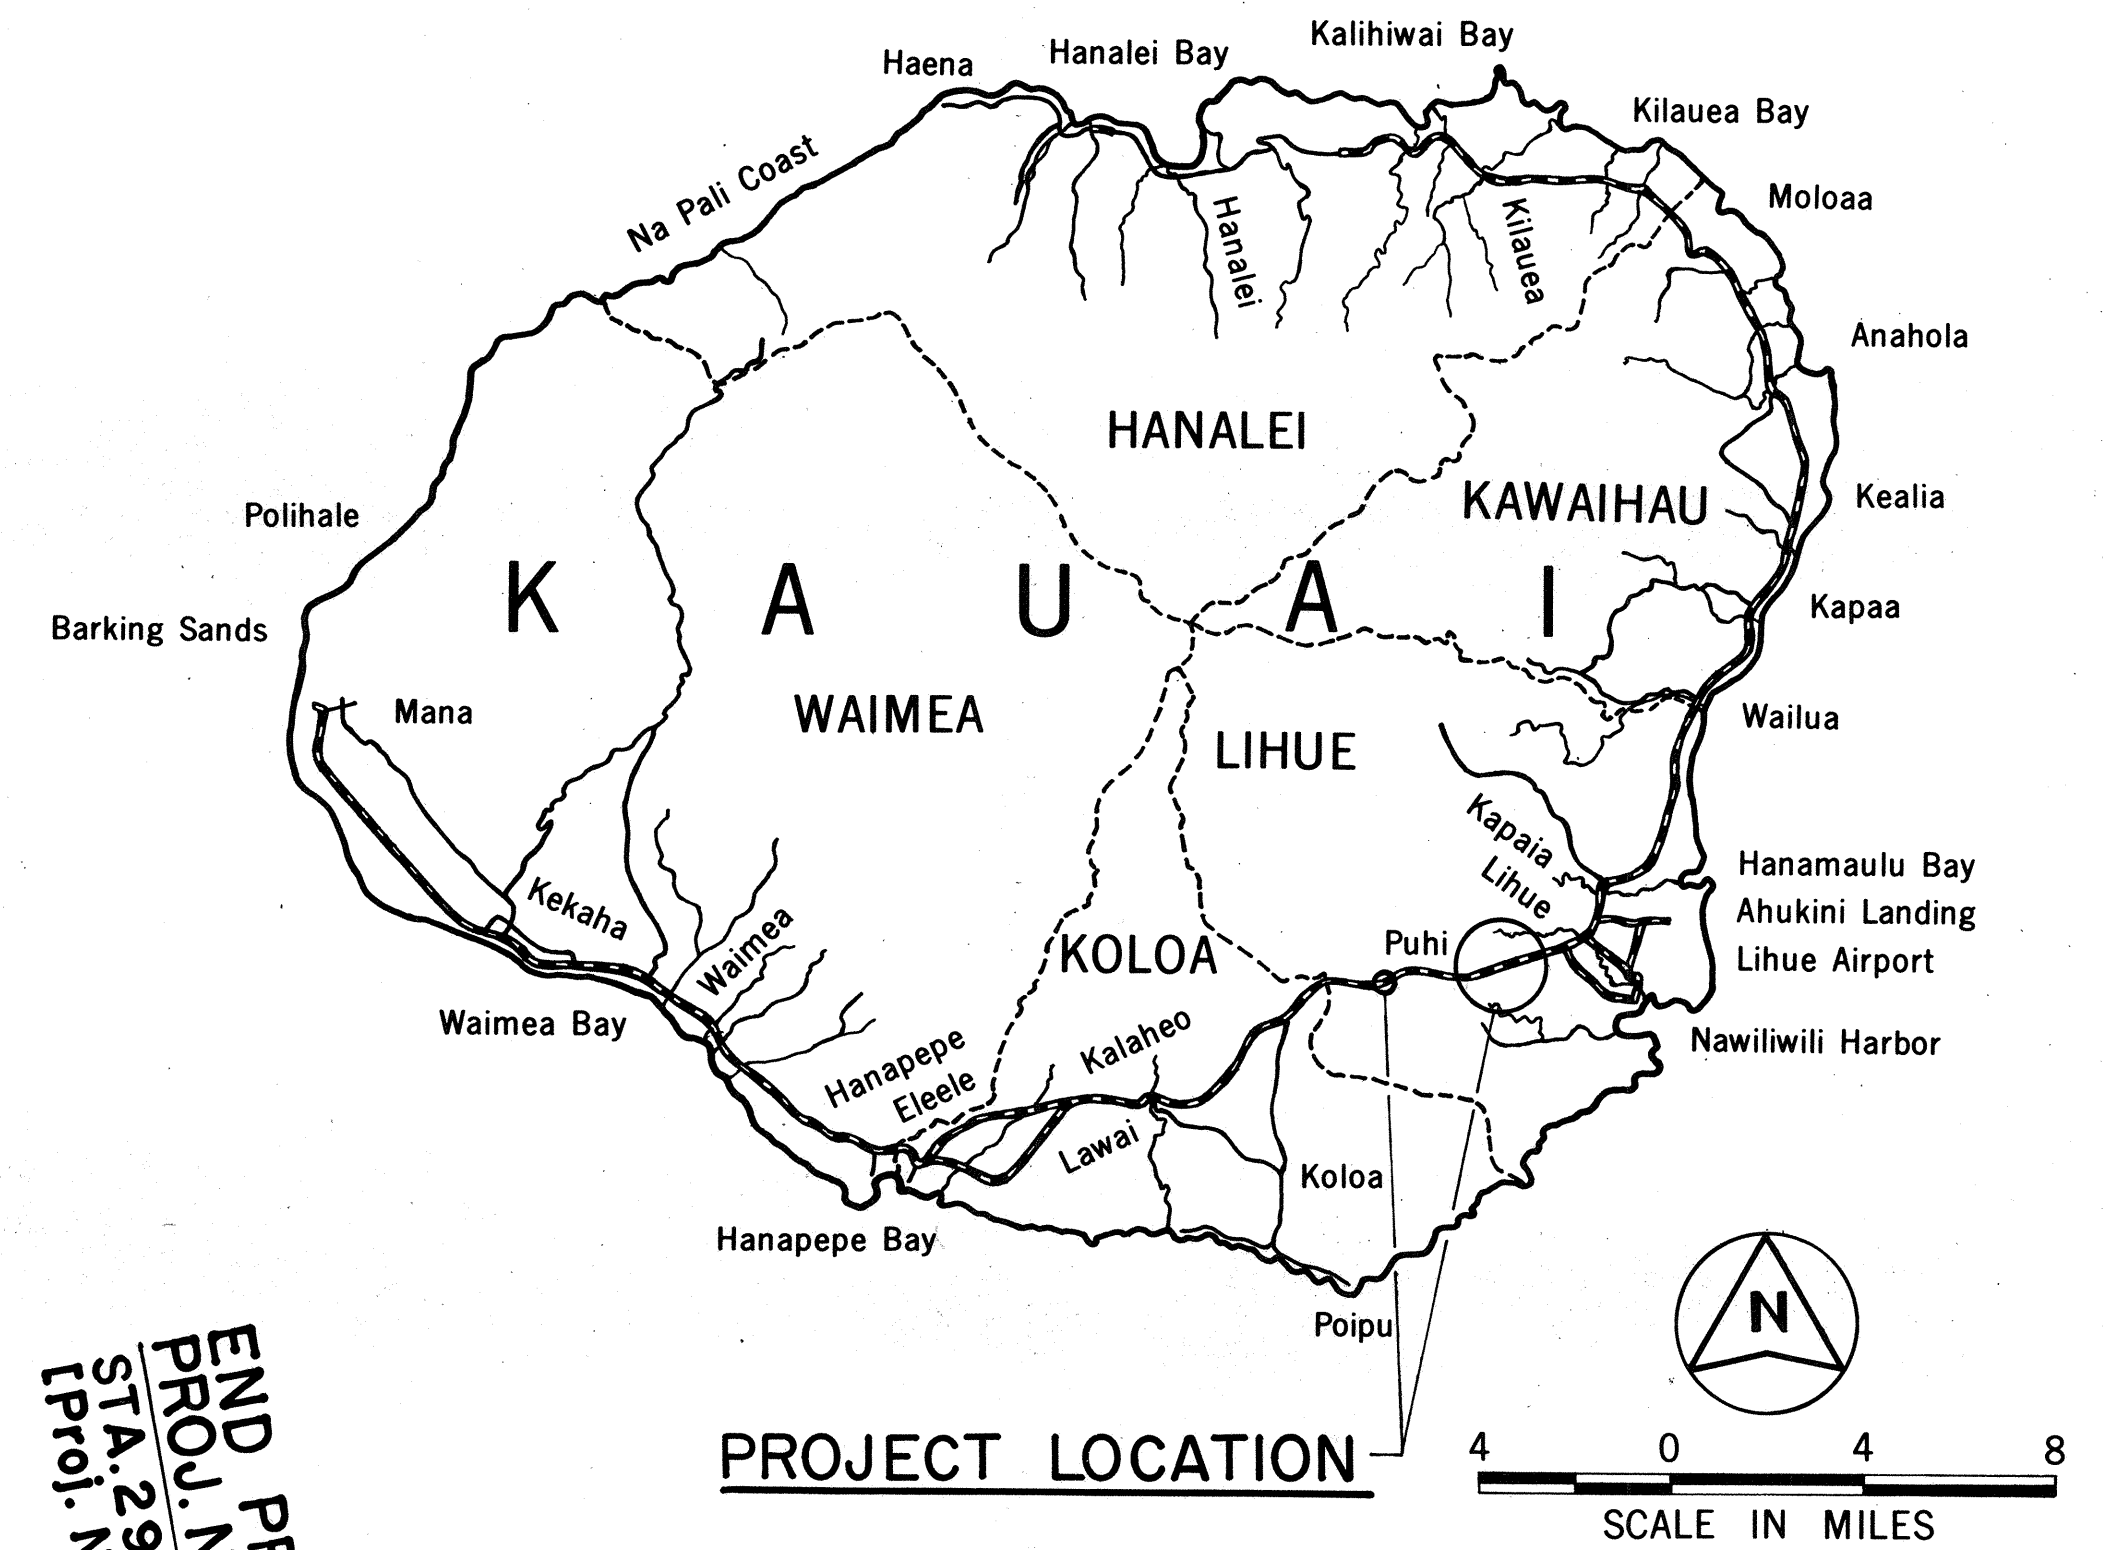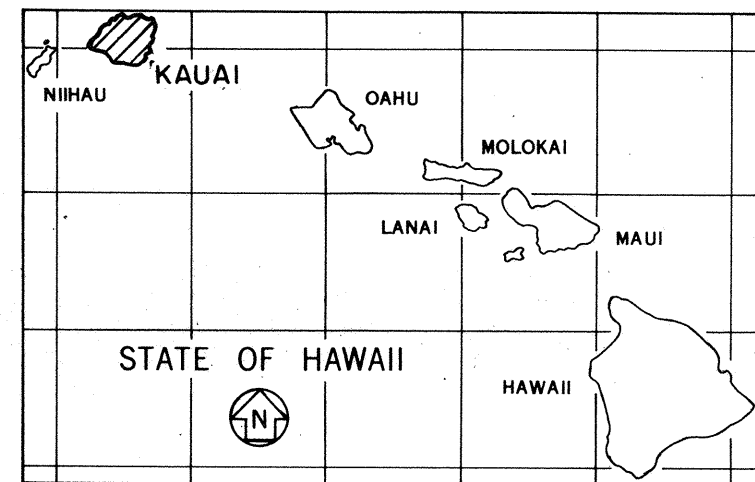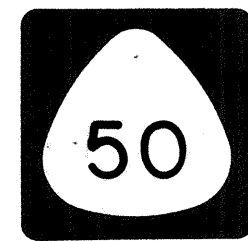

FEDERAL AID PROJECTS PREVIOUSLY CONSTRUCTED OR UNDER CONSTRUCTION

CHANGES MADE DURING CONSTRUCTION HAVE BEEN INCORPORATED ON THESE PLANS EXCEPT CHANGES IN THE ORIGINAL THEORETICAL QUANTITIES. FOR ACTUAL QUANTITIES, REFER TO PROJECT LEDGER AND/OR COMPUTATION BOOK.

Dorel H. Mada
RESIDENT ENGINEER

11/26/85
DATE

DEPARTMENT OF TRANSPORTATION

STATE OF HAWAII

APPROVED:

Cheng D. Bown 12/17/85

DIR. OF TRANSPORTATION DATE

KAUAI DISTRICT

DESIGNED BY

A. Yamaguchi

548-4125

Nov., 1985

PHONE

DATE

LAYOUT OF PROJECT

SCALE: 1" = 1000'

LENGTH OF PROJECT = 2.31 MILES