


[illegible]

STATE OF HAWAII
DEPARTMENT OF TRANSPORTATION
HIGHWAYS DIVISION
"AS-BUILT"
PLANS FOR
KAUMUALII HIGHWAY, GUARDRAIL
AND SHOULDER IMPROVEMENTS
OMAO TO LAWAI
PROJECT NO. 50D-01-86
DISTRICT OF KOLOA
ISLAND OF KAUAI

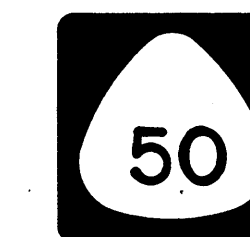

FEDERAL AID PROJECTS PREVIOUSLY CONSTRUCTED
OR UNDER CONSTRUCTION

for RESIDENT ENGINEER DATE 12-3-80

LAYOUT OF PROJECT
SCALE: 1" = 500'

KAUAI DISTRICT
DESIGNED BY
A. NISHIMURA
P. S. & E. BY
548-7490
PHONE
JAN., 1986
DATE