	INDEX TO DRAWINGS
SHEET NO.	DESCRIPTION
	TITLE SHEET
2	STANDARD PLAN SUMMARY
3	GENERAL NOTES &
	TYPICAL SECTIONS
4	PLAN & ESTIMATED QUANTITIES
•	

APRIL, 1987 DATE

5487537 PHONE

TAKESHITA P. S. & E. BY STATE OF HAWAII


DEPARTMENT OF TRANSPORTATION
HIGHWAYS DIVISION
"AS-BUILT"
PLANS FOR

KAUMUALII HIGHWAY RESURFACING,

KIPU TO HULEIA


PROJECT NO. 50D - 01-87M


DISTRICT OF LIHUE
ISLAND OF KAUAI

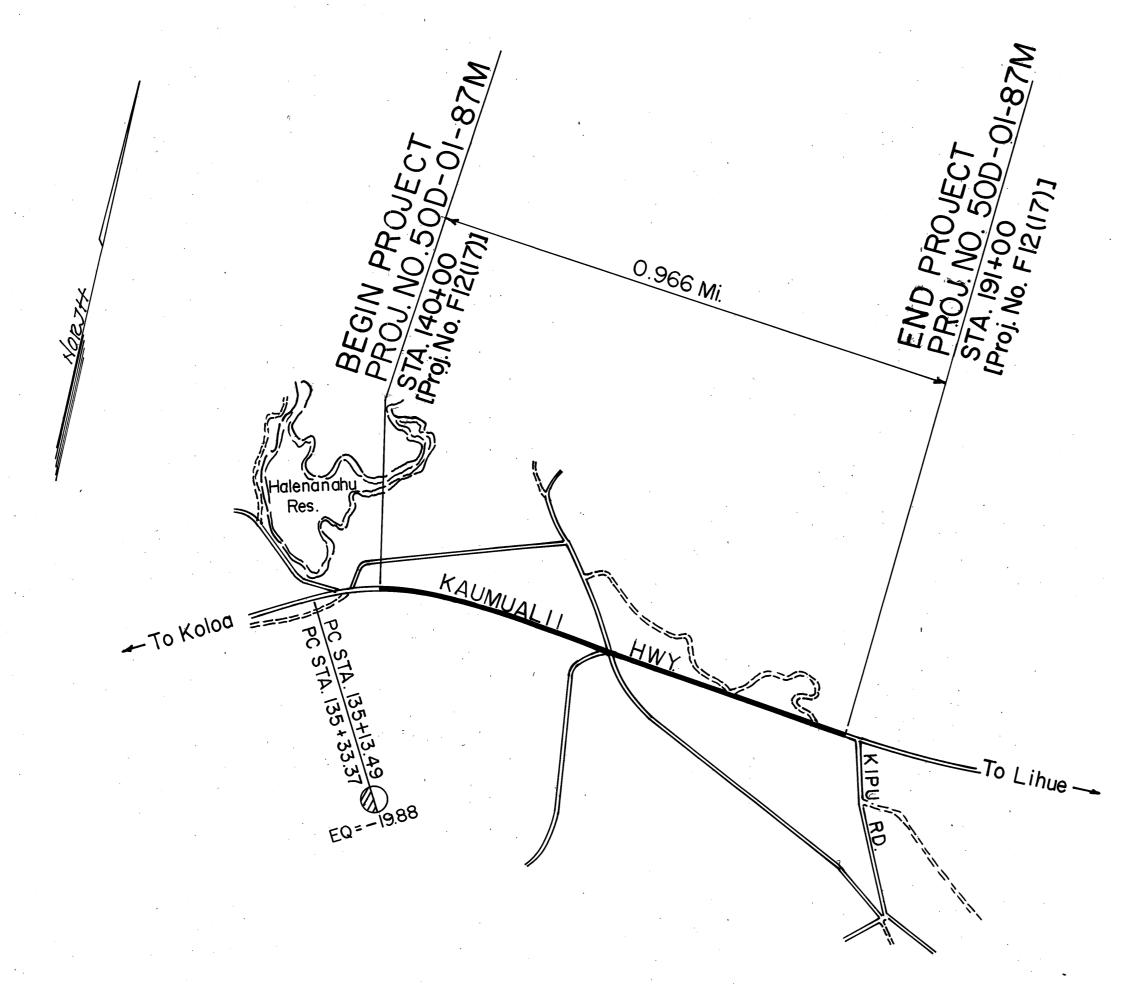


FED. ROAD DIST. NO. STATE PROJ. NO. FISCAL SHEET TOTAL SHEETS

HAWAII HAW. 50D-01-87M 1987 I

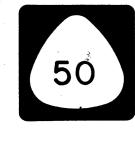

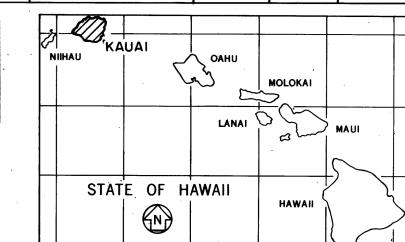

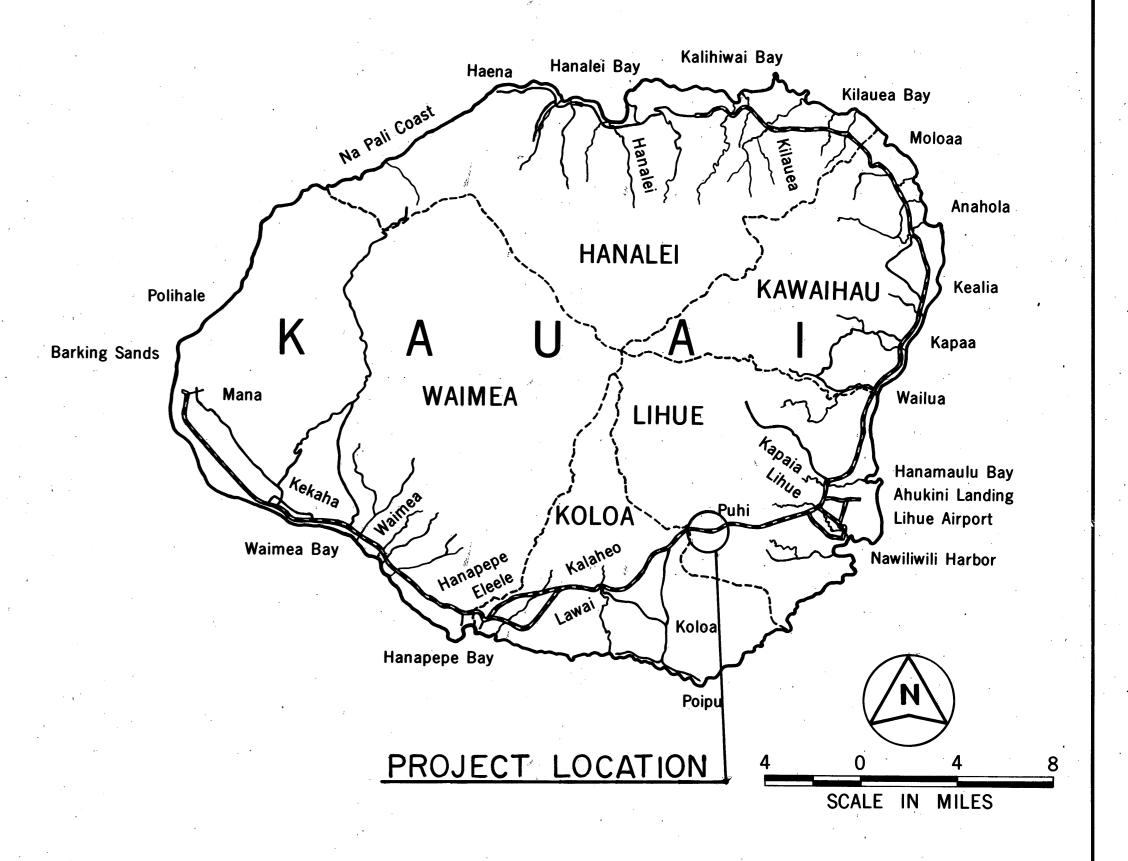

OR UNDER CONSTRUCTION

CHANGES MADE DURING CONSTRUCTION HAVE BEEN NOTED ON THESE PLANS AND CHECKED BY:

Dorryl 21. Maeda RESIDENT ENGINEER

6/17/88 DATE

DEPARTMENT OF TRANSPORTATION
STATE OF HAWAII

APPROVED:

DIR OF TRANSPORTATION

DATE

LAYOUT OF PROJECT

SCALE: 1"= 1000'