
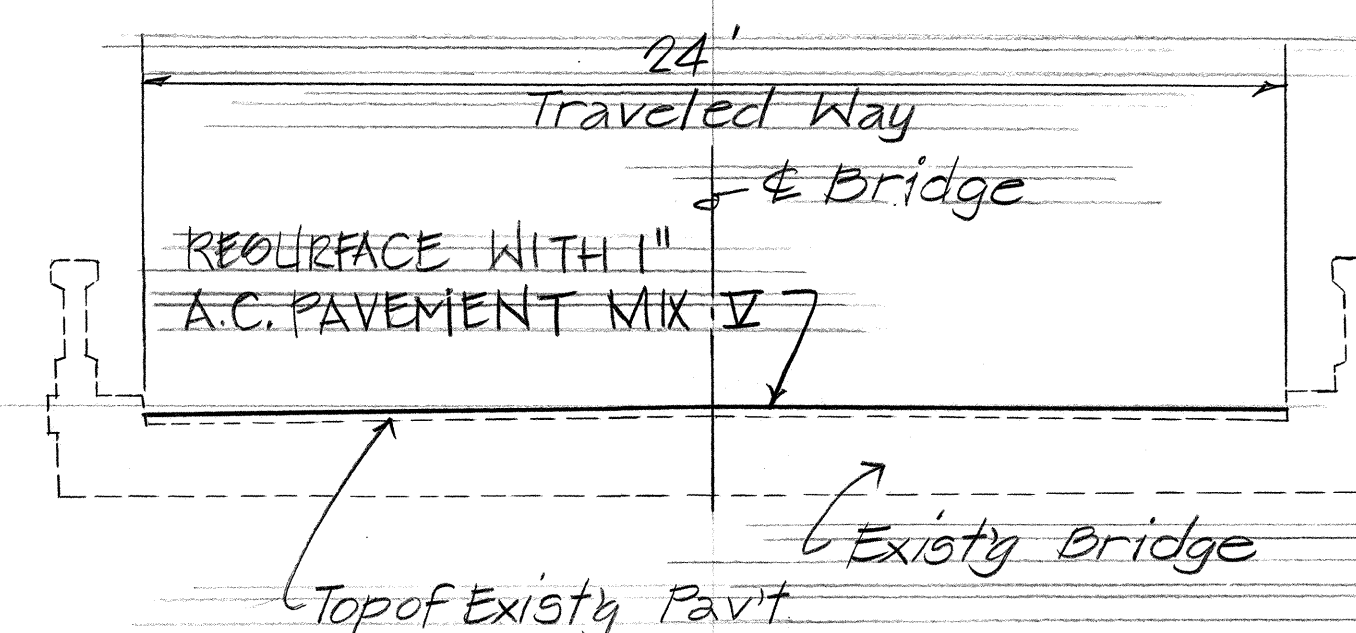
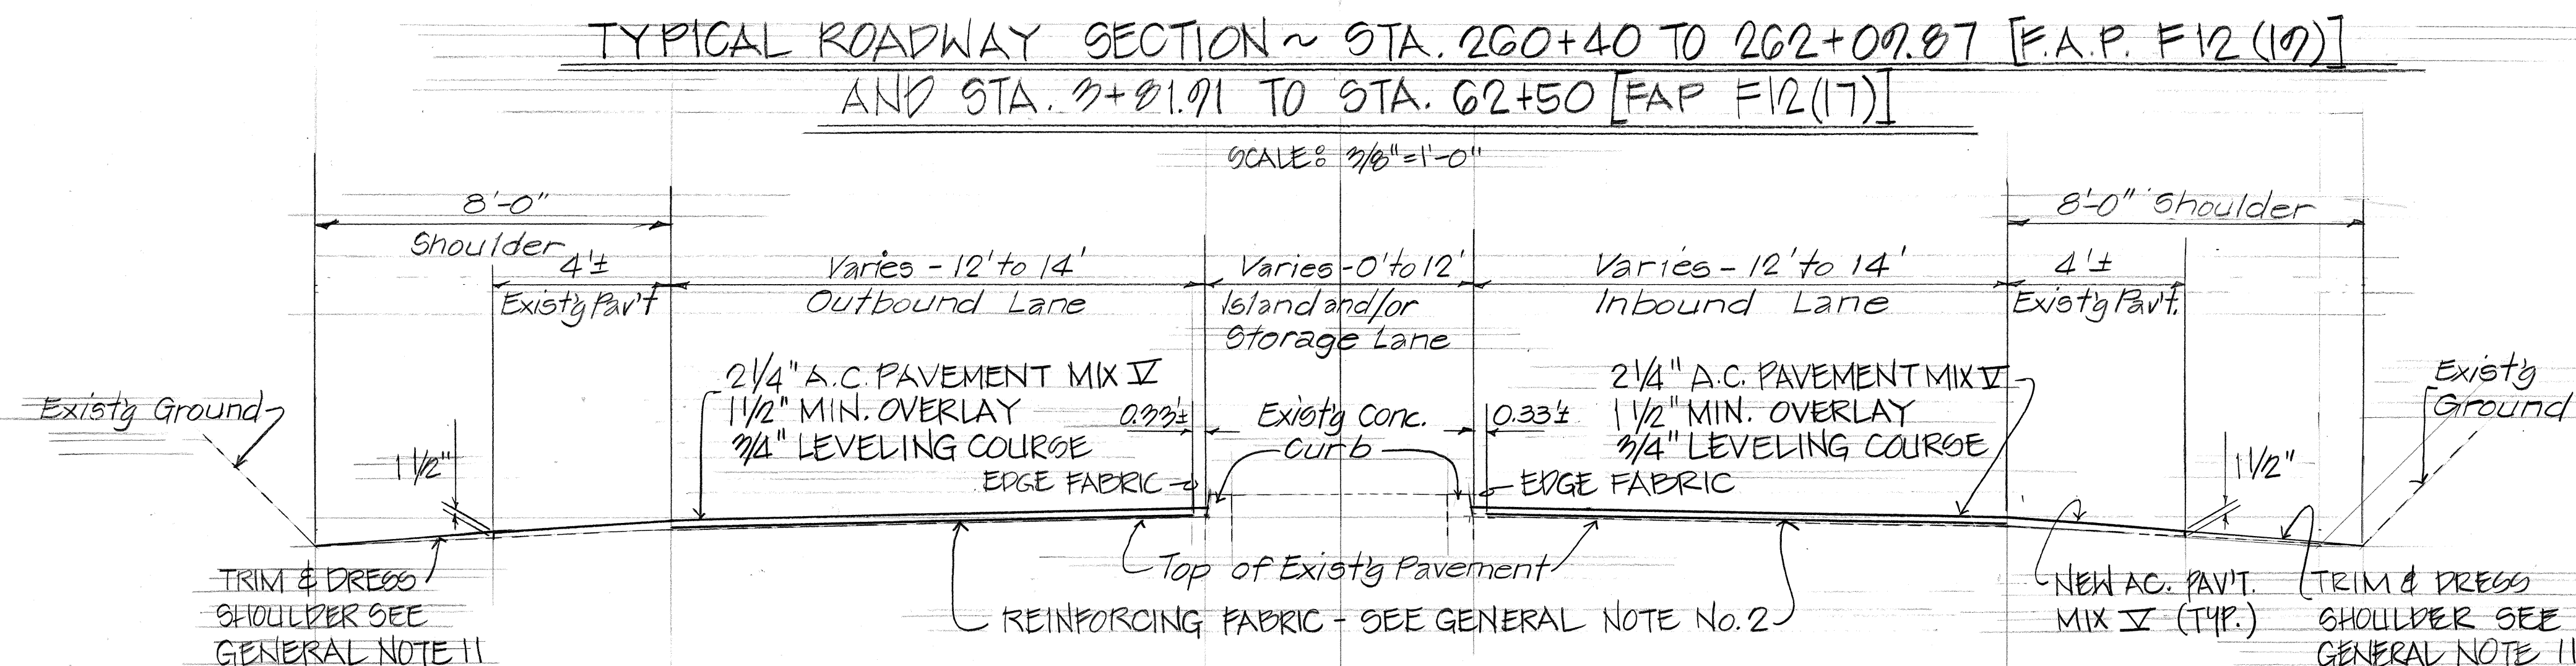


GENERAL NOTES:

1. Scope of Work: Resurfacing, Installing Reinforcing Fabric and Raised Pavement Markers and Pavement Striping.
2. All potholes, depressions, cracks and wheel ruts shall be cleaned, filled, leveled and compacted with $\frac{3}{4}$ " leveling course of Asphalt Concrete Pavement Mix No. V prior to laying of reinforcing fabric. This work will be measured and paid for as provided under Item No. 401.0500 Asphalt Concrete Pavement Mix No. V.
3. Existing Raised Pavement Markers shall be removed from the entire area to be resurfaced by such method that will cause the least possible damage to the pavement. This work will not be measured for payment but shall be considered incidental to various contract items.
4. Provide smooth riding transition from the new pavement overlay to the existing pavement 25' and 55' long, at the beginning and end of project, 30' long at the bridge approaches, to R/W line for County approaches and 4' long for private approaches.
5. "Brooming Off" and grading of the edges of the existing surface and removing portion of the existing pavement at the beginning and end of project prior to resurfacing will not be measured or paid for separately, but shall be considered incidental to Asphalt Concrete Pavement Mix No. V.
6. The Contractor shall be held liable for damages incurred to existing utility facilities as a result of his operation. All damages shall be repaired and/or replaced immediately in accordance to the Standards and Specifications of the State and/or the affected Utility Company. On any unreasonable delay by the Contractor the State shall repair said damages and bill the Contractor.
7. All lanes shall be open to traffic during the morning peak hours from 6:30 am to 9:30 am, during the afternoon peak hours from 3:30 pm. to 5:30 pm and during off work hours. Only one lane of Highway shall be closed at any other time.
8. Existing wearing surfaces indicated in Typical Sections varies. Surfaces indicated are typical and not intended to represent any specific location.
9. If it is necessary to run public traffic over roadways soon after the paving operations, the Contractor shall install temporary pavement marking tape and raised pavement markers as directed by the Engineer. For additional requirements, refer to Section 629 of the Standard Specifications and Special Provisions. This work shall be considered incidental to the various contract items and no separate payment will be made therefor.
10. Placement of Reinforcing Fabric will not be required on transitions at the beginning and end of project and at bridge approaches and on the bridge.
11. Trimming and dressing of shoulders will be done by the State Maintenance Forces.

FED. ROAD DIST. NO.	STATE	PROJ. NO.	FISCAL YEAR	SHEET NO.	TOTAL SHEETS
HAWAII	HAW.	502-02-00M	1988	2	5

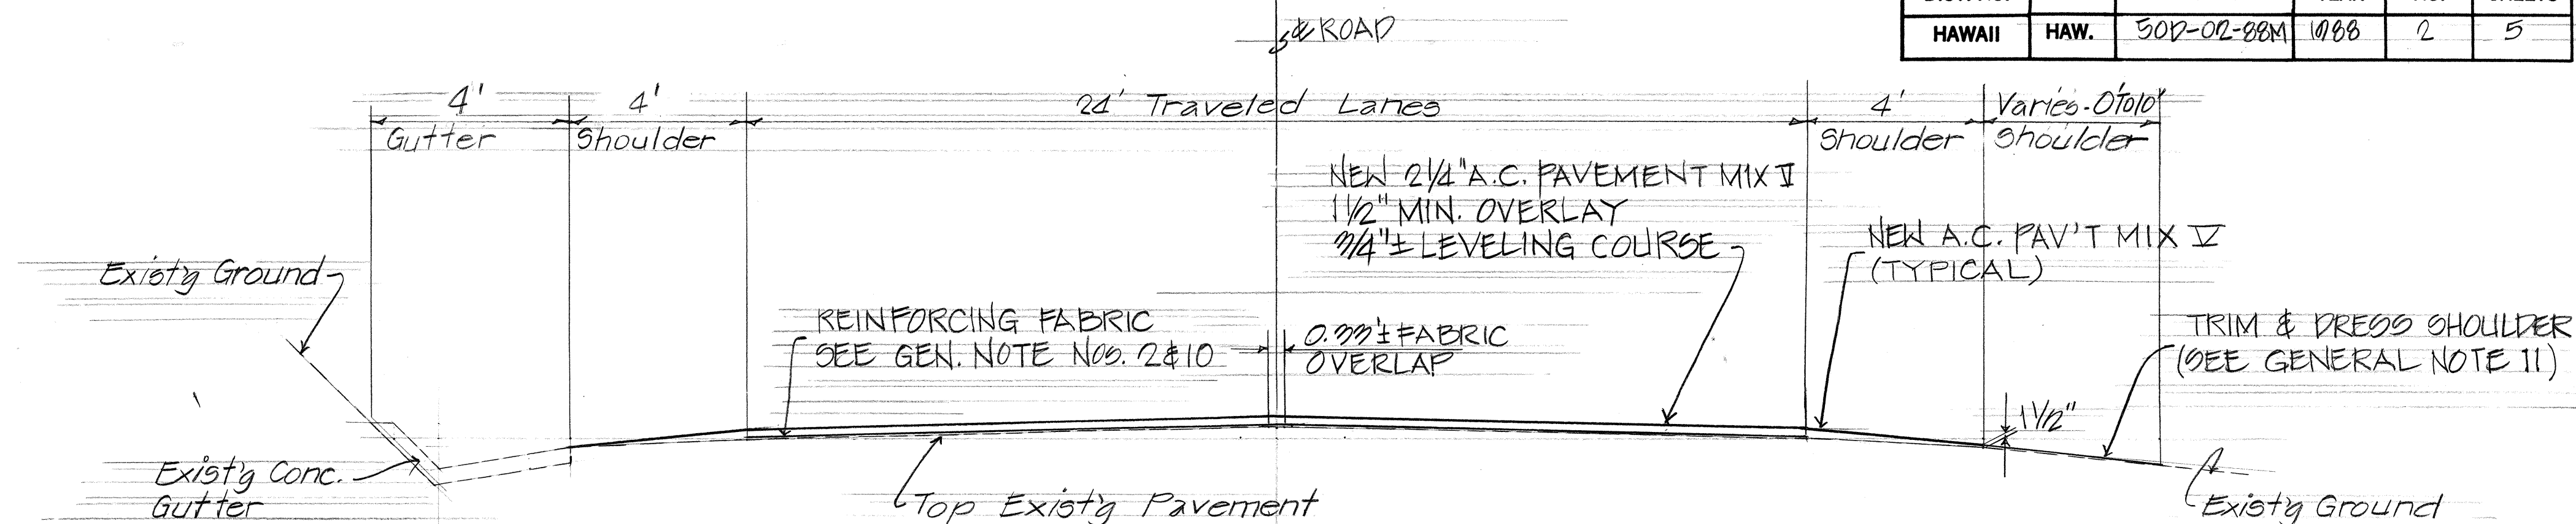

STATE OF HAWAII	
DEPARTMENT OF TRANSPORTATION	
LAND TRANSPORTATION FACILITIES DIVISION	
KAUAI HIGHWAY RESURFACING	
HULEIA TO MALIHIA	
GENERAL NOTES AND	
TYPICAL SECTIONS	
SCALE: AS SHOWN	OCT. 19, 1987
SHEET NO. 1 OF 1 SHEETS	