



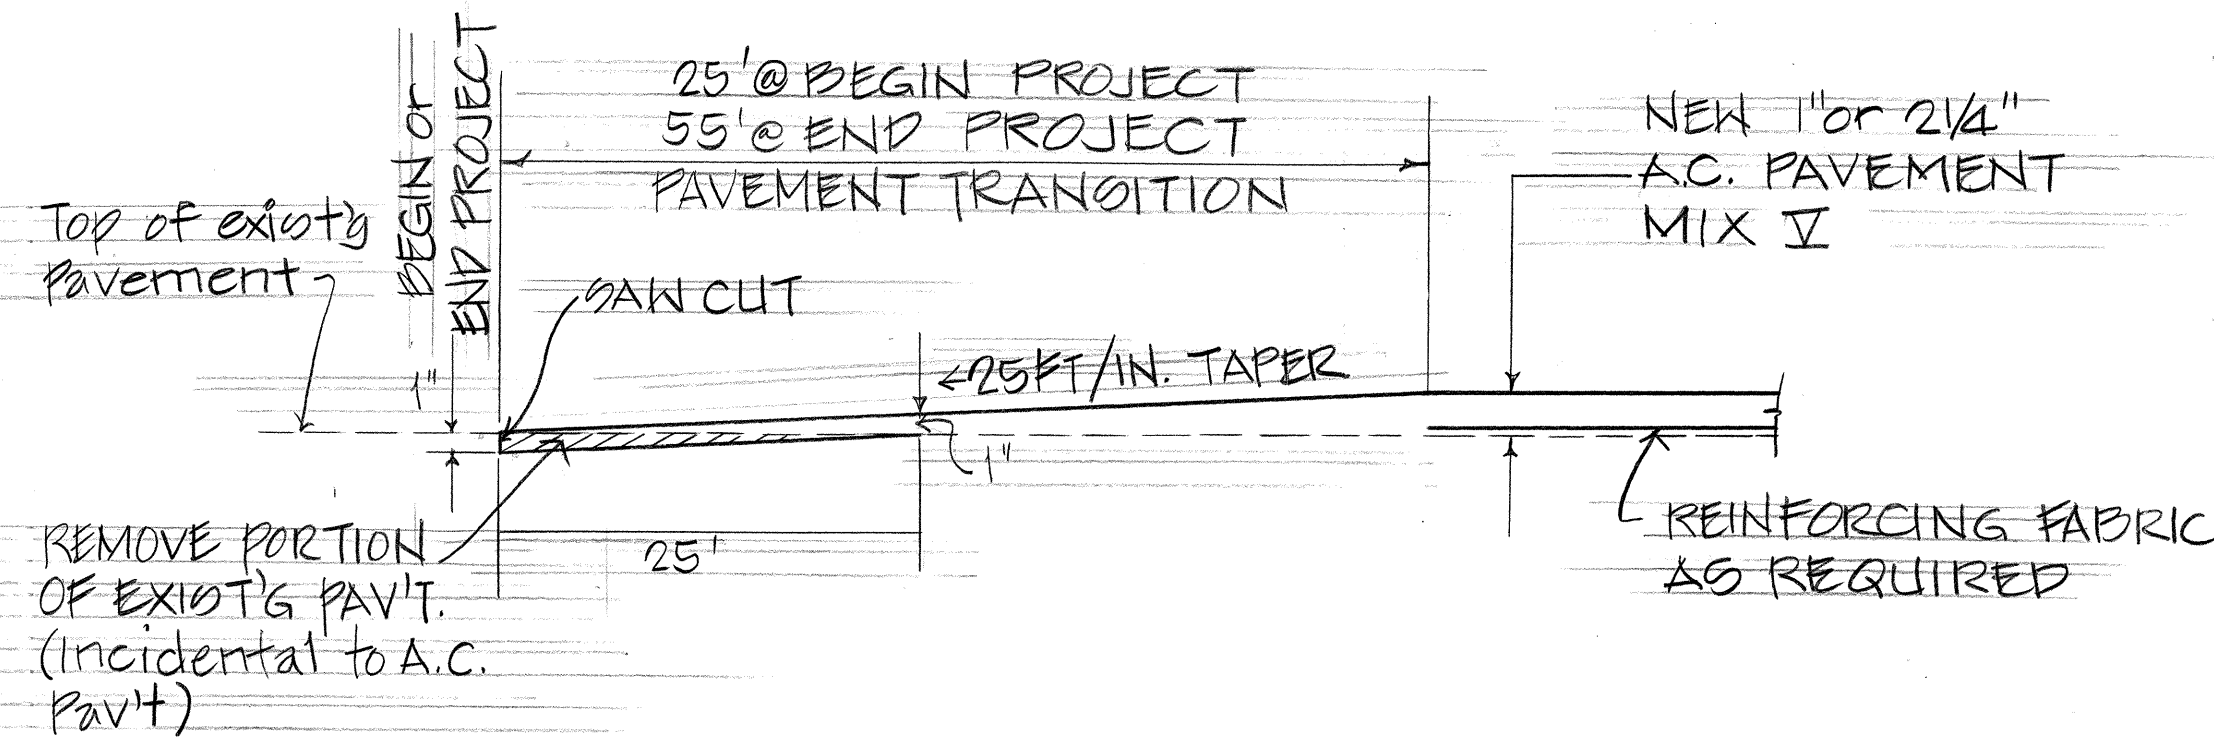

TYPICAL SECTION OF PAVEMENT TRANSITION
@ THE BEGINNING AND END OF PROJECT
N. T. S.

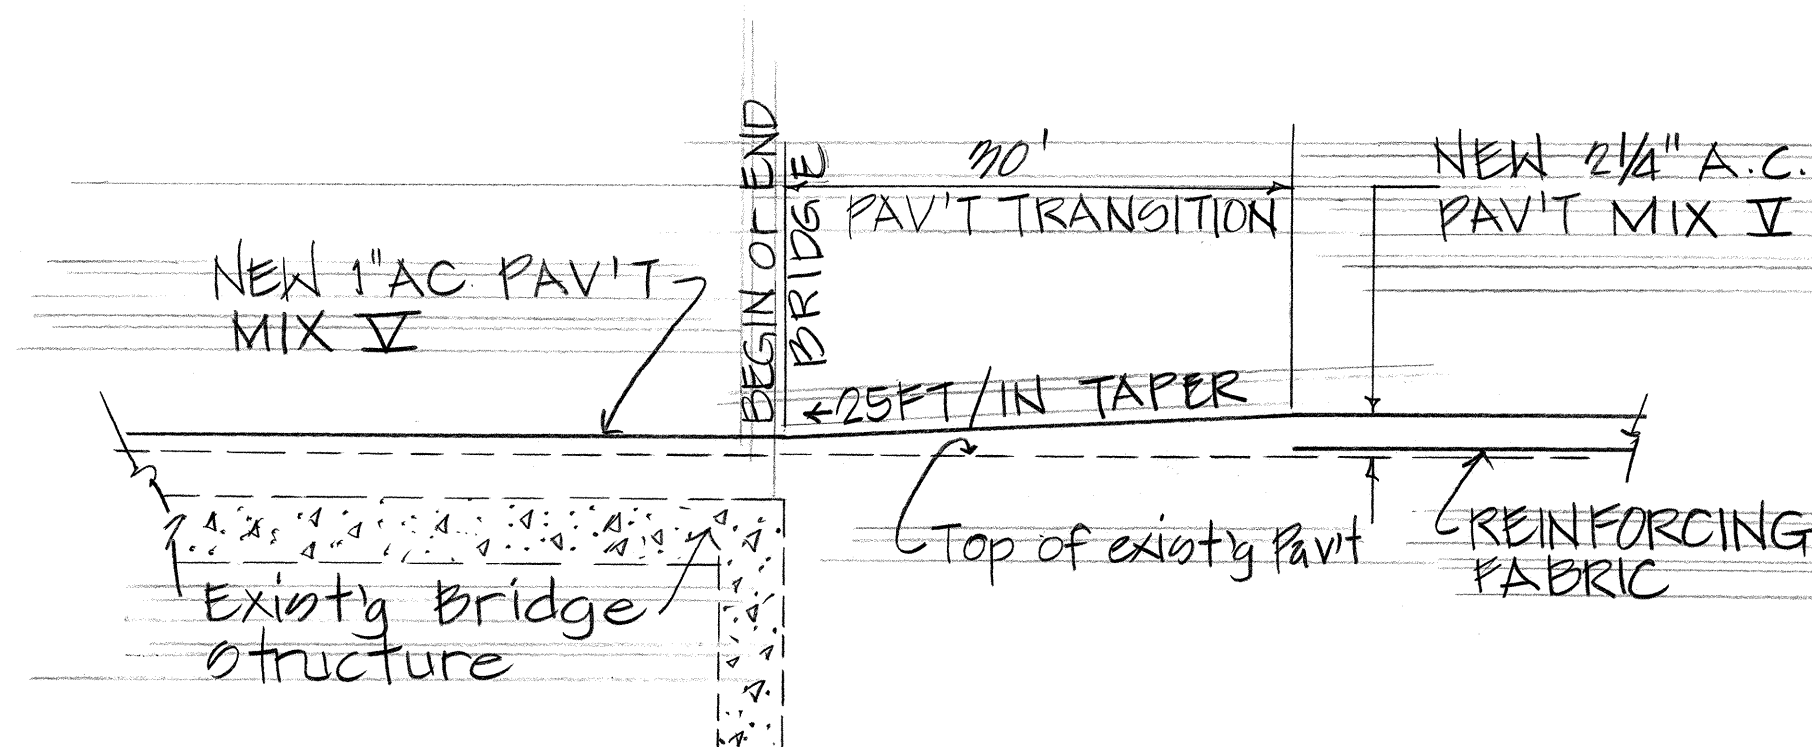

TYPICAL SECTION OF PAVEMENT TRANSITION AT
WAIHOHONU BRIDGE (END ONLY) AND WEOWEOPILAU
BRIDGE (BOTH ENDS)
N. T. S.

SUMMARY - STRIPING AND RAISED PAVEMENT MARKERS						
STATION	STRIPING L.F.	PAVEMENT MARKER #	TYPE D	TYPE H	TYPE J	ZONE
3+00 TO 4+20	240	72				No Pass
4+20 TO 5+20	160	720	4	45	1020	NO PASS/PASS
5+20 TO 16+60	2160	27			104	PASS
16+60 TO 18+60	200	400	5	5	20	PASS/NO PASS
18+60 TO 20+00	140	280	7			NO PASS
20+00 TO 22+00	200	400	5	56	24	NO PASS/PASS
22+00 TO 26+00	2800	25			142	PASS
26+00 TO 44+00	800	1600	21	2021	84	PASS/NO PASS
44+00 TO 52+40	240	1680	21			NO PASS
52+40 TO 60+40	800	1600	19	20	80	NO PASS/PASS
60+40 TO 62+50	3180	420	5		20	PASS
TOTAL	11,100	174	57	54	476	

PAVEMENT MARKING NOTES:

1. LOCATION OF NEW PAVEMENT MARKINGS, INCLUDING PAVEMENT ARROWS AND STOP BARS SHALL BE STAKED OUT IN THE FIELD BY THE CONTRACTOR FOR APPROVAL BY ENGINEER PRIOR TO INSTALLATION.
2. ALL STRIPING AND RAISED PAVEMENT MARKERS SHALL BE INSTALLED IN ACCORDANCE TO THE STANDARD PLANS OF THE DEPARTMENT.
3. PAVEMENT STRIPING SHALL BE PAINTED UNLESS OTHERWISE NOTED ON PLANS

SUMMARY - STRIPING AND RAISED PAVEMENT MARKERS

STA. 260+40 TO STA. 272+18.09 AND STA. 0+00 TO STA. 3+00

STRIPING
CENTERLINE = 589 L.F. 323
EDGE PAVEMENT = 2,915 L.F. 3,075
GUIDE LINES = 200 L.F.
ISLAND = 2,003 L.F. 2723

PAVEMENT MARKERS
TYPE C = 7 EA.
TYPE D = 25 EA. 21
TYPE H = 66 EA. 84

FED. ROAD DIST. NO.	STATE	PROJ. NO.	FISCAL YEAR	SHEET NO.	TOTAL SHEETS
HAWAII	HAW.	300-02-88M	1988	4	5

ORIGINAL PLAN	SURVEY PLOTTED BY	DATE
NOTE BOOK	DRAWN BY	
No.	TRACED BY	
	REVIEWED BY	
	CHECKED BY	

STATE OF HAWAII
DEPARTMENT OF TRANSPORTATION
LAND TRANSPORTATION FACILITIES DIVISION
KAUAIUALII HIGHWAY RESURFACING
HULEIA TO MALIHIA
MISCELLANEOUS DETAILS &
SUMMARY STRIPING AND
RAISED PAVEMENT MARKERS
SCALE 8 AS SHOWN OCT. 18, 1987
SHEET NO. 1 OF 1 SHEETS