


FED. ROAD DIST. NO.	STATE	PROJ. NO.	FISCAL YEAR	SHEET NO.	TOTAL SHEETS
HAWAII	HAW.	300-02-88M	1980	7	5

SURVEY PLOTTED BY	DATE
DRAWN BY	
TRACED BY	
QUANTITIES BY	
CHECKED BY	
ORIGINAL PLAN	
NOTE BOOK	
No.	

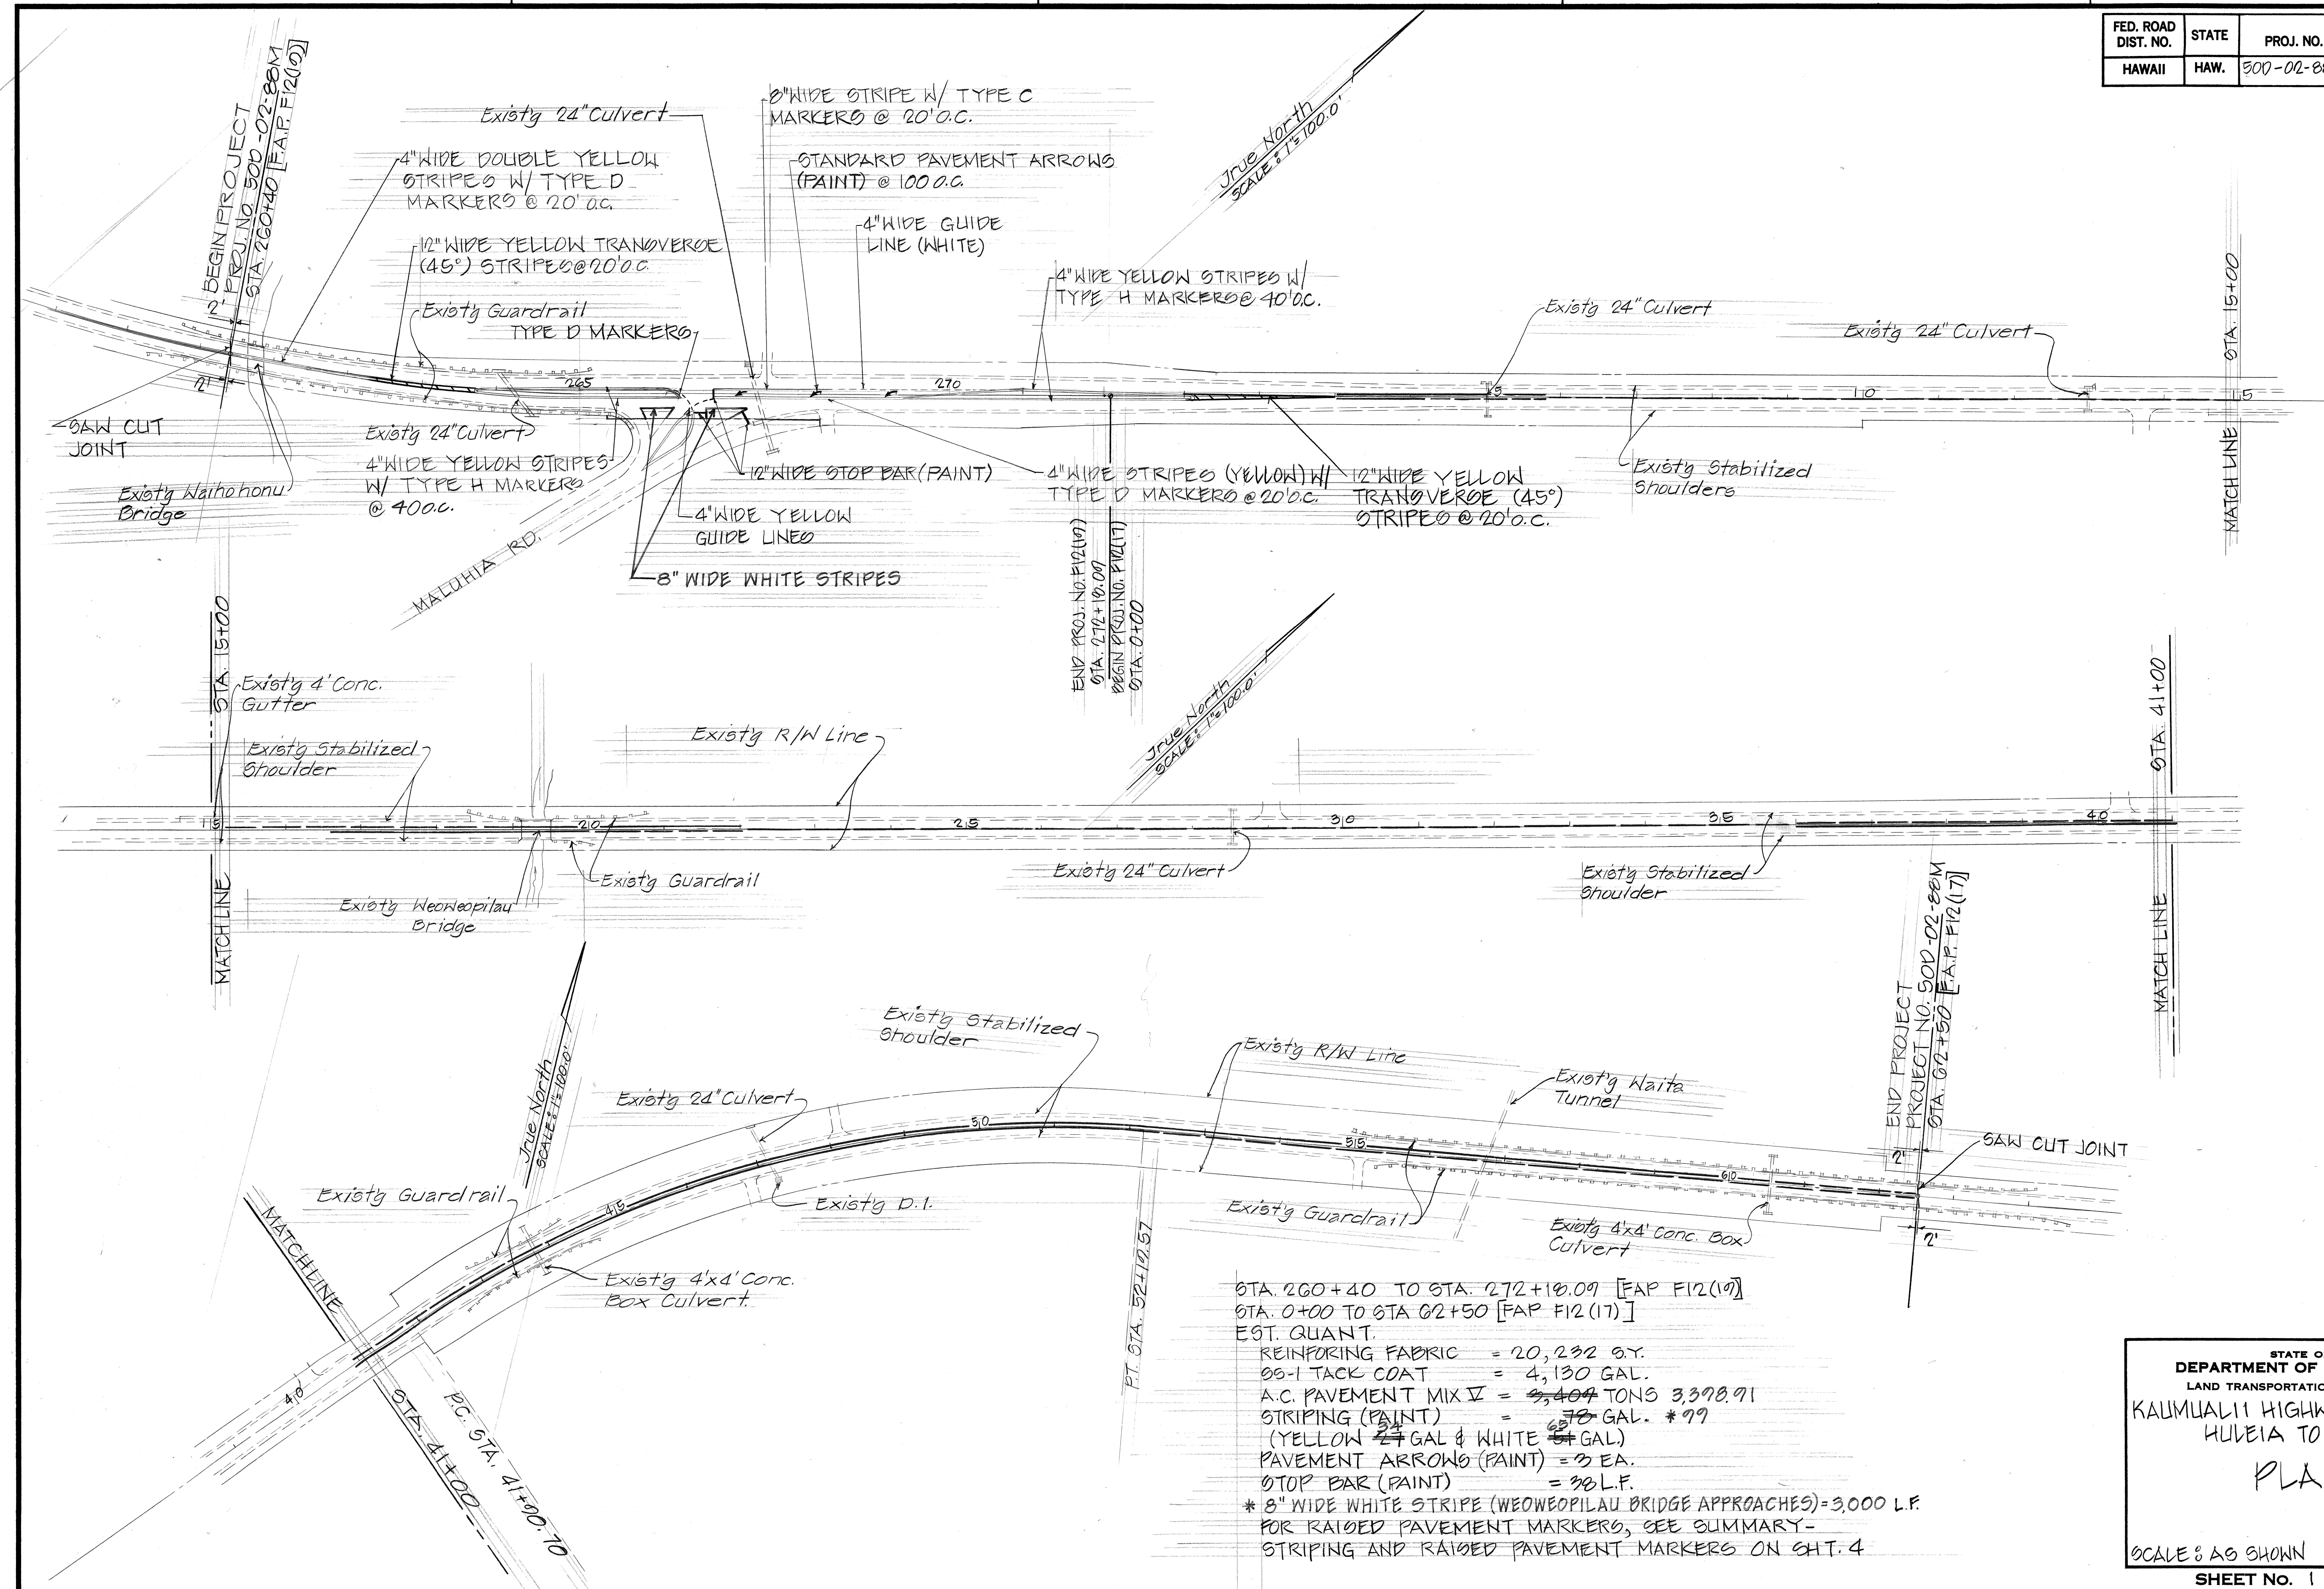

STA. 260+40 TO STA. 272+10.09 [FAP F12(10)]
 STA. 0+00 TO STA. 02+50 [FAP F12(17)]
 EST. QUANT.
 REINFORCING FABRIC = 20,232 S.Y.
 55-1 TACK COAT = 4,130 GAL.
 A.C. PAVEMENT MIX V = 3,404 TONS 3,398.91
 STRIPING (PAINT) = 678 GAL. * 77
 (YELLOW 47 GAL & WHITE 208 GAL.)
 PAVEMENT ARROWS (PAINT) = 3 EA.
 STOP BAR (PAINT) = 30 L.F.
 * 8" WIDE WHITE STRIPE (WEONEOPILAU BRIDGE APPROACHES) = 3,000 L.F.
 FOR RAISED PAVEMENT MARKERS, SEE SUMMARY-
 STRIPING AND RAISED PAVEMENT MARKERS ON SHT. 4

STATE OF HAWAII
 DEPARTMENT OF TRANSPORTATION
 LAND TRANSPORTATION FACILITIES DIVISION
 KAUMUALII HIGHWAY RESURFACING
 HULEIA TO MALUHIA
PLAN
 SCALE: AS SHOWN OCT. 19, 1987
 SHEET NO. 1 OF 1 SHEETS