	INDEX TO DRAWINGS
SHEET NO.	DESCRIPTION
	TITLE SHEET
2	GENERAL NOTES &
	TYPICAL SECTIONS
3	PLAN
4	MISCELLANEOUS DETAILS AND
	SUMMARY STRIPING & RAISED
	PAVEMENT MARKERS
5	STANDARD PLAN SUMMARY
1	

STATE OF HAWAII

DEPARTMENT OF TRANSPORTATION HIGHWAYS DIVISION

"AS-BUILT"


PLANS FOR

KAUMUALII HIGHWAY RESURFACING, HULEIA TO MALUHIA


PROJECT NO. 50D - 02-88M


DISTRICTS OF LIHUE AND KOLOA

ISLAND OF KAUAI

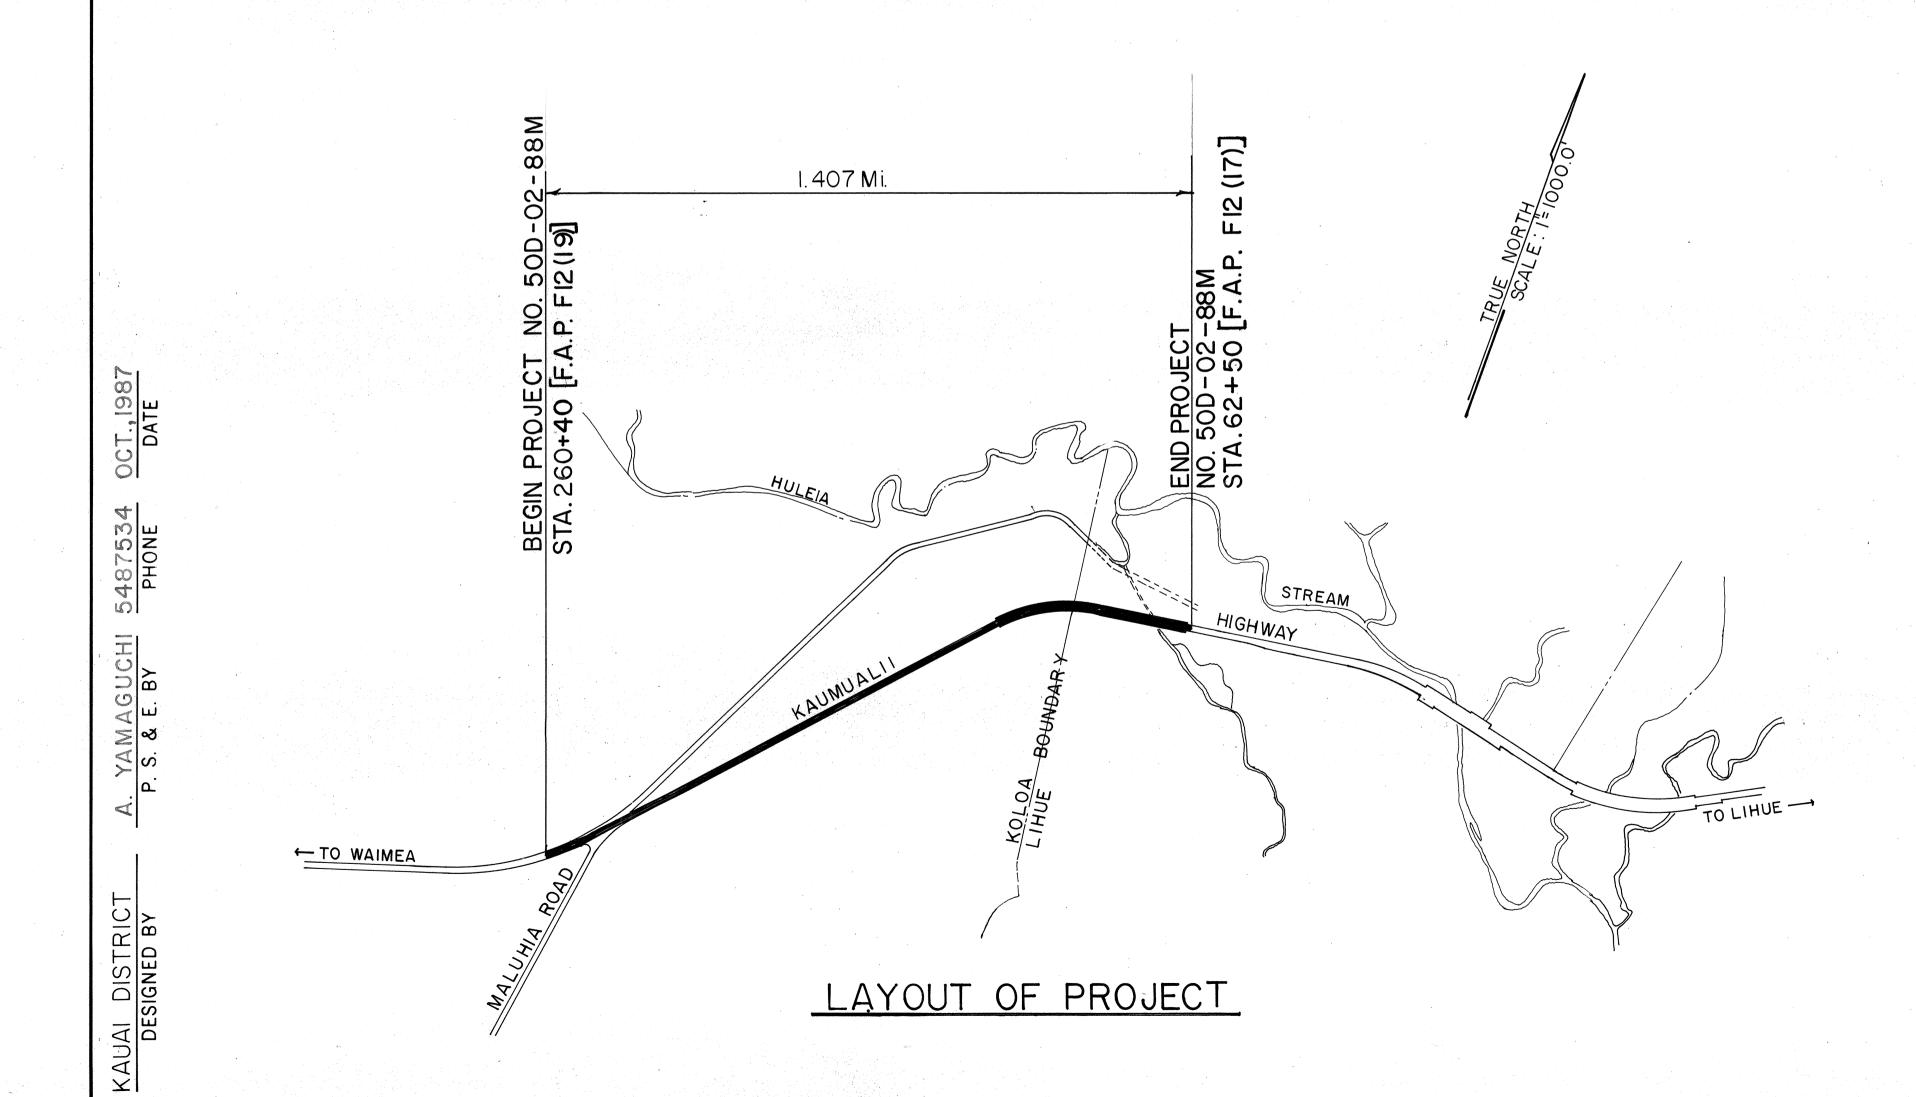

FED. ROAD
DIST. NO.STATEPROJ. NO.FISCAL
YEARSHEET
NO.TOTAL
SHEETSHAWAIIHAW.50D-02-88M198815

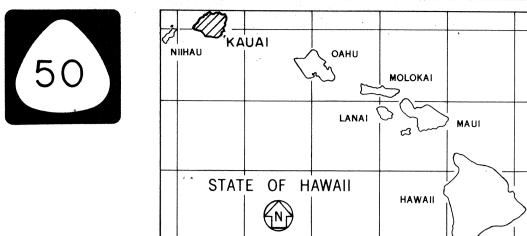

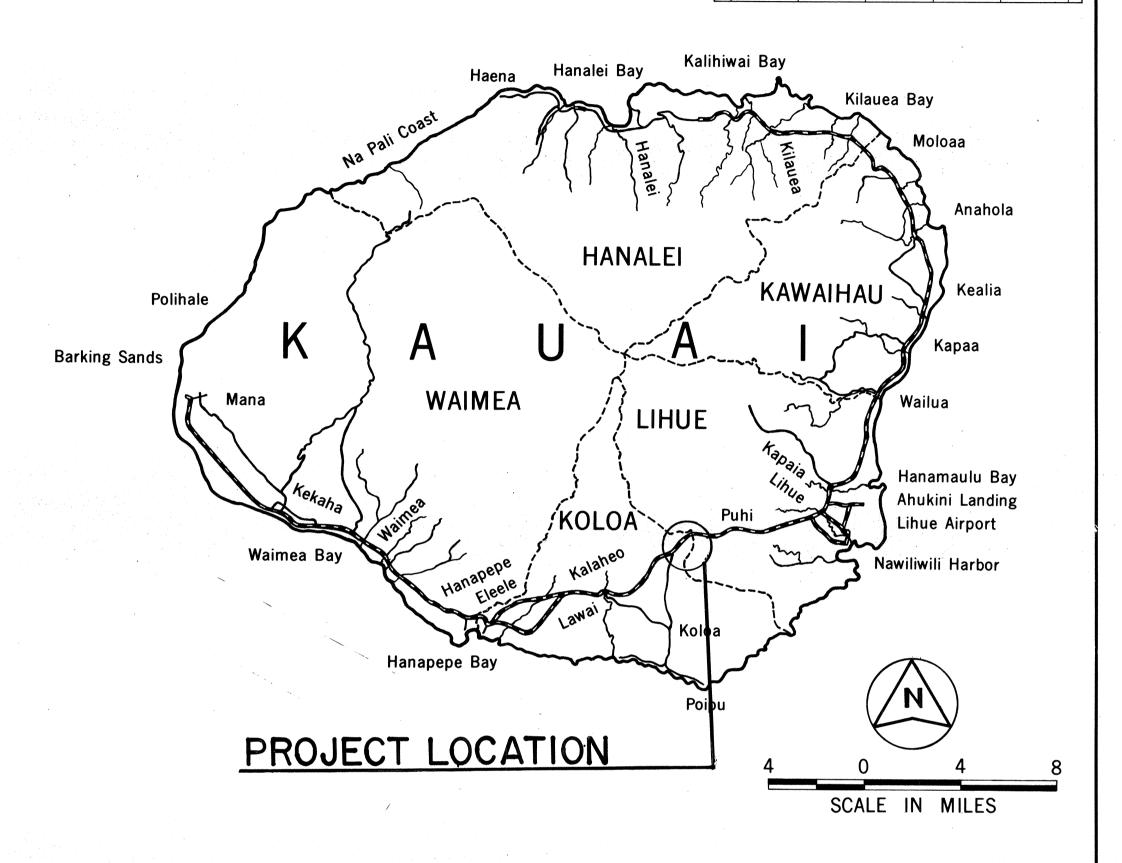

CHANGES MADE DURING CONSTRUCTION HAVE BEEN NOTED ON THESE PLANS AND CHECKED BY:

Danyl H. Maeda RESIDENT ENGINEER

FEDERAL AID PROJECTS PREVIOUSLY CONSTRUCTED

OR UNDER CONSTRUCTION

G/17/88 DATE

DEPARTMENT OF TRANSPORTATION
STATE OF HAWAII

APPROVED:

LILLING 12/1/87

DIR. OF TRANSPORTATION DATE