


ORIGINAL PLAN
NO. _____
DATE _____
DESIGNED BY _____
CHECKED BY _____
SURVEY PLOTTED BY _____
DRAWN BY _____
TRACED BY _____
NOTED BY _____
DATE _____
DESIGNED BY _____
CHECKED BY _____
SURVEY PLOTTED BY _____
DRAWN BY _____
TRACED BY _____
NOTED BY _____
DATE _____

INDEX	
SHEET NO.	DESCRIPTION
51	INDEX TO DRAWINGS, ESTIMATED QUANTITIES, LOCATION PLAN
52	GENERAL STRUCTURAL NOTES, TYPICAL PIER ELEVATION
53	LAYOUT PLAN, LONGITUDINAL SECTION ALONG & ROADWAY
54	FOUNDATION PLAN
55	BORING LOGS
56	DECK FINISH GRADE, TYPICAL ABUTMENT SECTION, ABUTMENT EXCAVATION & BACKFILL, ROADWAY PROFILE
57	ABUTMENT ① - PLAN & ELEVATION
58	ABUTMENT ② - PLAN & ELEVATION
59	ABUTMENT ① & ② - SECTION (A), (B), (C)
510	CANTILEVERED WALL #1, #2, #3 & #4
511	CANTILEVERED WALL DETAILS
512	ABUTMENT COLUMN REINFORCEMENT & TIES SCHEDULE
513	ABUTMENT FOOTING REINFORCEMENT, STEP-UP DETAIL
514	PIER ①, ② & ③ FOOTING DETAIL & SCHEDULE
515	PIER COLUMN DETAILS
516	PIER CAP DETAILS
517	DECK FRAMING PLAN, SLAB CAMBER DIAGRAM
518	NORMAL DECK SECTION, DECK REINFORCEMENT DIAGRAM
519	BEAM "A" & BEAM "C1", "C2" DETAILS
520	BEAM "D" DETAIL
521	PART PLAN - TYPICAL DECK REINFORCEMENT AT SKEWED ENDS
522	PART PLAN - TYPICAL DECK REINF. AT SKEWED ENDS & BEAM "B"
Q1	TYPICAL DETAILS - PRESTRESSED GIRDER TYPE IV
Q2	TYPICAL DETAILS - PLAN - GIRDER CONCRETE SEAT AND MISCELLANEOUS SCHEDULES
Q3	TYPICAL DETAILS - CONCRETE SEAT, HINGE BLOCK, CREEP BLOCK, SCHEDULE
Q4	TYPICAL DETAILS - TYPICAL EXPANSION JOINT SEAL DETAIL
Q5	TYPICAL DETAILS - CONCRETE BRIDGE RAILING / ONE RAIL
Q6	TYPICAL DETAILS - ALUMINUM BRIDGE RAIL
Q7	TYPICAL DETAILS - METAL GUARD RAIL CONNECTION
01-04	EXISTING HULEIA STREAM BRIDGE (REFERENCE PLAN)

ESTIMATED QUANTITIES			
ITEM NO.	ITEM	UNIT	QUANTITIES
202.0440	Removal of Existing Timber Bridge	Lump Sum	
206.6000	Structure Excavation for Bridges	Cu. Yd.	2109.10 1,956 C.Y.
206.7000	Structure Backfill	Cu. Yd.	399.70 434 C.Y.
206.8000	Filter Material	Cu. Yd.	55.30 53 C.Y.
503.1092	Concrete in Bridge (Except Footings)	Lump Sum	(1,705 C.Y.)
503.1093	Concrete in Bridge Footing	Lump Sum	(343 C.Y.)
504.4500	Type PG IV Prestressed Concrete Girders	Lump Sum	(3,792 L.F.)
505.0001	Pile Driving Equipment Expense (Not to Exceed \$8,000)	Lump Sum	
505.0310	Precast Prestressed Concrete Piles, Furnished	Lin. Ft.	5021.50 5,047 L.F.
505.3100	Precast Prestressed Concrete Piles, Driven	Lin. Ft.	2324.40 2,685 L.F.
505.6100	Drilled Holes in Embankment for Piles	Lin. Ft.	1710.00 1,709 L.F.
507.1000	Metal Bridge Railing - One Rail on Parapet	Lin. Ft.	858.10 863 L.F.
507.6000	Concrete Railing And End Post	Lin. Ft.	941.50 941 L.F.
602.0090	Reinforcing Steel in Bridge	Lump Sum	(476,200 lbs.)
612.0200	Grouted Rubble Slope Protection	Cu. Yd.	761.50 541 C.Y.
505.0020	Test Piles, Driven	Lin. Ft.	280.50 315 L.F.

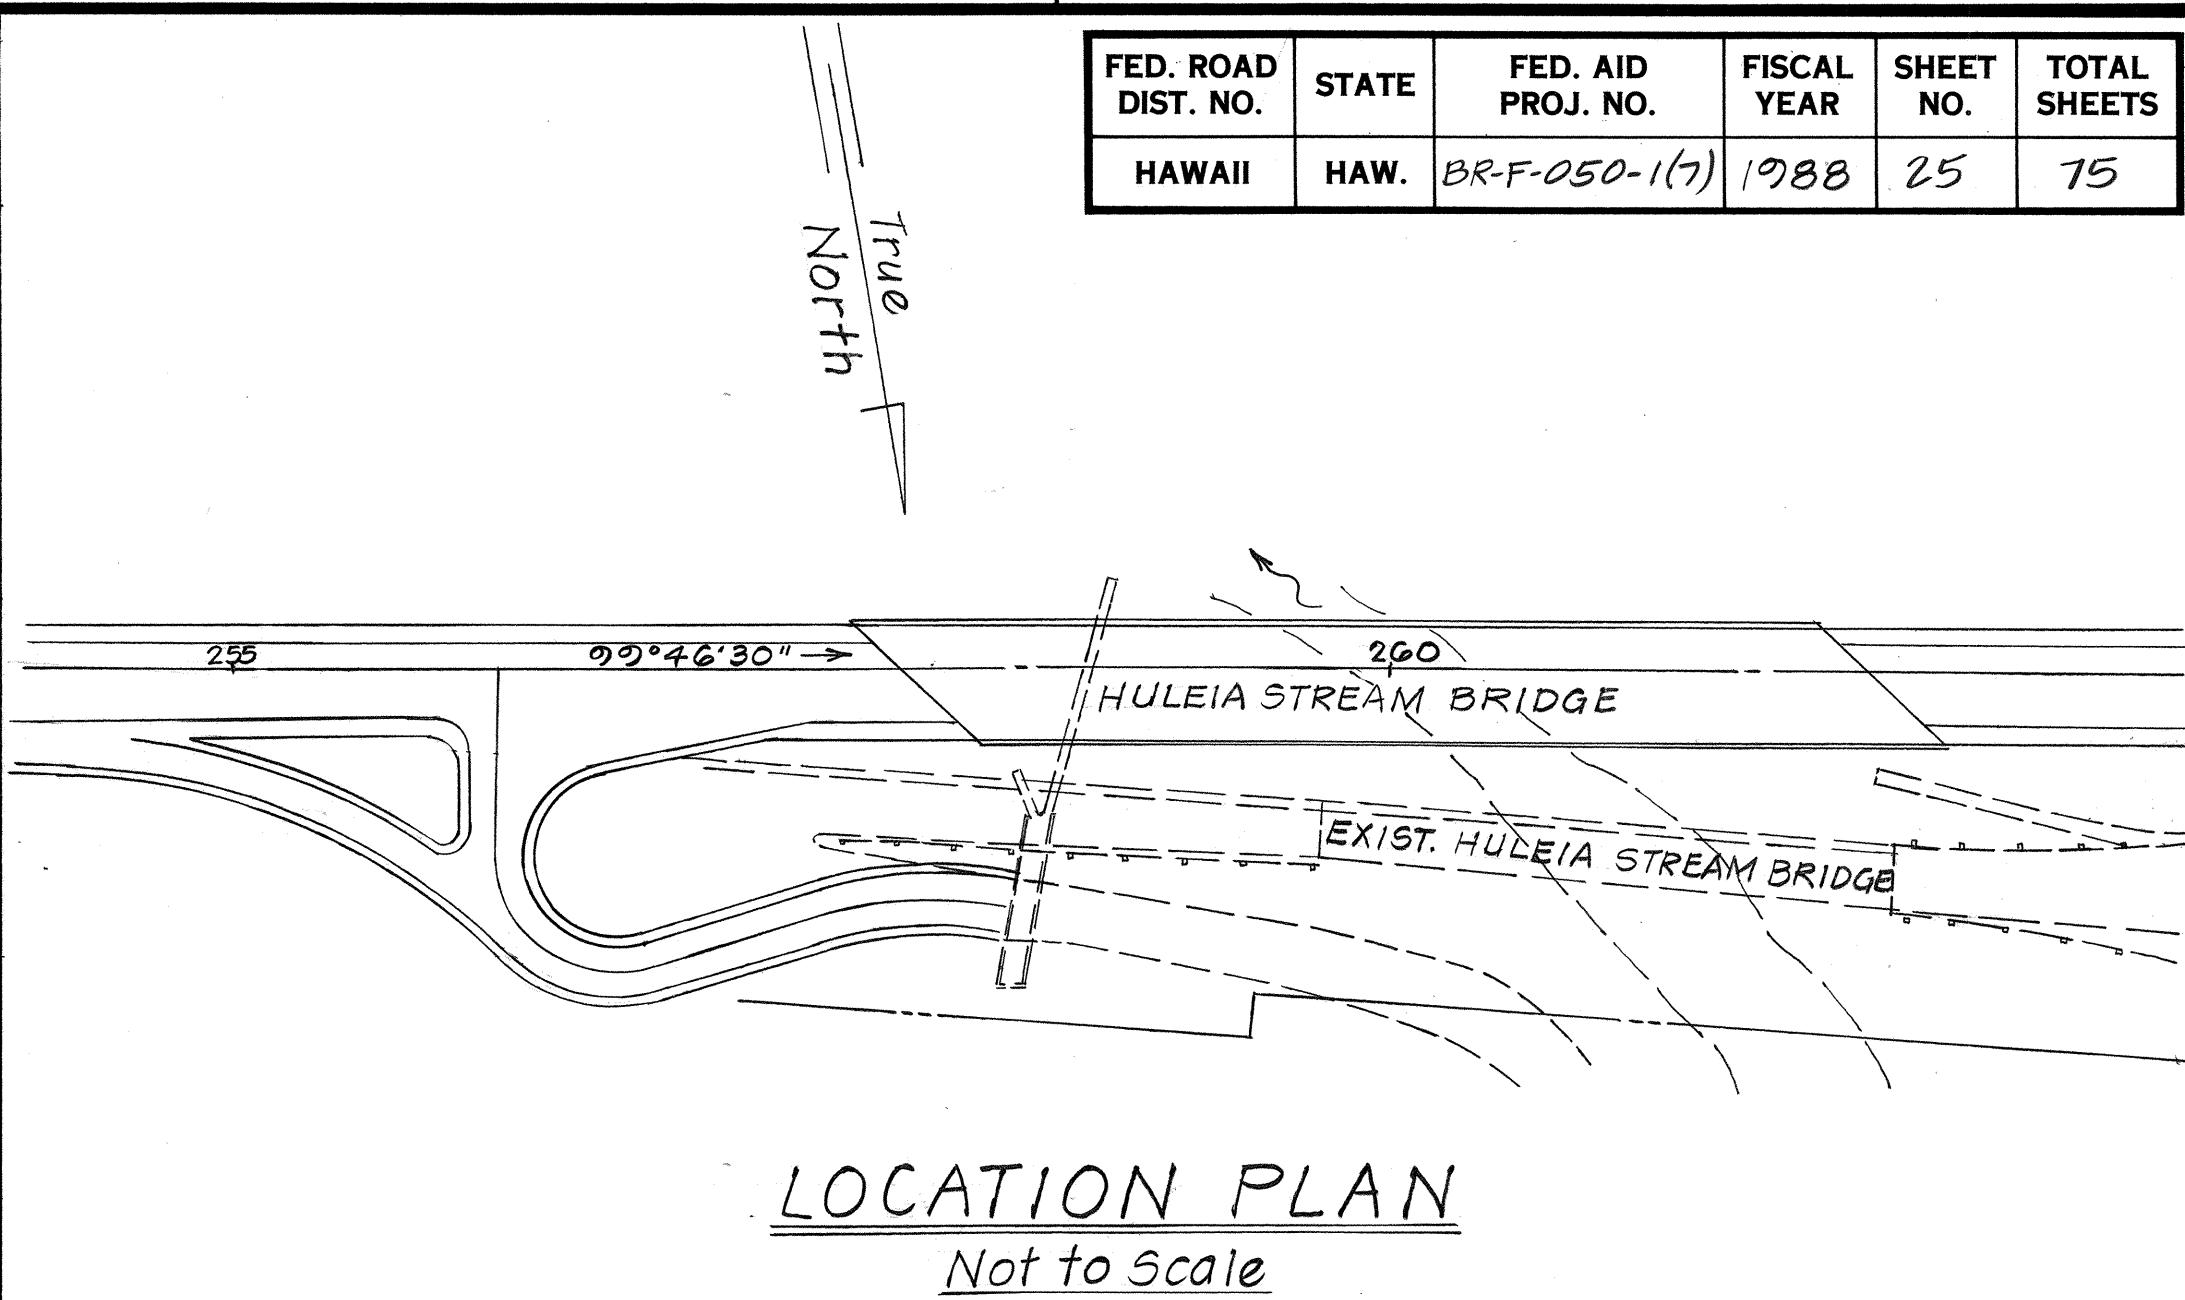

FED. ROAD DIST. NO.	STATE	FED. AID PROJ. NO.	FISCAL YEAR	SHEET NO.	TOTAL SHEETS
HAWAII	HAW.	BR-F-050-1(7)	1988	25	75

STATE OF HAWAII
DEPARTMENT OF TRANSPORTATION
HIGHWAYS DIVISION

HULEIA STREAM BRIDGE

INDEX TO DRAWINGS
EST. QUANTITIES, LOCATION PLAN

KAUMUALII HWY.
PROJ. NO. BR-F-050-1(7)

Scale: As Noted Date: Aug. 1987

SHEET No. 51 OF 22 SHEETS

GENERAL STRUCTURAL NOTES

See State of Hawaii, Dept. of Transportation
Standard Plans (1986), sht. no. B-01 & the following.

DESIGN SPECIFICATIONS:

AASHTO Standard Specifications for Highway Bridges
(13th Edition) including interim specifications for
1984, 1985 & 1986.

DESIGN LIVE LOAD: HS-20-44

ALLOWABLE DESIGN STRESSES:

Reinforced Concrete : $f_c = 0.40 f_c'$
Reinforcing Steel : $f_s = 20,000$ psi for Grade 40.
24,000 psi for Grade 60.
Prestressed Concrete : See Design Specifications

MATERIALS:

Reinforced Concrete : Class A unless noted otherwise.
Class BD for bridge deck
5,000 psi for pier columns, caps,
pedestals & footings
Reinforcing Steel : ASTM A615, Grade 40, Grade 60.
Prestress Precast Piles: See Standard Plan sheets
B-12 & B-13.
Exception: $f_c' = 6,000$ psi.



CONSTRUCTION METHODS:

1. Piles shorter than 100' shall not be spliced.
2. Pre-drilled holes for piles shall extend at least thru the compacted fill embankment. See item 505.6100 for quantities.
3. Existing ground shall be removed to a depth of 5'-0" in the vicinity of approach embankments. Embankment construction of the approach fills shall have a relative compaction of 100%. Boulders, rock fragments, hardpan or cemented gravel larger than 6 inches in greatest dimension shall not be placed under the abutments where piles are to be driven.

FOUNDATION:

1. Design load* for pile = 50 tons.
2. For Boring Logs and their location, see sheet nos. 54 & 55.
3. The pile tip elevations shown on the plans are based on boring data.
4. The Contractor shall verify the type of surface soil before starting to drive any pile. The annular space around the piles in the drilled holes in embankment shall be backfilled as specified in the Special Provisions, Section 50503.
5. Test piles indicated in Foundation Plan shall be furnished 5' longer than regular piles.
6. Estimated downdrag load = 51 tons.

* Design load for piles excludes pile weight & estimated downdrag.

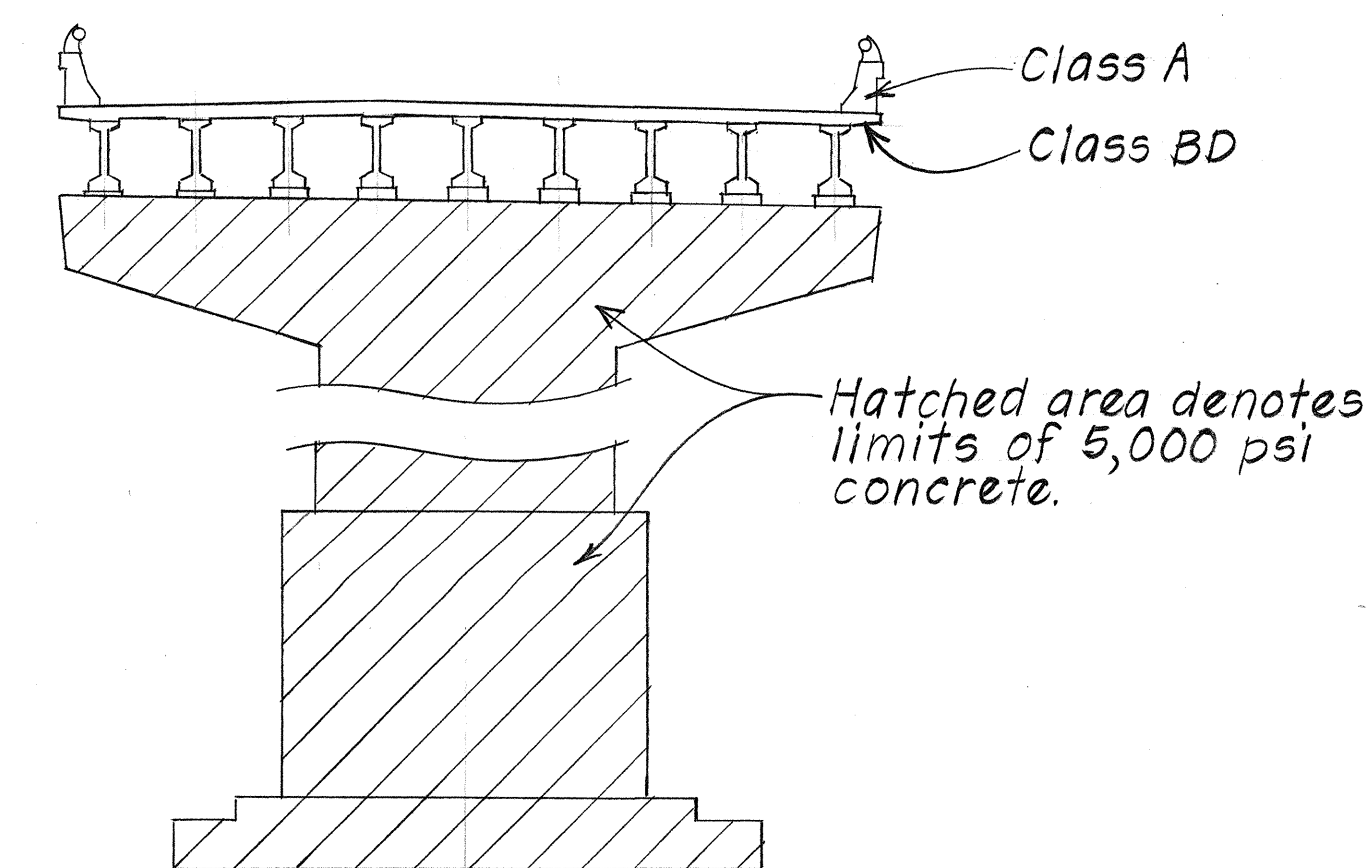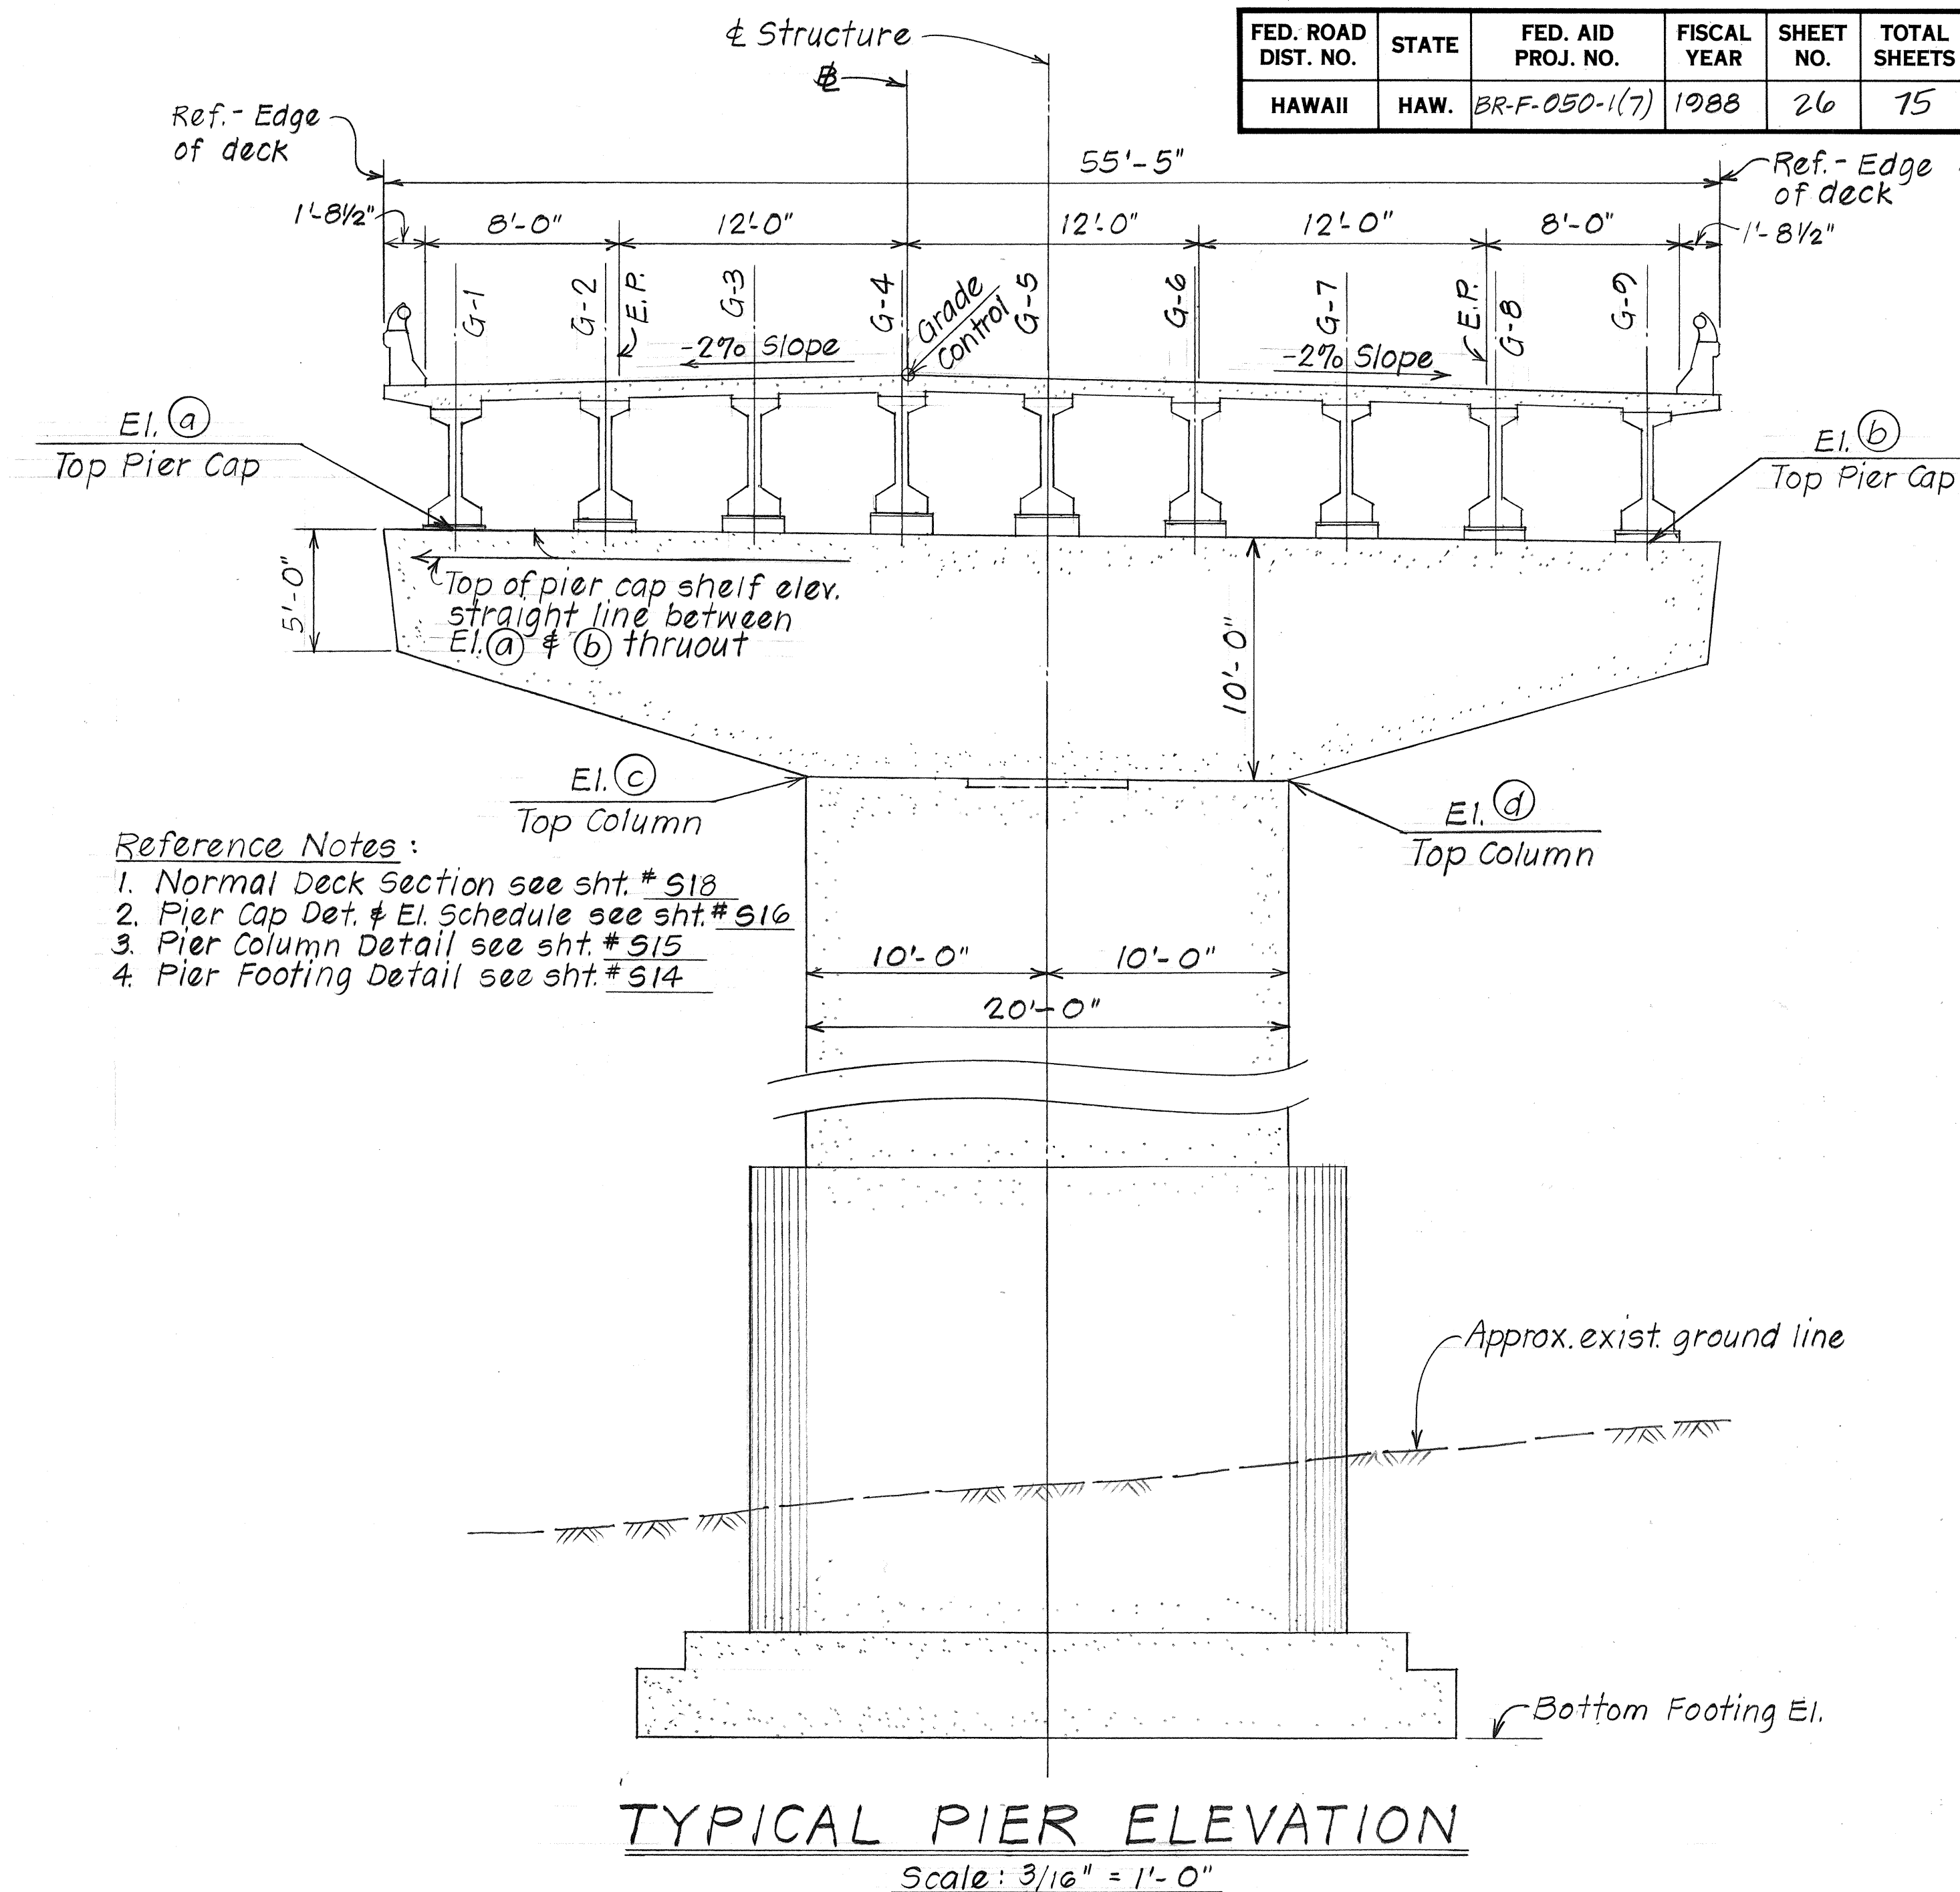



**TYPICAL DETAIL SHOWING CLASS CONCRETE
& LIMITS OF 5,000 PSI CONCRETE AT PIERS**

Not to Scale

FED. ROAD DIST. NO.	STATE	FED. AID PROJ. NO.	FISCAL YEAR	SHEET NO.	TOTAL SHEETS
HAWAII	HAW.	BR-F-050-1(7)	1988	26	75

STATE OF HAWAII DEPARTMENT OF TRANSPORTATION HIGHWAYS DIVISION	
HULEIA STREAM BRIDGE	
GENERAL STRUCTURAL NOTES	
TYPICAL PIER ELEVATION	
KAUMUALII HWY.	
PROJ. NO. BR-F-050-1(7)	
Scale: As Noted	Date: Aug. 1987
SHEET NO. 52 OF 22 SHEETS	


FED. ROAD DIST. NO.	STATE	FED. AID PROJ. NO.	FISCAL YEAR	SHEET NO.	TOTAL SHEETS
HAWAII	HAW.	BR-F-050-1(7)	1988	27	75

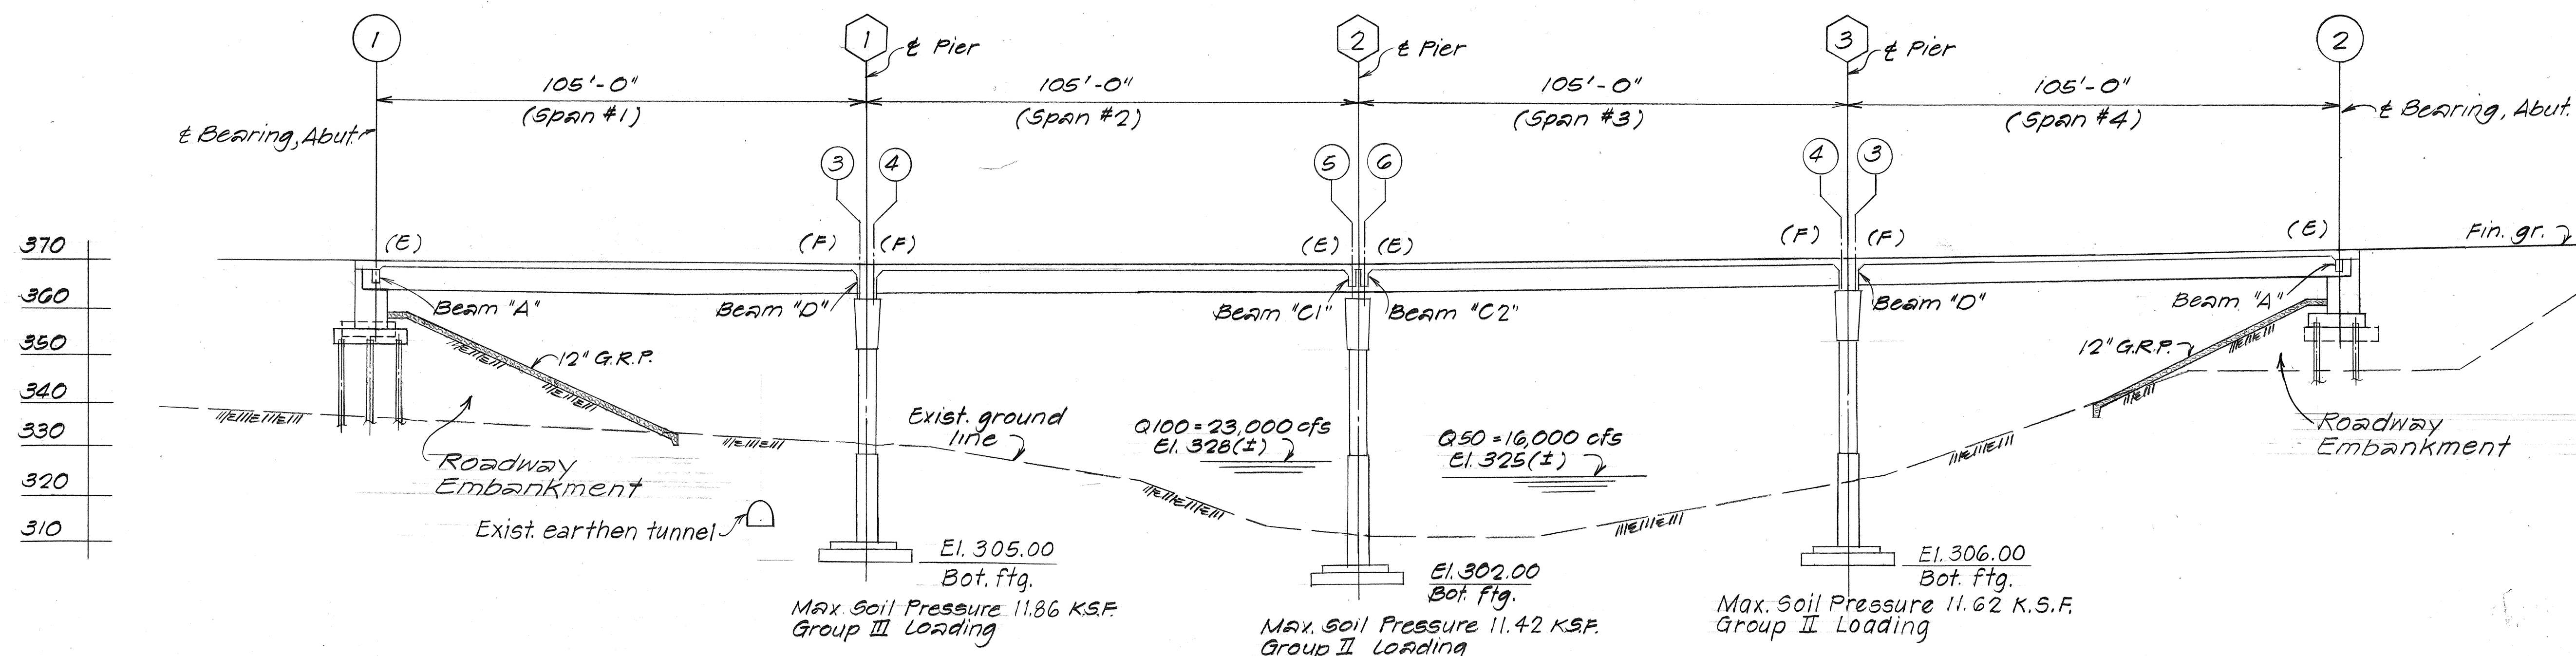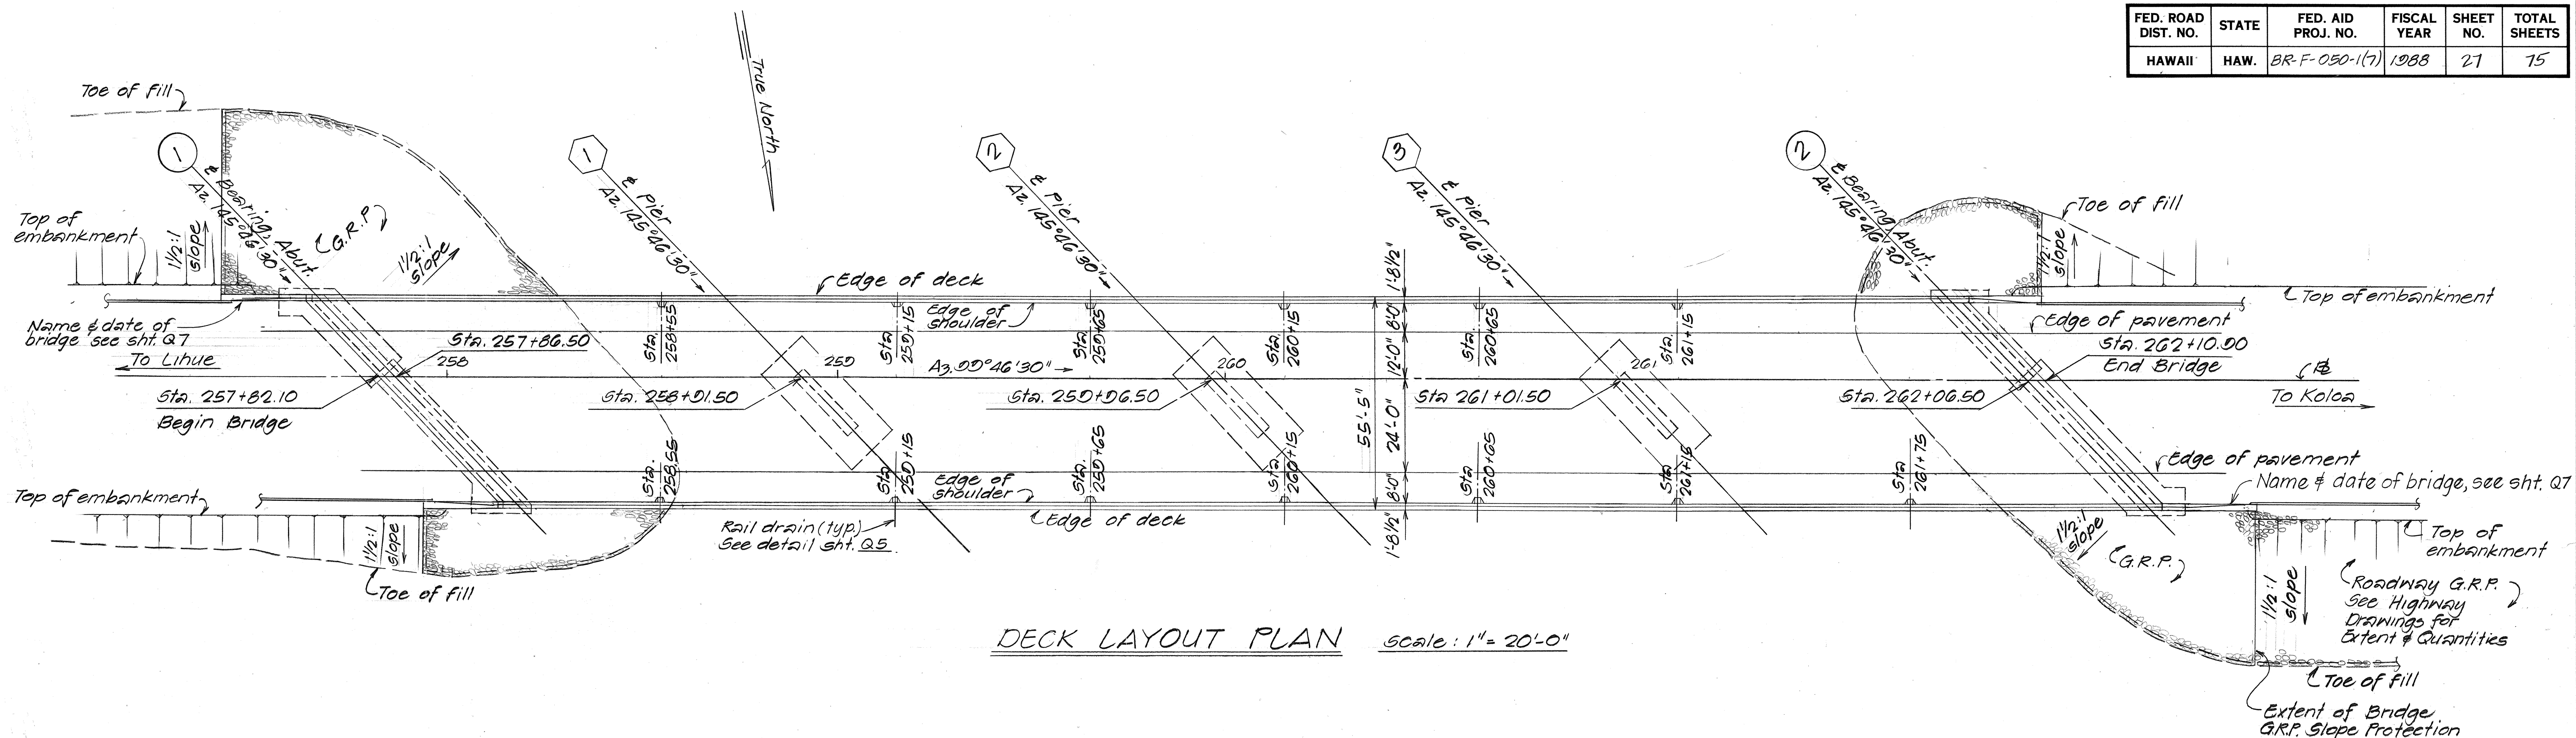

ORIGINAL PLAN	DATE	1987
DRAWN BY	H.F.	
CHECKED BY	D.C.O. & S.A.	
NOTED BY	L.M.A. & H.F.	
CHECKED BY	D.C.O. & G.T.	

STATE OF HAWAII
DEPARTMENT OF TRANSPORTATION
HIGHWAYS DIVISION
HULEIA STREAM BRIDGE
LAYOUT PLAN, LONGITUDINAL
SECTION ALONG #1
KAUMUALII HWY.
PROJ. NO. BR-F-050-1(7)
Scale: As Noted Date: Aug. 1987
SHEET NO. 53 OF 22 SHEETS

FED. ROAD DIST. NO.	STATE	FED. AID PROJ. NO.	FISCAL YEAR	SHEET NO.	TOTAL SHEETS
HAWAII	HAW.	BR-F-050-1(7)	1988	20	75

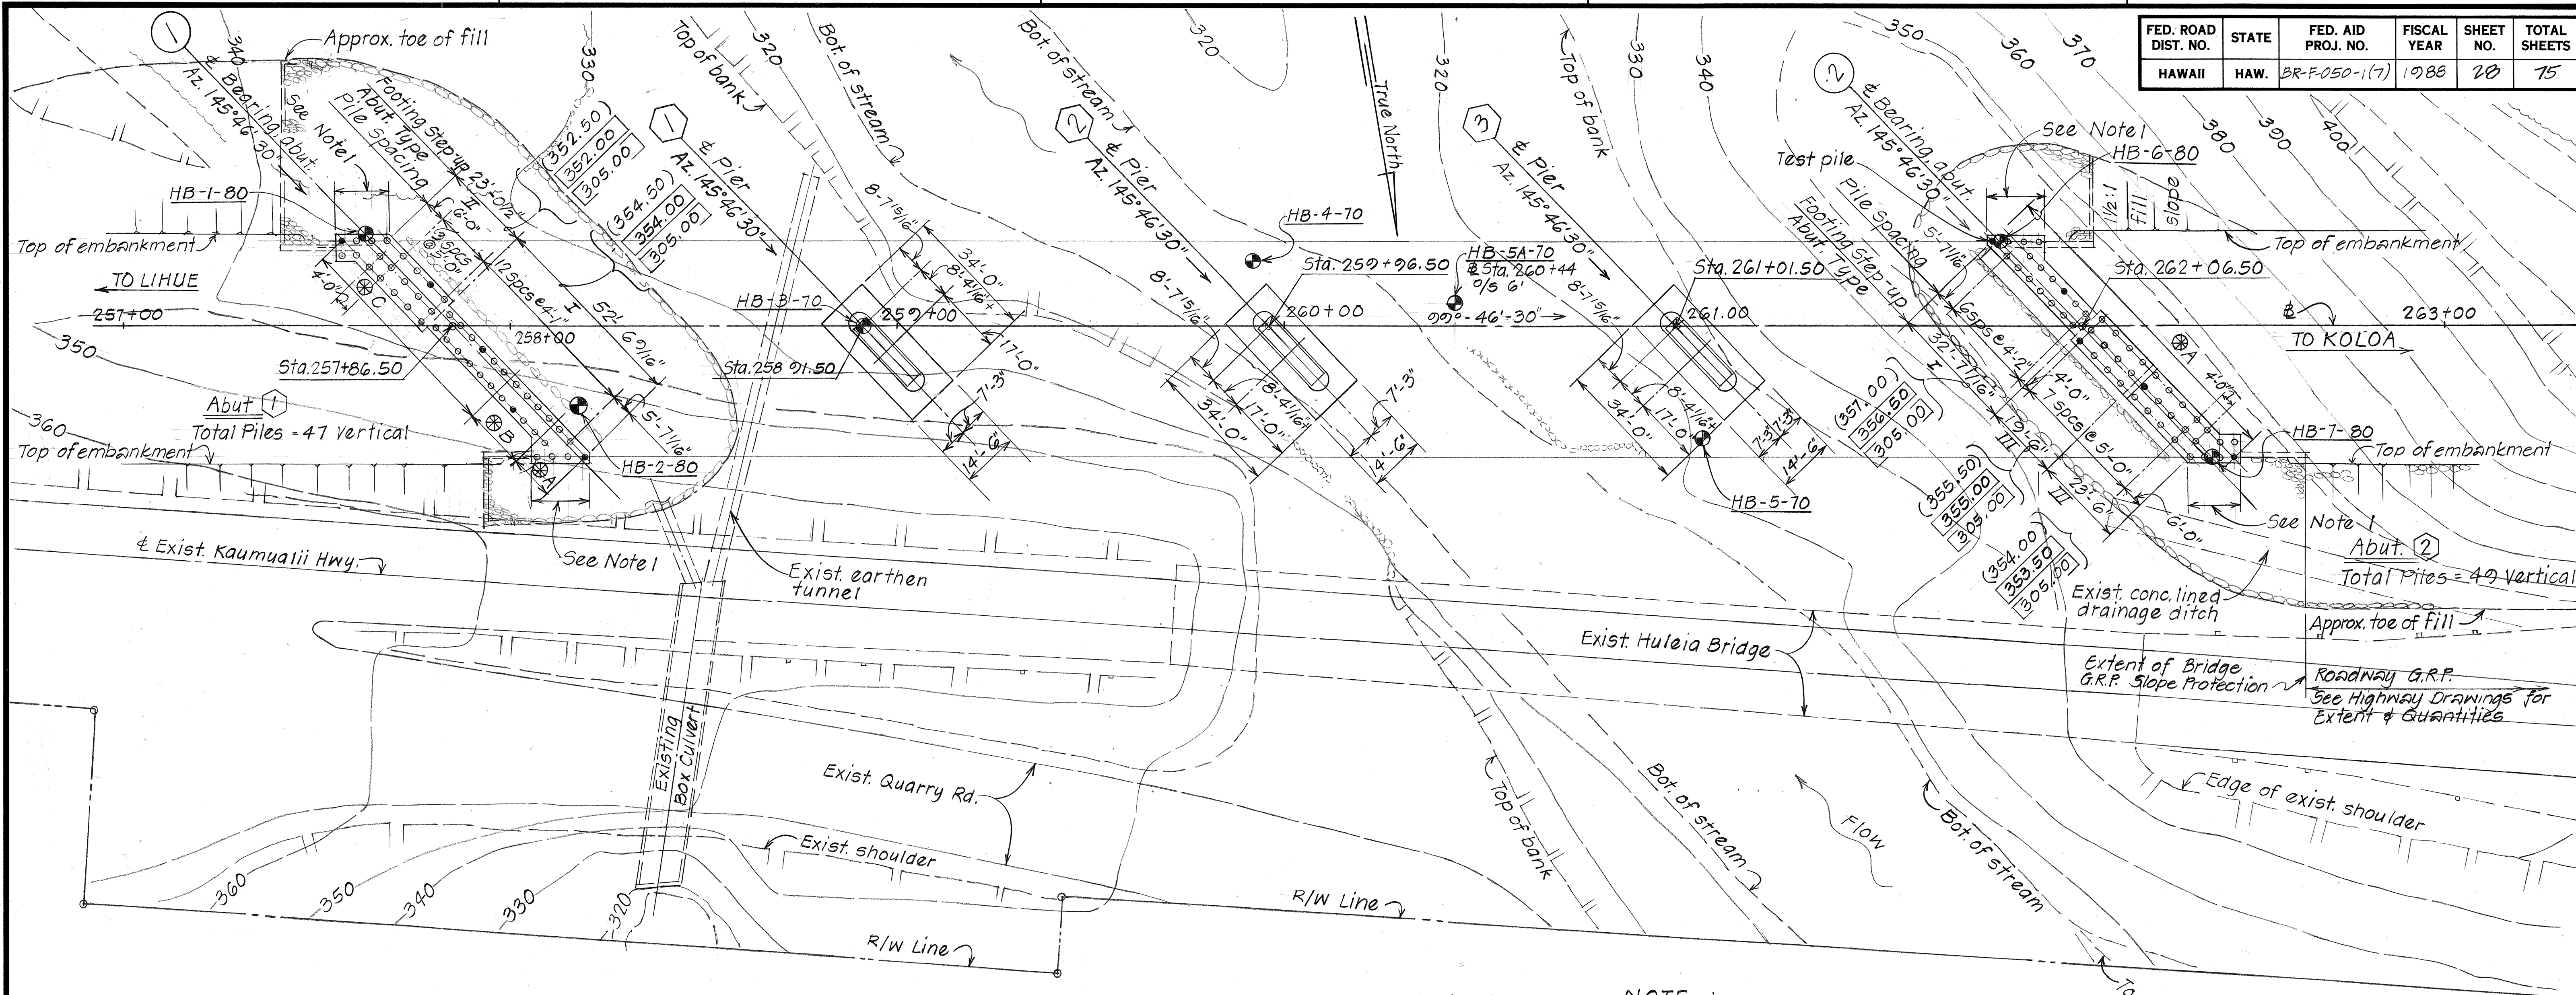

FOUNDATION PLAN

Scale: 1" = 20'-0"

NOTE:
1. For additional footing dimension & pile layout see sht. # S13.

LEGEND

- = Denotes vertical piles
- = Test piles
- (0.00) = Pile cut-off elevation
- 0.00 = Bottom footing elevation
- 0.00 = Pile tip elevation

⊗ Pre-Drill Tip Elevation

A = El. 340
B = El. 335
C = El. 330









STATE OF HAWAII
DEPARTMENT OF TRANSPORTATION
HIGHWAYS DIVISION
HULEIA STREAM BRIDGE
FOUNDATION PLAN

KAUMUALII HWY.
PROJ. NO. BR-F-050-1(7)
Scale: As Noted Date: Aug 1987

SHEET No. 24 OF 22 SHEETS

ORIGINAL PLAN	DATE
NO.	
SURVEY PLOTTED BY	
DRAWN BY	
TRACED BY	
QUANTITIES BY	
CHECKED BY	

FED. ROAD DIST. NO.	STATE	FED. AID PROJ. NO.	FISCAL YEAR	SHEET NO.	TOTAL SHEETS
HAWAII	HAW.	BR-F-050-1(7)	1988	29	75

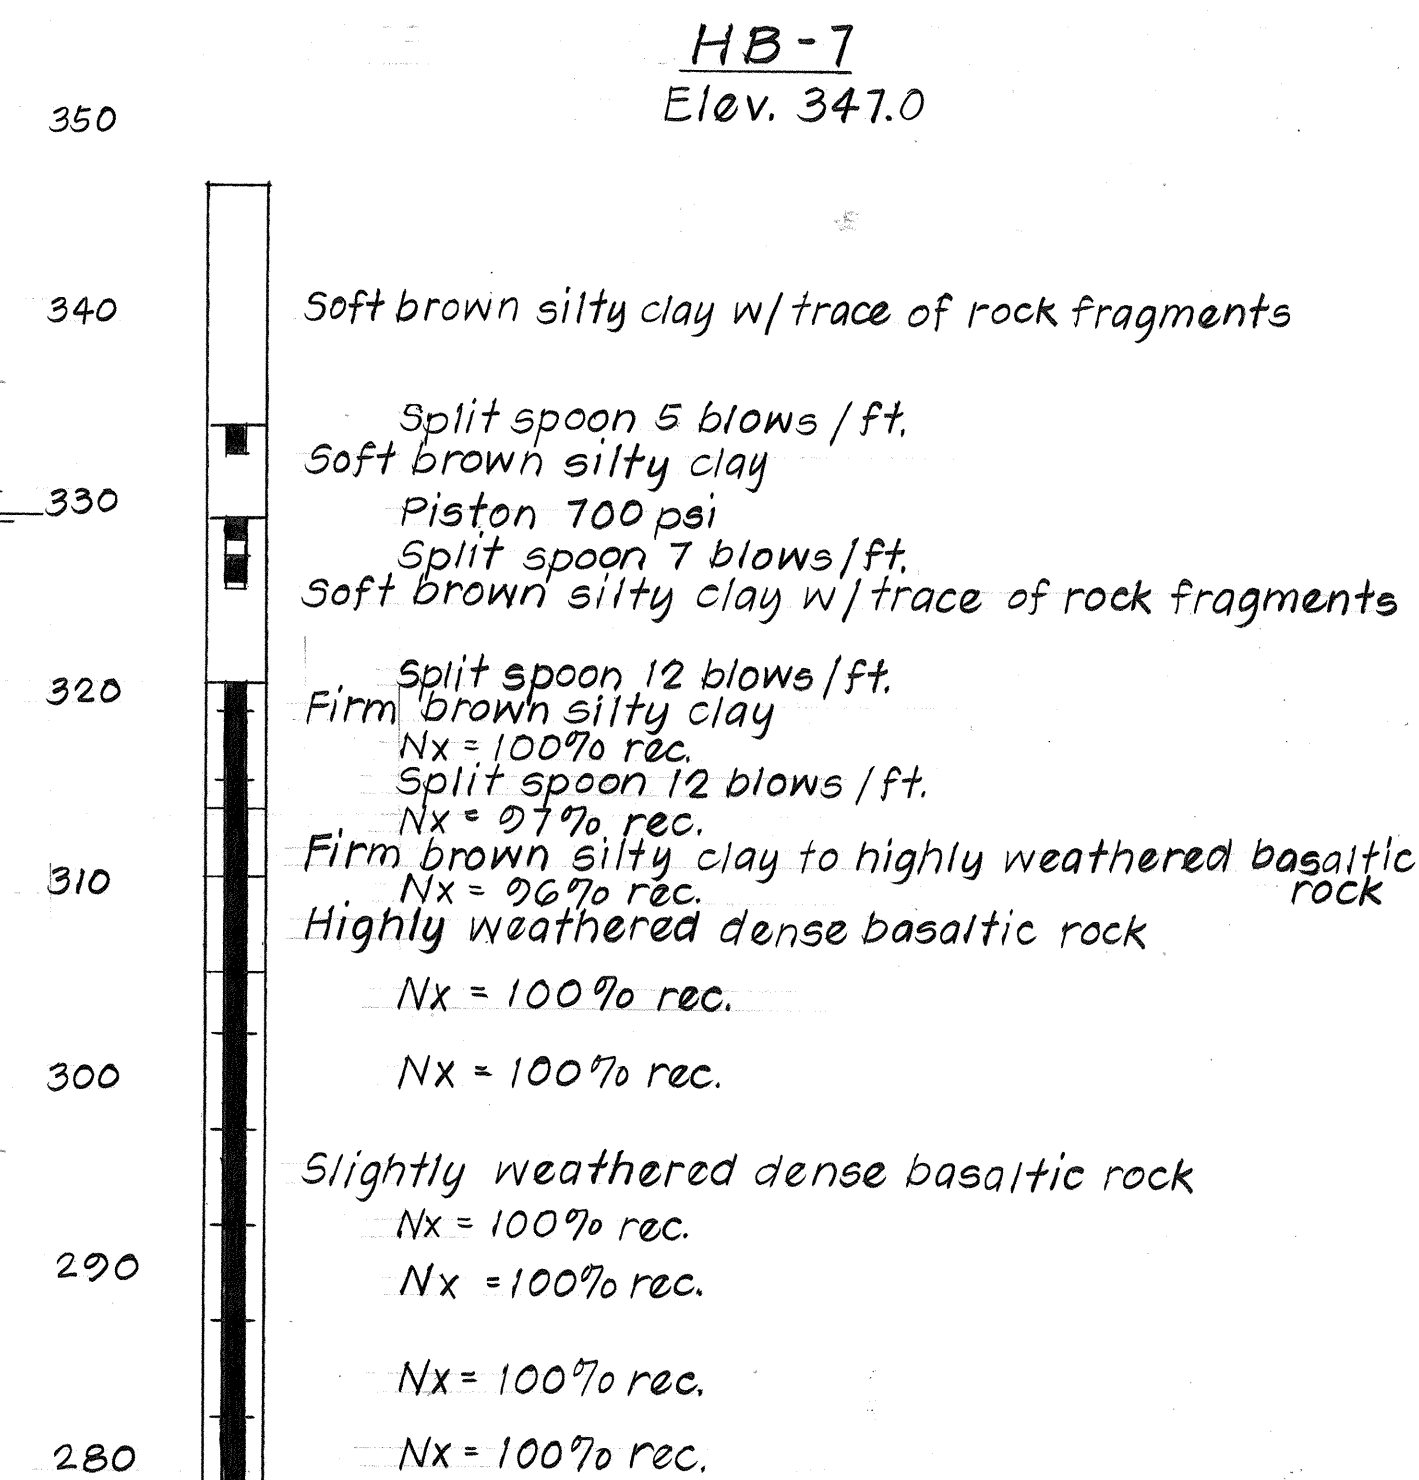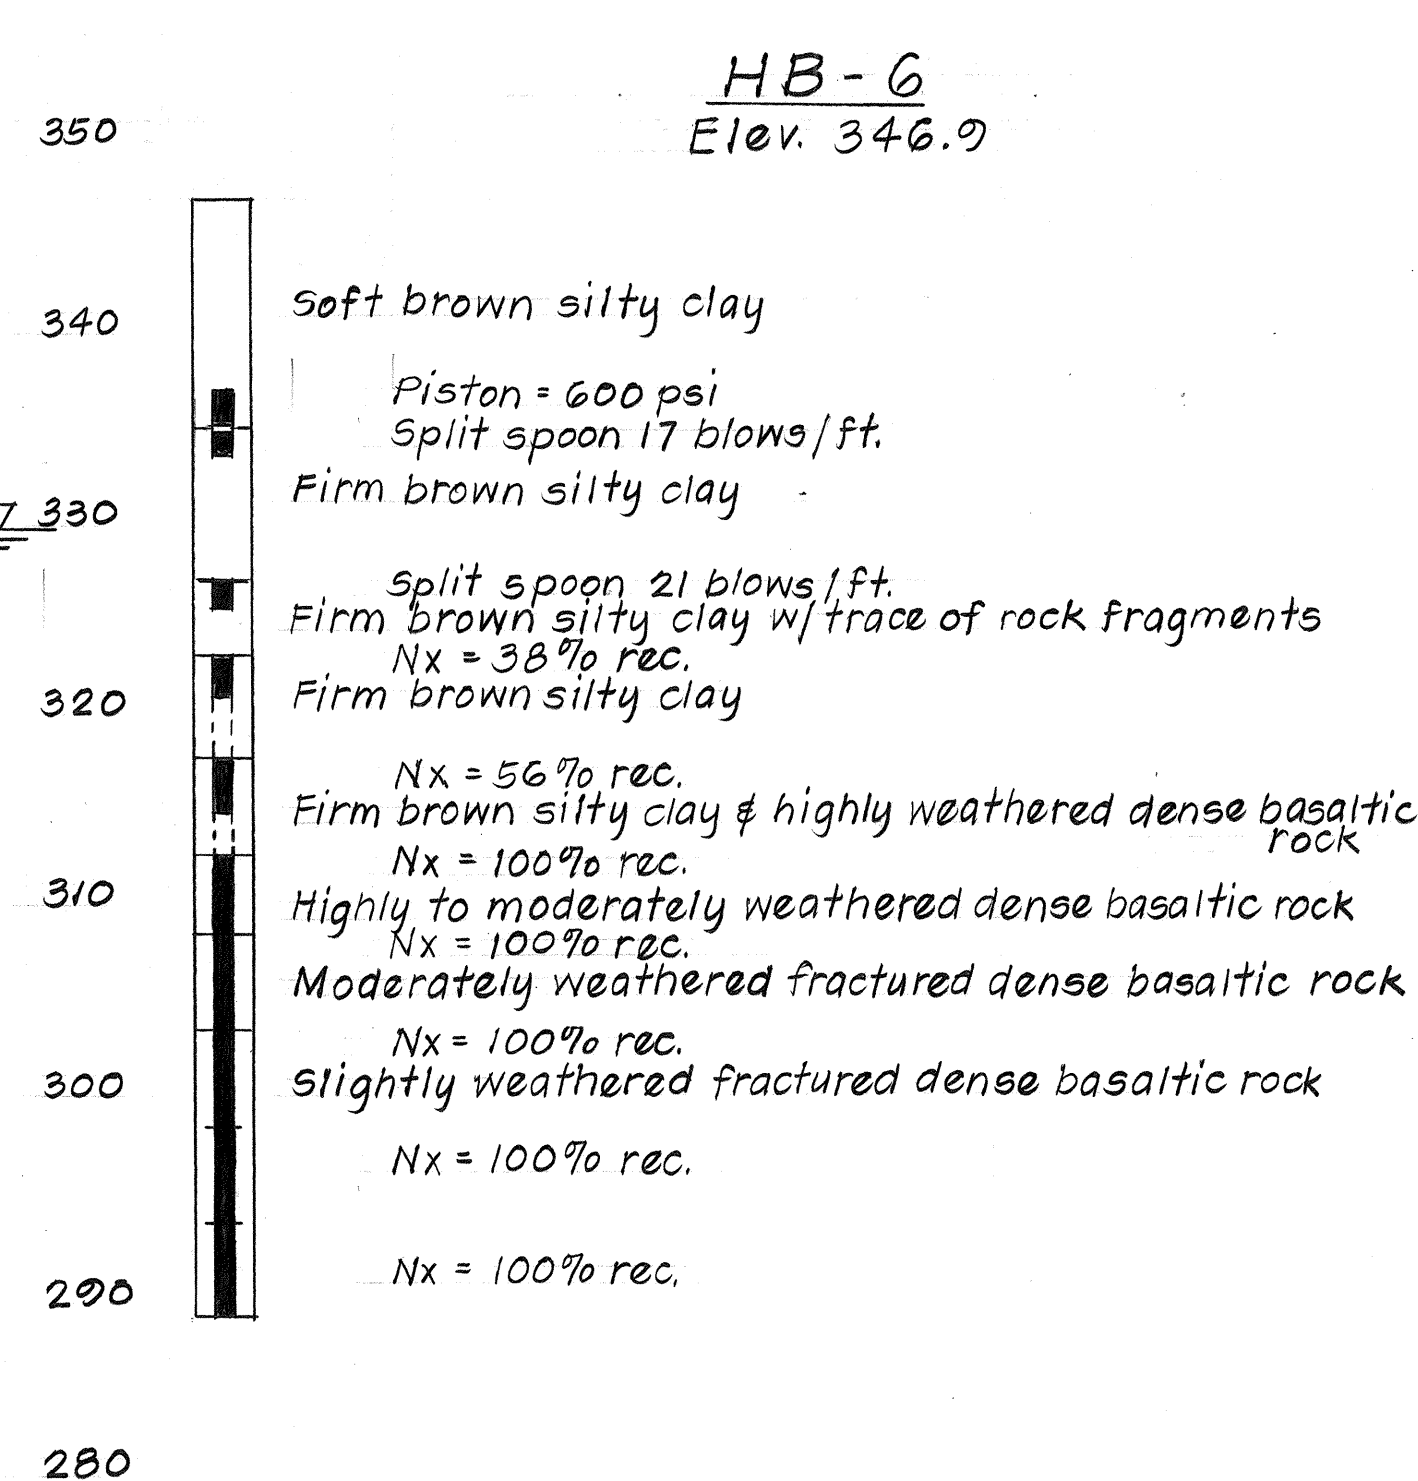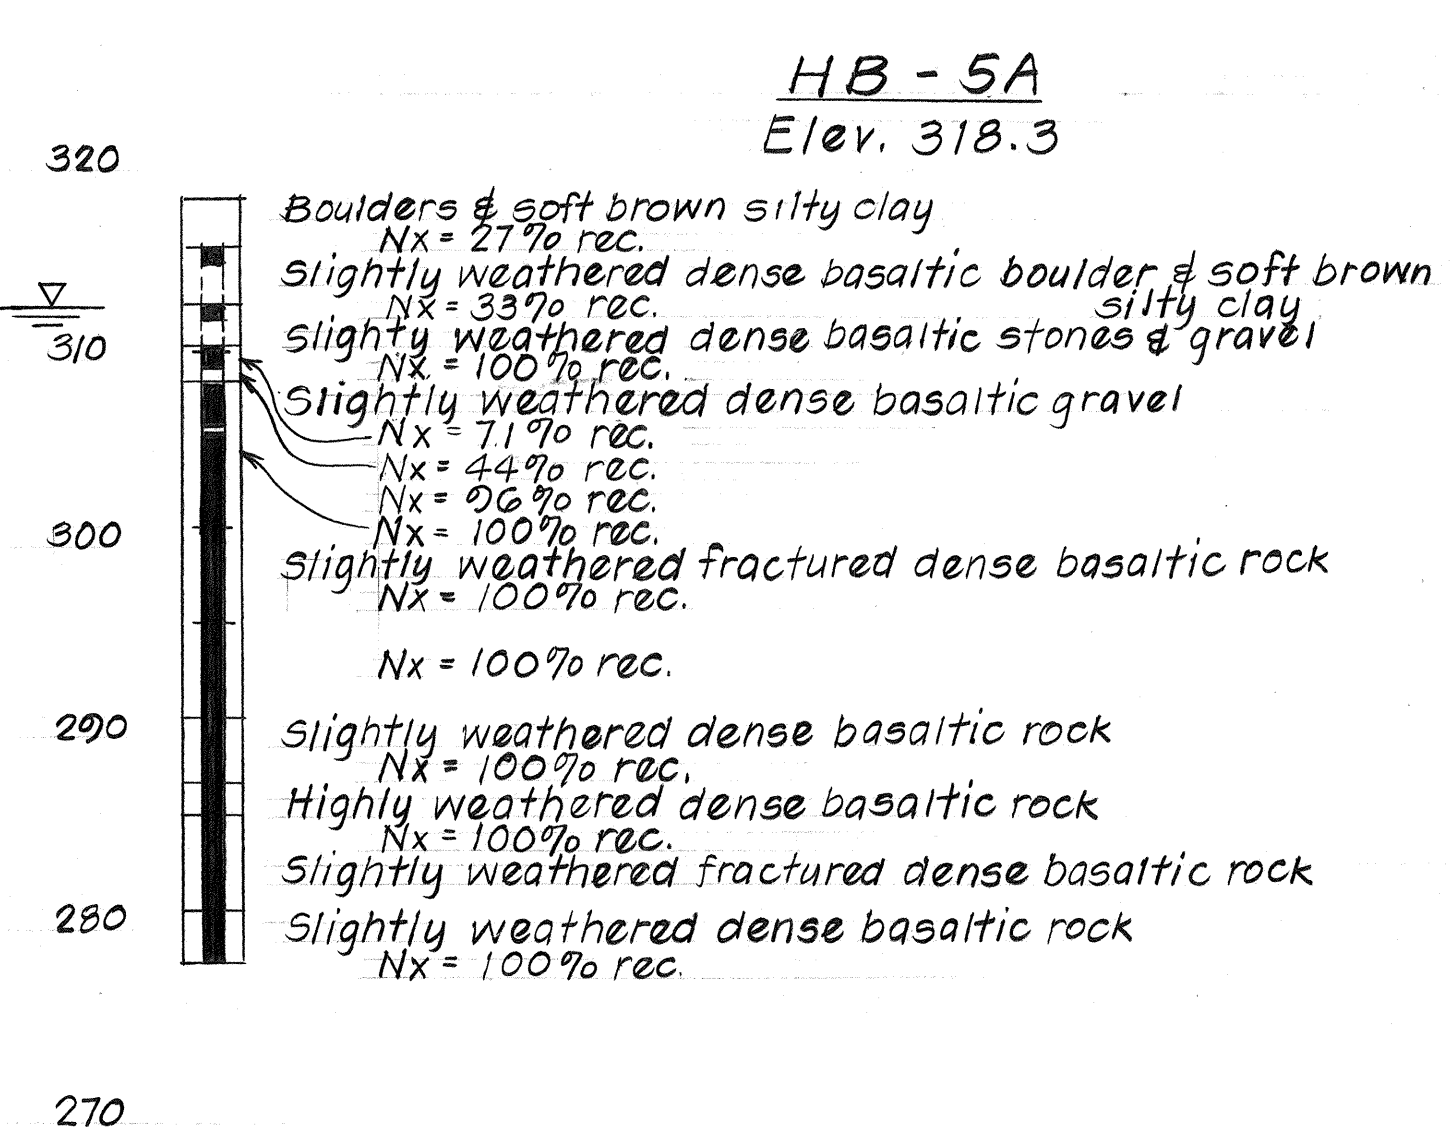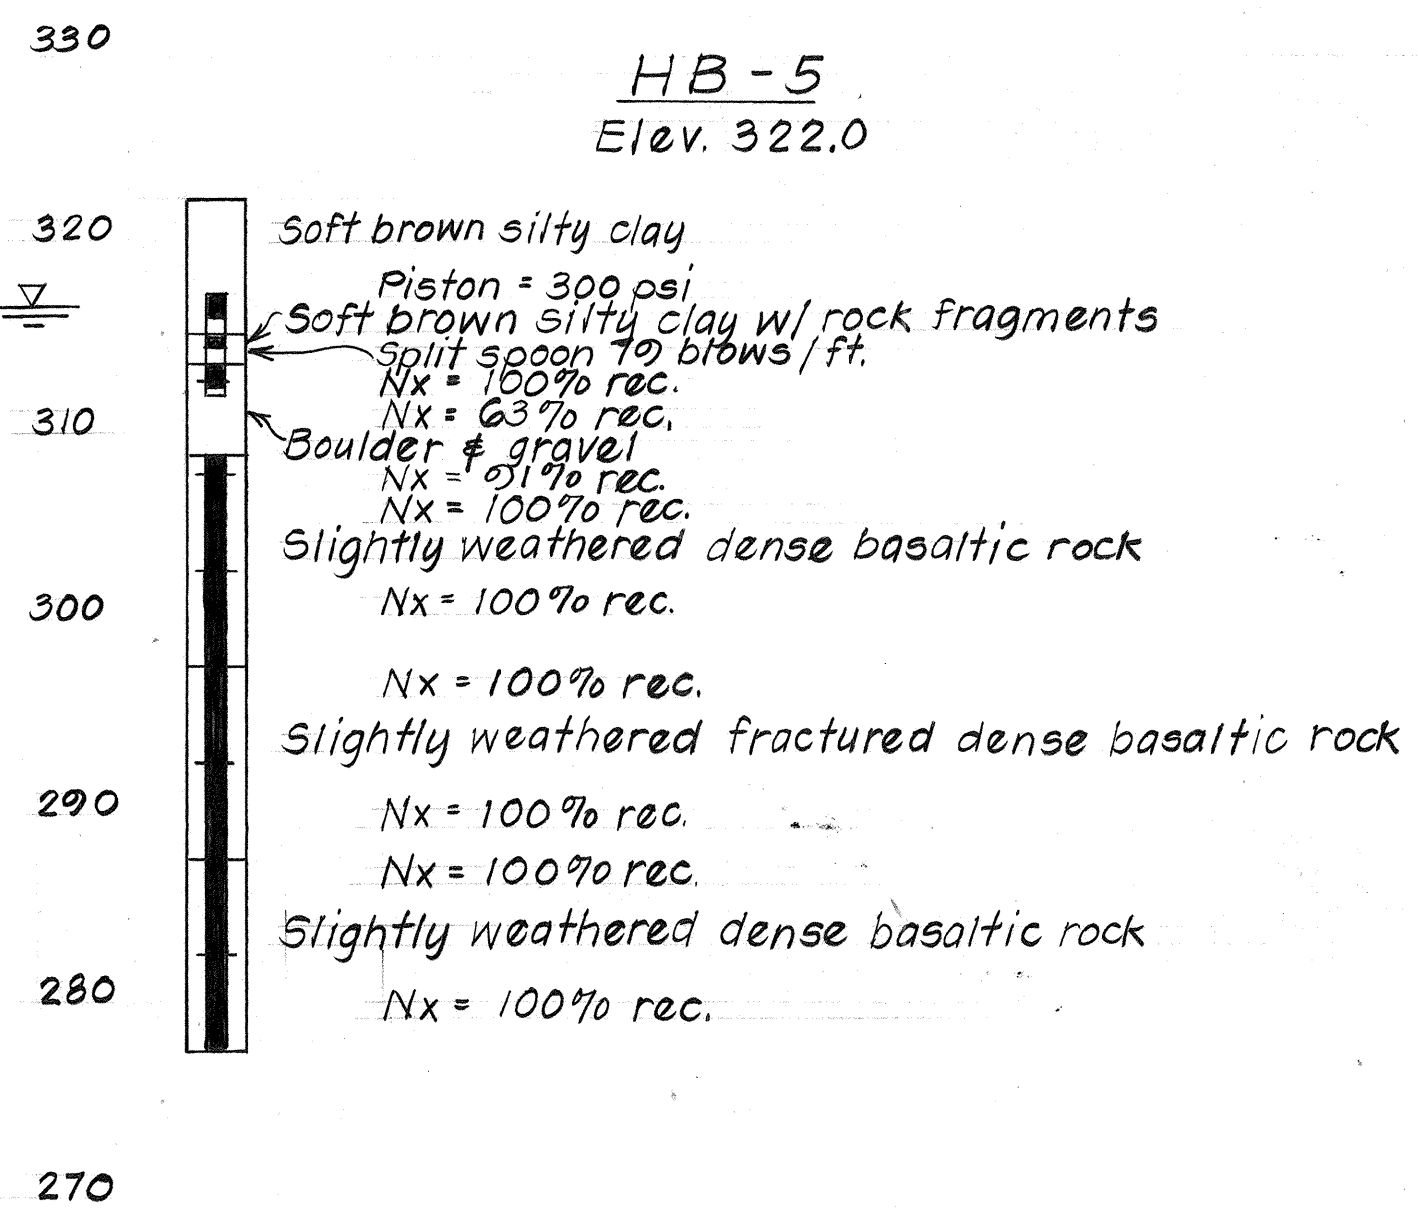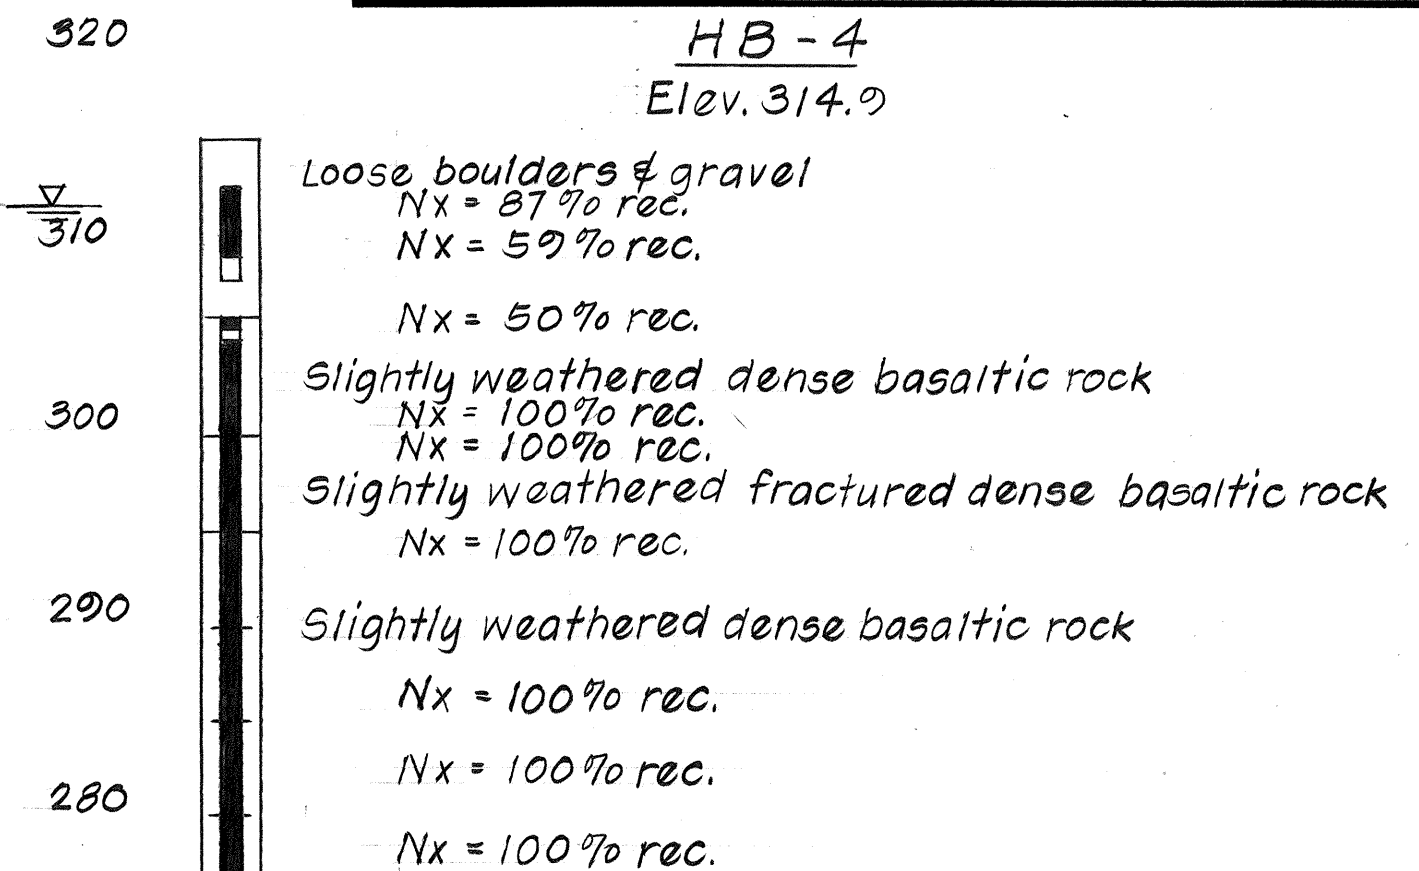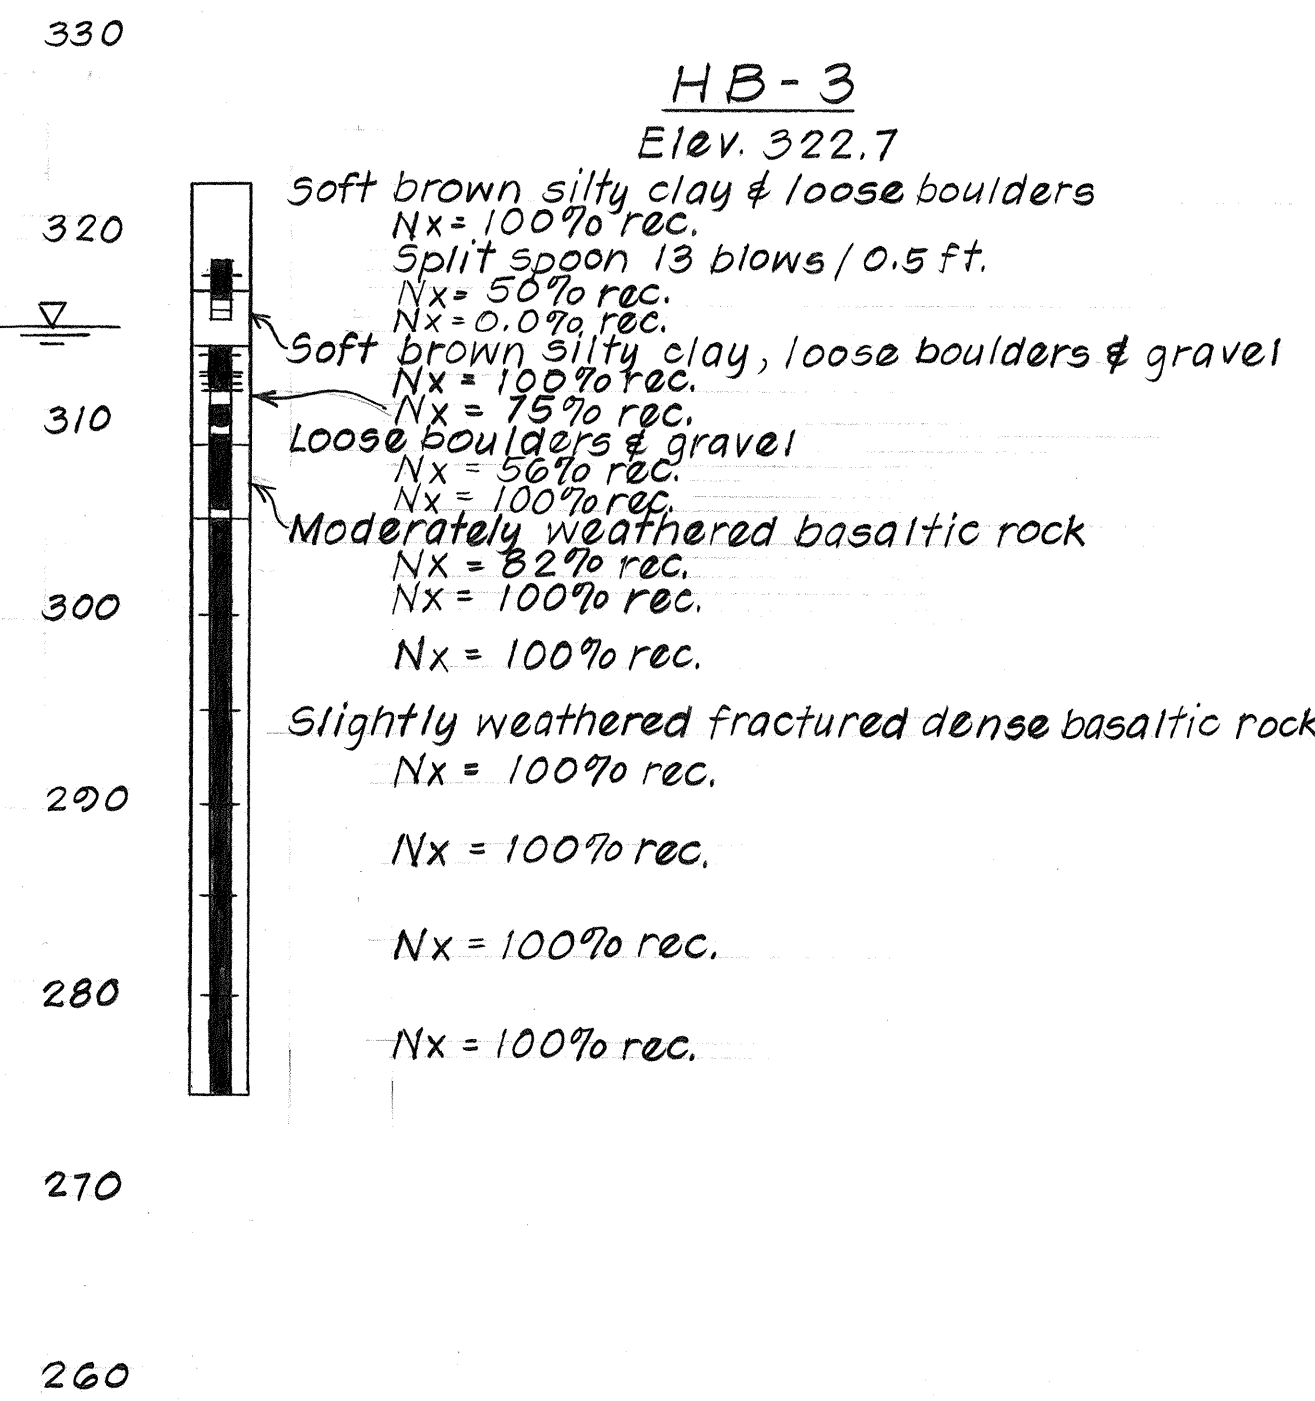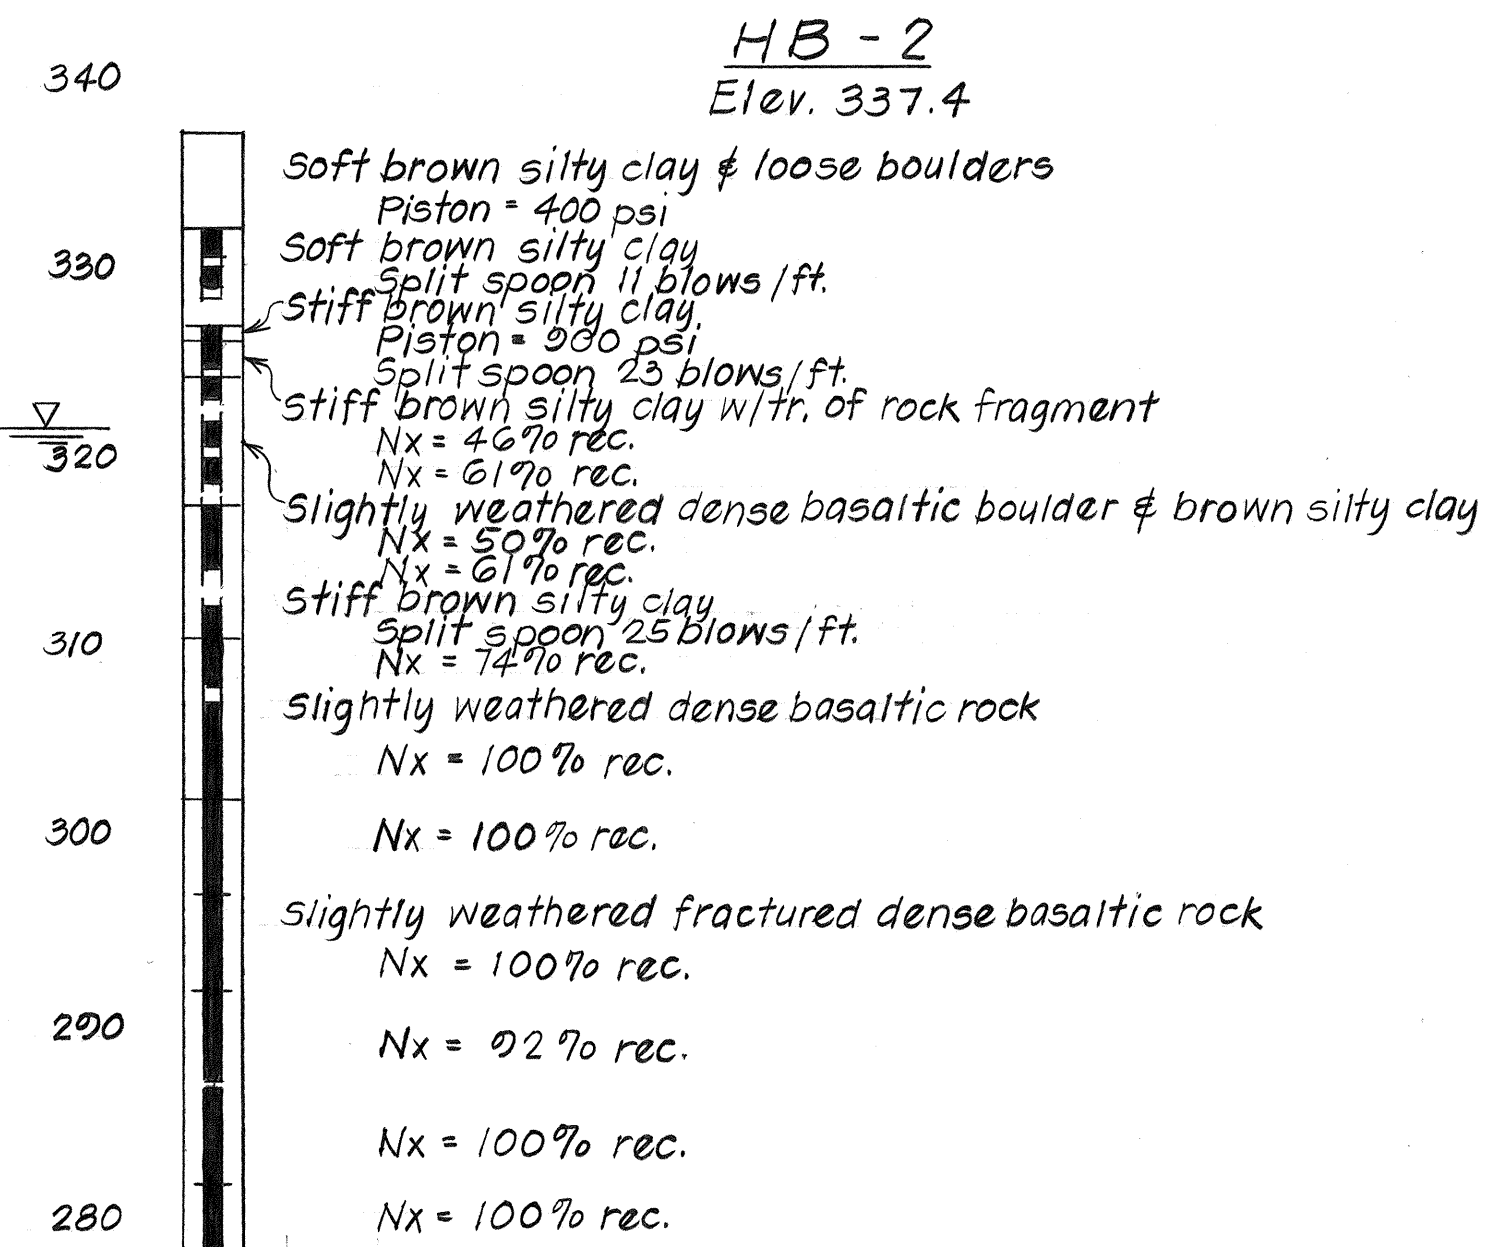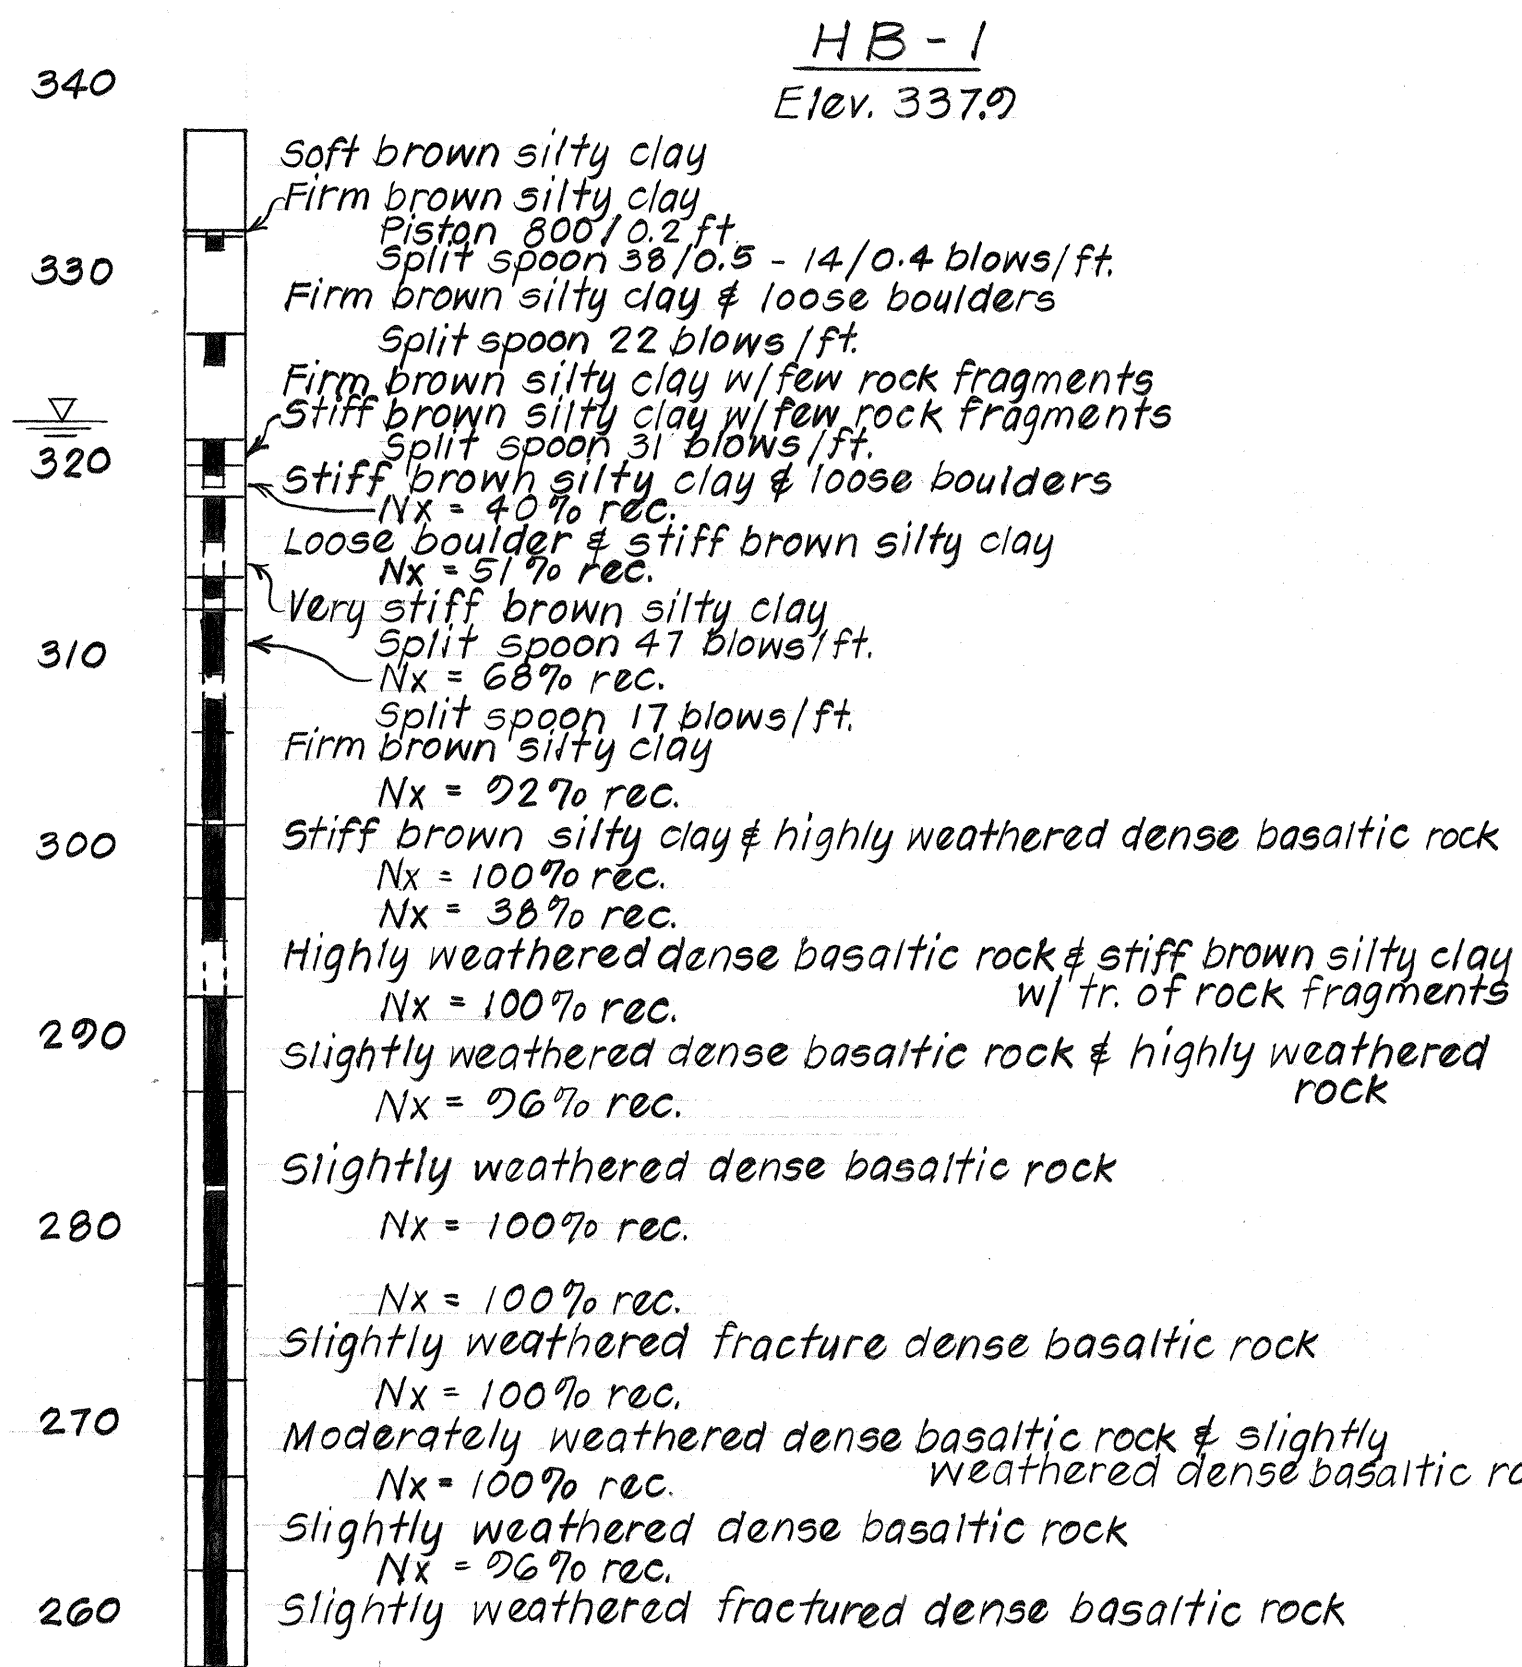

BORING LOGS

STATE OF HAWAII
DEPARTMENT OF TRANSPORTATION
HIGHWAYS DIVISION
HULEIA STREAM BRIDGE
BORING LOGS
KAUMUALII HWY.
PROJ. NO. BR-F-050-1(7)
Scale: As Noted Date: Aug. 1987
SHEET NO. 35 OF 22 SHEETS

SURVEY PLOTTED BY	DATE
DRAWN BY	
TRACED BY	
NOTED BY	
QUANTITIES BY	
CHECKED BY	
ORIGINAL PLAN	
NOTE BOOK	
NO.	

The diagram illustrates a cross-section of a bridge deck with various elevation points and stationing. The deck is divided into sections by vertical lines, with elevations noted at the top and bottom of each section. The top elevations range from 369.07 to 373.48, and the bottom elevations range from 368.72 to 373.00. The stationing is marked along the bottom, starting from Sta. 257+82.10 (Begin Bridge) and ending at Sta. 262+10.90 (End Bridge). The diagram also shows the 'Edge of pavement' and 'Edge of deck' for both the top and bottom surfaces. A table in the upper right corner provides project details.

FED. ROAD DIST. NO.	STATE	FED. AID PROJ. NO.	FISCAL YEAR	SHEET NO.
HAWAII	HAW.	BR-F-050-1(7)	1988	30

Hand-drawn diagram of a vertical curve. The horizontal axis is divided into two 1000' V.C. segments. The vertical axis is labeled 'ELEVATION' and has a scale from 0 to 100. The curve starts at a -4.00% grade and ends at a +3.76% grade. Key points marked include: PVI at station 254+00, C.G. at station 250+00, and E.V.C. at station 264+00. The curve is labeled 'Bearing Abut #1' and 'Bearing Abut #2'. The elevation at the C.G. is 350.45, and the elevation at the E.V.C. is 378.25. The elevation at the PVI is 370.45.


ABUT. TYPE ITEM	I	II	III
"a"	1'-6"	3'-0"	3'-0"
"b"	2'-0"	2'-0"	2'-0"
"c"	7'-0"	11'-0"	11'-0"
"a" bars	#6 @ 11	#7 @ 12	#7 @ 10
short "a" bars	#6 @ 11	#7 @ 12	#7 @ 10
"b" bars	#7 @ 12	#8 @ 12	#8 @ 12
"c" bars	#6 @ 11	#6 @ 11 1/2	#6 @ 11 1/2

STATE OF HAWAII
DEPARTMENT OF TRANSPORTATION
HIGHWAYS DIVISION


HULEIA STREAM BRIDGE
DECK FINISH GRADE, TYP. ABUT. SECT.
ABUT. EXC. & BACKFILL, & ROADWAY PROFILE
KAUMUALII HWY.
PROJ. NO. BR-F-050-1(7)
Scale: As Noted Date: Aug. 1987

SHEET NO. 56 OF 22 SHEETS

FED. ROAD DIST. NO.	STATE	FED. AID PROJ. NO.	FISCAL YEAR	SHEET NO.	TOTAL SHEETS
HAWAII	HAW.	BR-F-050-1(7)	1988	31	75

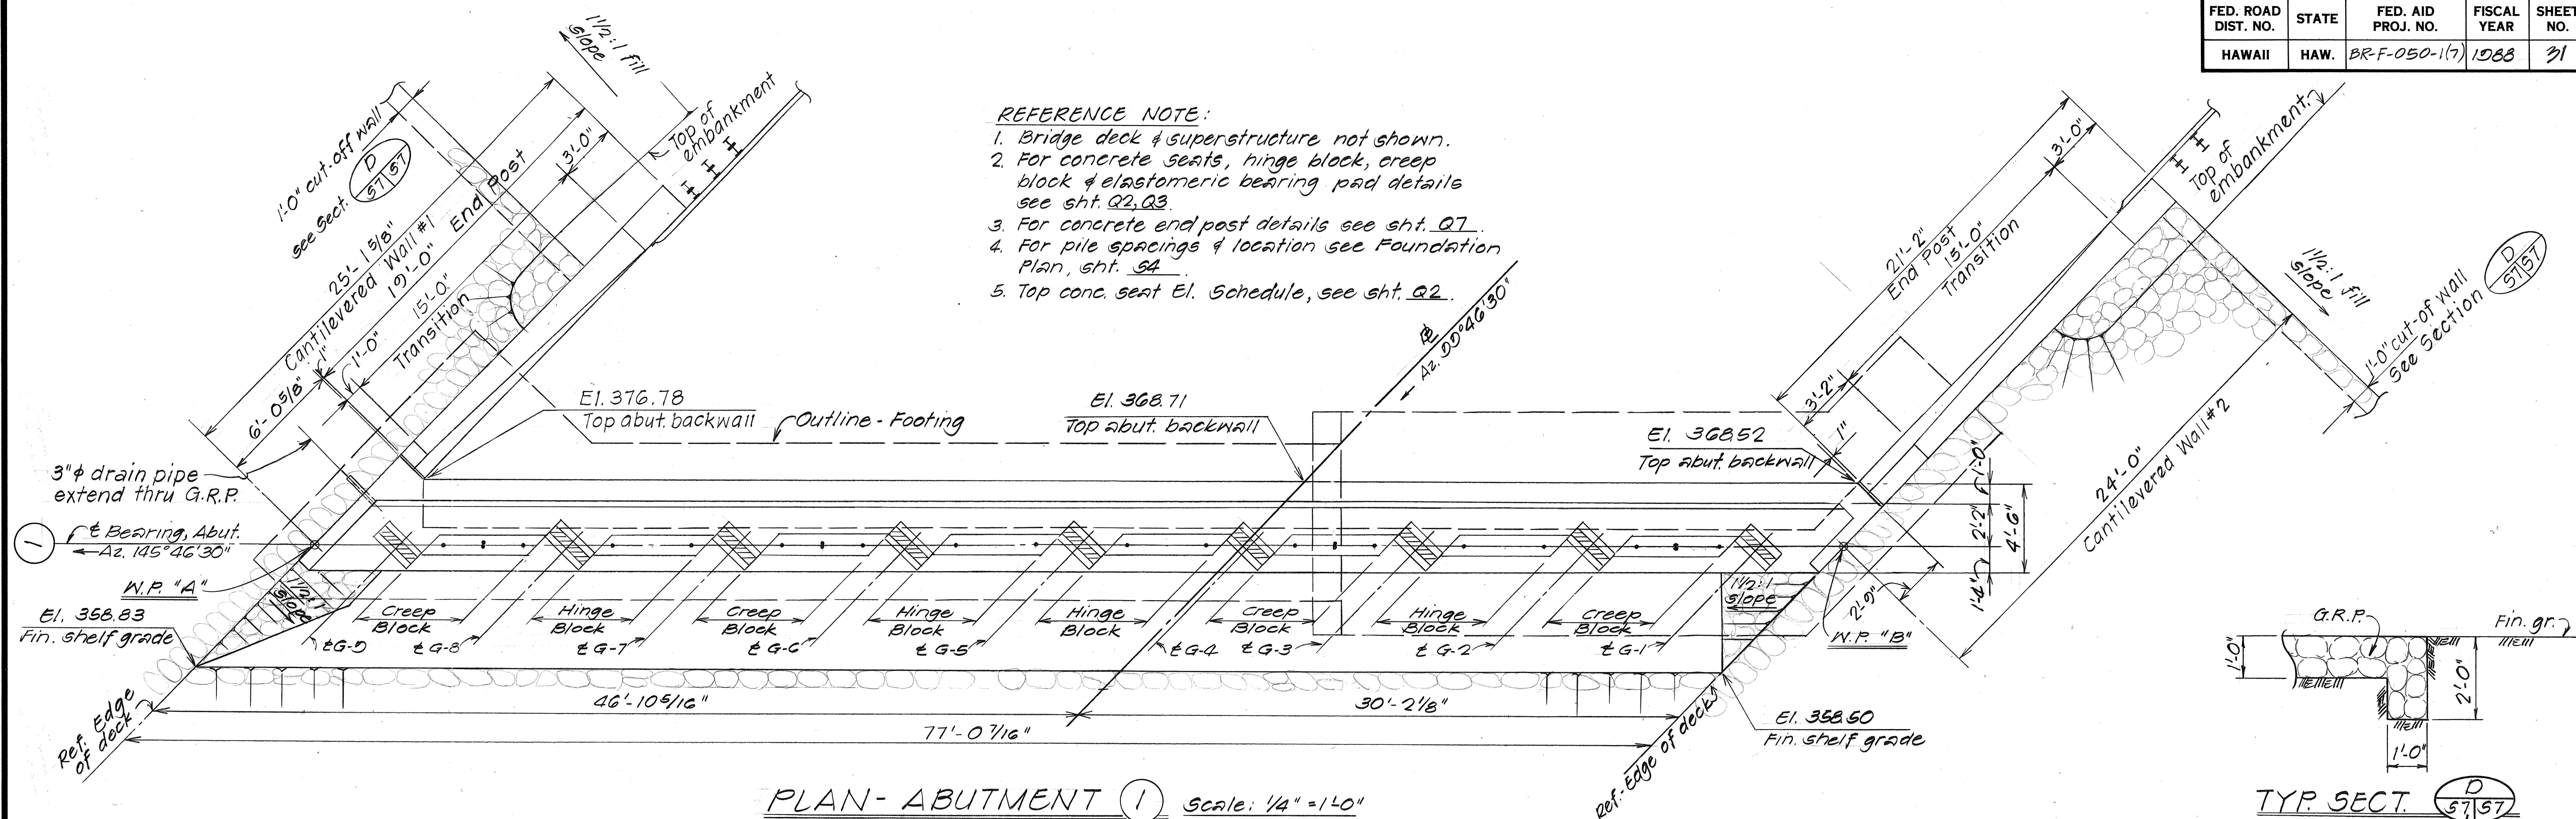

PLAN- ABUTMENT (1) Scale: $\frac{1}{4}" = 1'-0"$

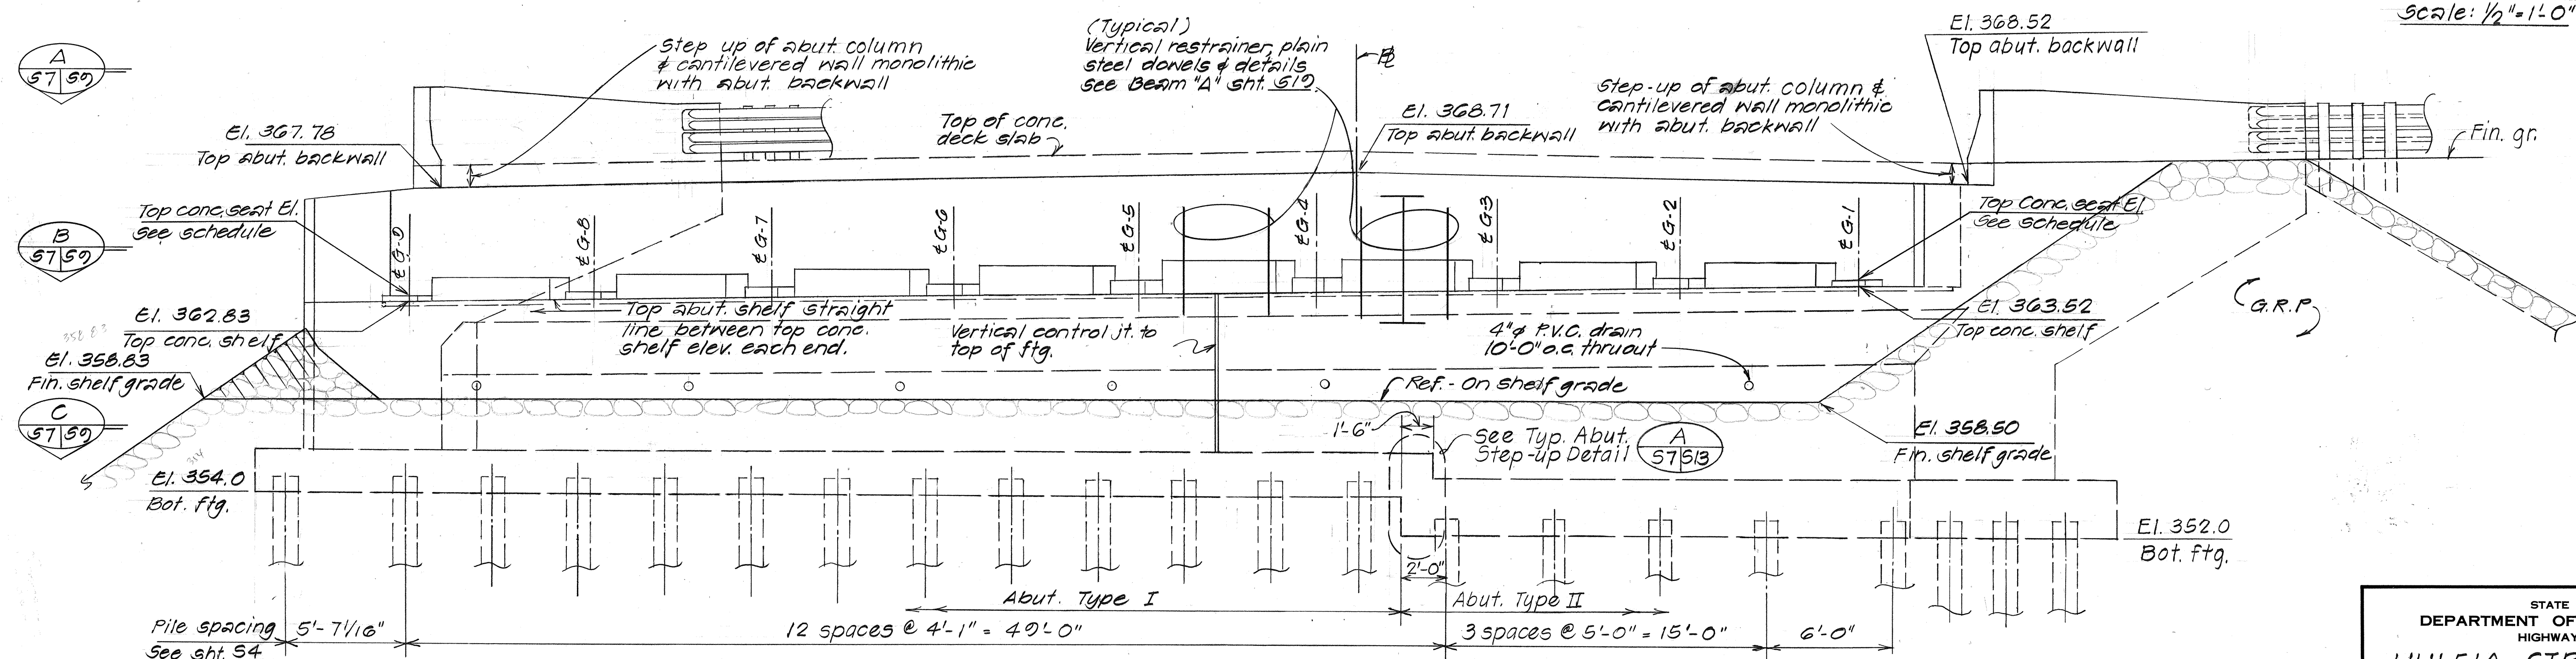



ELEVATION - ABUTMENT (1)
Scale: $\frac{1}{4}" = 1'-0"$

STATE OF HAWAII
DEPARTMENT OF TRANSPORTATION
HIGHWAYS DIVISION

HULEIA STREAM BRIDGE
ABUTMENT (1) PLAN & ELEVATION

KAUMUALII HWY.
PROJ. NO. BR-F-050-1(7)
Scale: As Noted Date: Aug. 1987
SHEET No. 57 OF 22 SHEETS

FED. ROAD DIST. NO.	STATE	FED. AID PROJ. NO.	FISCAL YEAR	SHEET NO.	TOTAL SHEETS
HAWAII	HAW.	BR-F-050-1(7)	1988	32	75

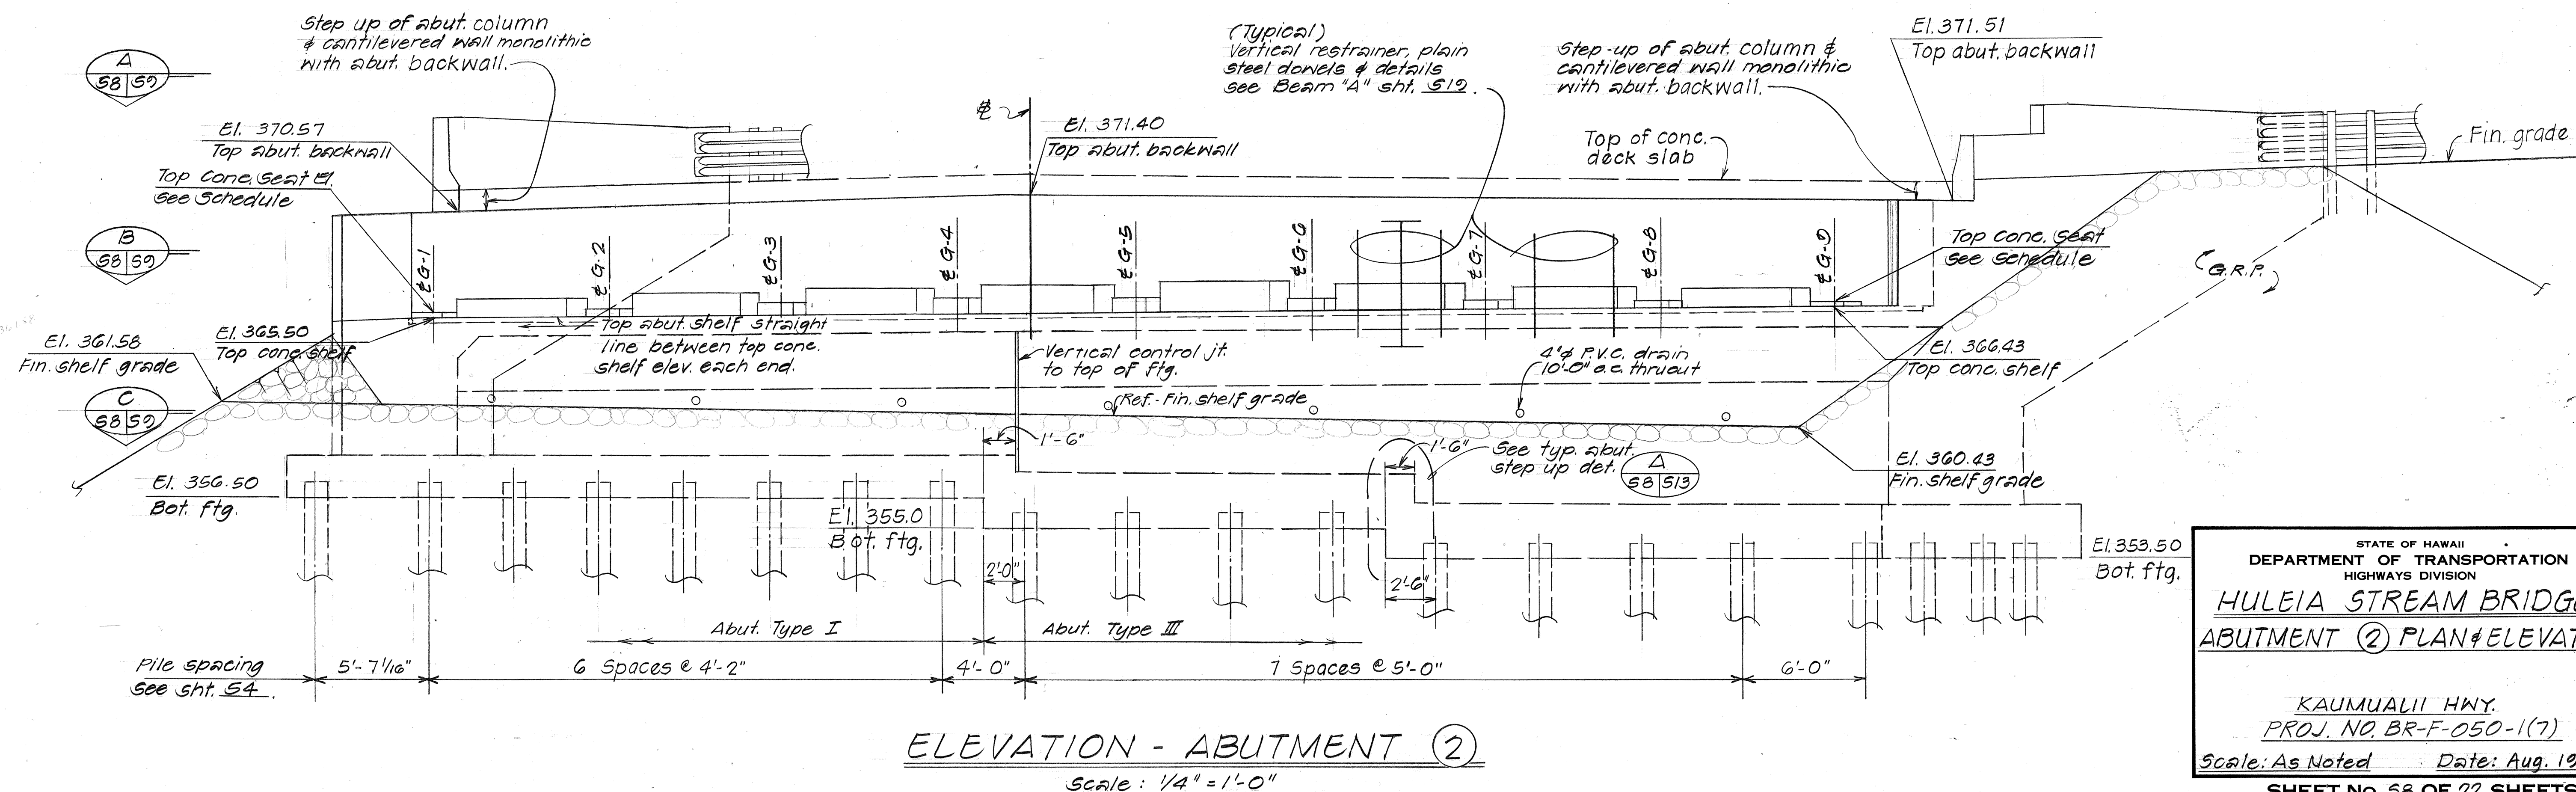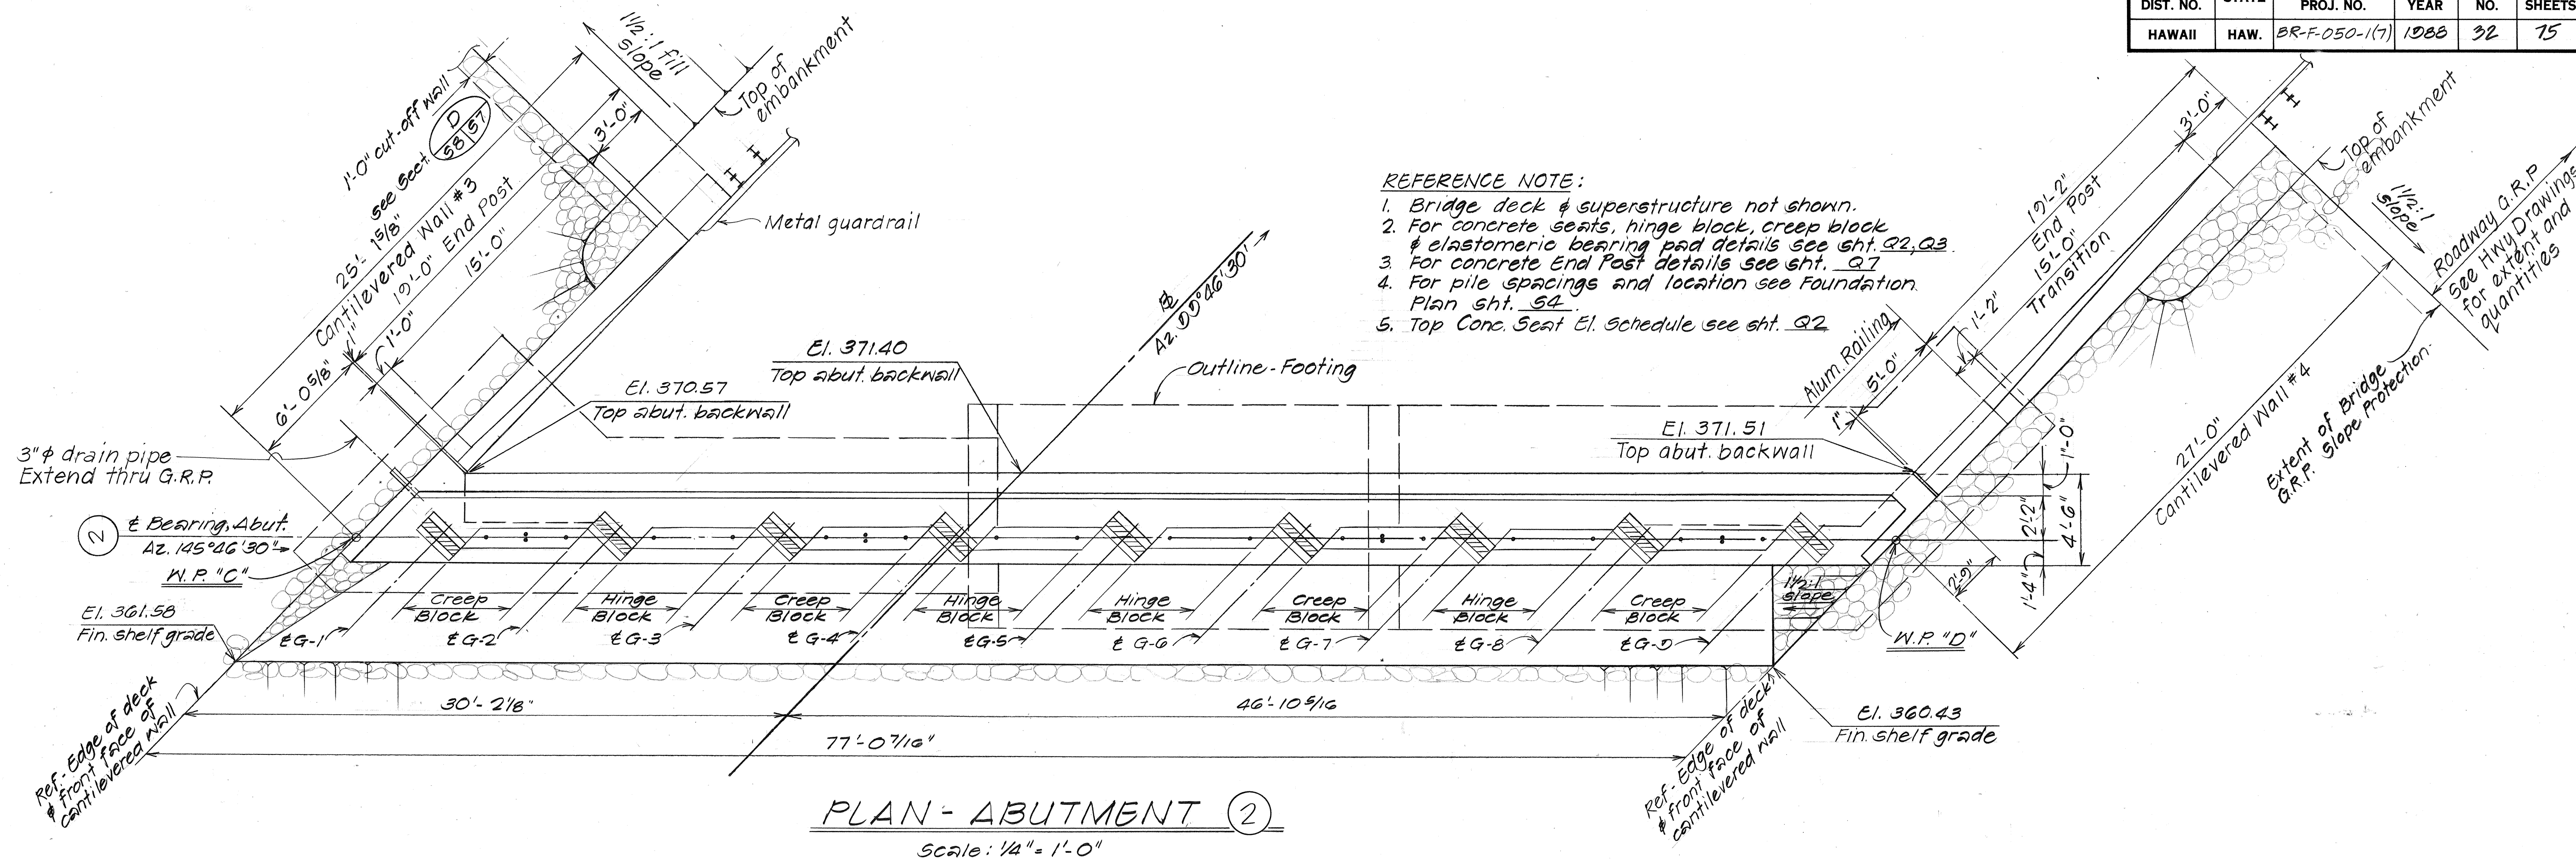

STATE OF HAWAII
DEPARTMENT OF TRANSPORTATION
HIGHWAYS DIVISION





HULEIA STREAM BRIDGE
ABUTMENT (2) PLAN & ELEVATION

KAUMUALII HWY.
PROJ. NO. BR-F-050-1(7)
Scale: As Noted Date: Aug. 1987

SHEET NO. 58 OF 22 SHEETS

ORIGINAL PLAN	DATE
NO. 1	7/87
NO. 2	7/87
NO. 3	7/87
NO. 32	7/87

FED. ROAD DIST. NO.	STATE	FED. AID PROJ. NO.	FISCAL YEAR	SHEET NO.	TOTAL SHEETS
HAWAII	HAW.	BR-F-050-1(7)	1988	33	15

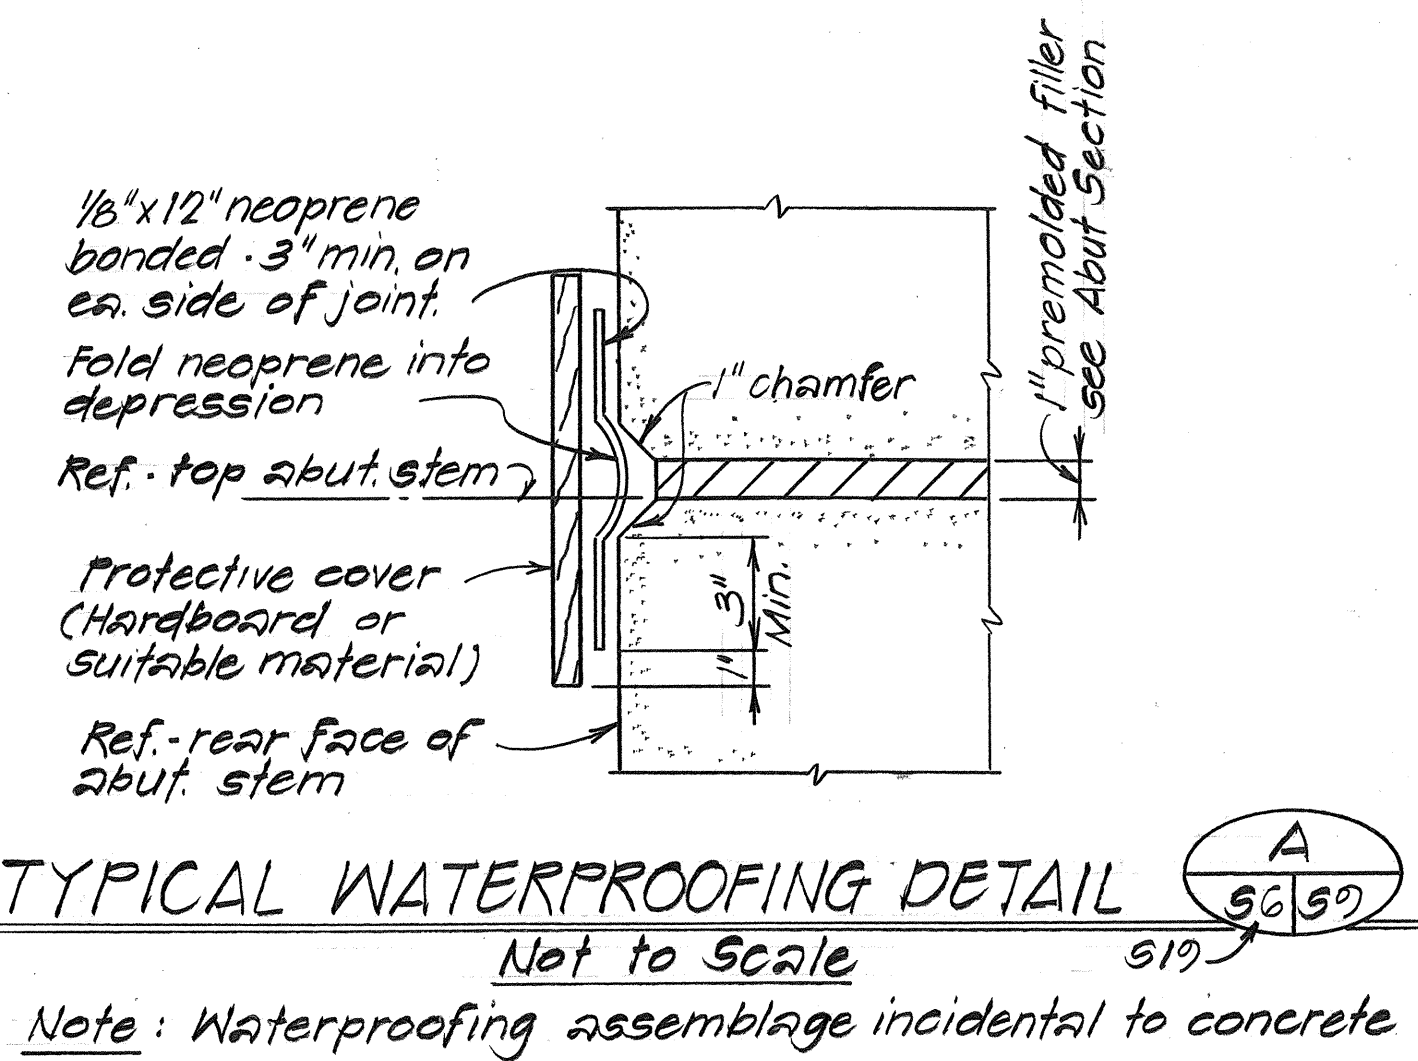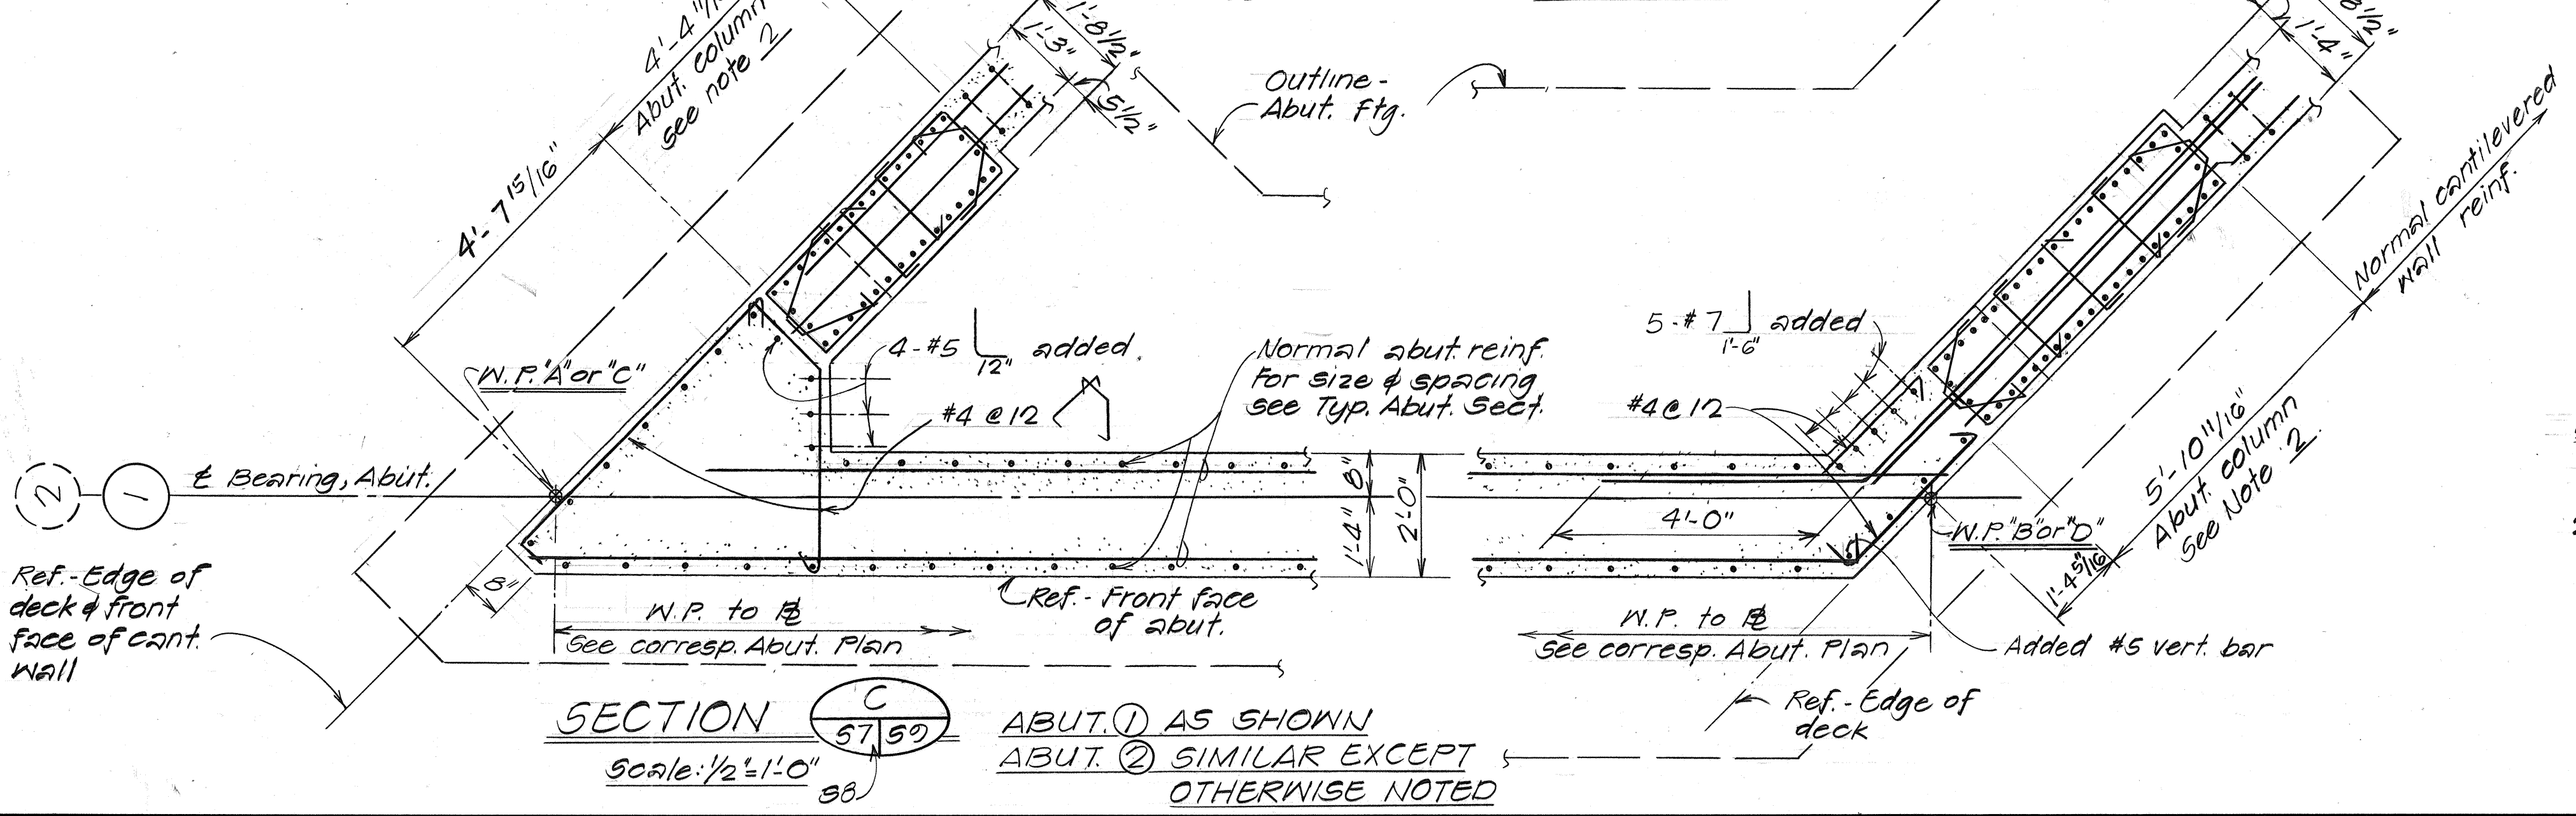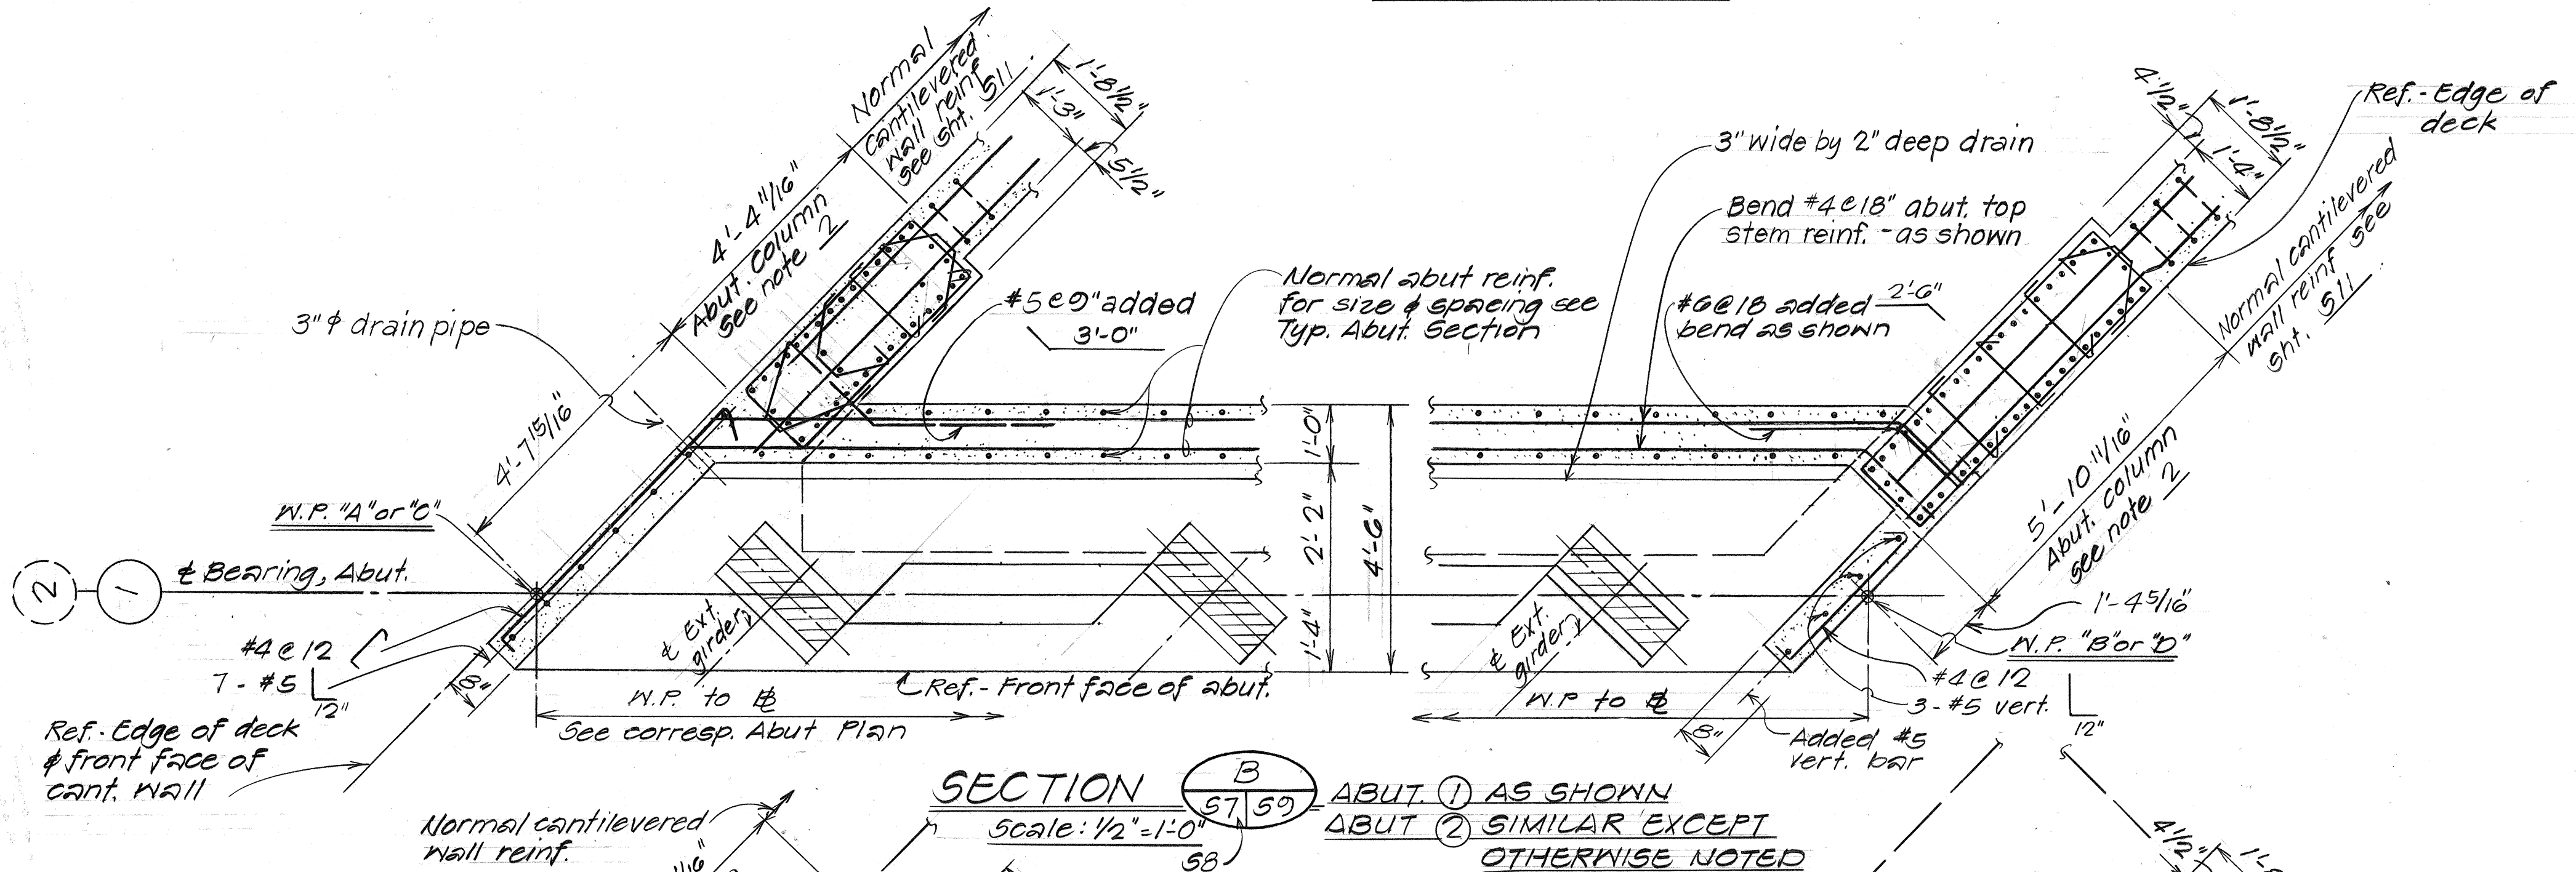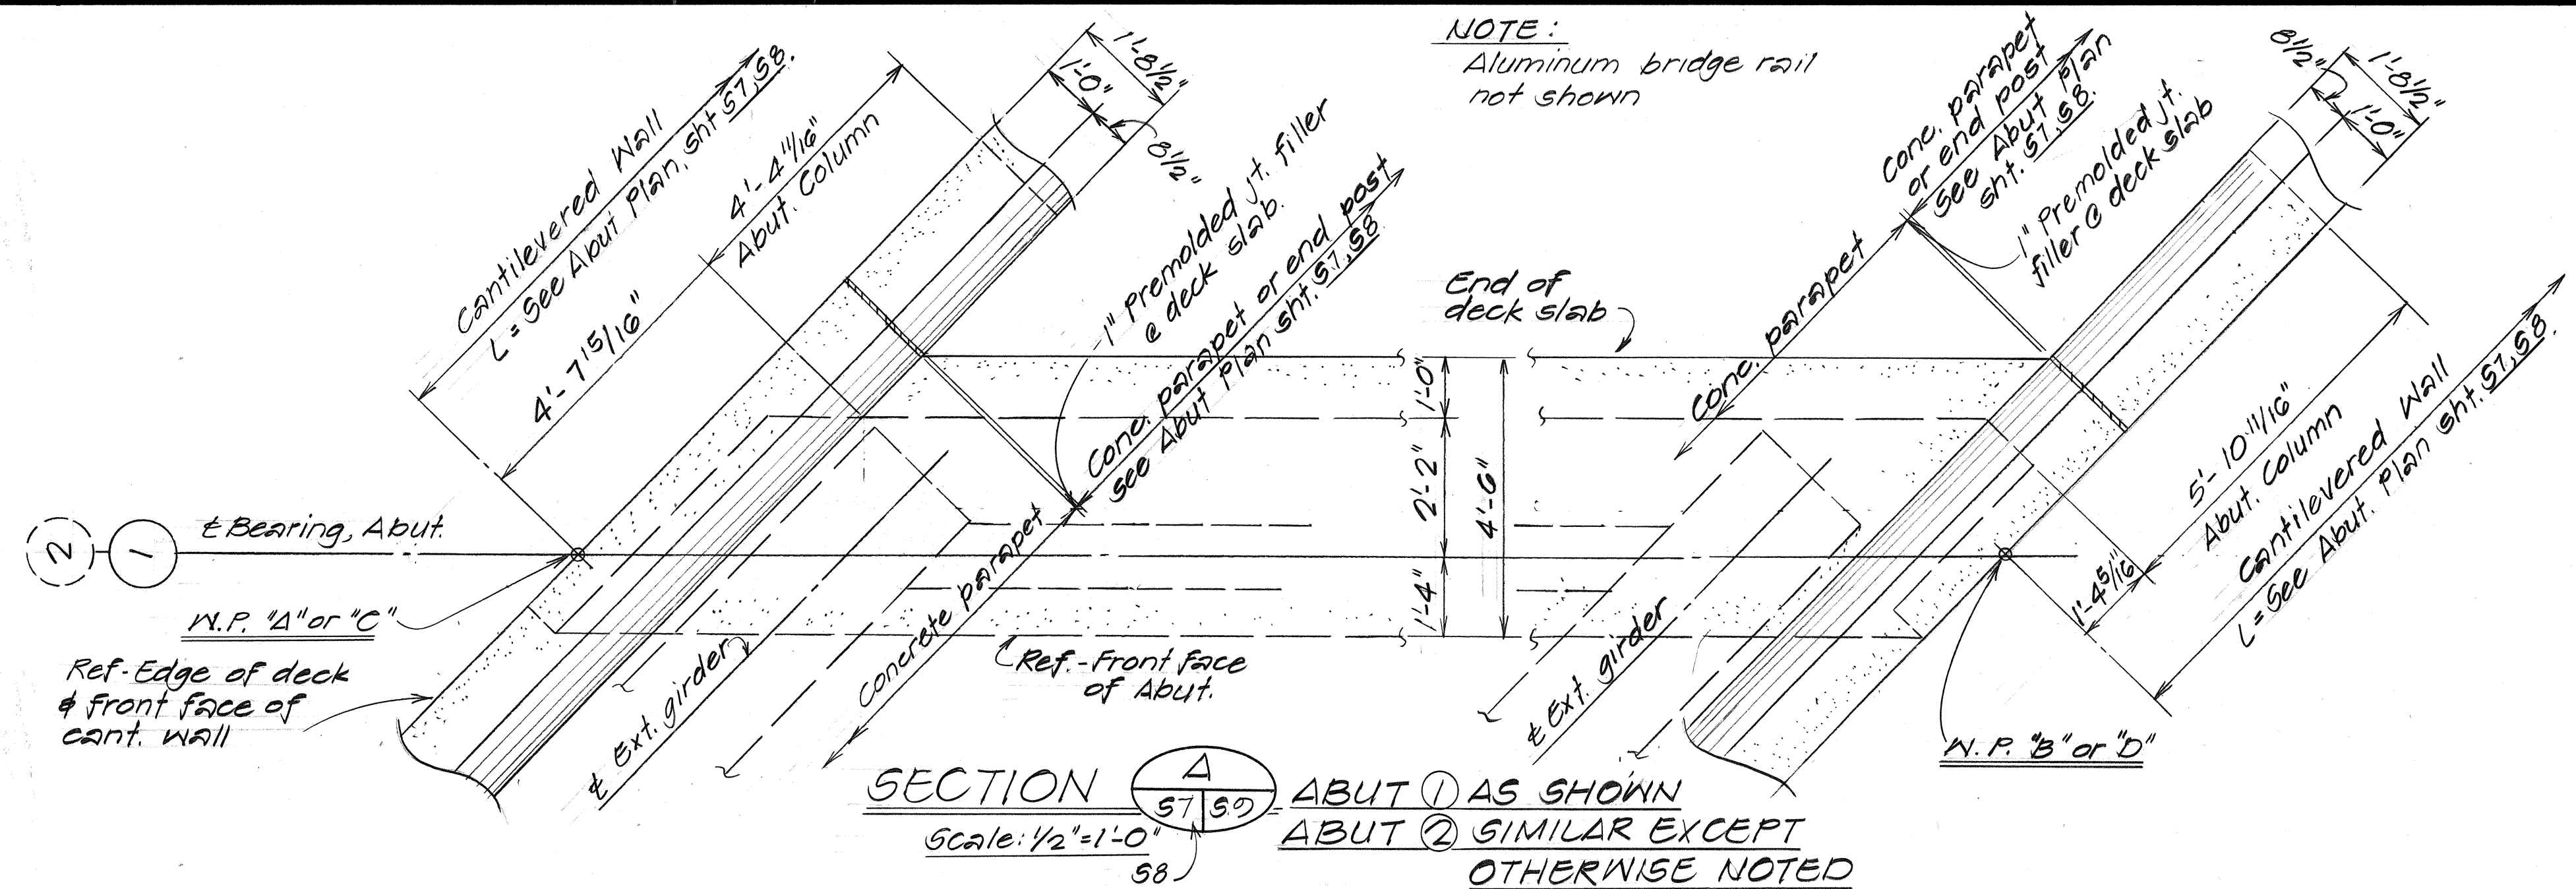

- REFERENCE NOTE:
1. Refer to sht. 511 for Typ. Abut. Column Elevation & Cantilevered Wall.
 2. Refer to sht. 512 for Abut. Column Reinf. & Tie Schedule.

STATE OF HAWAII
DEPARTMENT OF TRANSPORTATION
HIGHWAYS DIVISION

HULEIA STREAM BRIDGE

ABUTMENT ① & ② -
SECTION A, B, C


KAUMUALII HWY.

PROJ. NO. BR-F-050-1(7)
Scale: As Noted Date: Aug. 1987


SHEET NO. 33 OF 22 SHEETS

SURVEY PLOTTED BY	DATE
DRAWN BY	
TRACED BY	
CHECKED BY	
ORIGINAL PLAN	
NOTE BOOK	
NO.	


FED. ROAD DIST. NO.	STATE	FED. AID PROJ. NO.	FISCAL YEAR	SHEET NO.	TOTAL SHEETS
HAWAII	HAW.	BR-F-050-1(7)	1988	34	75

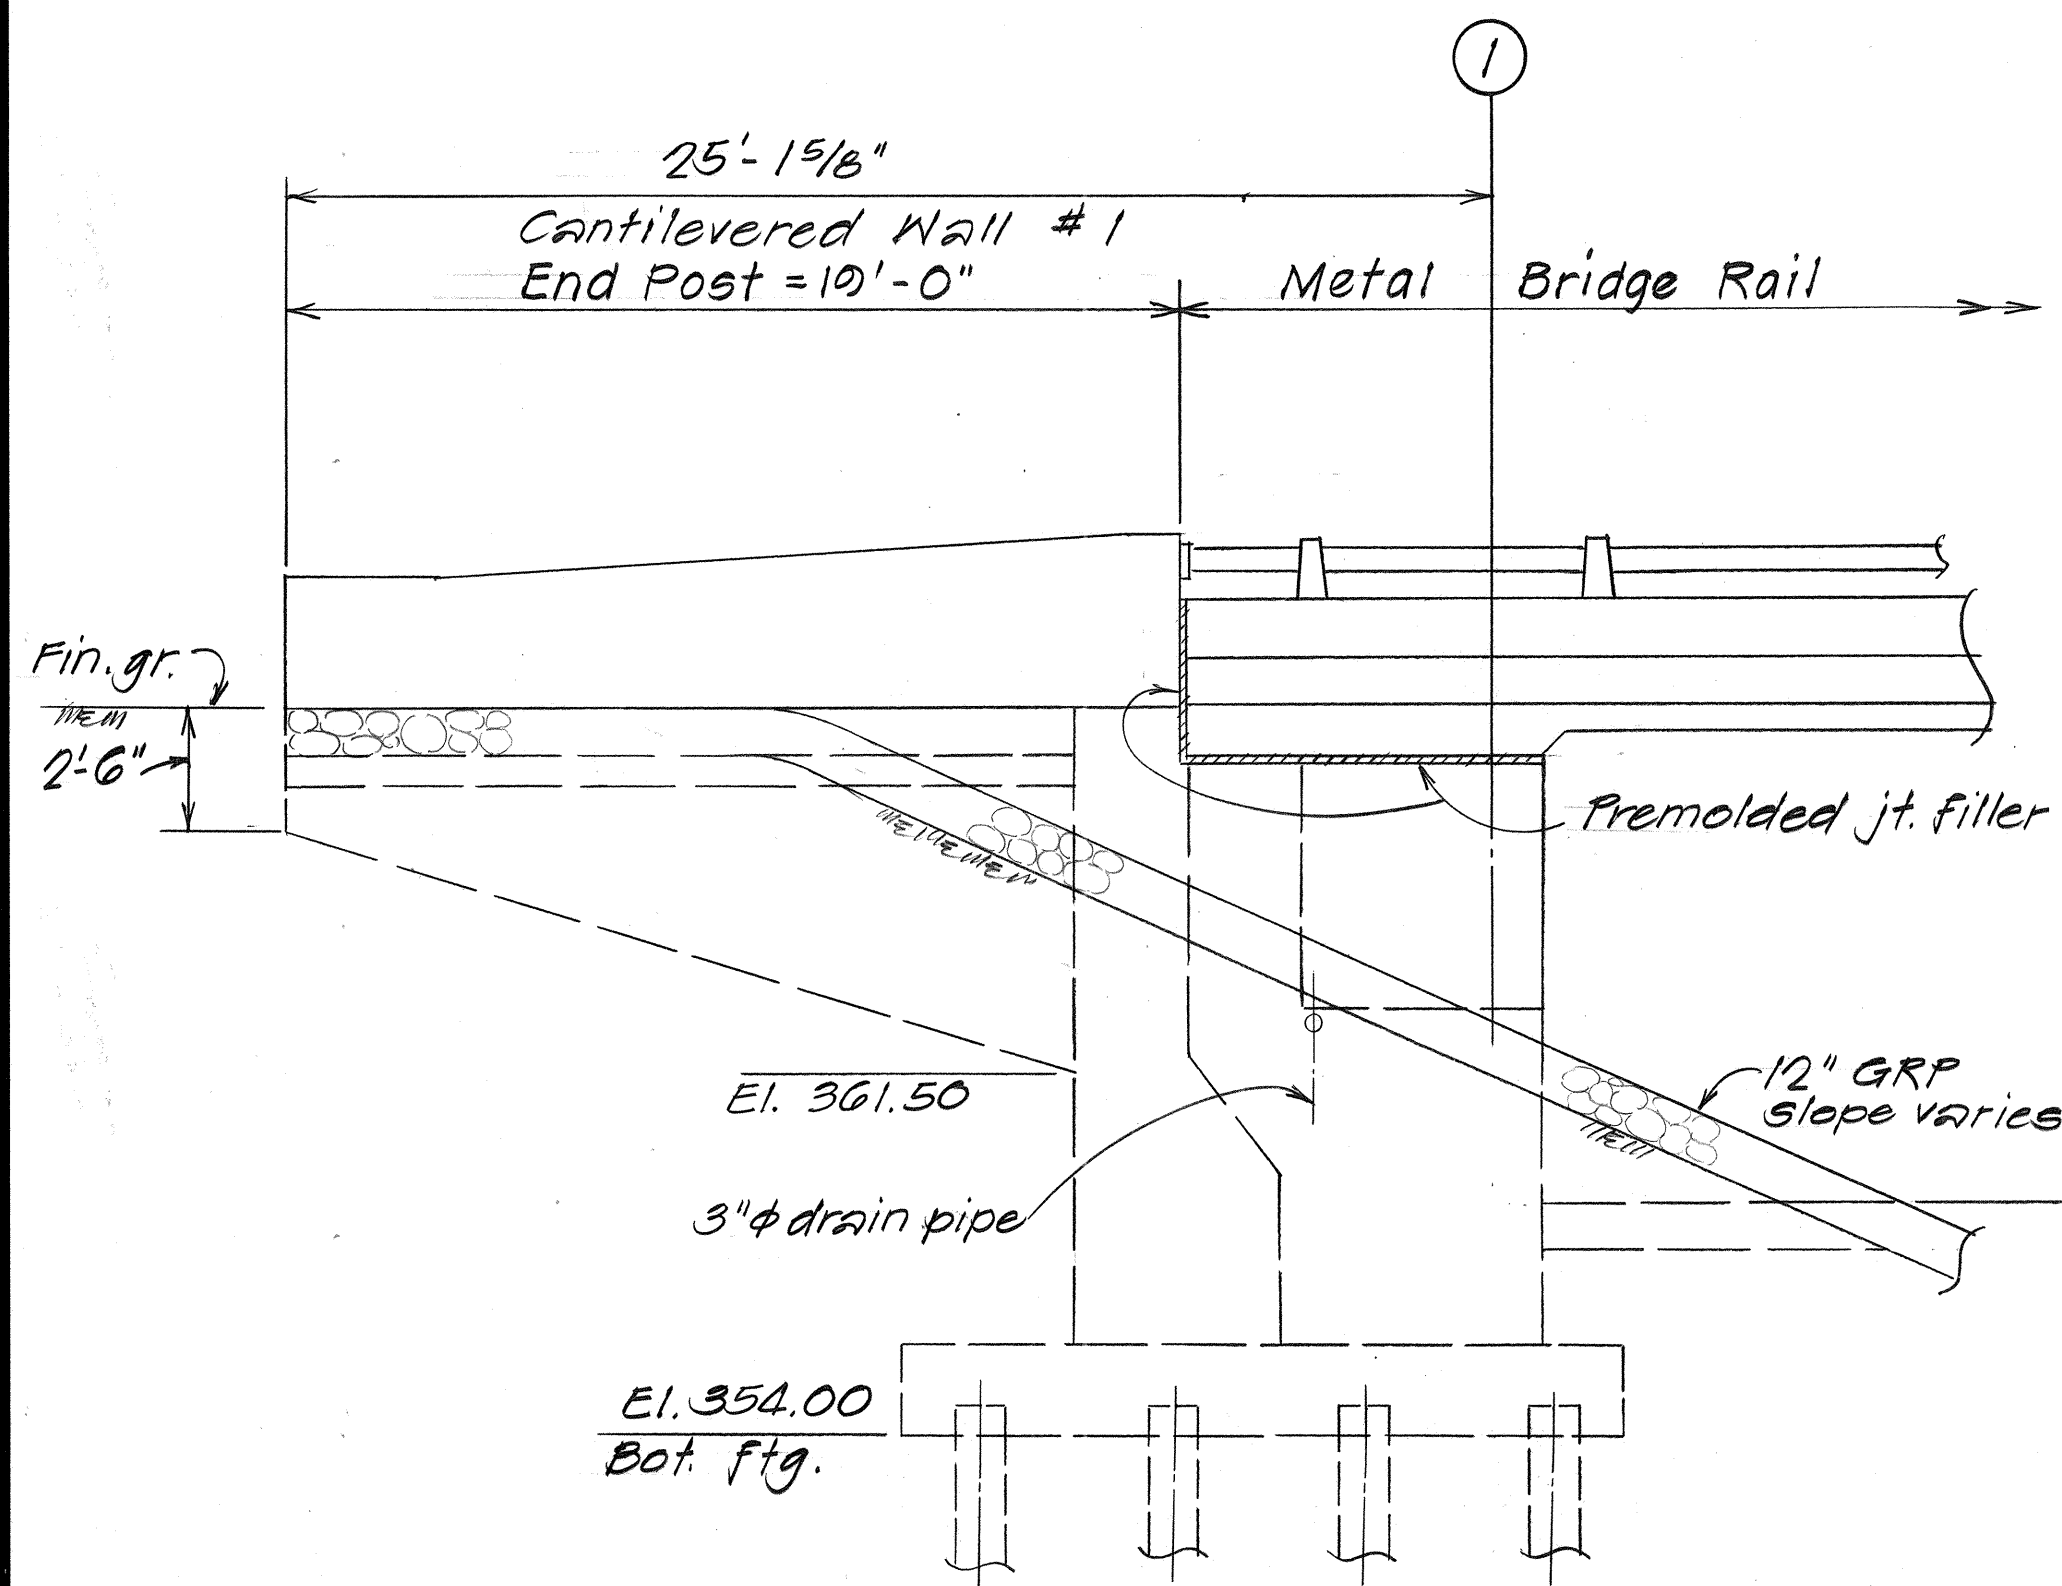


CANTILEVERED WALL #1
Scale: 1/4" = 1'-0"

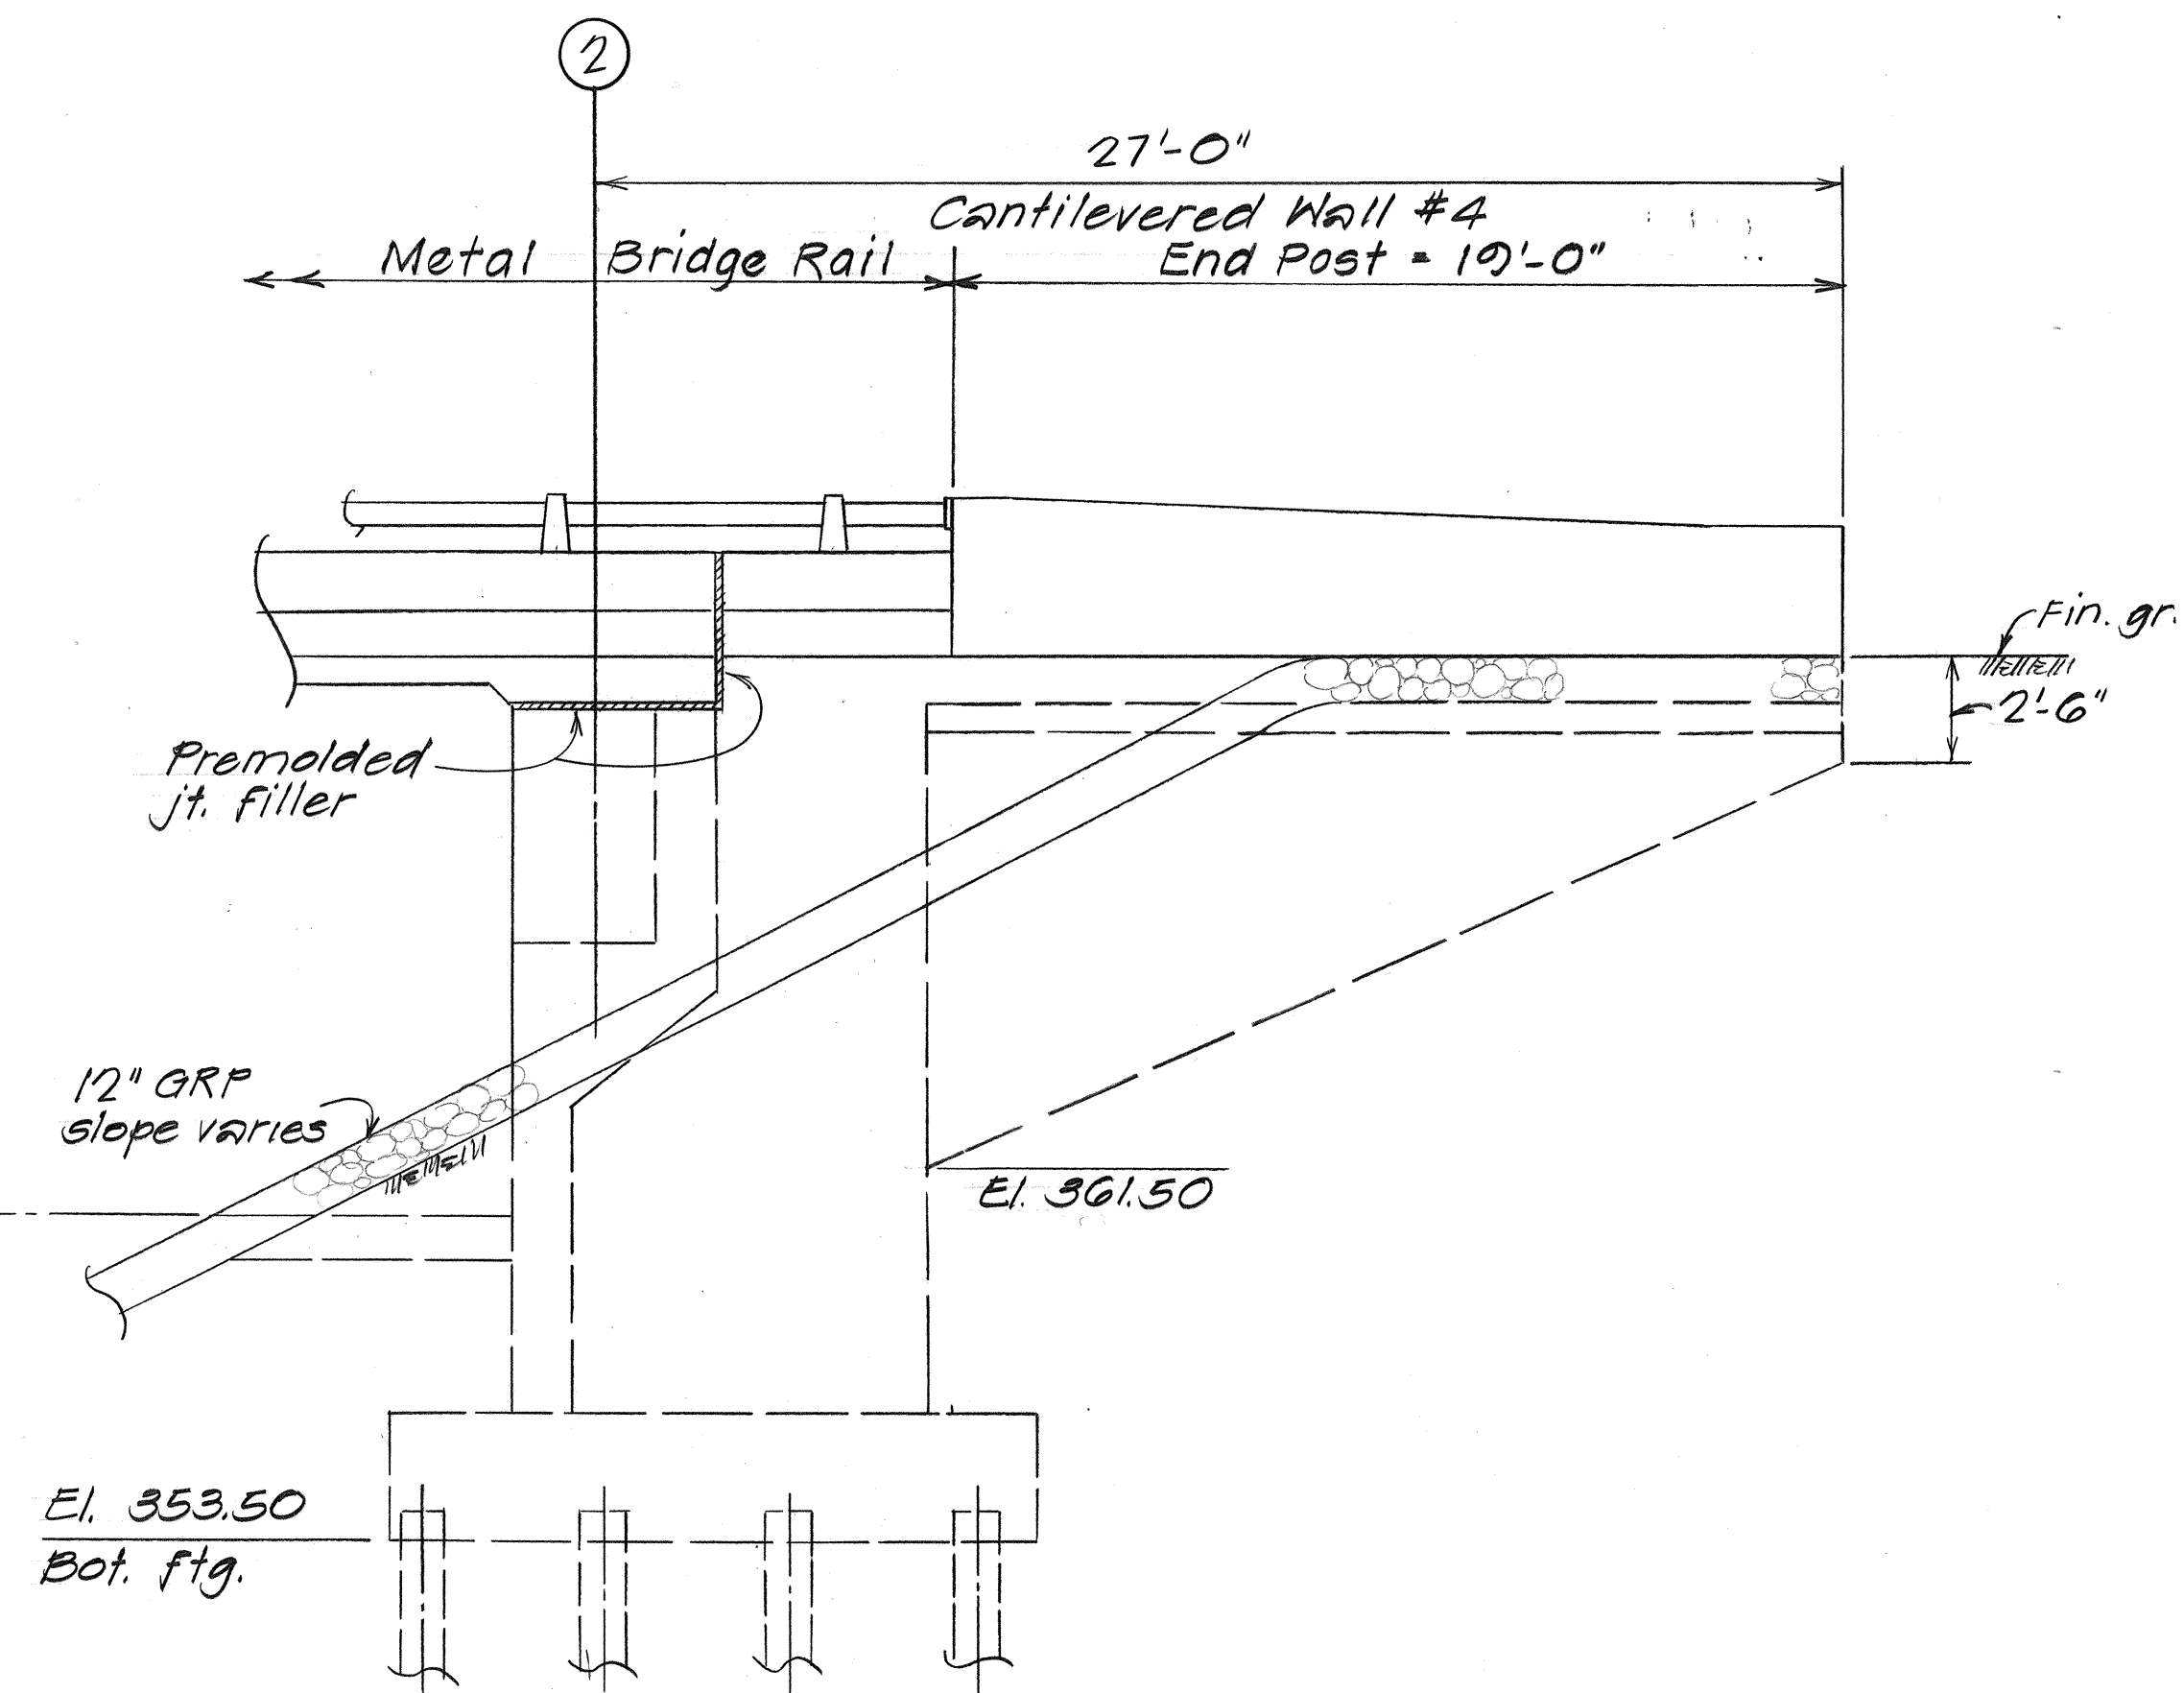

CANTILEVERED WALL #4
Scale: 1/4" = 1'-0"

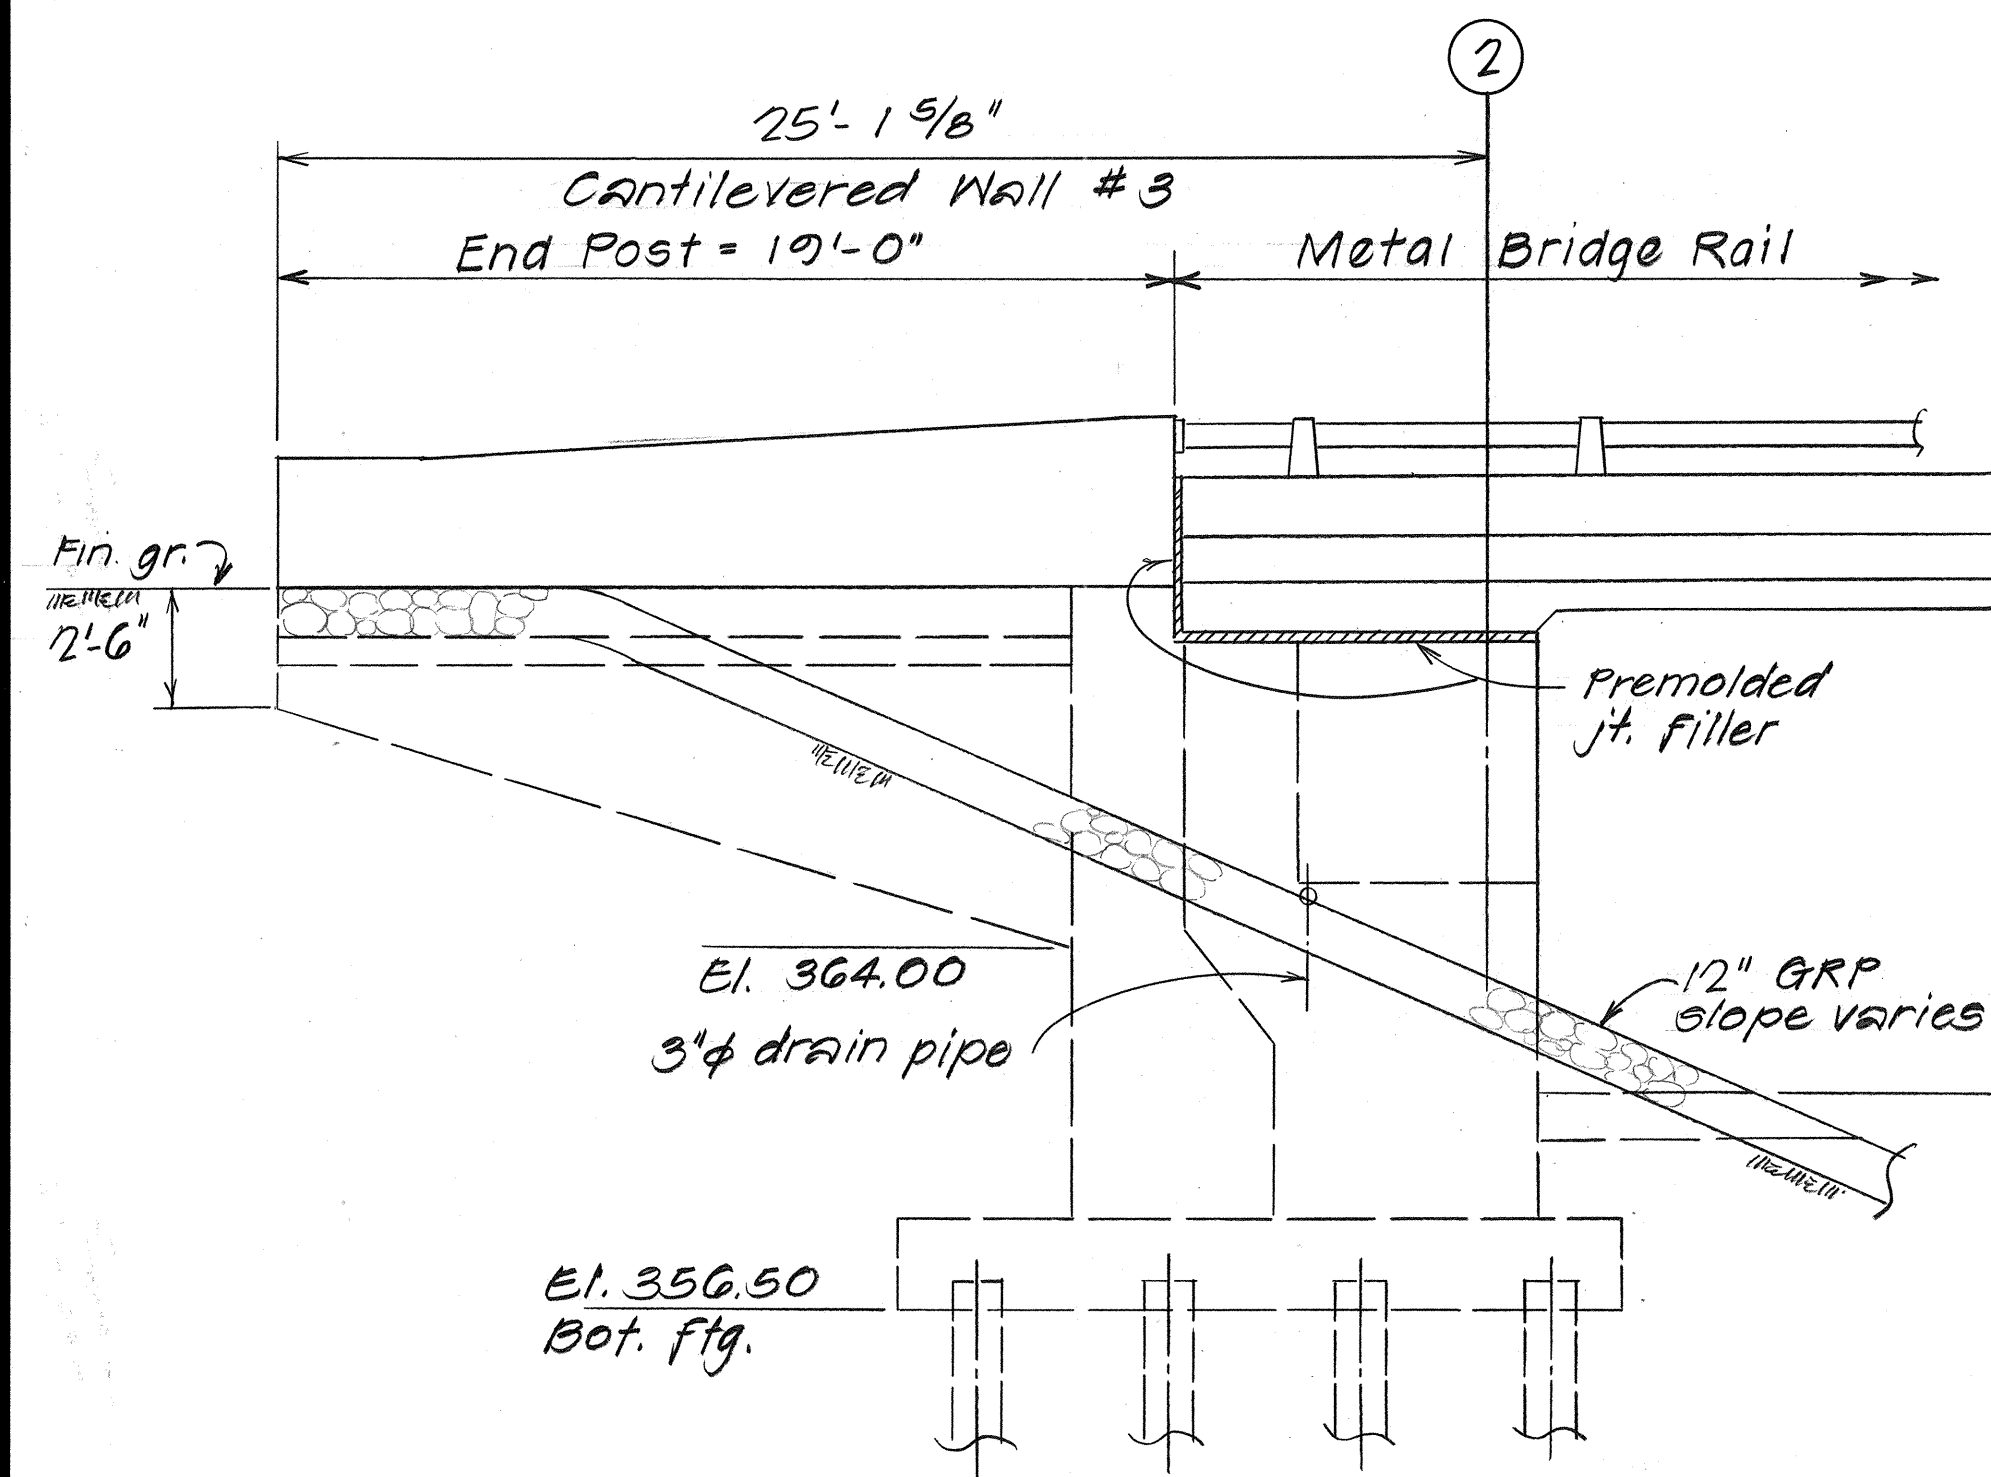

CANTILEVERED WALL #3
Scale: 1/4" = 1'-0"

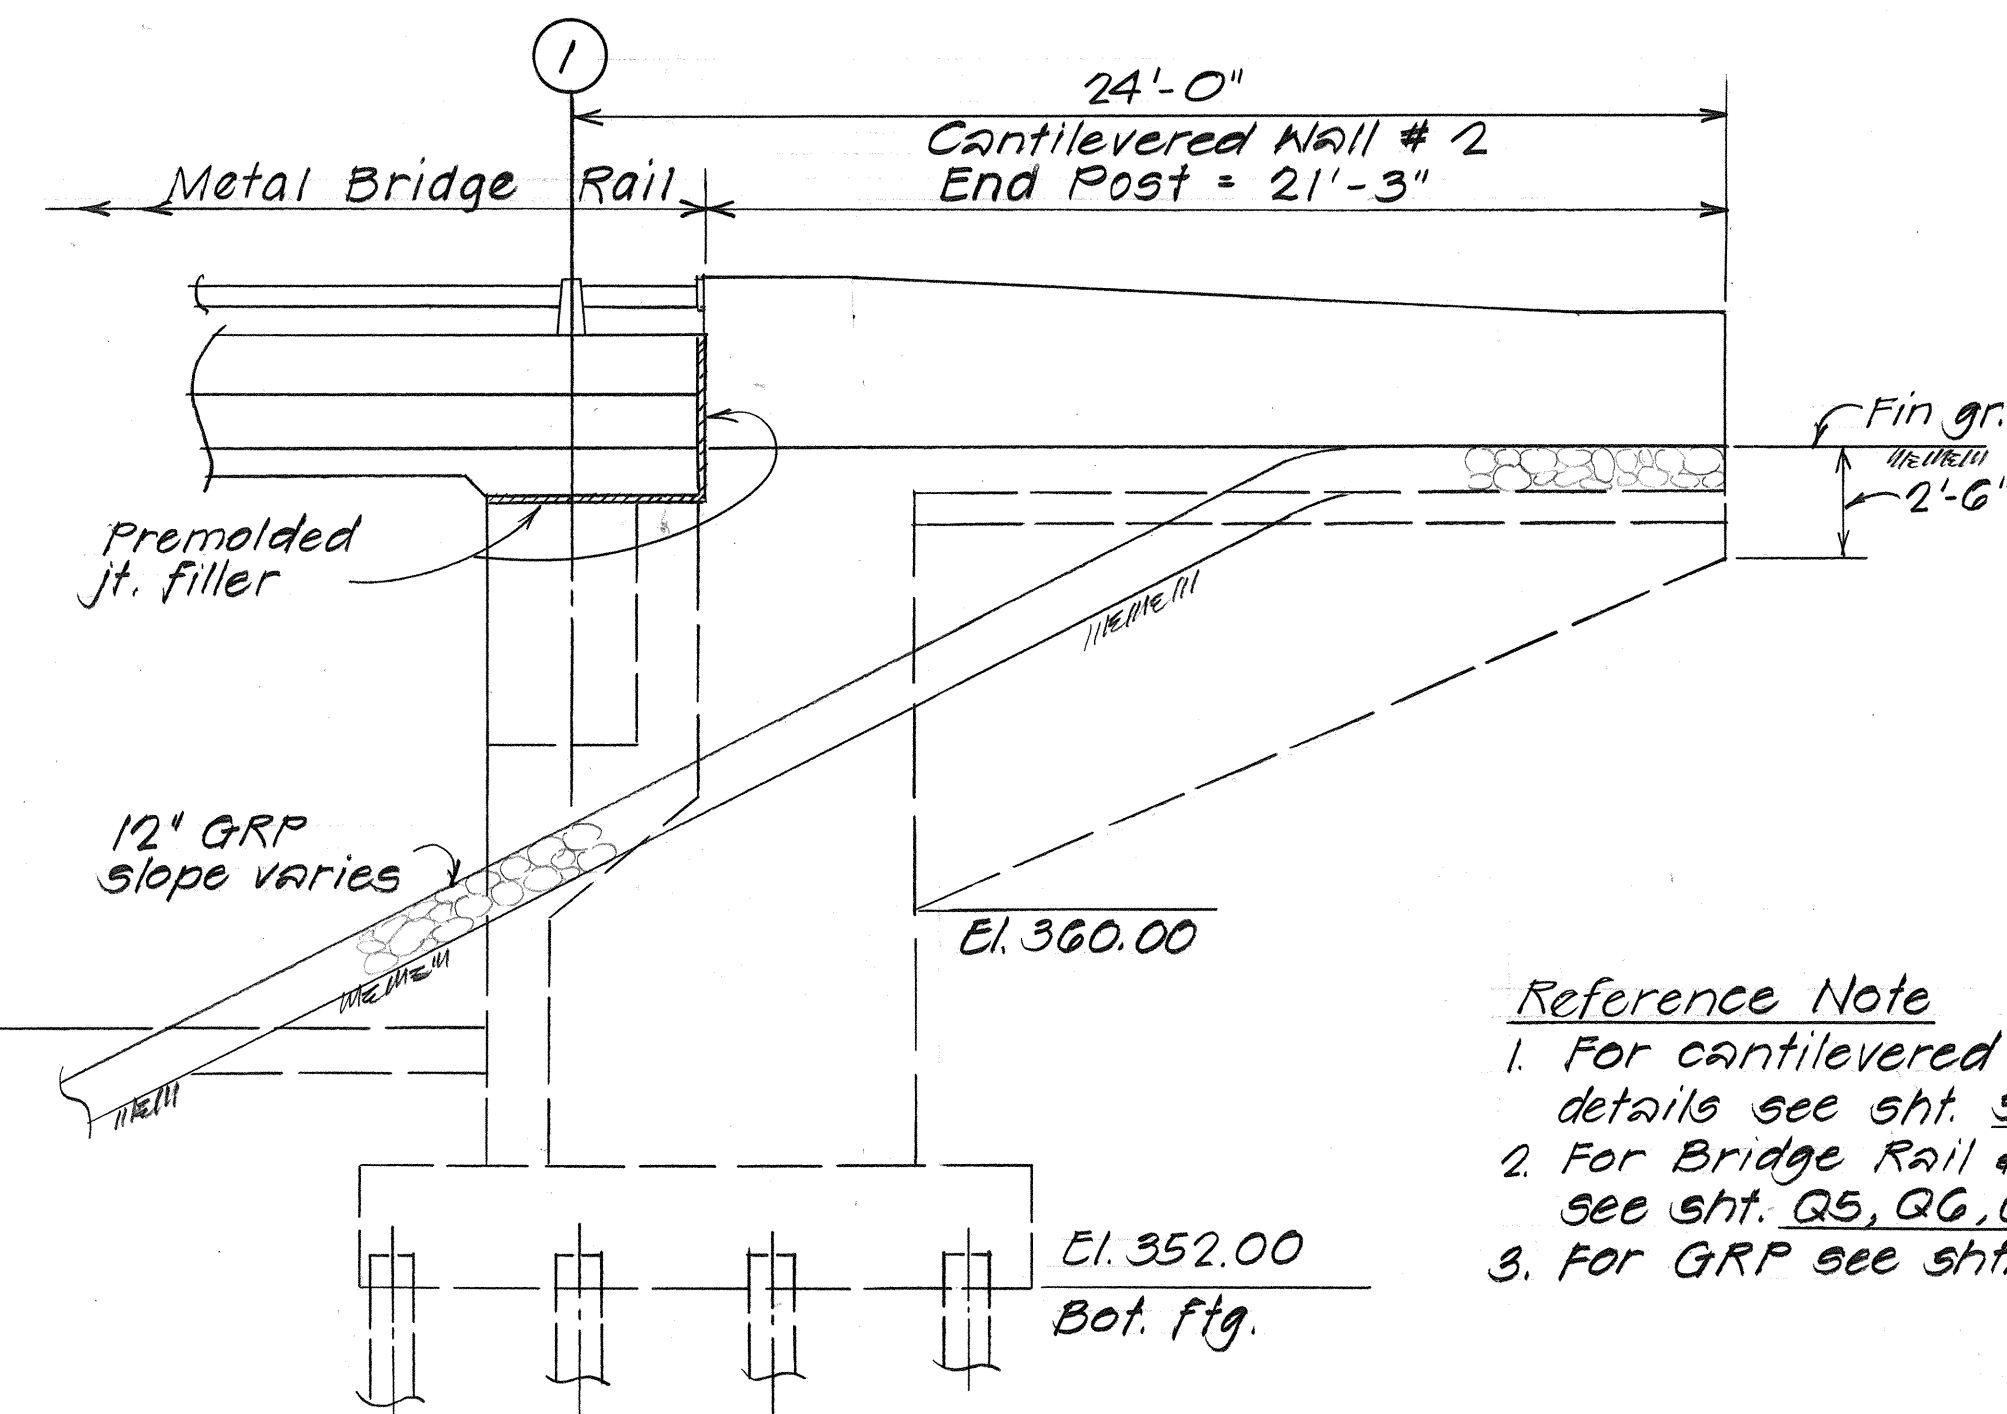

CANTILEVERED WALL #2
Scale: 1/4" = 1'-0"

- Reference Note**
1. For cantilevered Wall reinf. & details see sht. 511.
 2. For Bridge Rail & Conc. End Post see sht. Q5, Q6, Q7.
 3. For GRP see sht. 56 & 57.

STATE OF HAWAII
DEPARTMENT OF TRANSPORTATION
HIGHWAYS DIVISION


HULEIA STREAM BRIDGE
CANTILEVERED WALL #1, #2, #3, #4

KAUMUALII HWY.
PROJ. NO. BR-F-050-1(7)
Scale: As Noted Date: Aug. 1987

SHEET NO. 510 OF 22 SHEETS

SURVEY PLOTTED BY	DATE
DRAWN BY	
CHECKED BY	
NOTED BY	
ORIGINAL PLAN	
NOTE BOOK	
NO.	

FED. ROAD DIST. NO.	STATE	FED. AID PROJ. NO.	FISCAL YEAR	SHEET NO.	TOTAL SHEETS
HAWAII	HAW.	BR-F-050-1(7)	1988	35	75

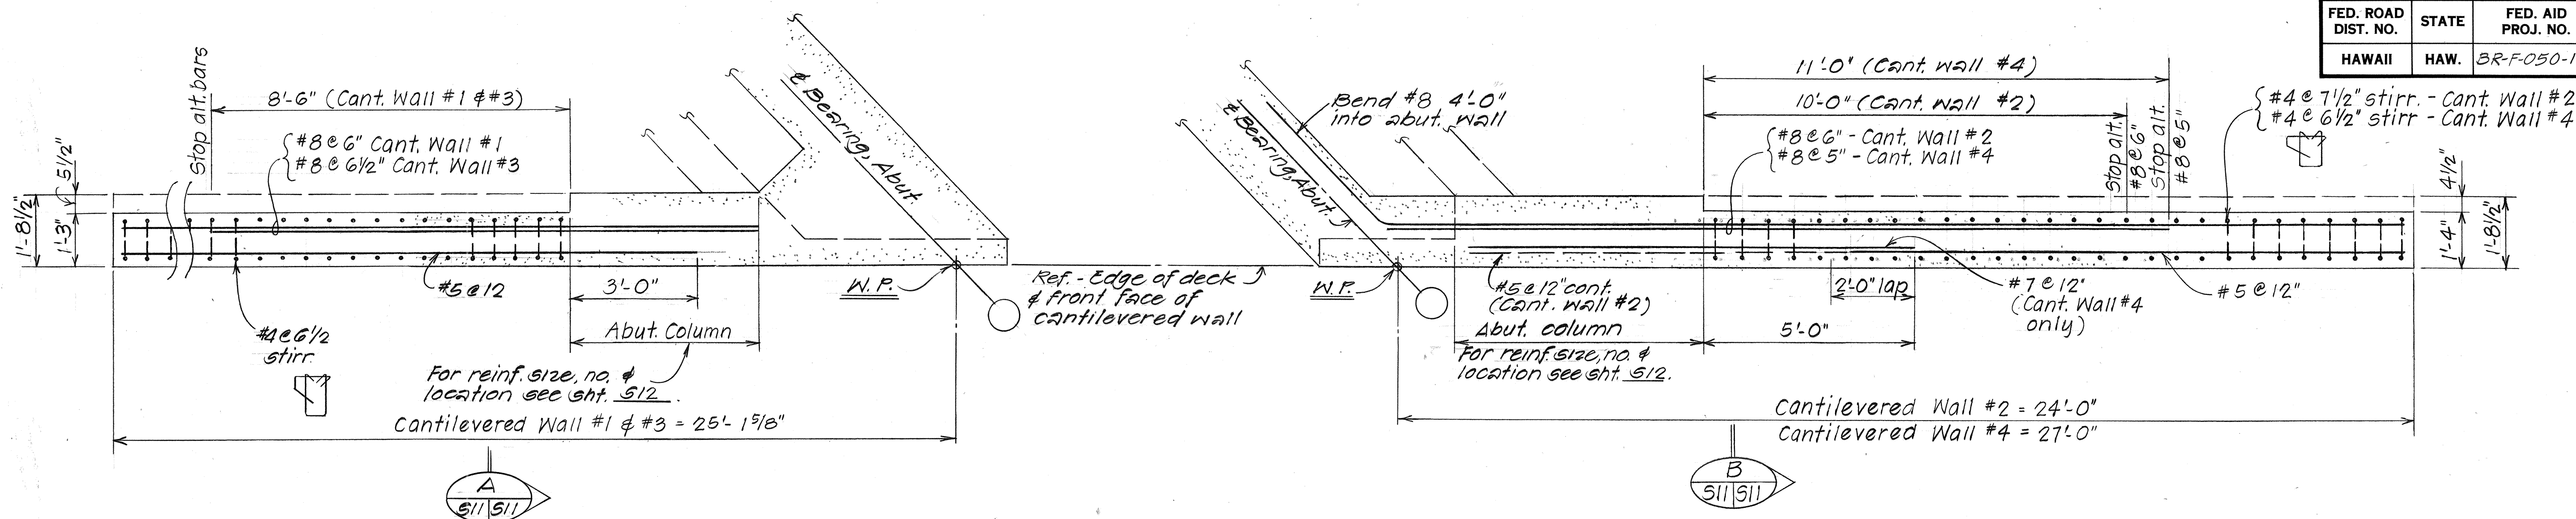

CANTILEVERED WALL #1 & #3


CANTILEVERED WALL #2 & #4

TYPICAL REINFORCING PLAN -
CANTILEVERED WALL

Scale: 1/2" = 1'-0"


Reference Note:

- 1- Refer to sht. S12 for abutment column reinf. & ties schedule
- 2- Refer to sht. S10 for cantilevered wall #1, 2, #3, & #4.

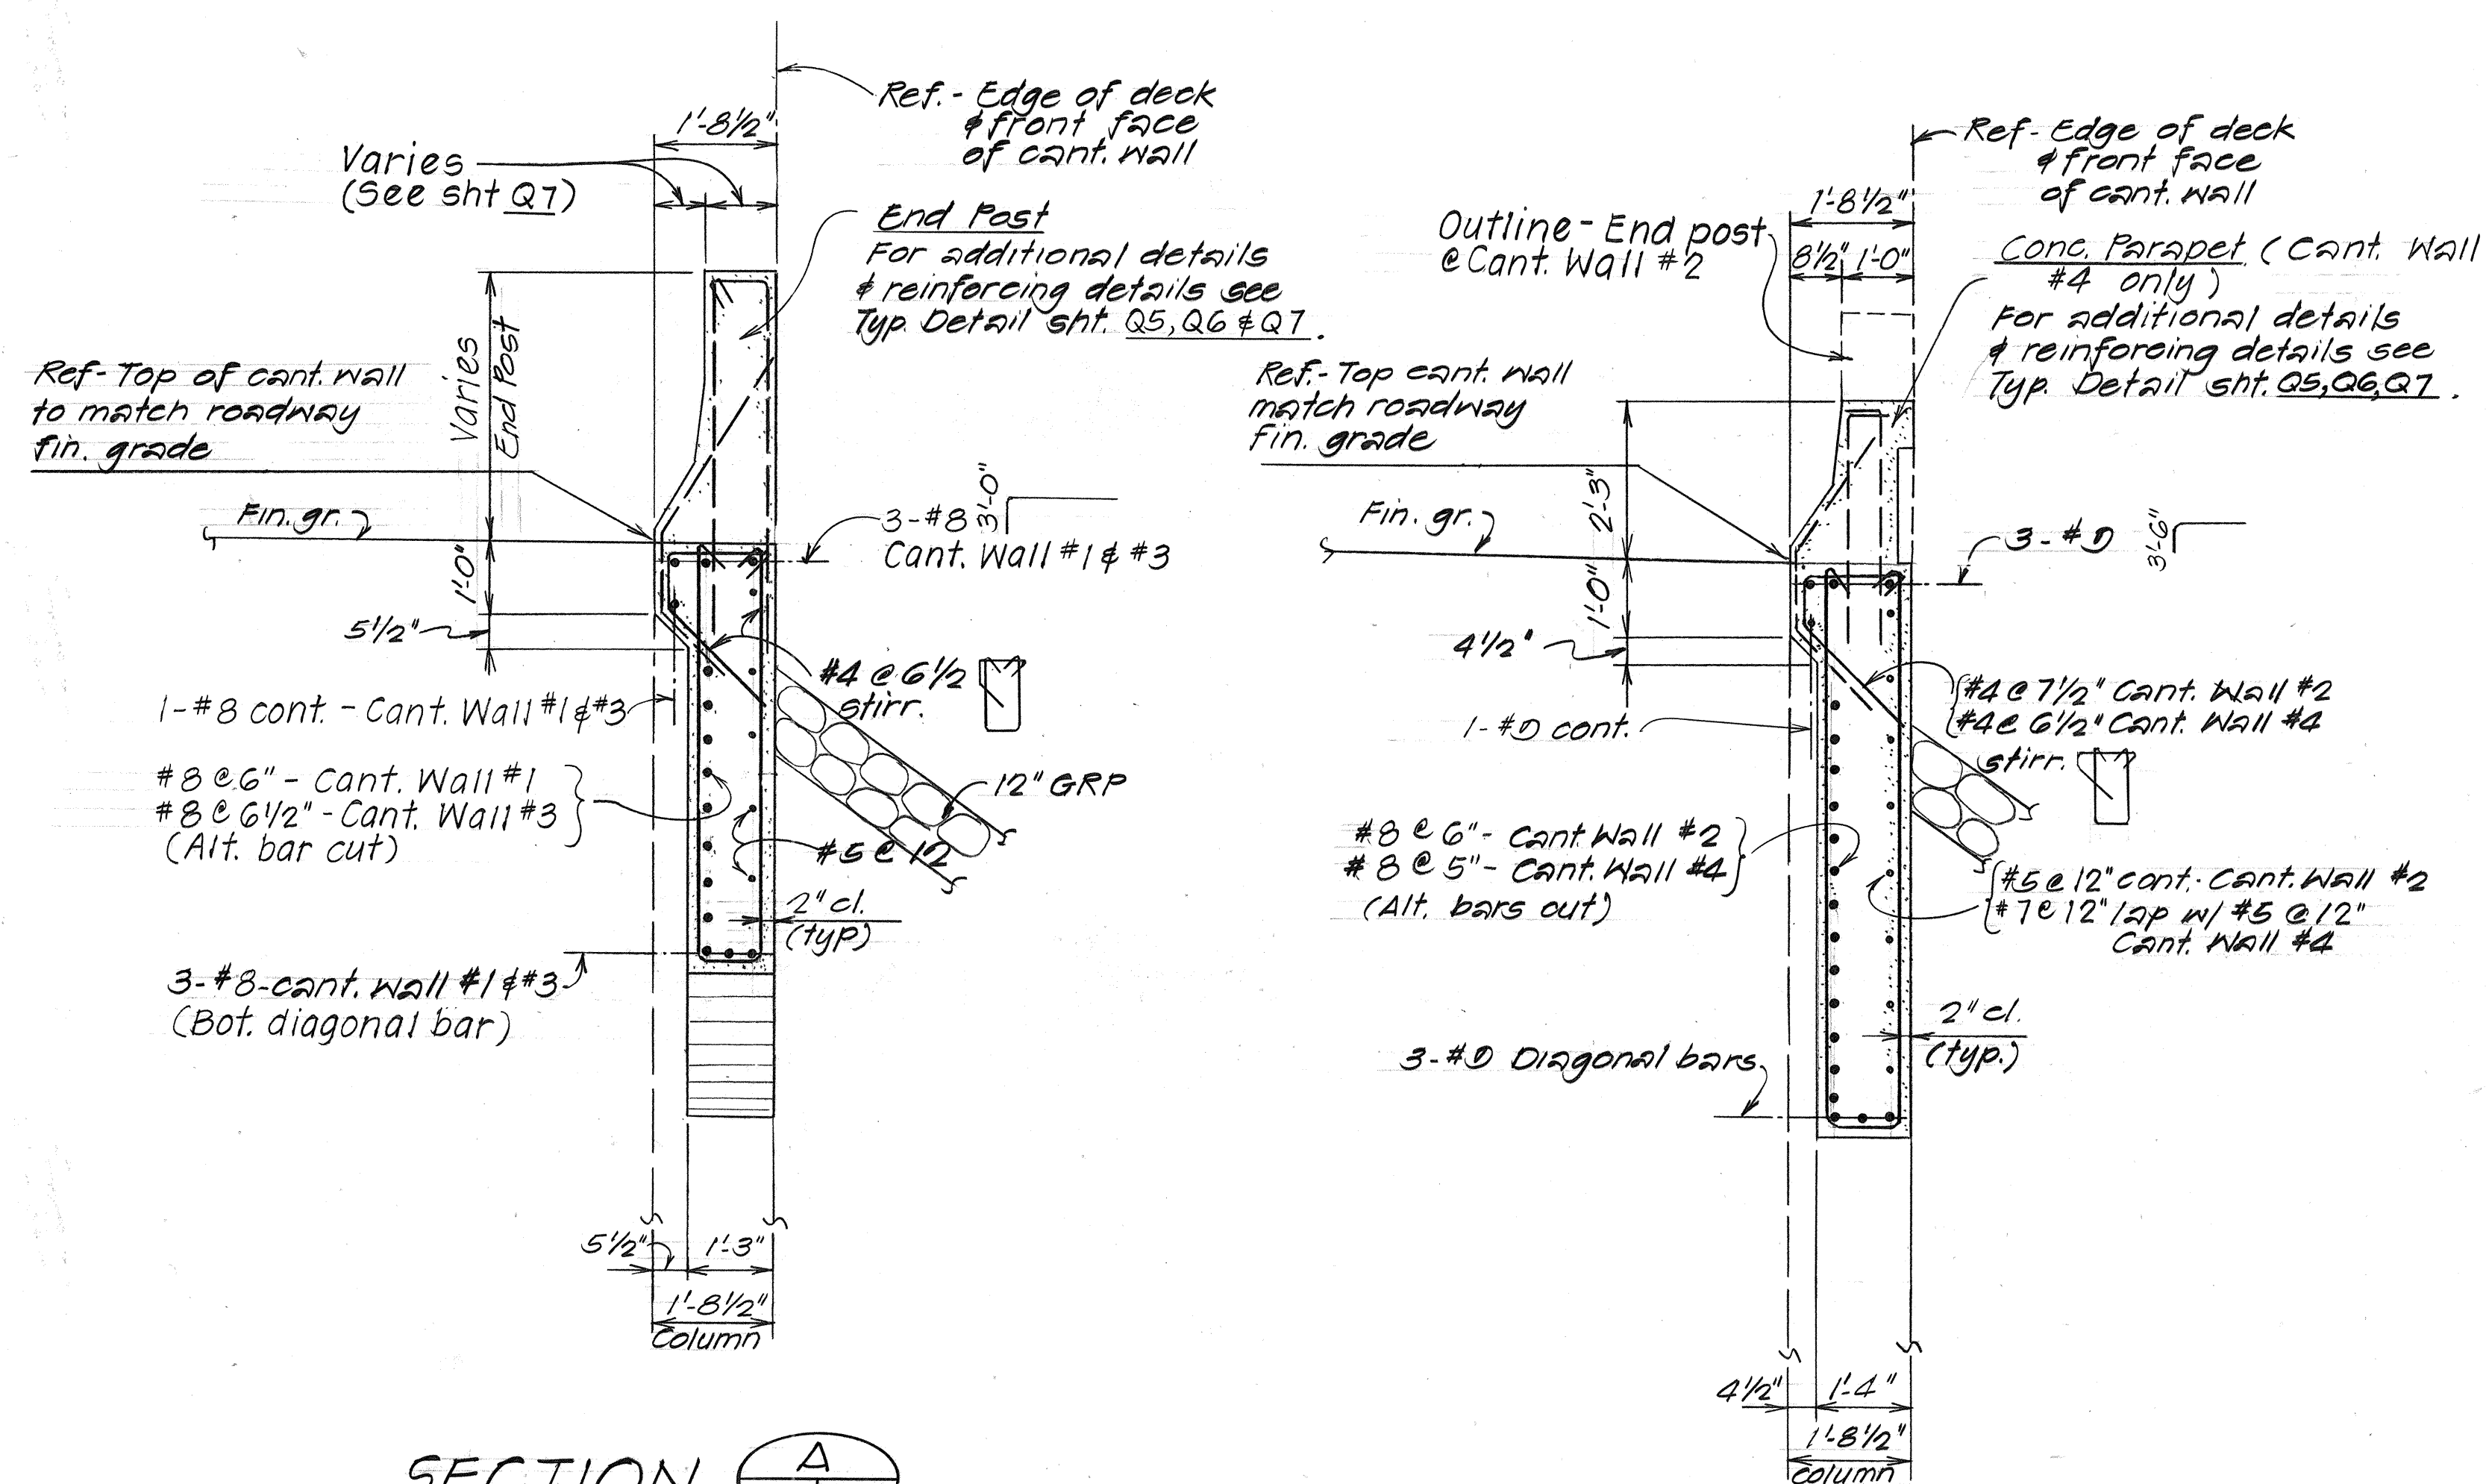

SECTION A
Scale: 1/2" = 1'-0"

SECTION B
Scale: 1/2" = 1'-0"

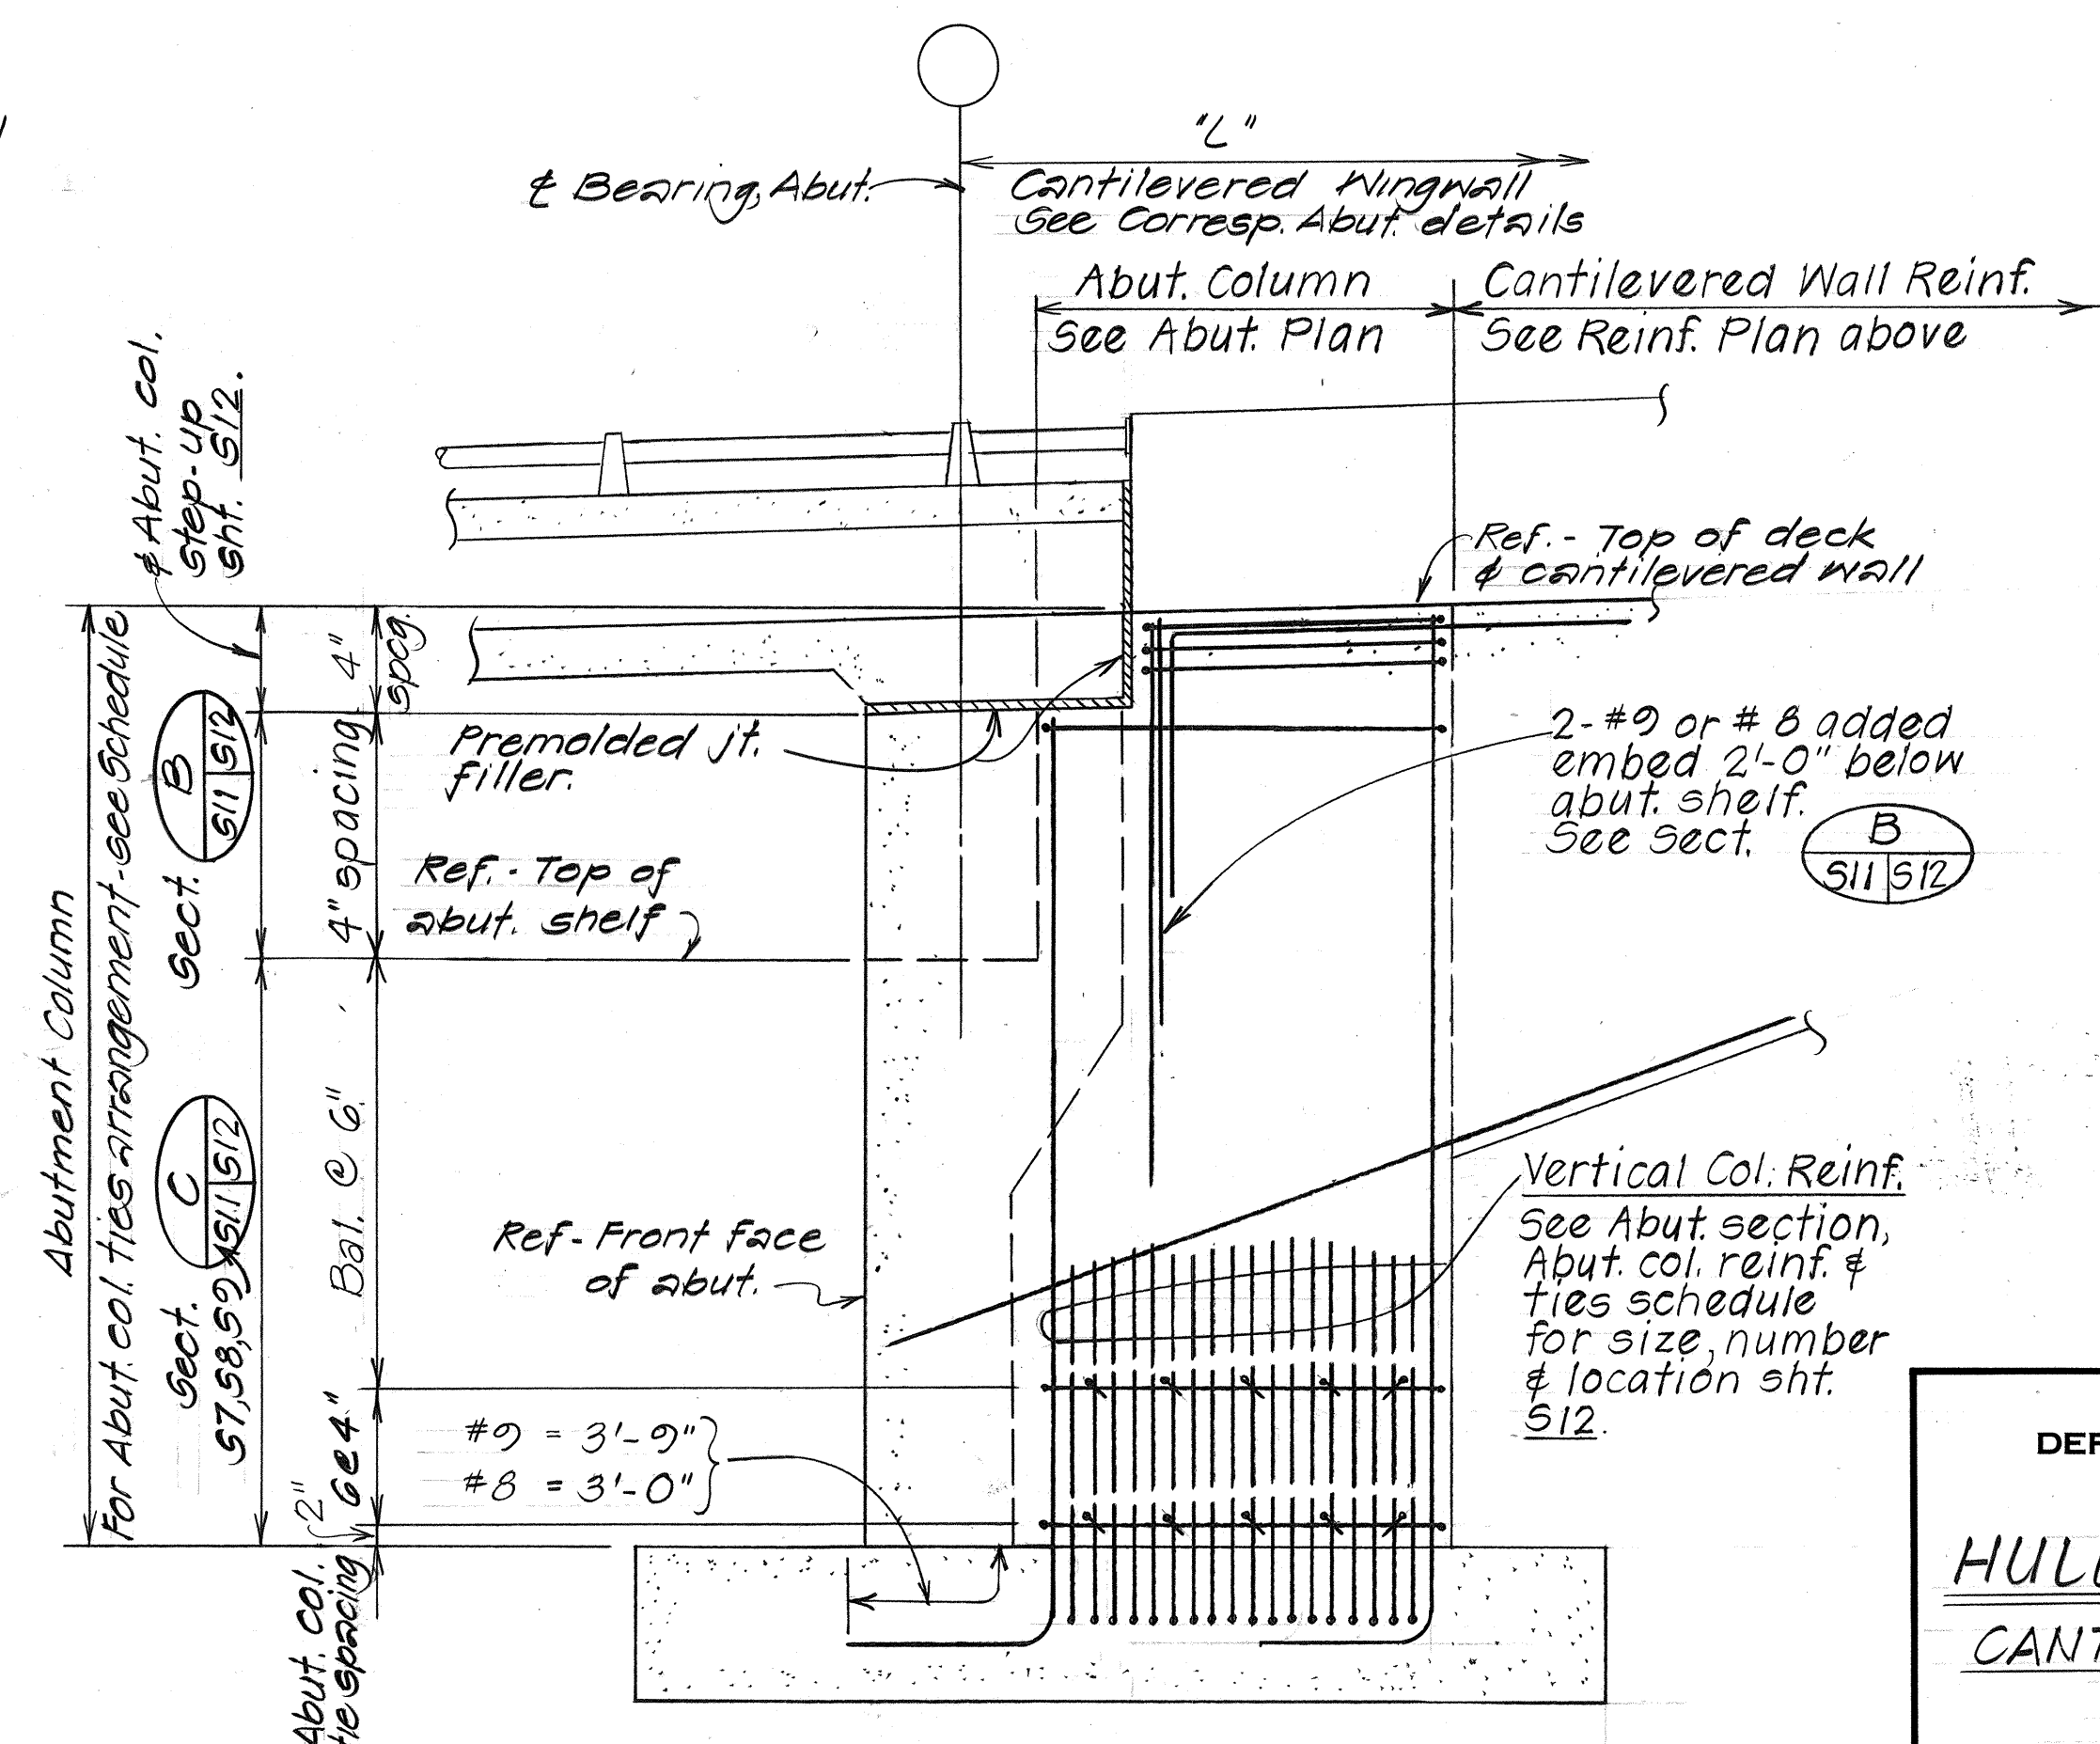

TYPICAL ELEVATION - ABUTMENT COLUMN
Not to Scale

STATE OF HAWAII
DEPARTMENT OF TRANSPORTATION
HIGHWAYS DIVISION

HULEIA STREAM BRIDGE
CANTILEVERED WALL DETAILS

KAUMUALII HWY.
PROJ. NO. BR-F-050-1(7)
Scale: As Noted Date: Aug. 1987


SHEET NO. S11 OF 22 SHEETS

ORIGINAL PLAN	DATE
NOTED BY	1/87
QUANTITIES BY	1/87
CHECKED BY	1/87


ABUTMENT COLUMN REINFORCING & TIES SCHEDULE

FED. ROAD DIST. NO.	STATE	FED. AID PROJ. NO.	FISCAL YEAR	SHEET NO.	TOTAL SHEETS
HAWAII	HAW.	BR-F-050-1(7)	1988	36	15


ABUTMENT COLUMN "A" OR "C"

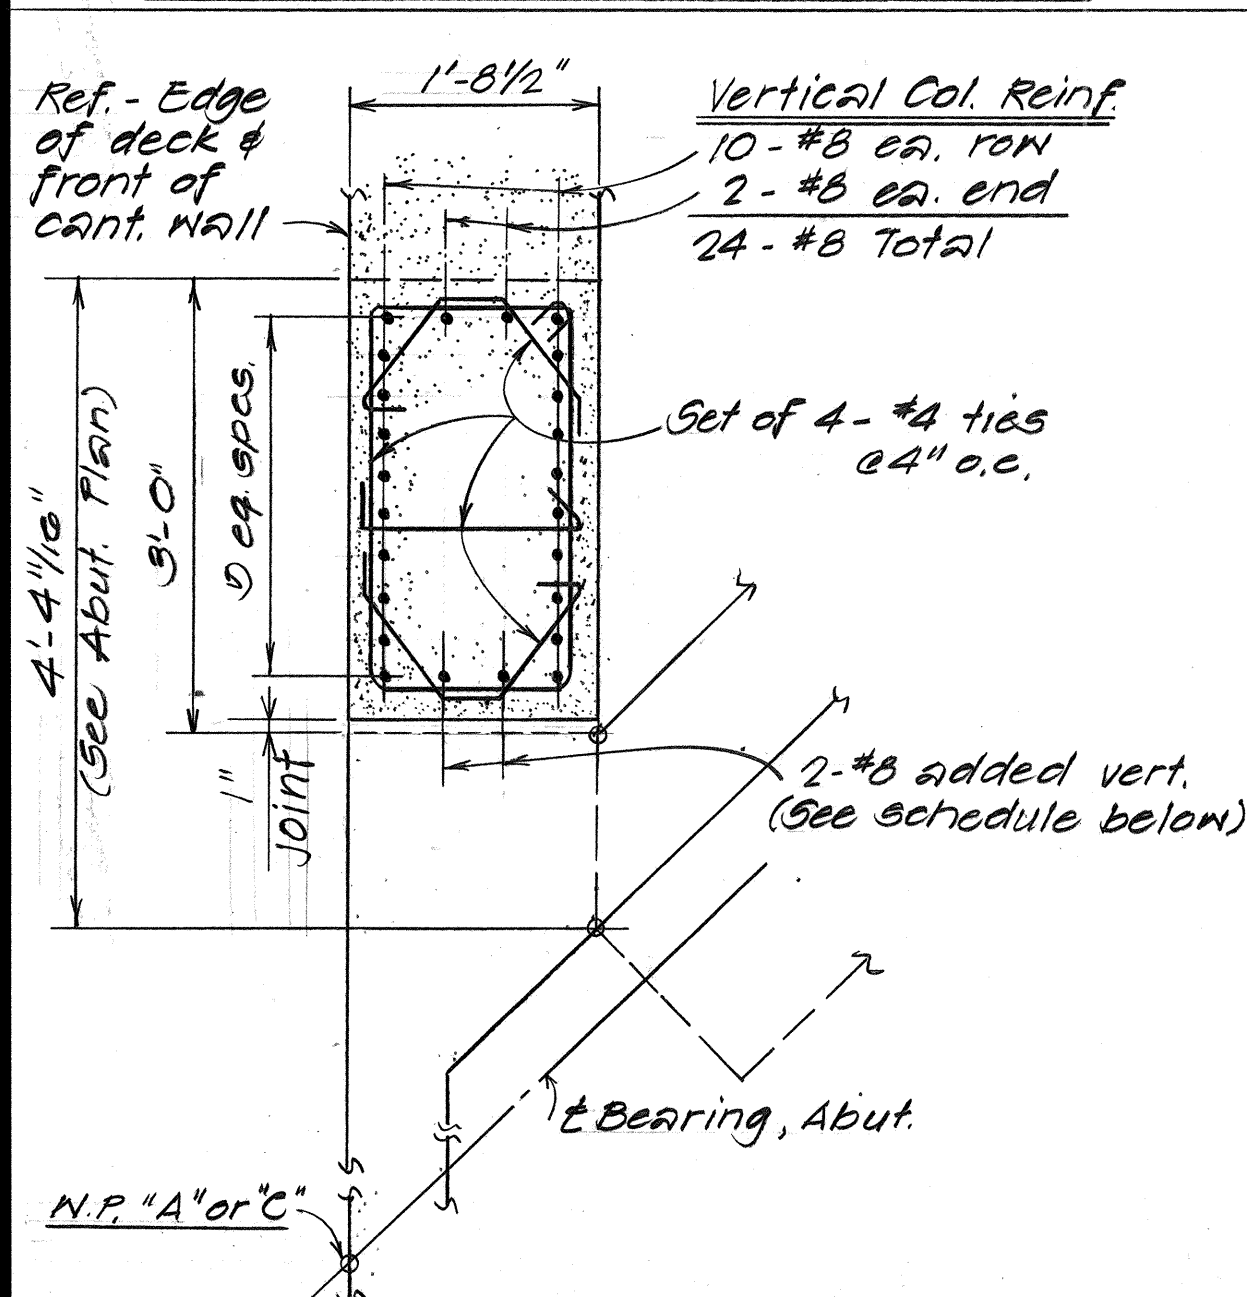




ABUTMENT COLUMN "B"

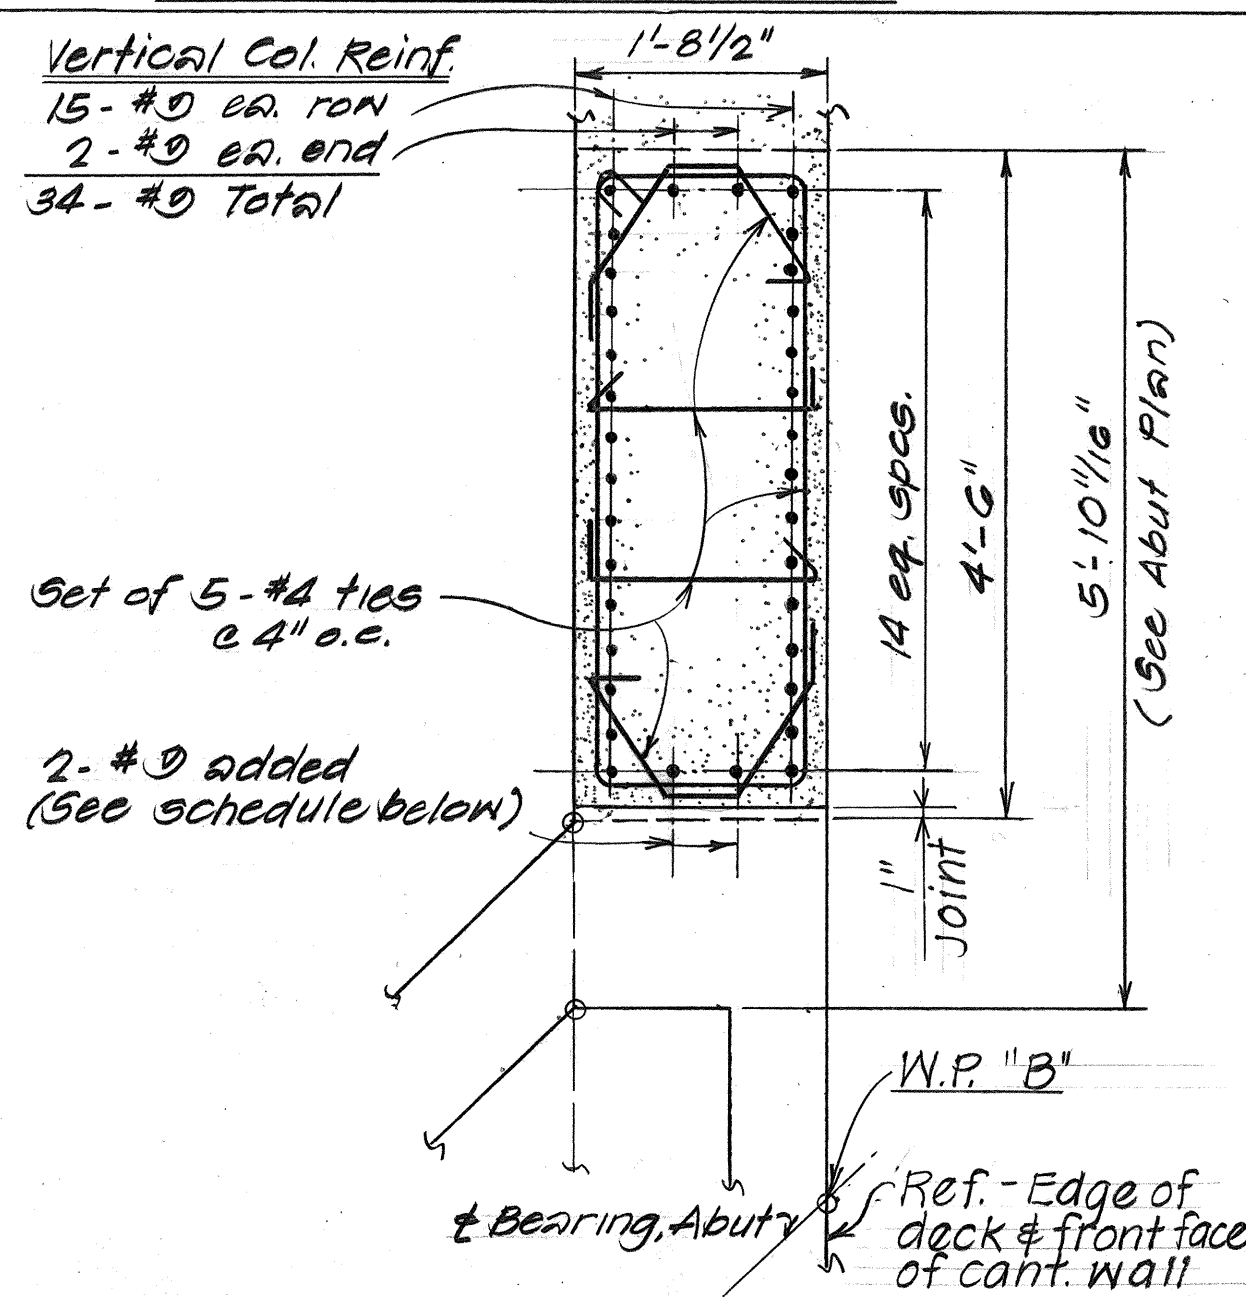




ABUTMENT COLUMN "D"

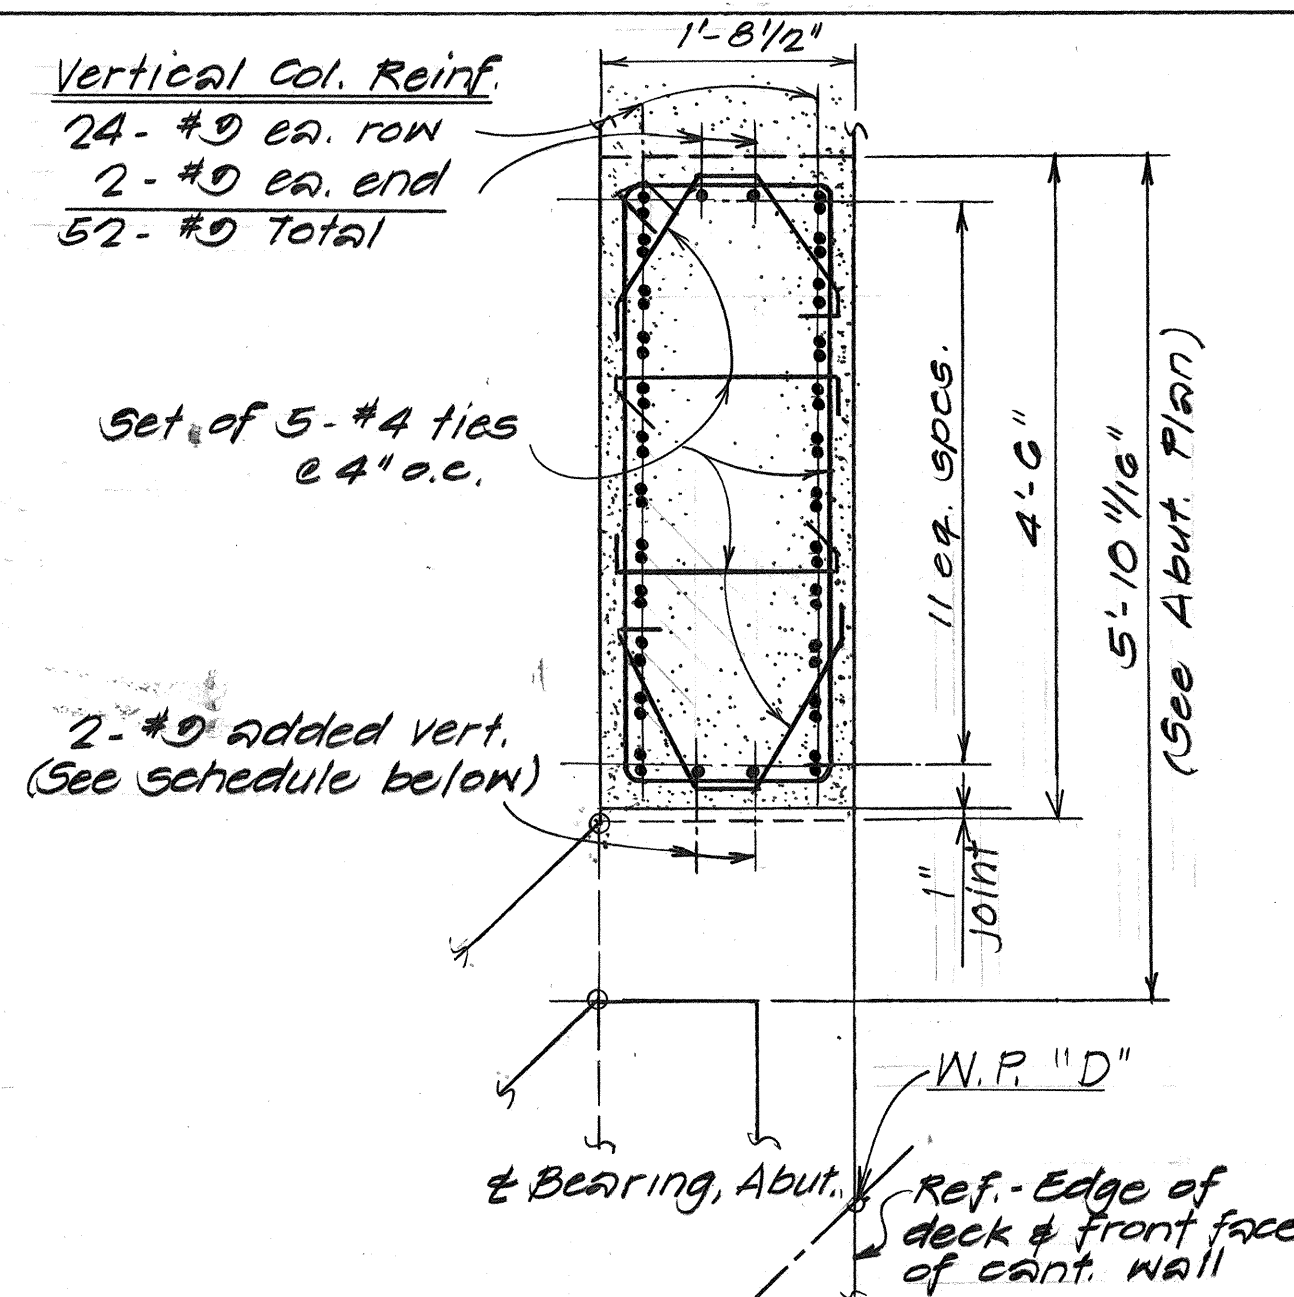

AT ABUTMENT COLUMN STEP-UP

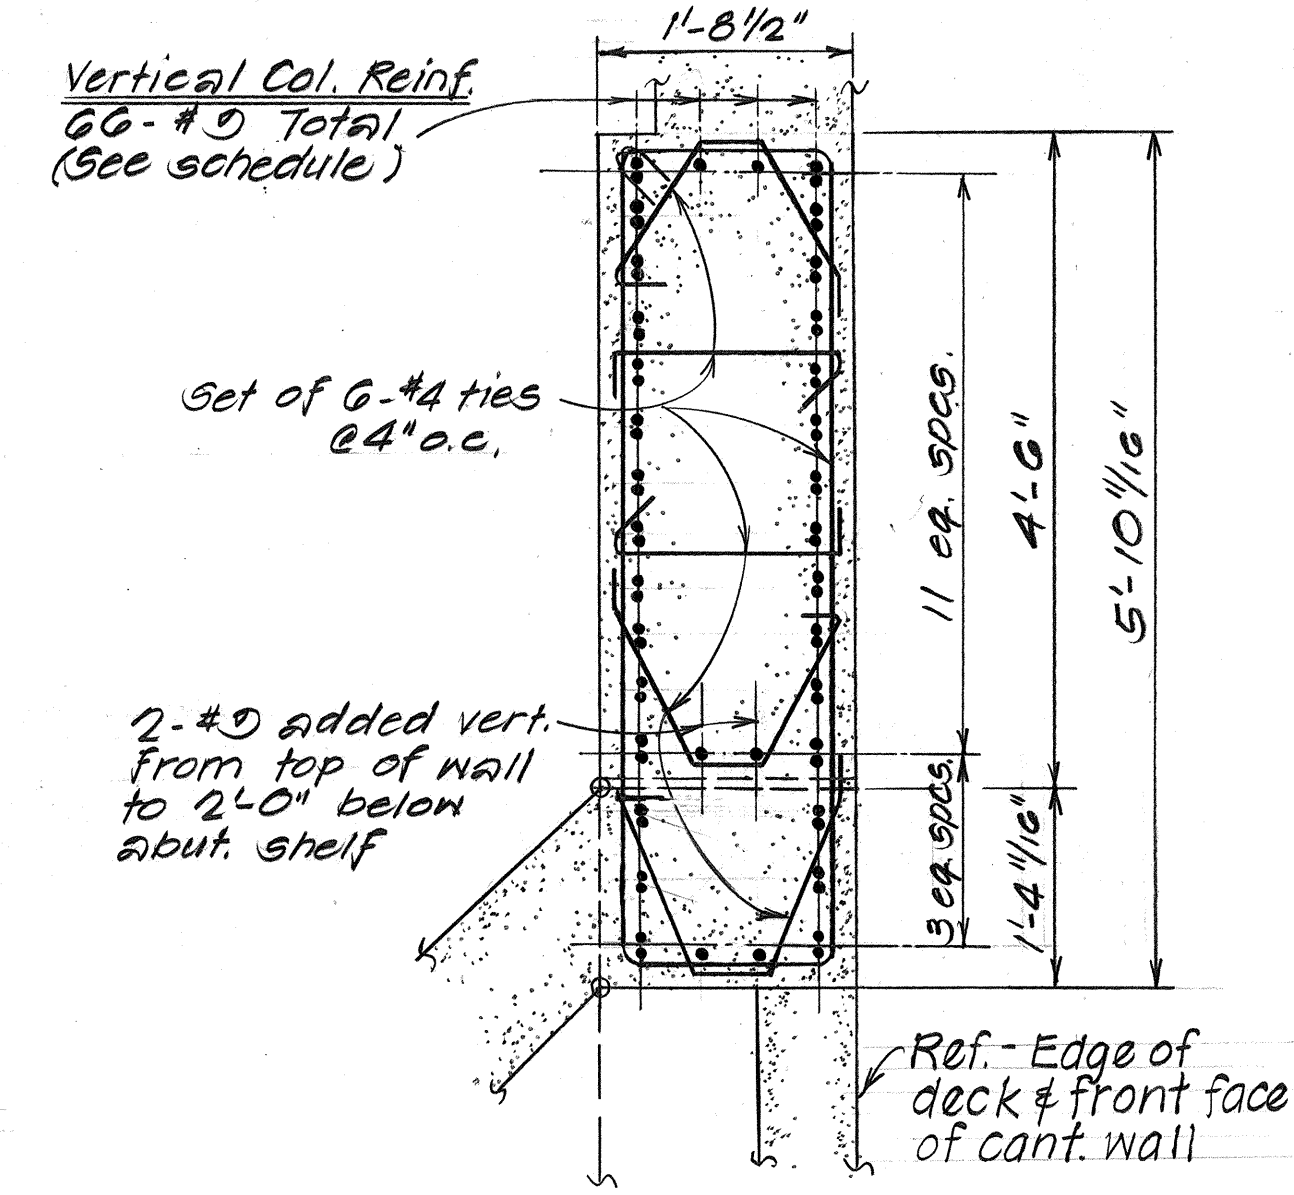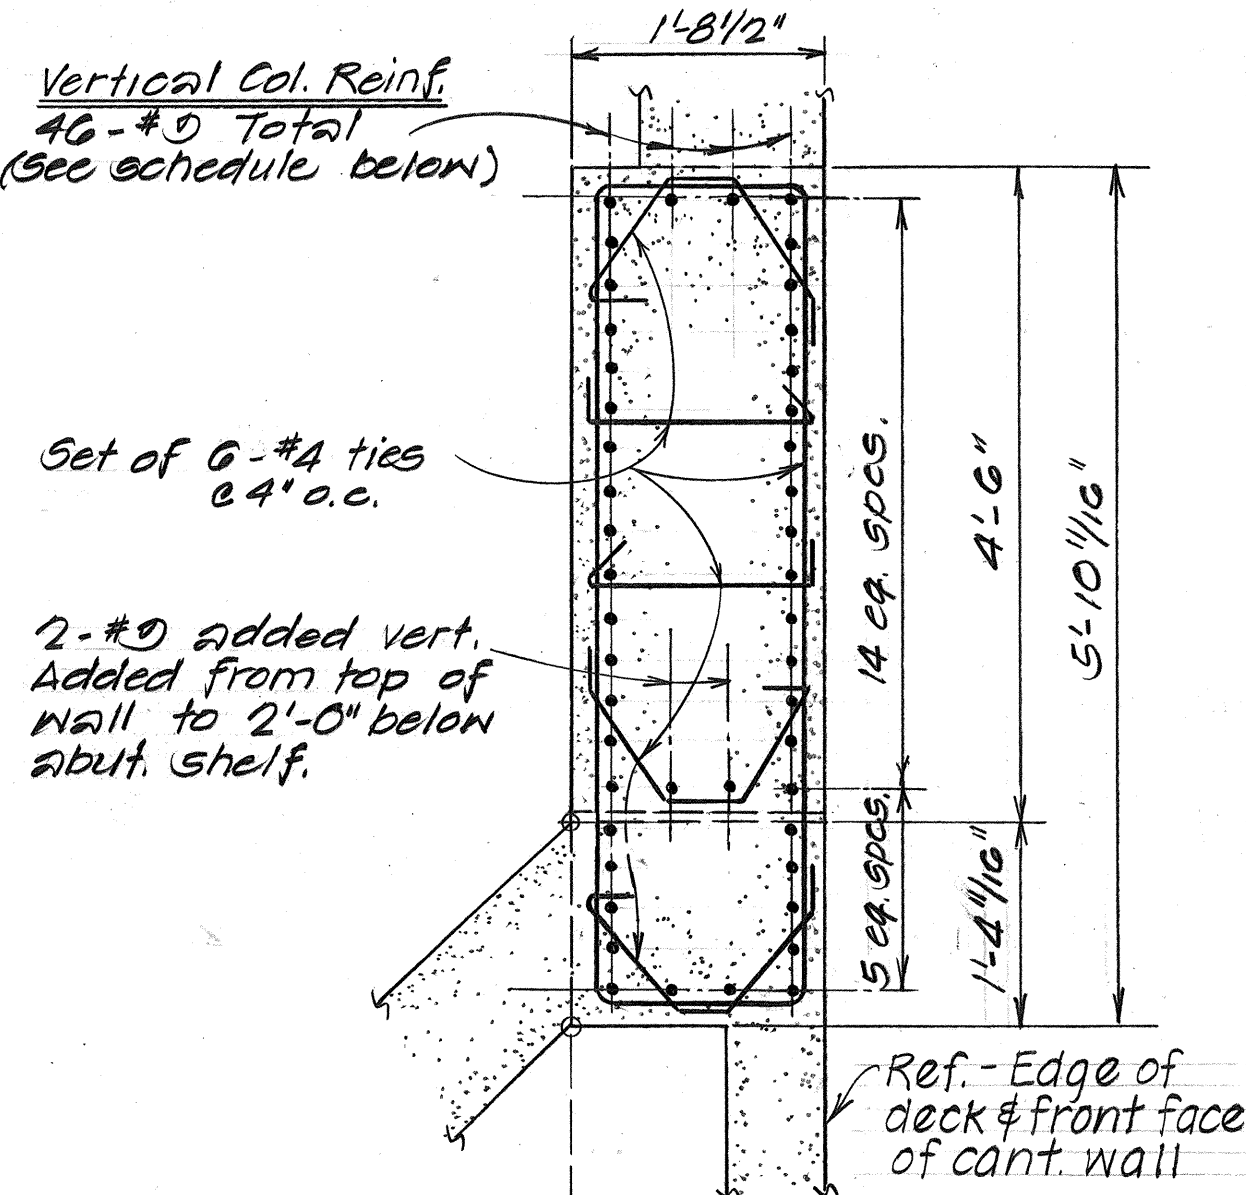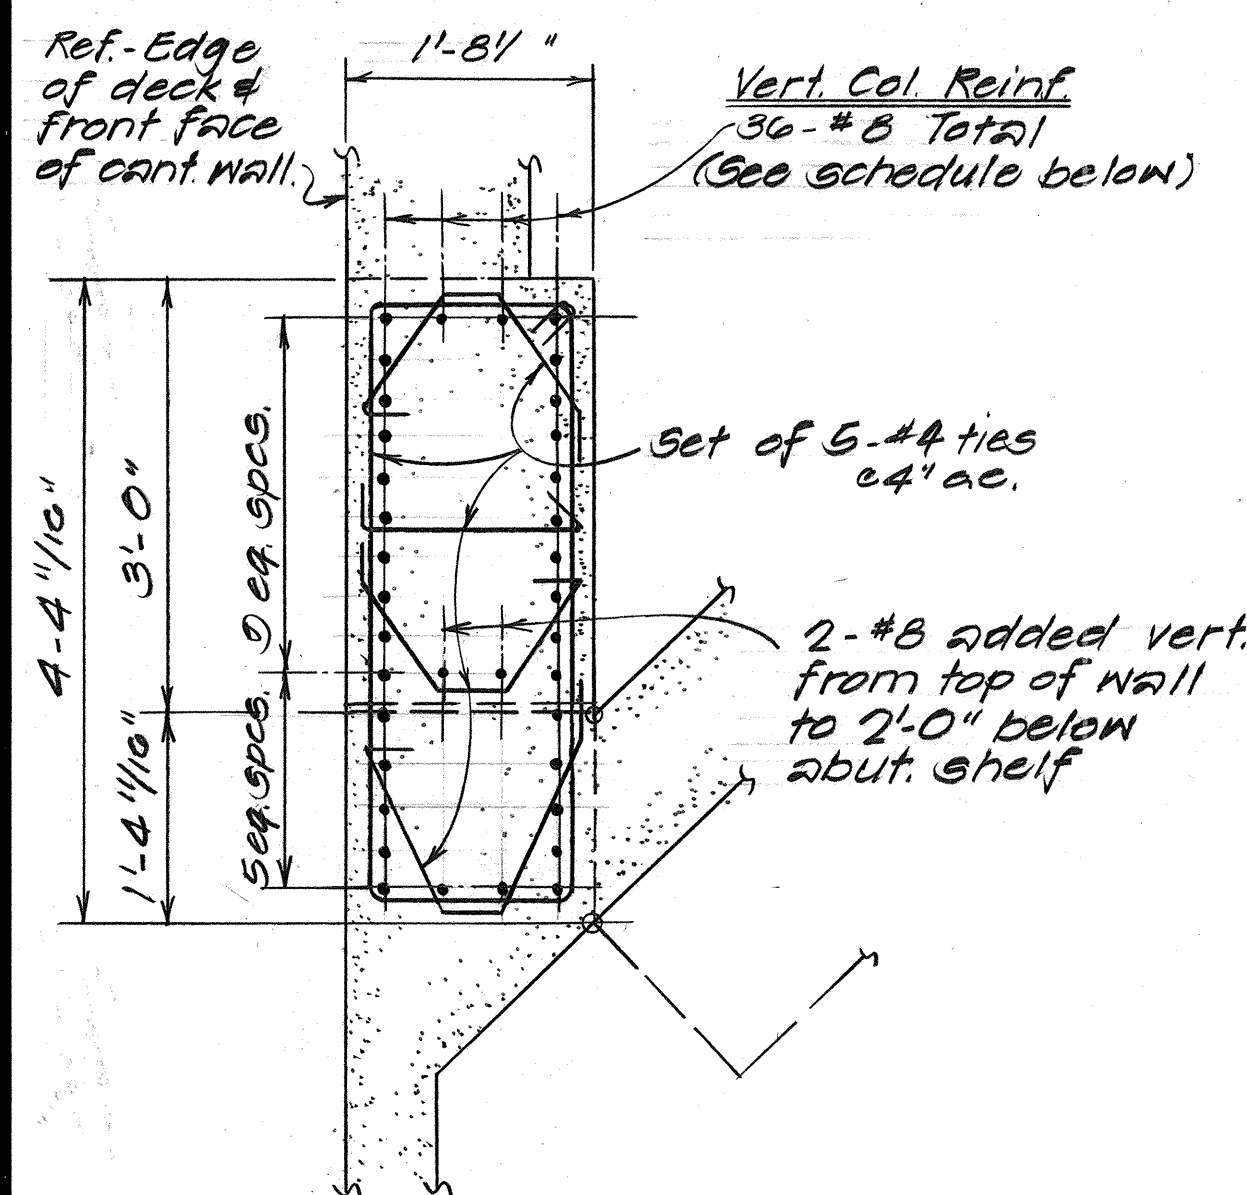

AT SECTION B 9/15/82

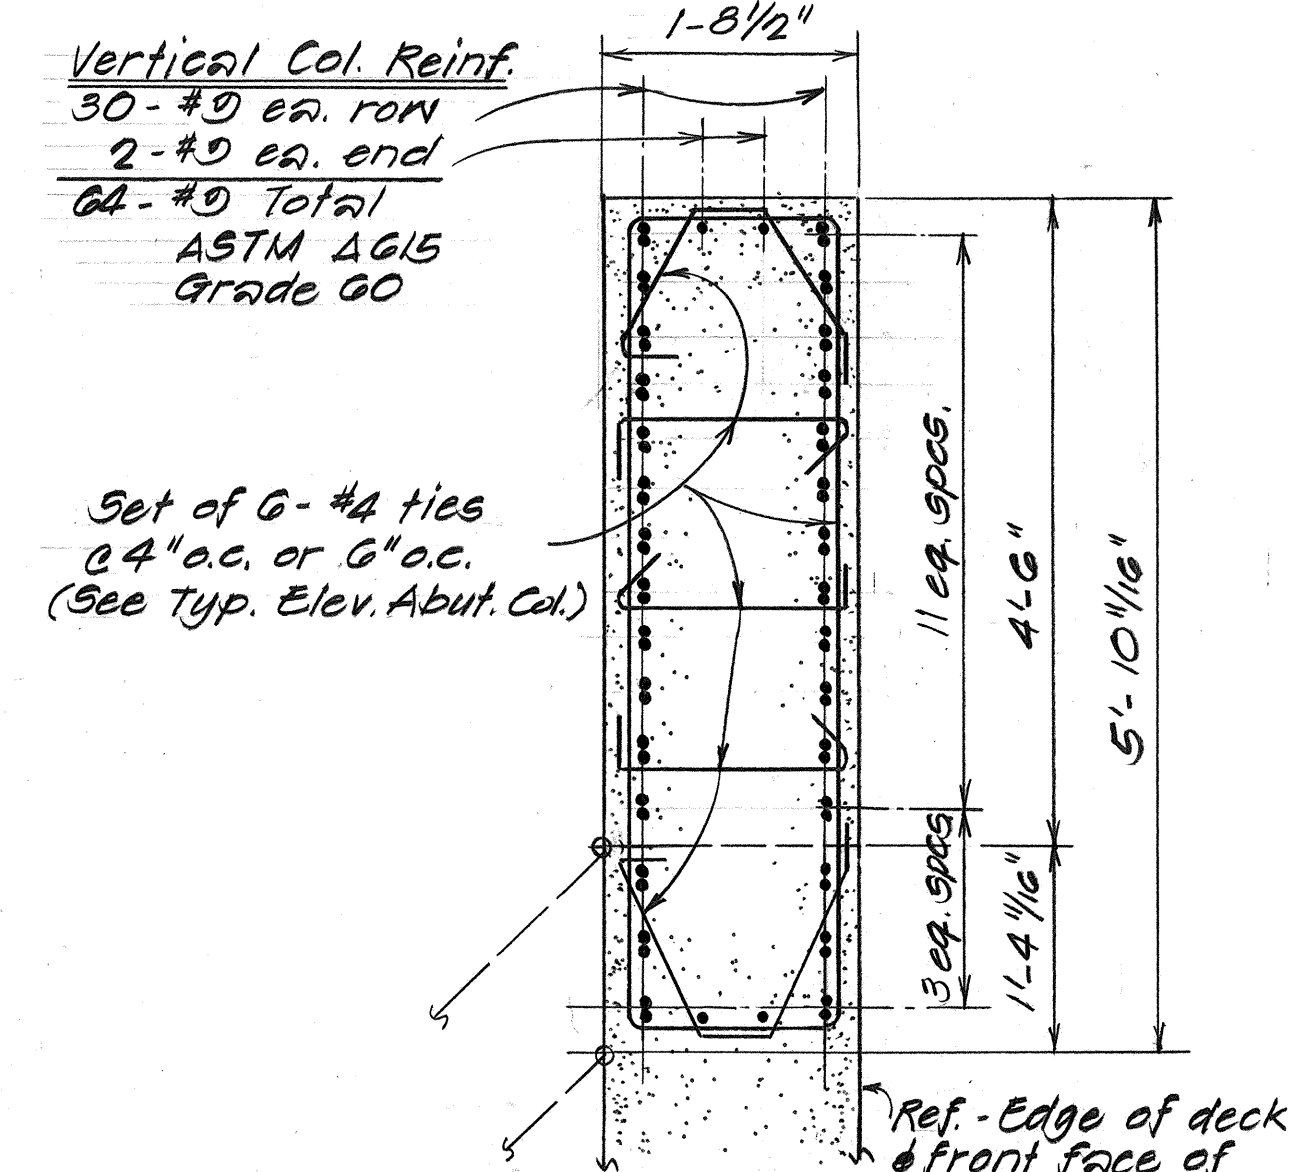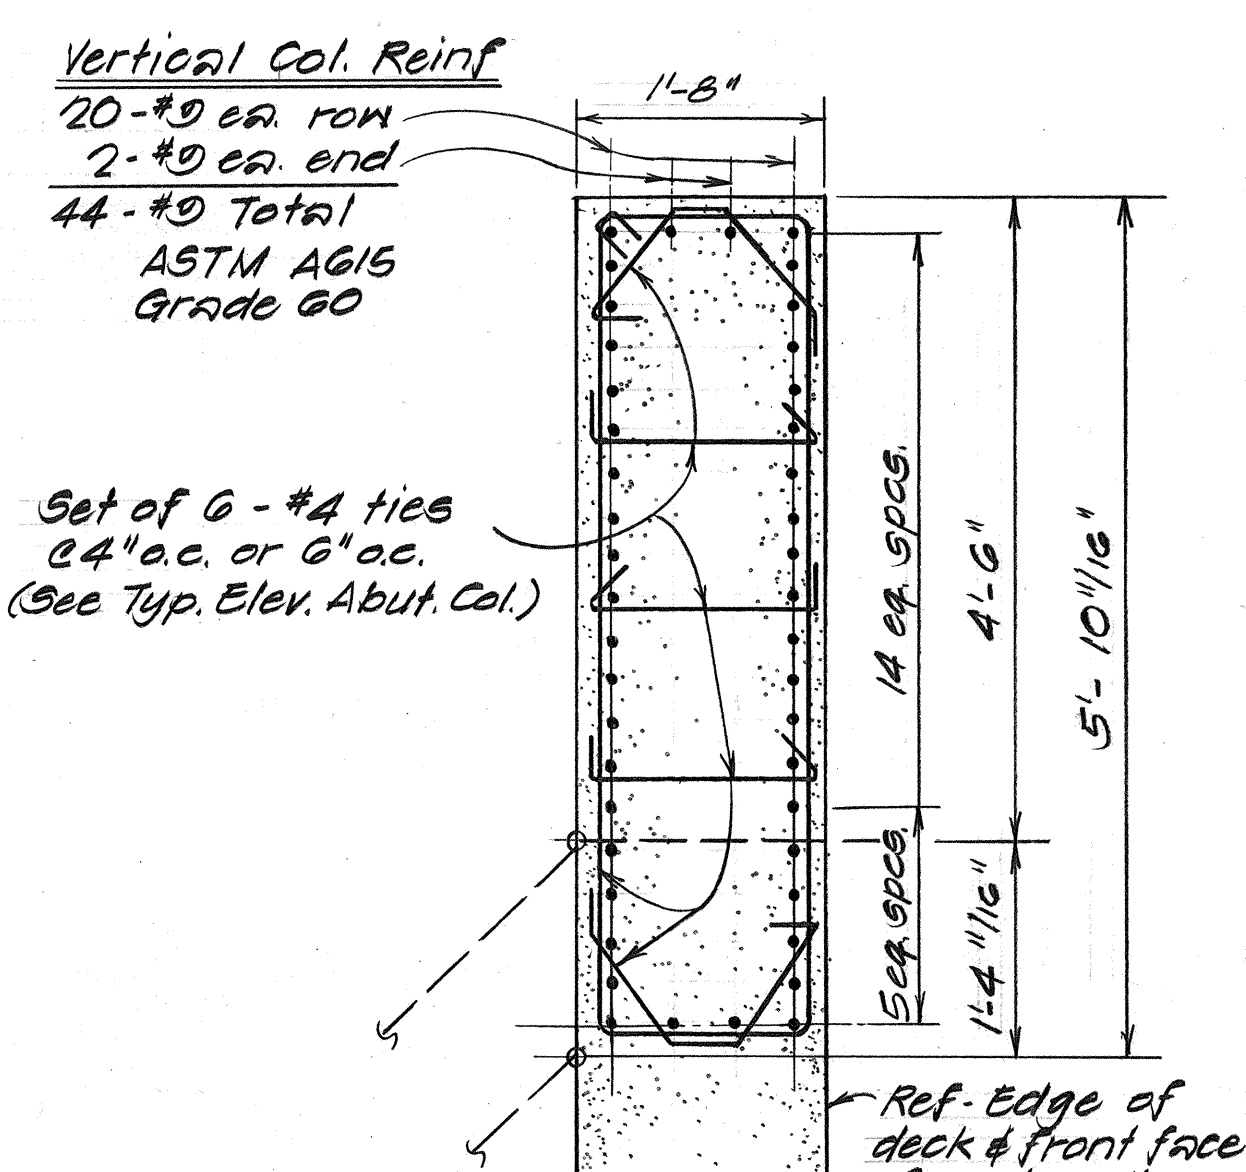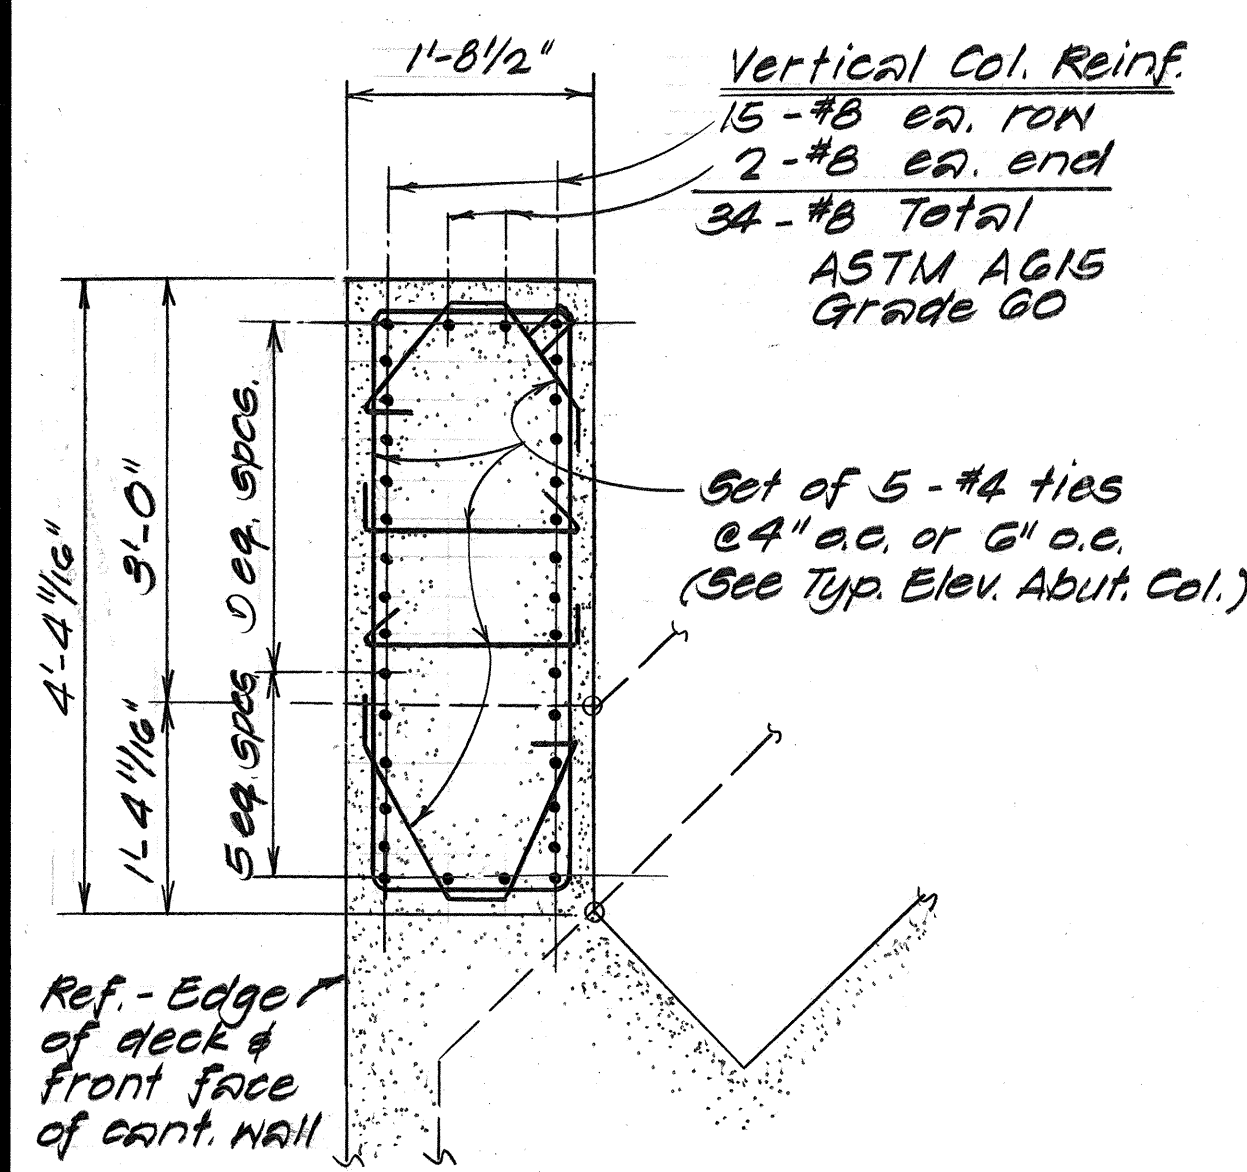

AT SECTION C 9/15/82

- Reference Note:
1. Refer to sht. 57, 58 for Abutment Plan.
 2. Refer to sht. 511 for Typical Abutment Column Elevation & Cantilevered Wall.
 3. Alternate hook ends of column ties @ each layer.


SURVEY PLOTTED BY	DATE
DRAWN BY	7/87
TRACED BY	7/87
CHECKED BY	7/87
QUANTITIES BY	7/87
NOTES BY	7/87
CHECKED BY	7/87
NO.	

STATE OF HAWAII
DEPARTMENT OF TRANSPORTATION
HIGHWAYS DIVISION


HULEIA STREAM BRIDGE
ABUTMENT COLUMN REINFORCEMENT
& TIES SCHEDULE
KAUMUALII HWY.
PROJ. NO. BR-F-050-1(7)
Scale: 3/4" = 1'-0" Date: Aug. 1987

SHEET NO. 512 OF 22 SHEETS

FED. ROAD DIST. NO.	STATE	FED. AID PROJ. NO.	FISCAL YEAR	SHEET NO.	TOTAL SHEETS
HAWAII	HAW.	BR-F-050-1(7)	1988	37	15

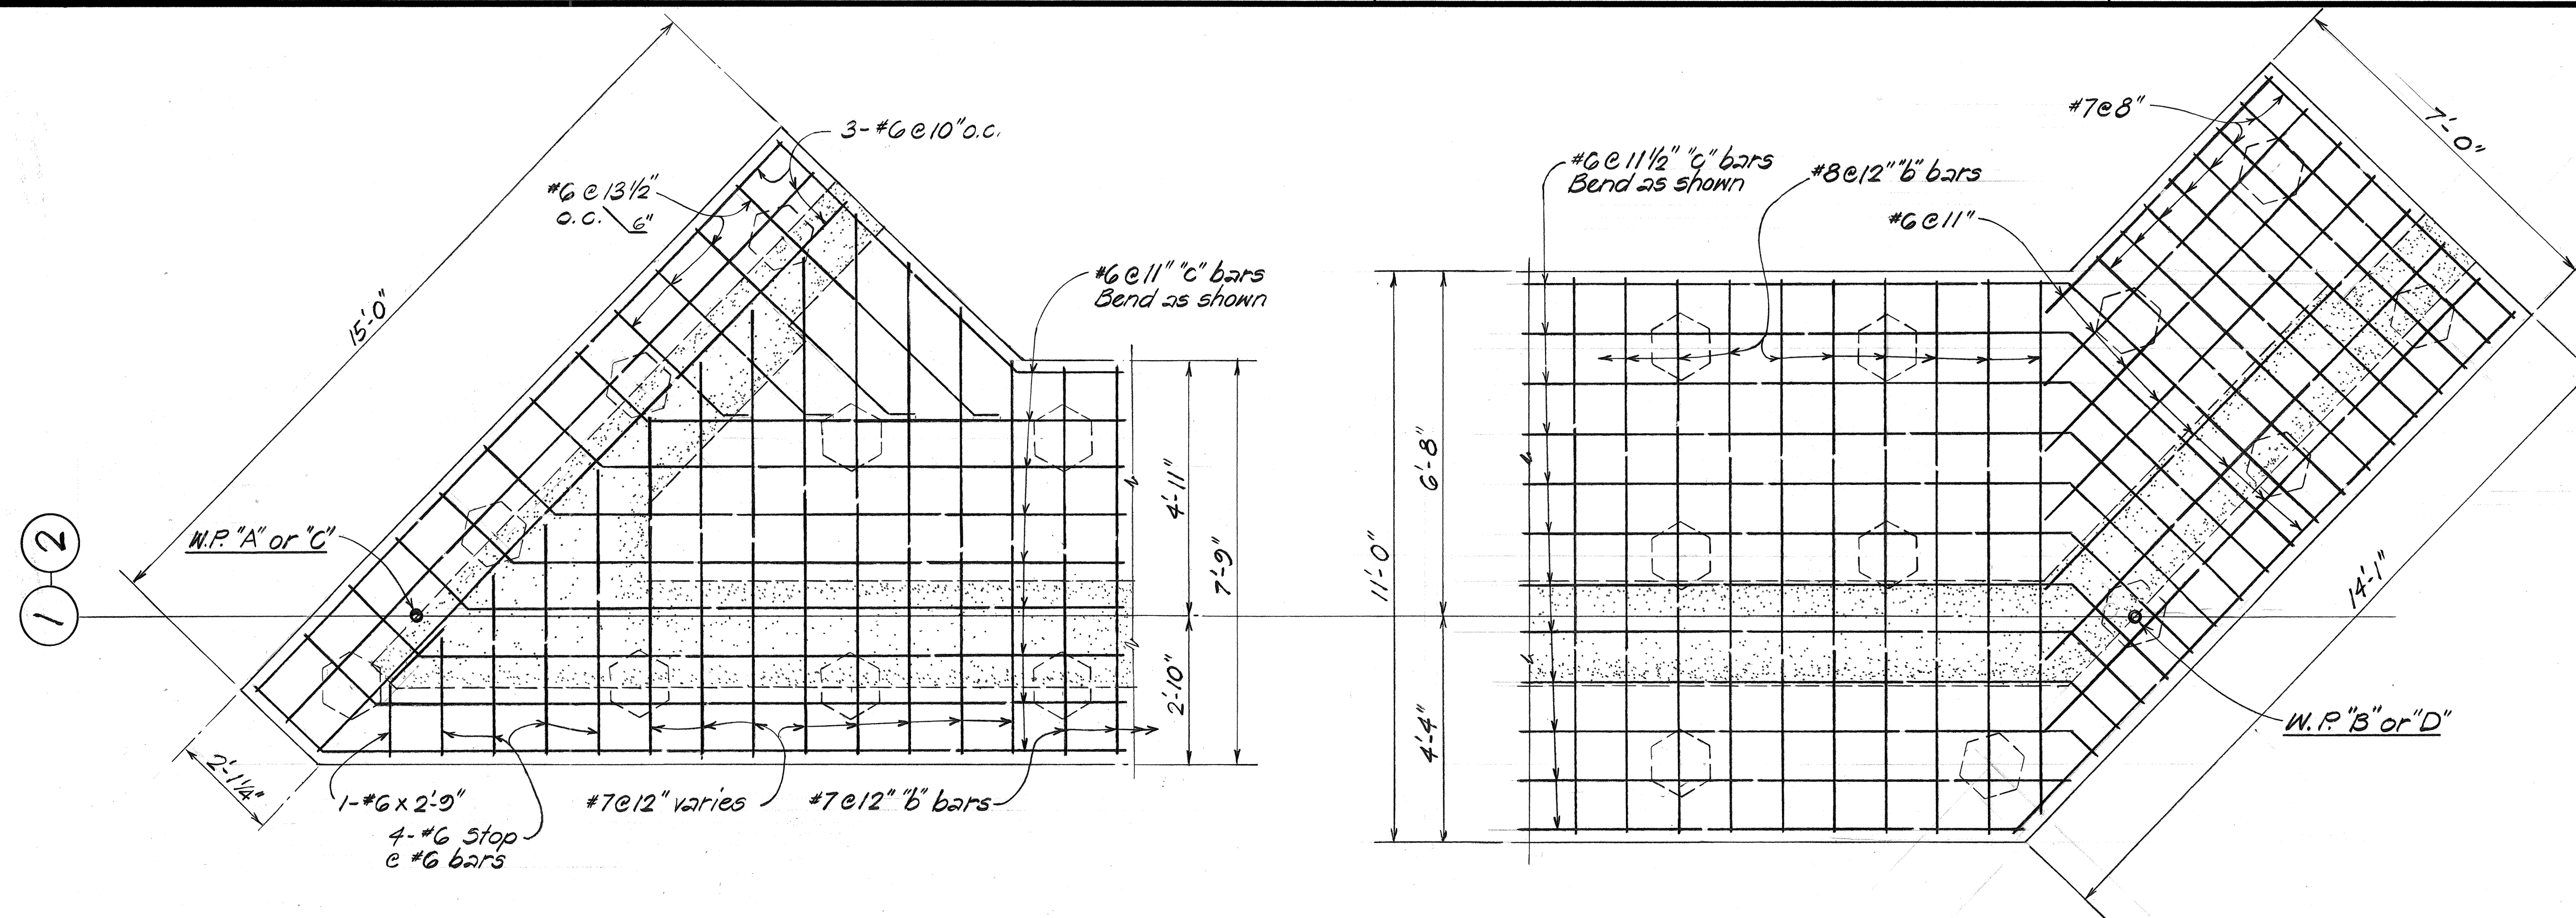

TYPICAL ABUT. FOOTING
STEP-UP DETAIL A
 Scale: 1/2" = 1'-0" 58

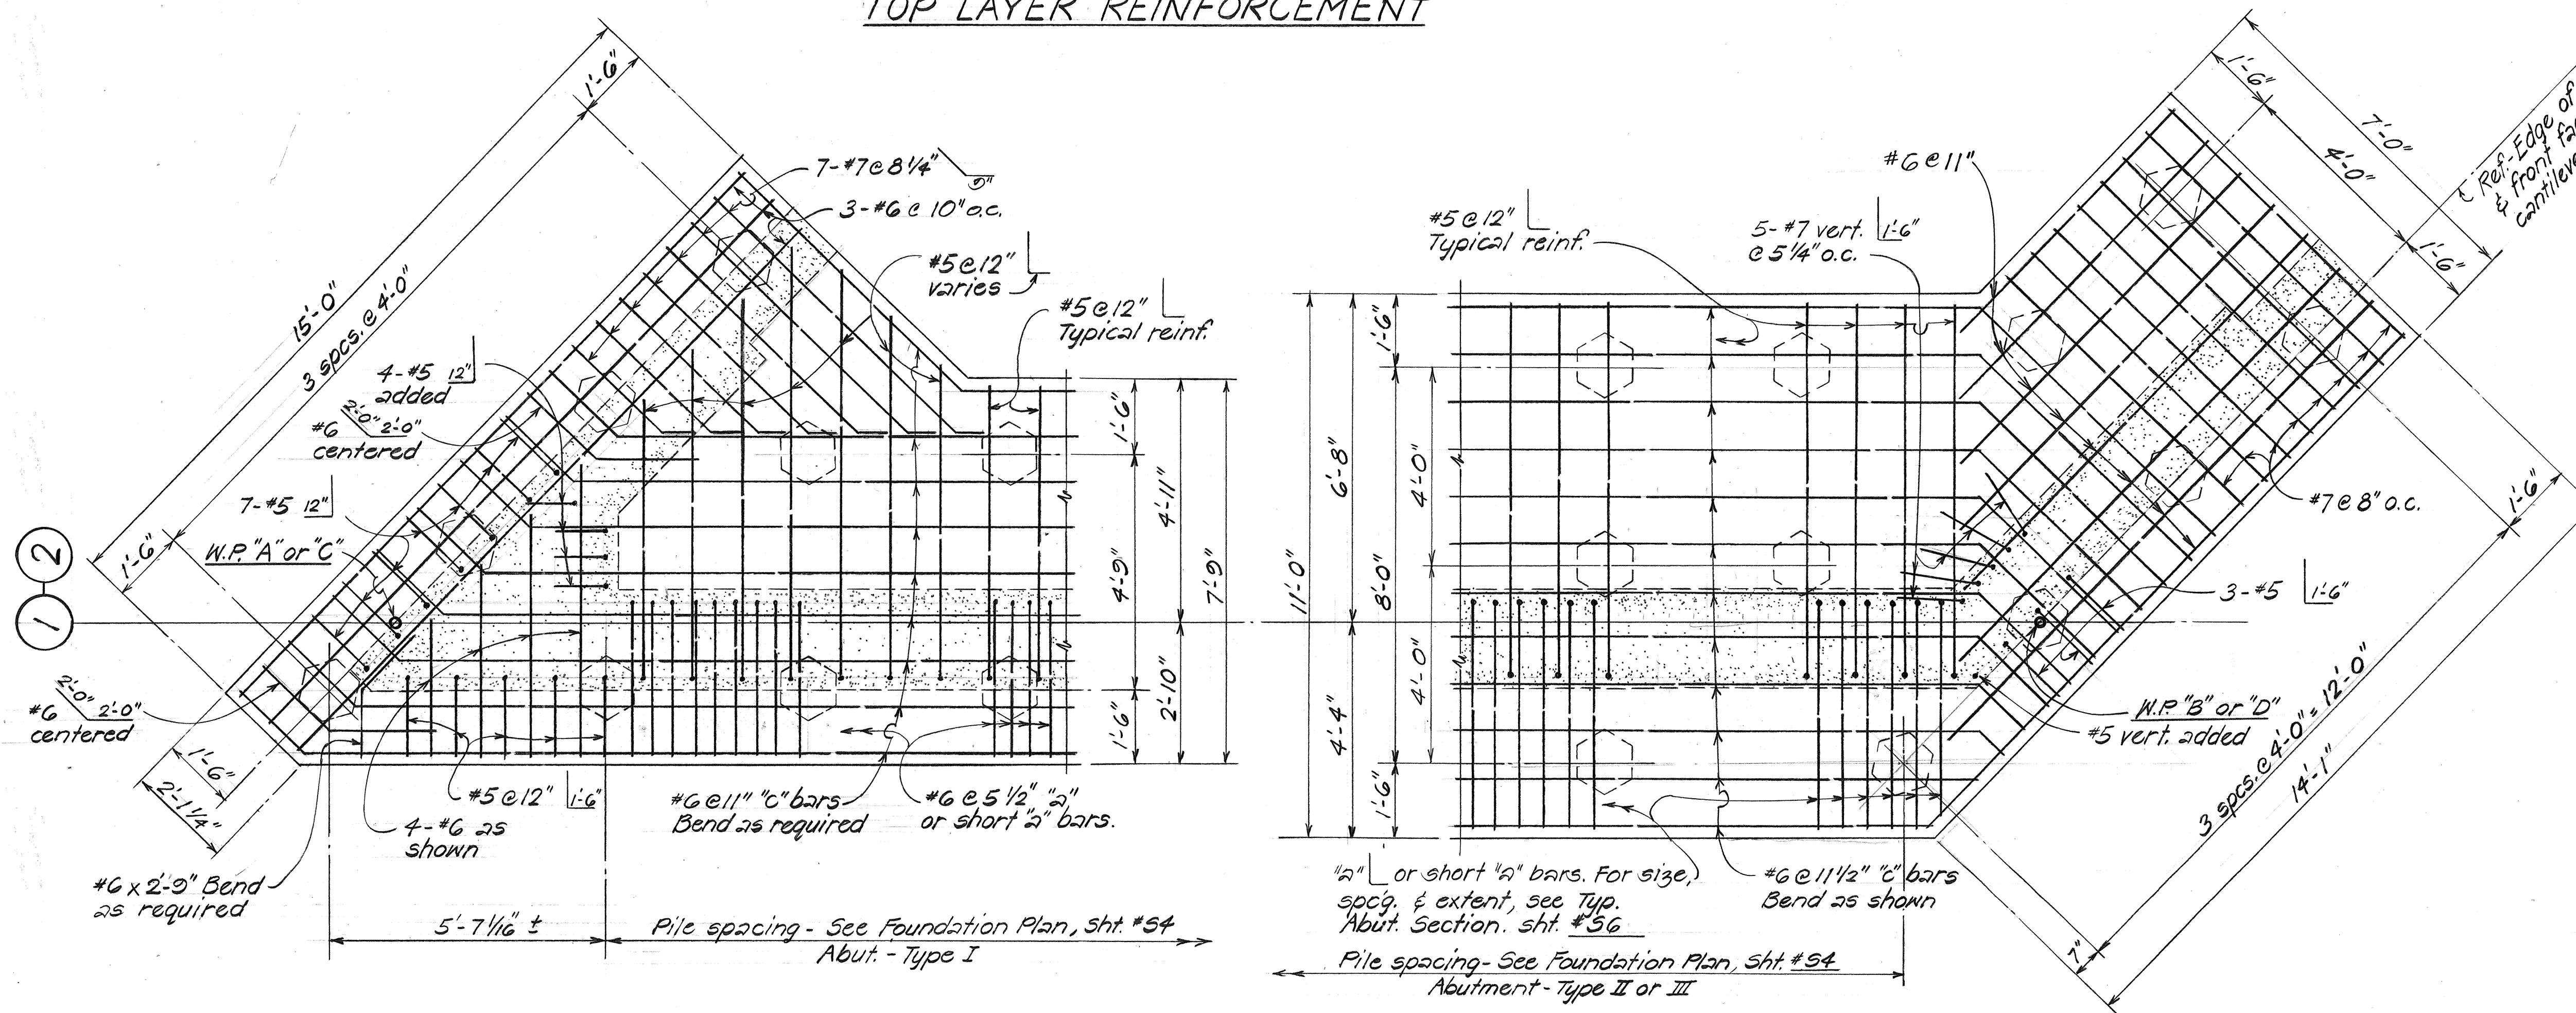


BOTTOM LAYER REINFORCEMENT
PART PLAN-ABUTMENT ① & ② FOOTING REINFORCEMENT
 Scale: 1/2" = 1'-0"

STATE OF HAWAII
 DEPARTMENT OF TRANSPORTATION
 HIGHWAYS DIVISION
HULEIA STREAM BRIDGE
 ABUTMENT FOOTING REINFORCEMENT
 & STEP-UP DETAIL
 KAUMUALII HWY.
 PROJ. NO. BR-F-050-1(7)
 Scale: As Noted Date: Aug. 1987
 SHEET No. 5/3 OF 22 SHEETS

ORIGINAL PLAN	DATE
TRACED BY	
NOTED BY	
CHECKED BY	
NO.	


FED. ROAD DIST. NO.	STATE	FED. AID PROJ. NO.	FISCAL YEAR	SHEET NO.	TOTAL SHEETS
HAWAII	HAW.	BR-F-050-1(7)	1988	20	15

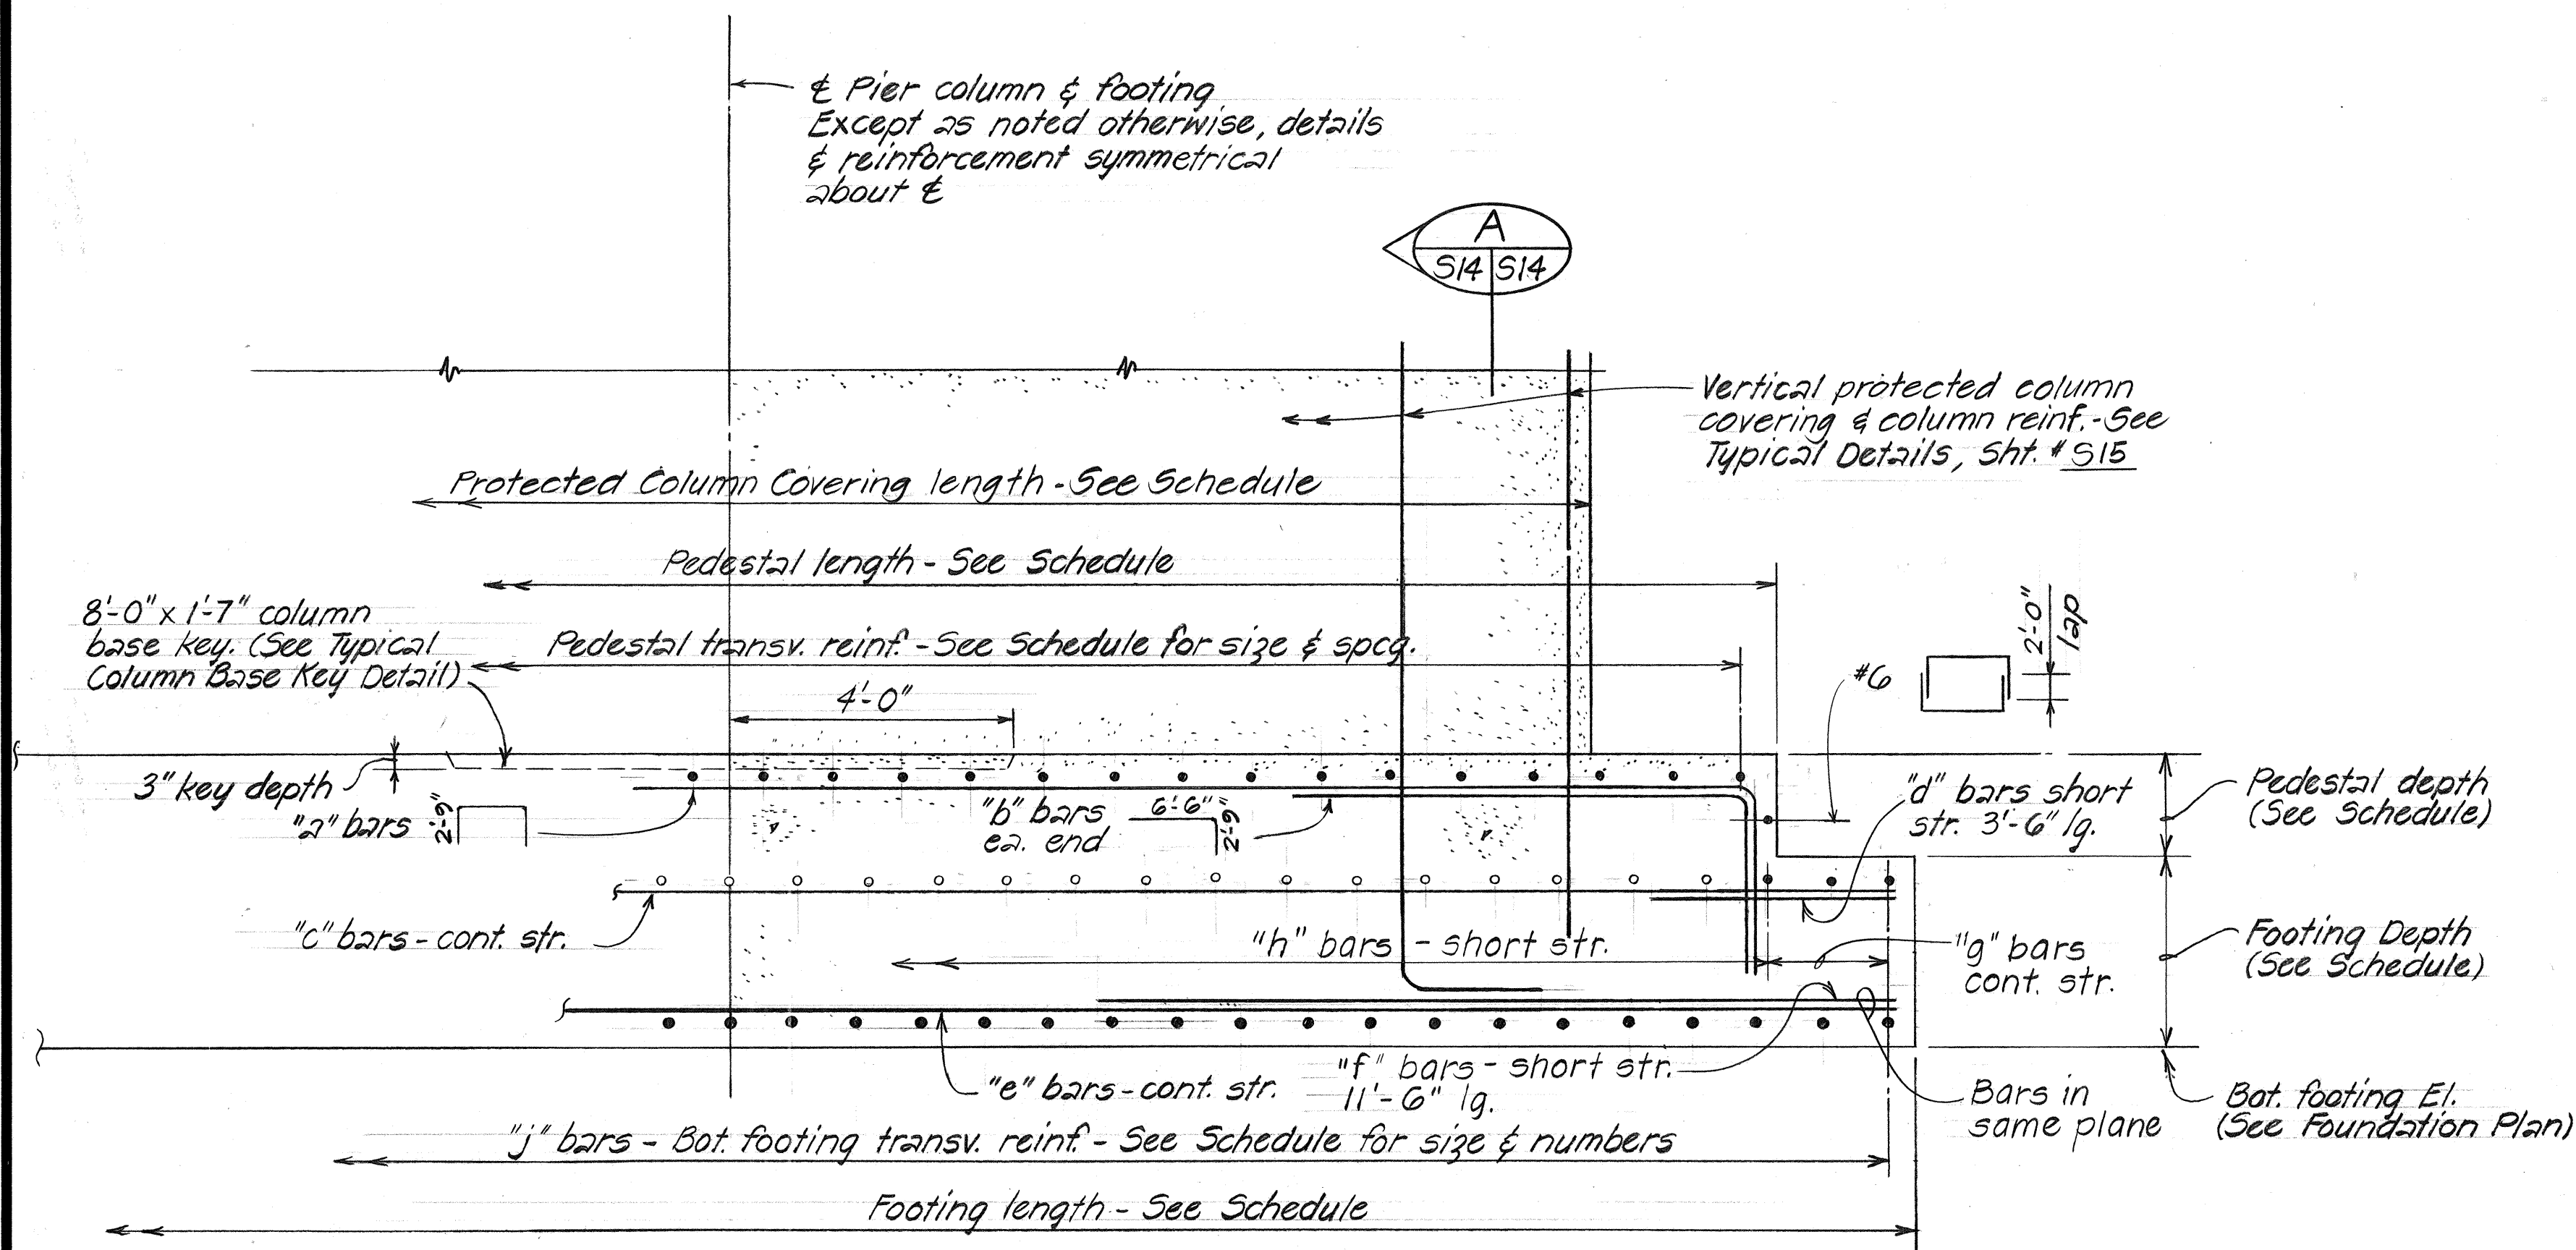

ELEVATION - PIER FOOTING

TYPICAL PIER FOOTING DETAIL


Scale: 1/2" = 1'-0"

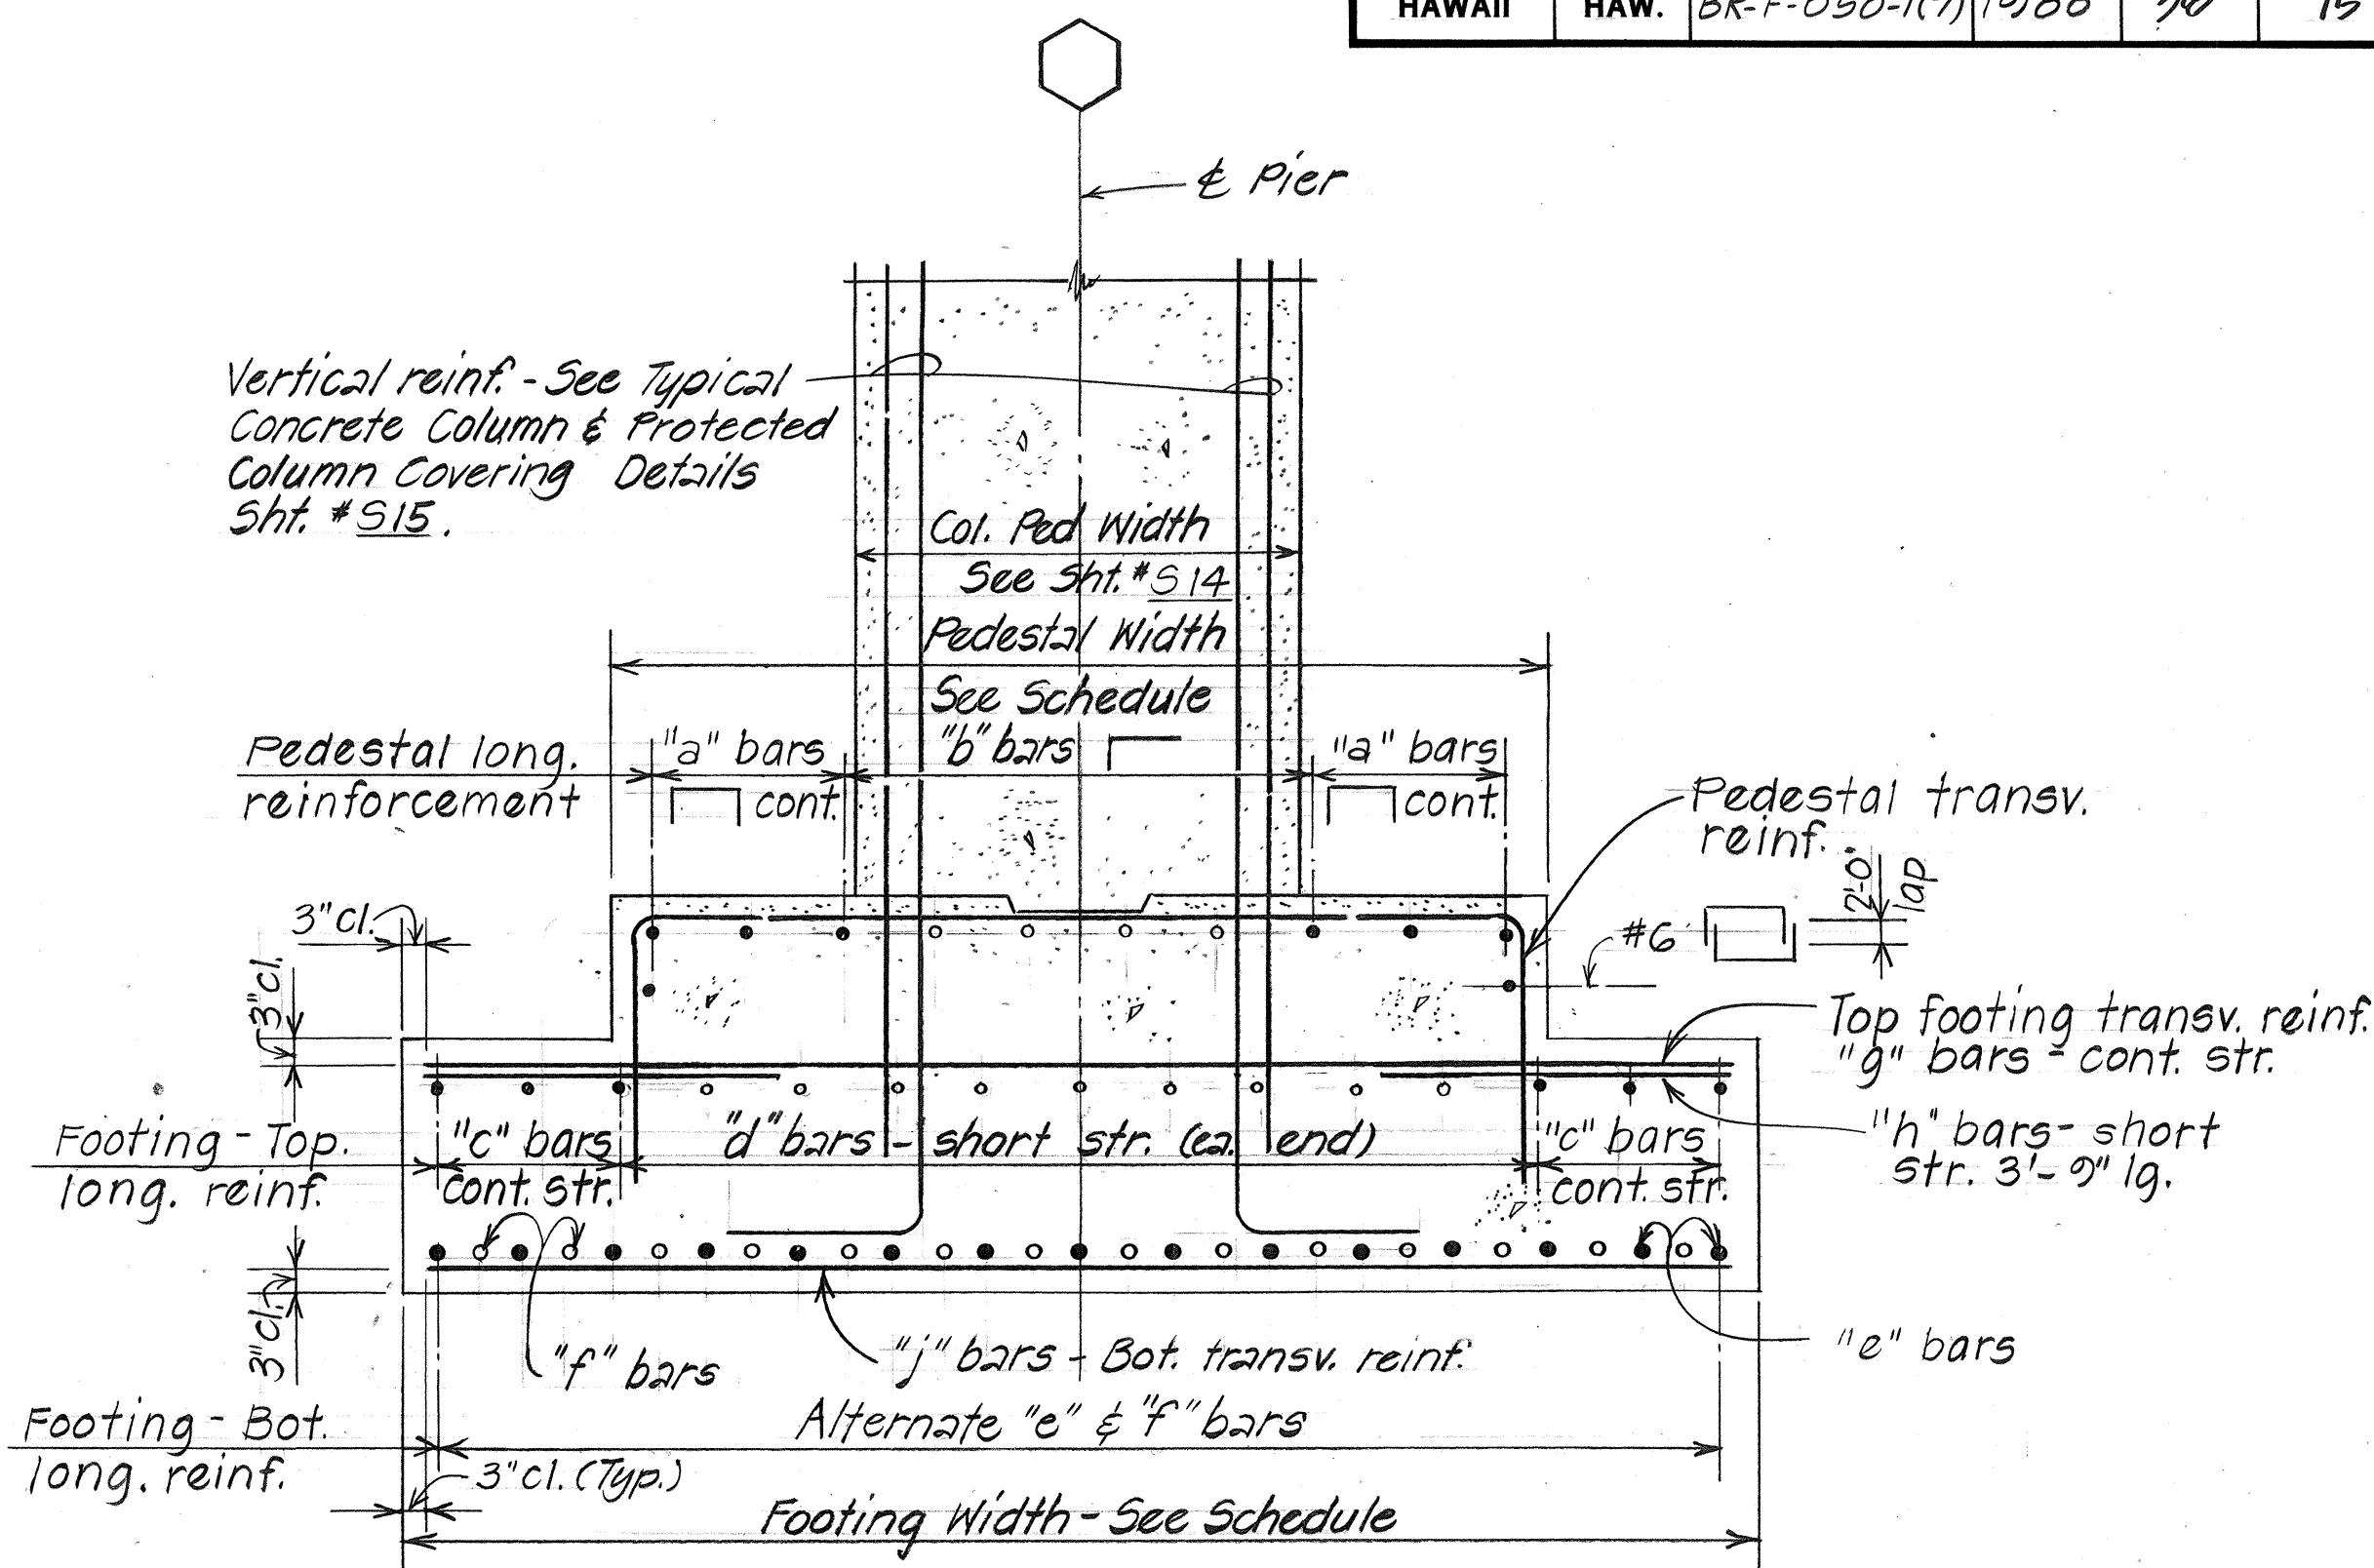

SECTION

REFERENCE NOTES

1. Refer to Sht. # S15 for pier column dimensions and reinf. details.
2. All footing reinf. shall be ASTM A615 Grade 60.
3. All footing and pedestal concrete shall be 5000 psi.

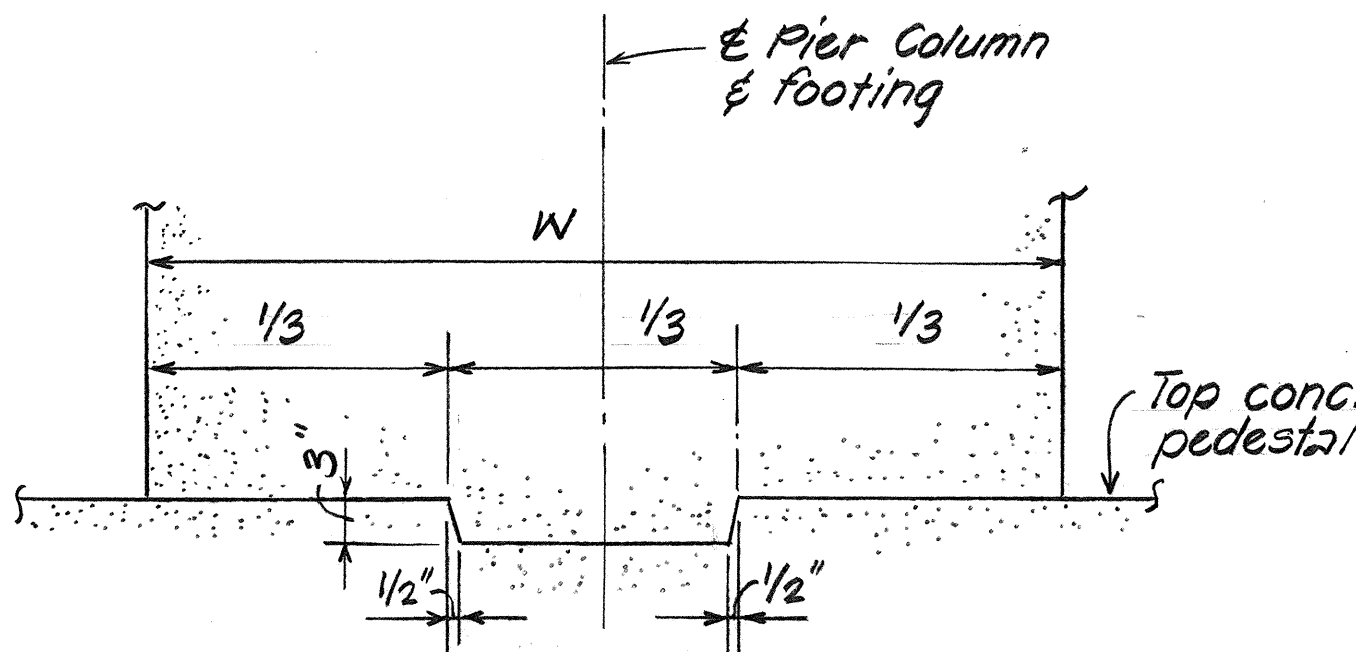

TYPICAL COLUMN BASE

KEY DETAIL

Not to Scale



PIER FOOTING - DIMENSION & REINFORCING SCHEDULE															
ITEM <															

SURVEY PLOTTED BY	DATE
DRAWN BY	1/87
TRACED BY	1/87
QUANTITIES BY	1/87
CHECKED BY	1/87
ORIGINAL PLAN	
NOTE BOOK	
NO.	

STATE OF HAWAII
DEPARTMENT OF TRANSPORTATION
HIGHWAYS DIVISION

HULEIA STREAM BRIDGE
PIER 1, 2 & 3 FOOTING DETAILS
& SCHEDULE
KAUMUALII HWY.
PROJ. NO. BR-F-050-1(7)
Scale: As Noted Date: Aug. 1987
SHEET NO. S14 OF 22 SHEETS

ORIGINAL PLAN	SURVEY PLOTTED BY	DATE
	DRAWN BY <u>T. K. M.</u>	" <u>1/87</u>
	TRACED BY _____	" <u>1/87</u>
NOTE BOOK	DESIGNED BY <u>S. A.</u>	" <u>1/87</u>
	QUANTITIES BY <u>T. K. M.</u>	" <u>1/87</u>
No. _____	CHECKED BY <u>D. C. O. & G. T.</u>	" <u>1/87</u>

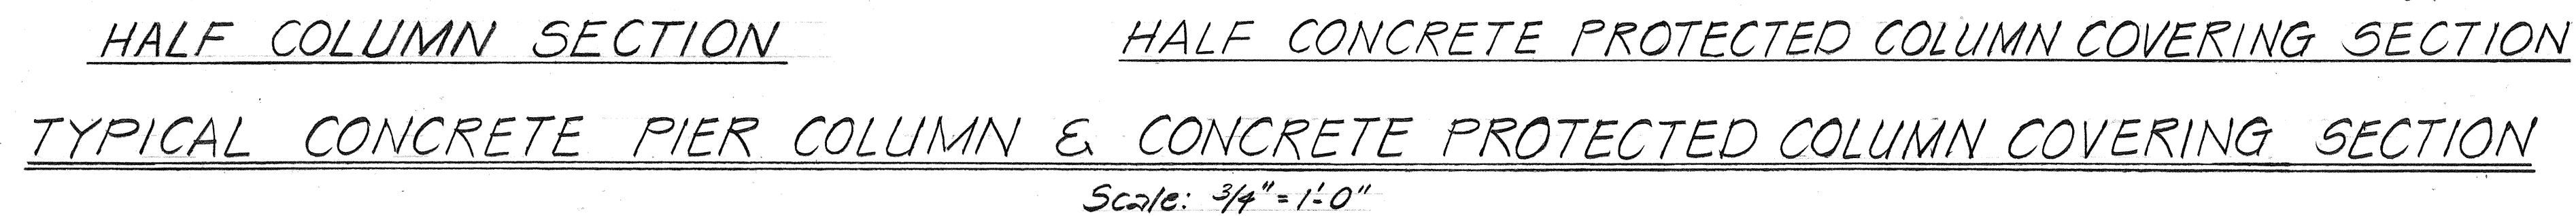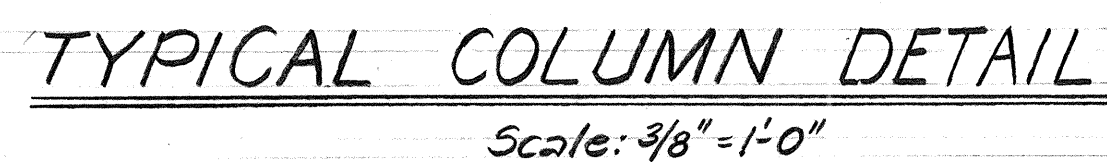

- NOTE:
1. Refer to sht. #SIG for pier cap dimensions & reinf. details.
 2. All vertical column reinf. to be ASTM A615 Grade 60.

STATE OF HAWAII
DEPARTMENT OF TRANSPORTATION
HIGHWAYS DIVISION

HULEIA STREAM BRIDGE

PIER COLUMN DETAILS


KAUMUALII HWY.
PROJ. NO. BR-F-050-1(7)

Scale: As Noted Date: Aug. 1978


SHEET No. 515 OF 22 SHEETS

FED. ROAD DIST. NO.	STATE	FED. AID PROJ. NO.	FISCAL YEAR	SHEET NO.	TOTAL SHEETS
HAWAII	HAW.	BR-F-050-1(7)	1988	40	15

TOP PIER CAP & TOP COLUMN ELEVATION SCHEDULE (AT & PIER)				
PIER	EL. (A)	EL. (B)	EL. (C)	EL. (D)
①	362.88	362.57	352.79	352.66
②	362.83	362.91	352.85	352.89
③	363.89	364.35	354.03	354.21

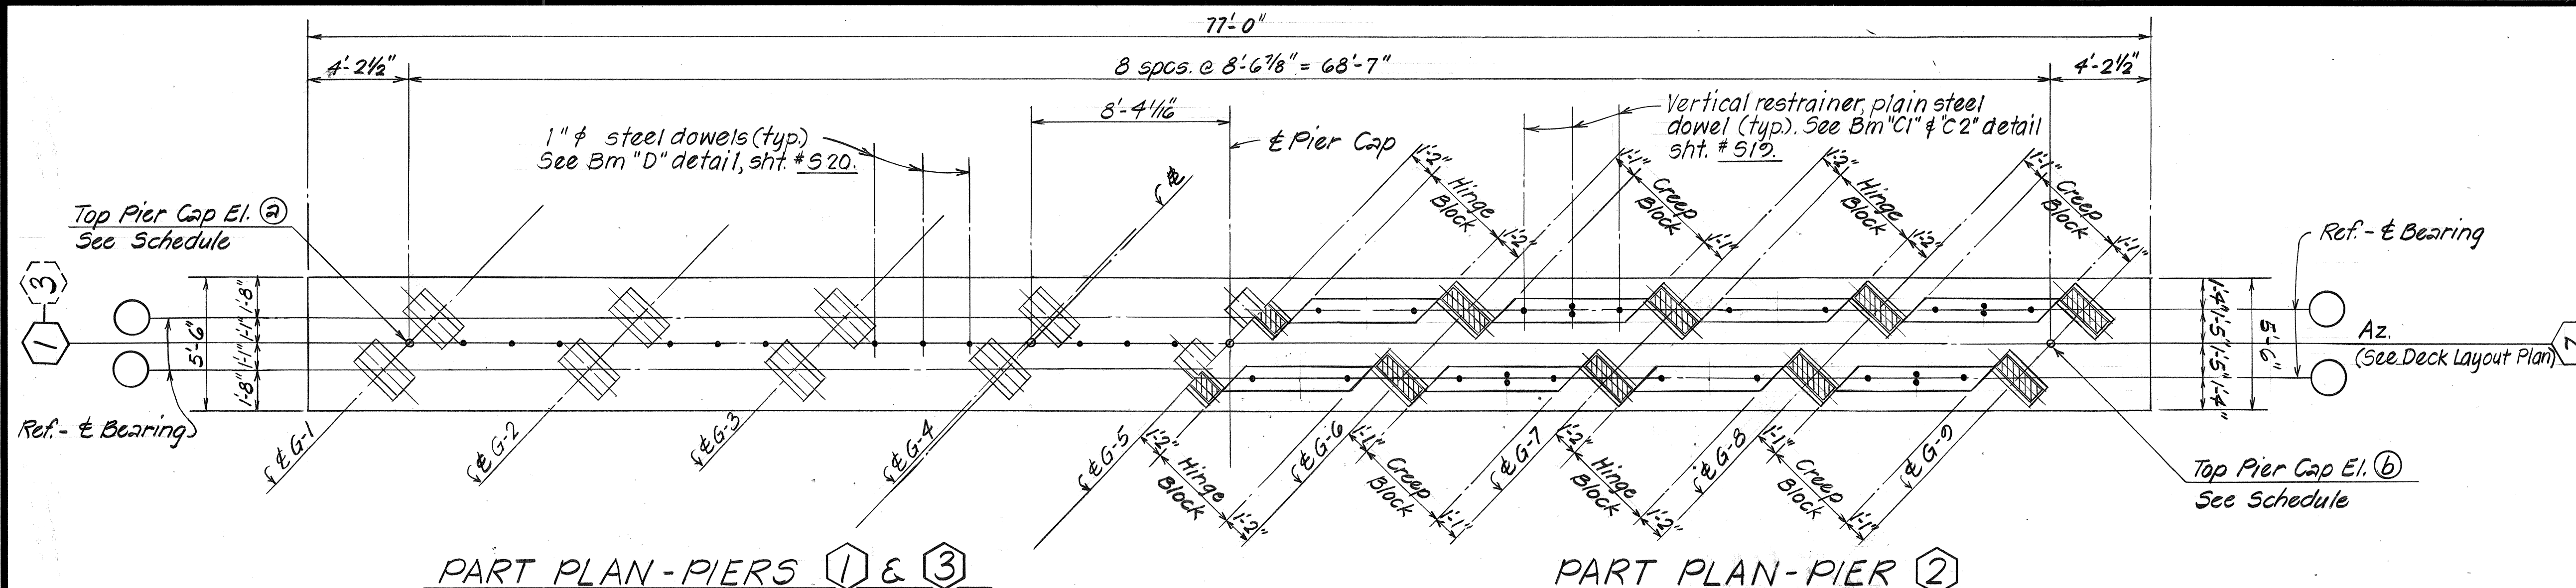


TYPICAL PIER CAP PLAN
Scale: 1/4"=1'-0"

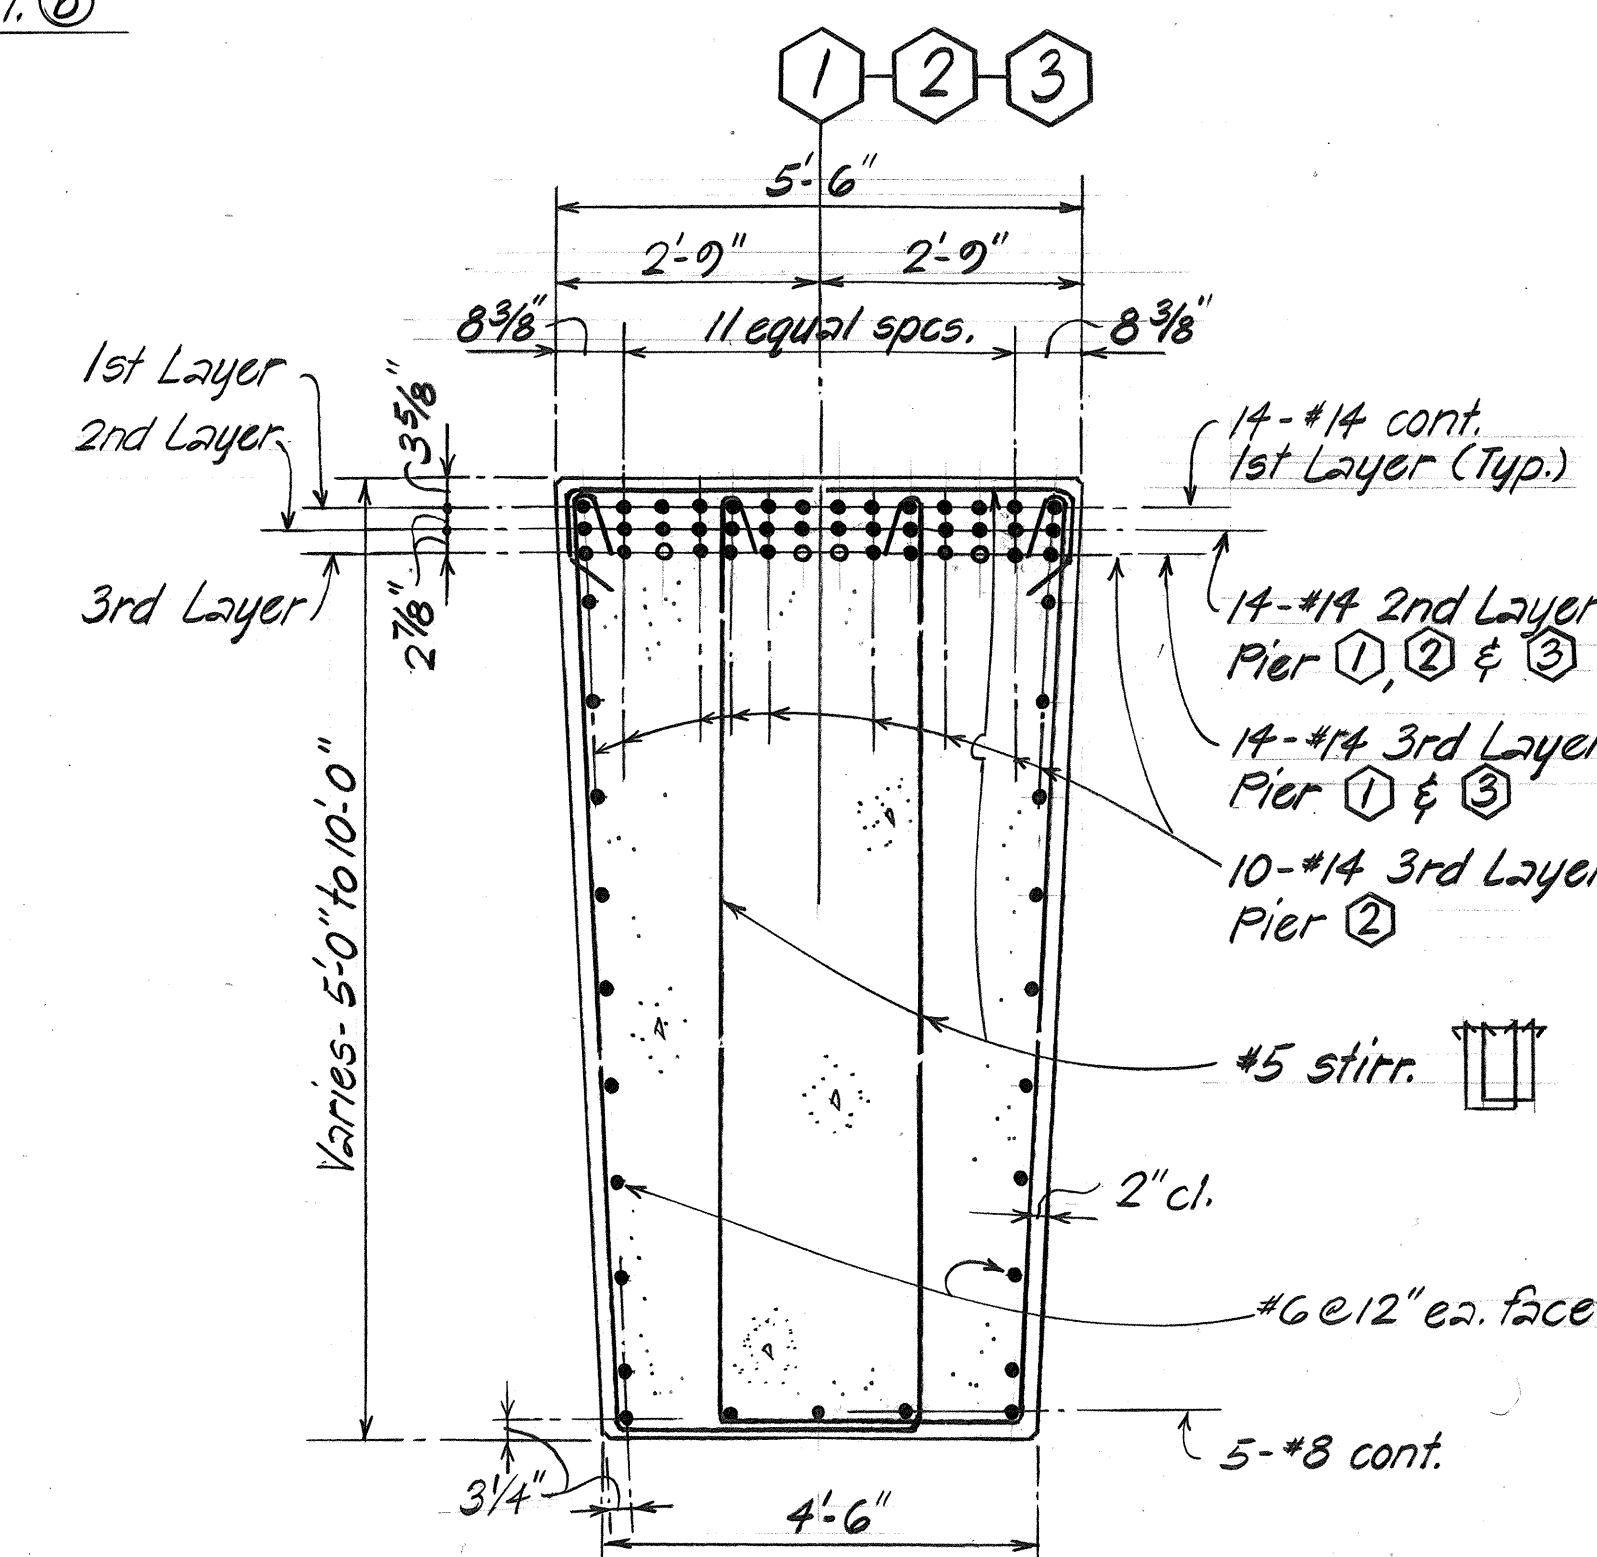

NOTE:
All #14 bars in pier cap to be
ASTM A615 Grade 60.


TYPICAL SECTION
Scale: 1/2"=1'-0"

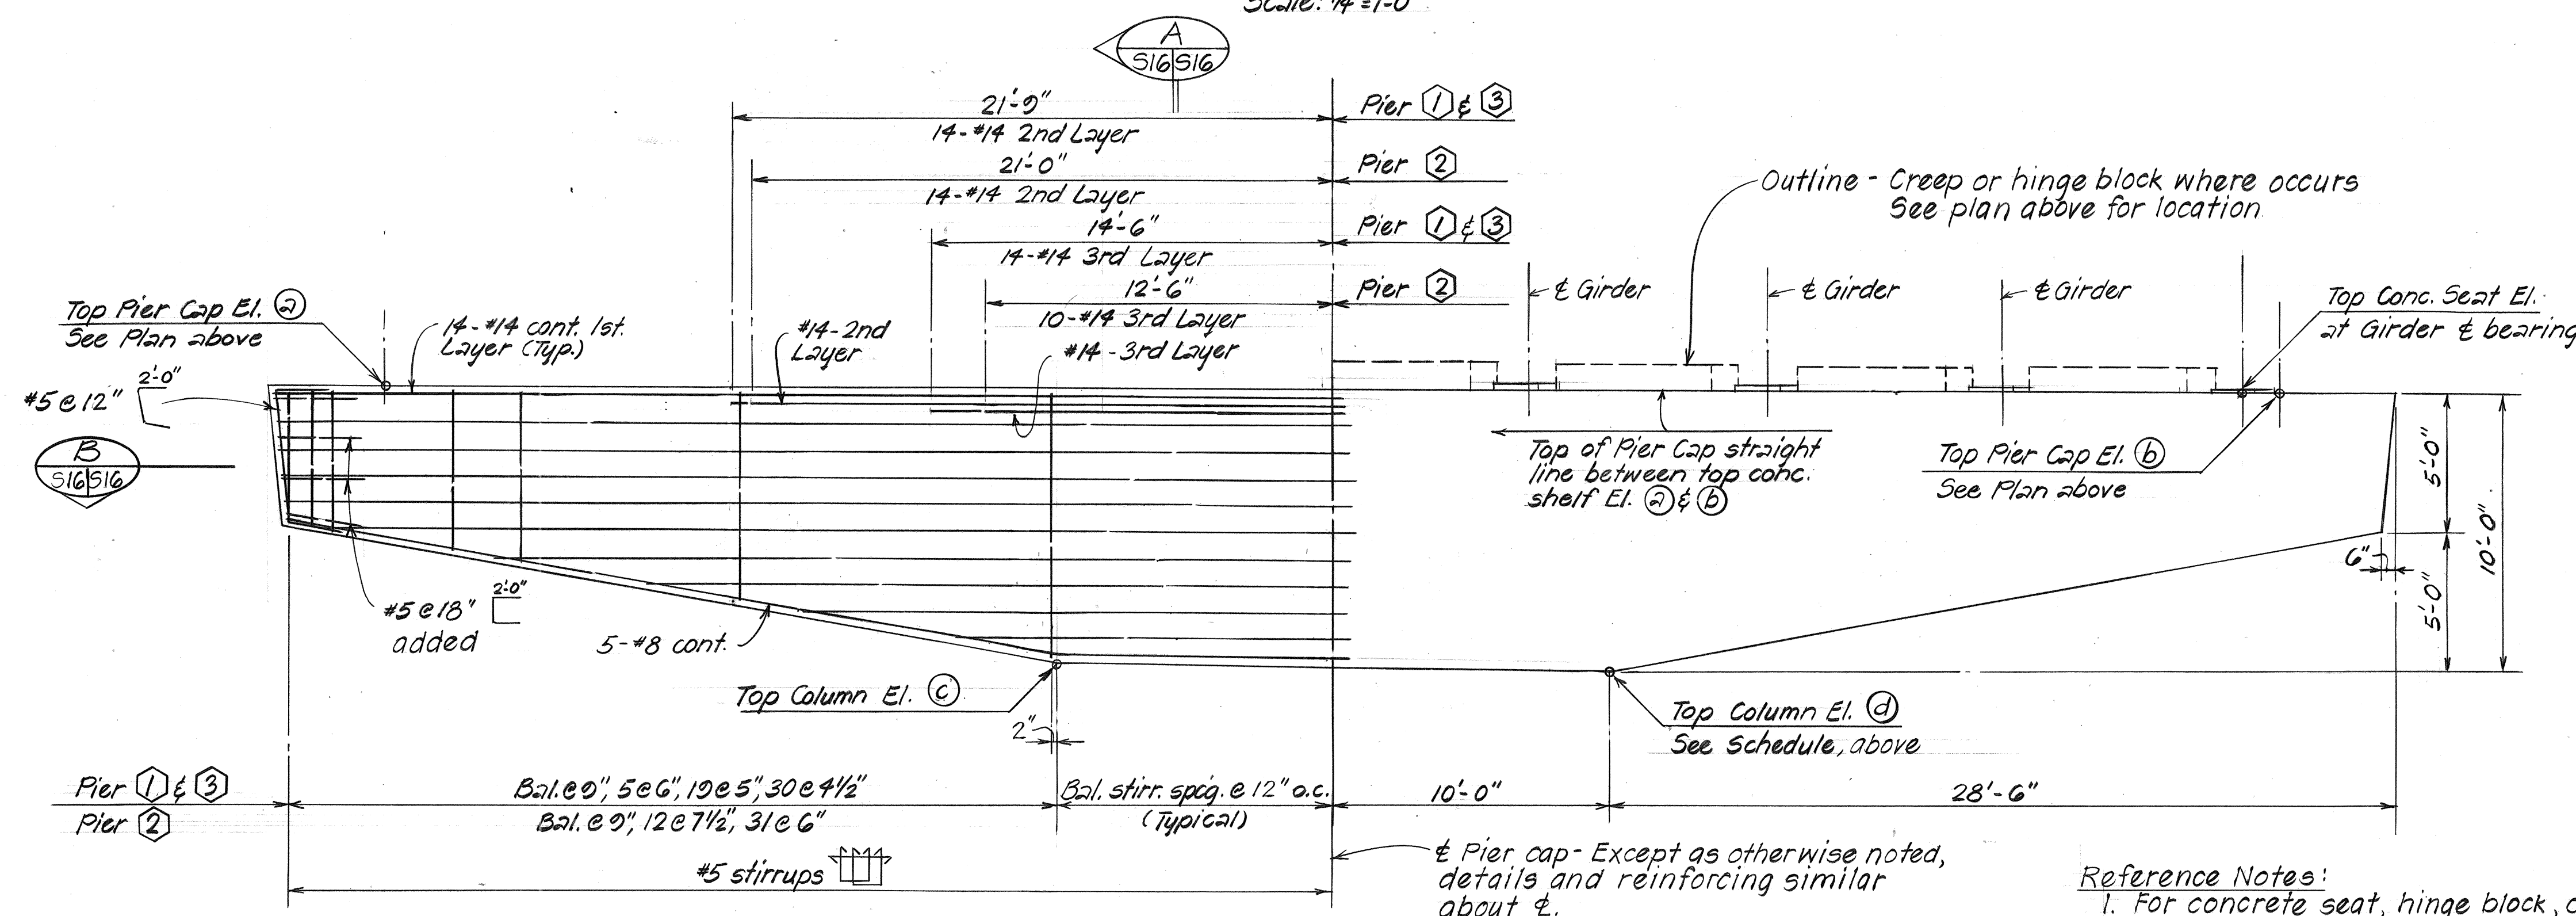

PIER REINFORCEMENT

PIER DIMENSION

TYPICAL PIER CAP ELEVATION
Scale: 1/4"=1'-0"

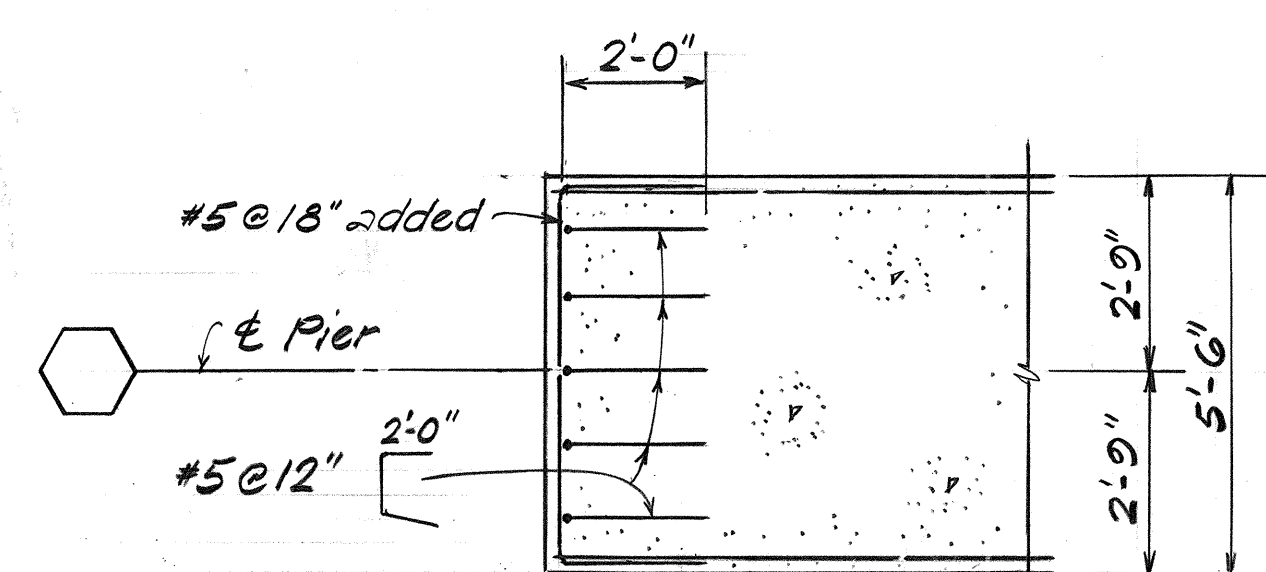

TYPICAL SECTION
Scale: 3/8"=1'-0"

- Reference Notes:
- For concrete seat, hinge block, creep block & elastomeric bearing pad details, see sht. #Q3.
 - For top concrete seat elev. & girder & bearing and elastomeric bearing pad size, see sht. #Q2.
 - For vertical restrainer & plain steel dowels, see Beam "C1", "C2" & "D" sht. #S19, #S20, #Q3.

STATE OF HAWAII
DEPARTMENT OF TRANSPORTATION
HIGHWAYS DIVISION

HULEIA STREAM BRIDGE

PIER CAP DETAILS

KAUMUALII HWY.
PROJ. NO. BR-F-050-1(7)



Scale: As Noted. Date: Aug. 1987

SHEET NO. 516 OF 22 SHEETS

FED. ROAD DIST. NO.	STATE	FED. AID PROJ. NO.	FISCAL YEAR	SHEET NO.	TOTAL SHEETS
HAWAII	HAW.	BR-F-050-1(7)	1988	41	75

NOTE:

1. TSS- Denotes extent of Top Slab Strip (TSS-) between girders each bay. Refer to Typ. Deck Slab Sections & corresponding Bar Placement Diagram for size and numbers on sht. #518.
2. Locate Beam "B" as indicated on Plan.
3. Girder dimension L = horizontal measurement between girder & bearing at each end of the girder. The Contractor shall determine total length of girder.

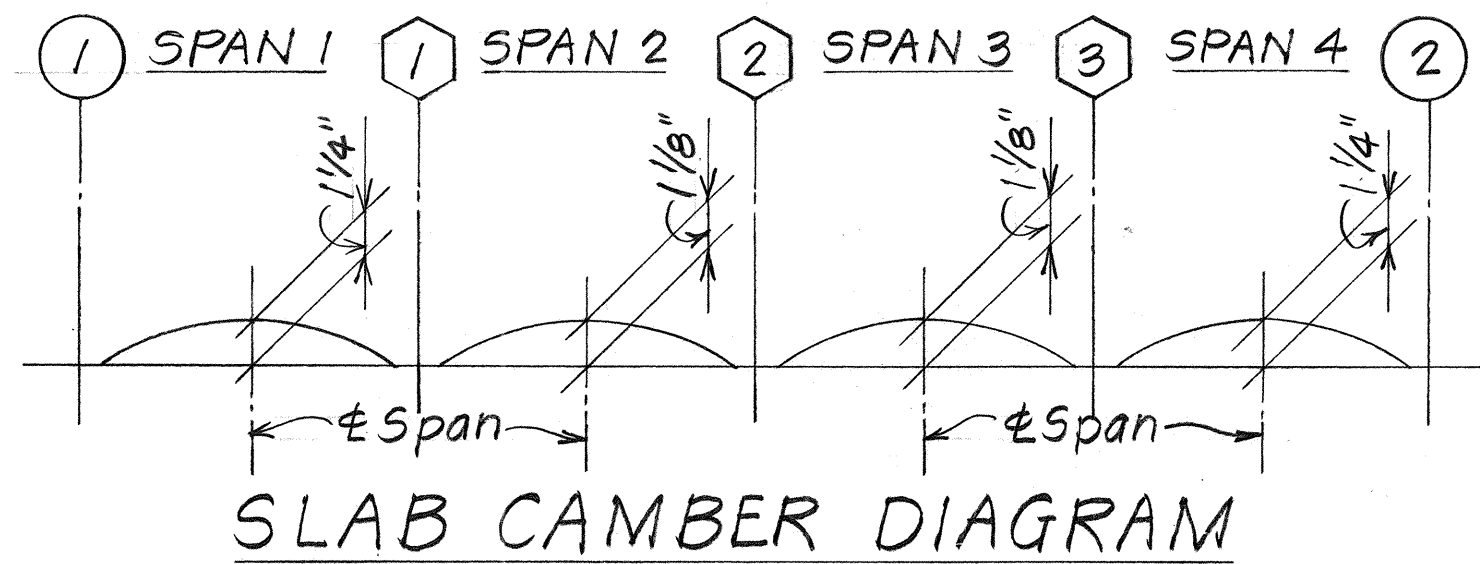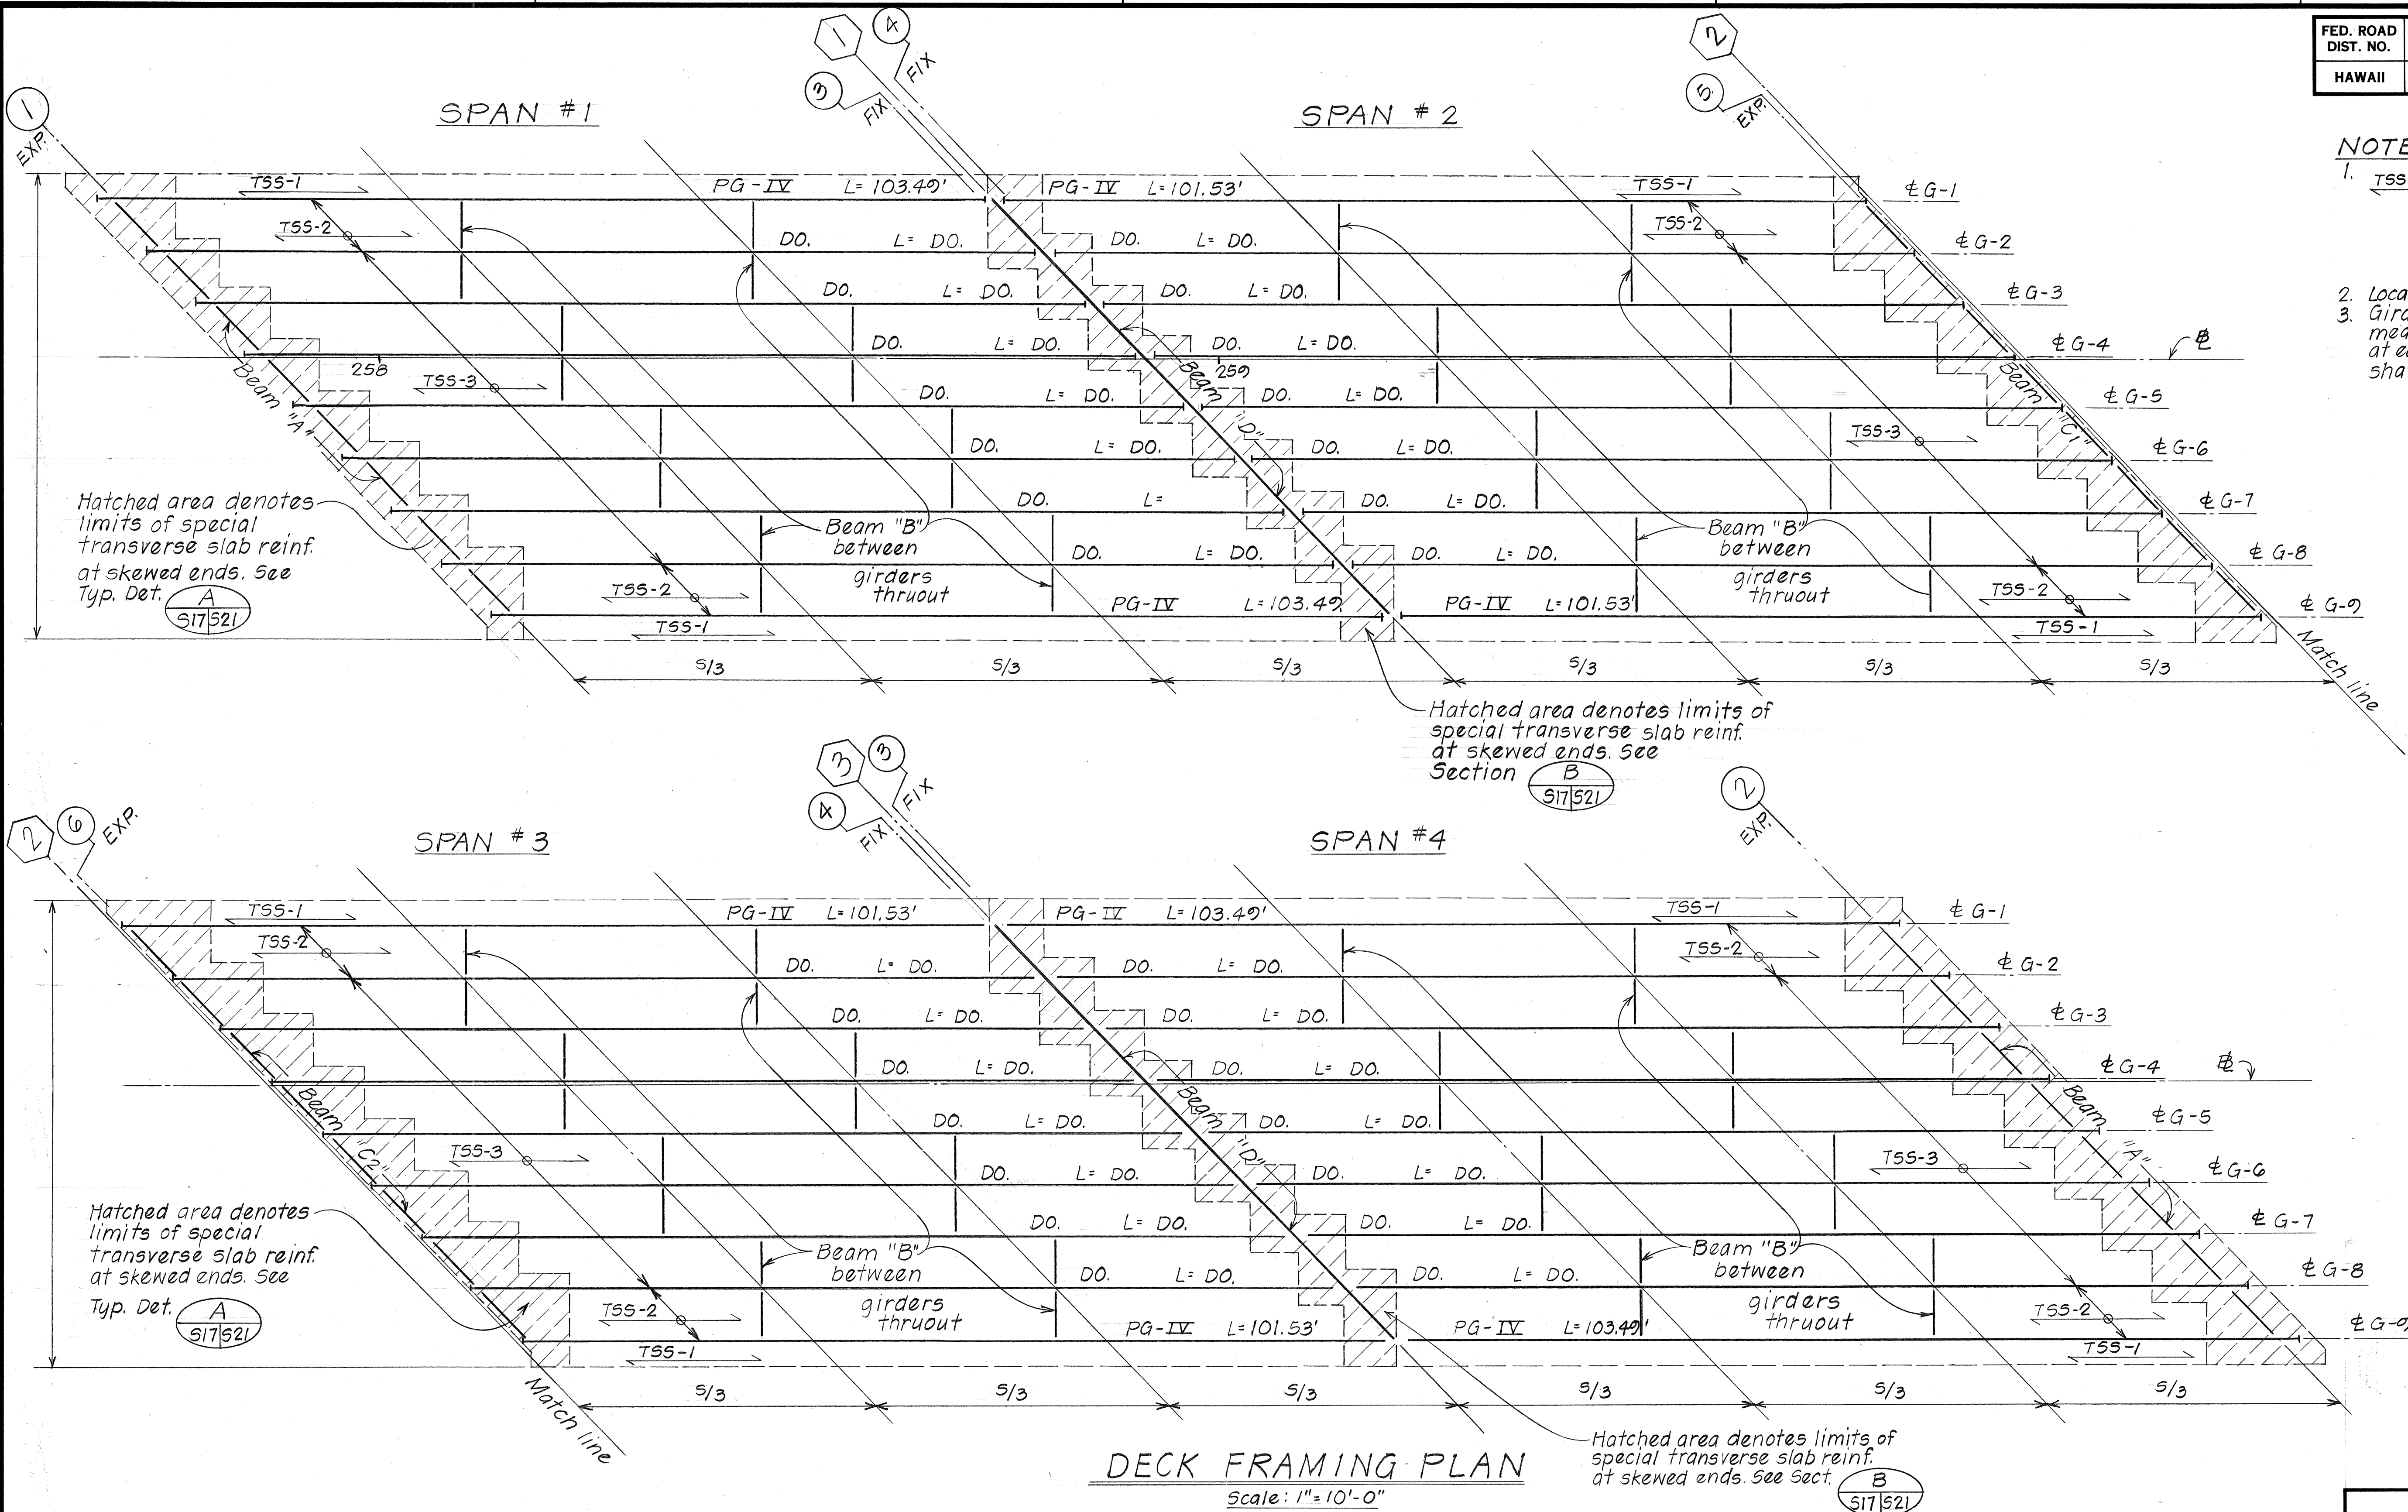

STATE OF HAWAII
DEPARTMENT OF TRANSPORTATION
HIGHWAYS DIVISION

HULEIA STREAM BRIDGE

DECK FRAMING PLAN
SLAB CAMBER DIAGRAM
KAUMUALII HWY.
PROJ. NO. BR-F-050-1(7)

Scale: As Noted Date: Aug. 1987

SHEET No. 517 OF 22 SHEETS

SURVEY PLOTTED BY	DATE
DRAWN BY	1/87
CHECKED BY	1/87
QUANTITIES BY	1/87
NOTED BY	1/87
NO.	




STATE OF HAWAII
DEPARTMENT OF TRANSPORTATION
HIGHWAYS DIVISION

HULEIA STREAM BRIDGE
NORMAL DECK SECTION
DECK REINF. DIAGRAM - TSS1 THRU TSS3
KAUMUALII HWY.
PROJ. NO. BR-F-050-1(7)

Scale: As Noted Date: Aug. 1987

SHEET No. 518 OF 22 SHEETS

FED. ROAD DIST. NO.	STATE	FED. AID PROJ. NO.	FISCAL YEAR	SHEET NO.	TOTAL SHEETS
HAWAII	HAW.	BR-F-050-1(7)	1988	43	15

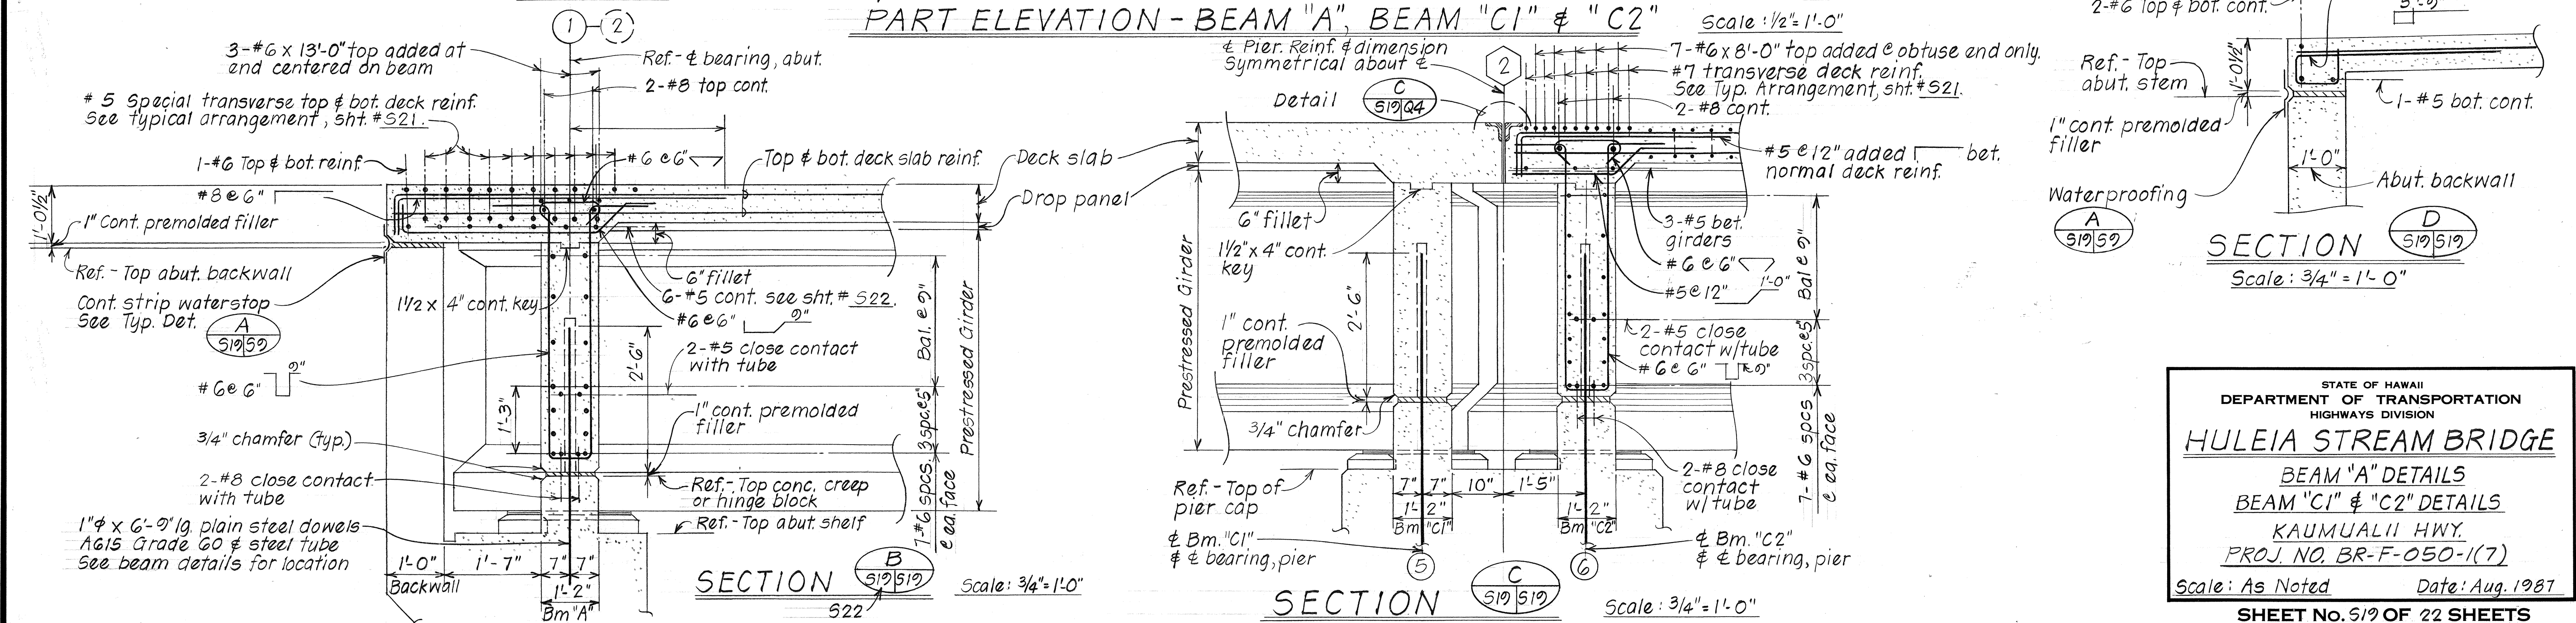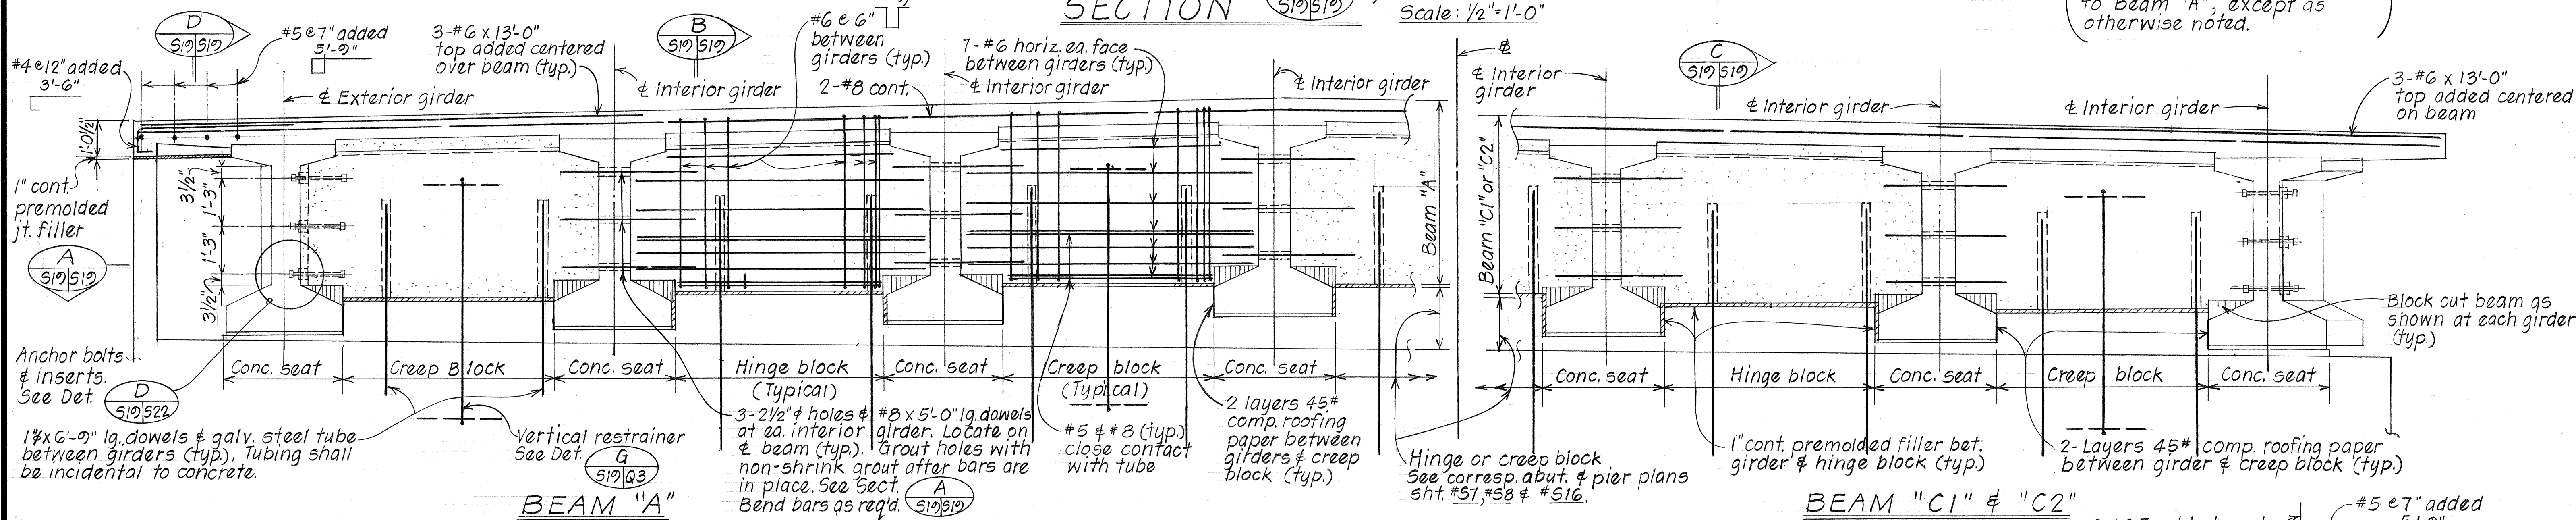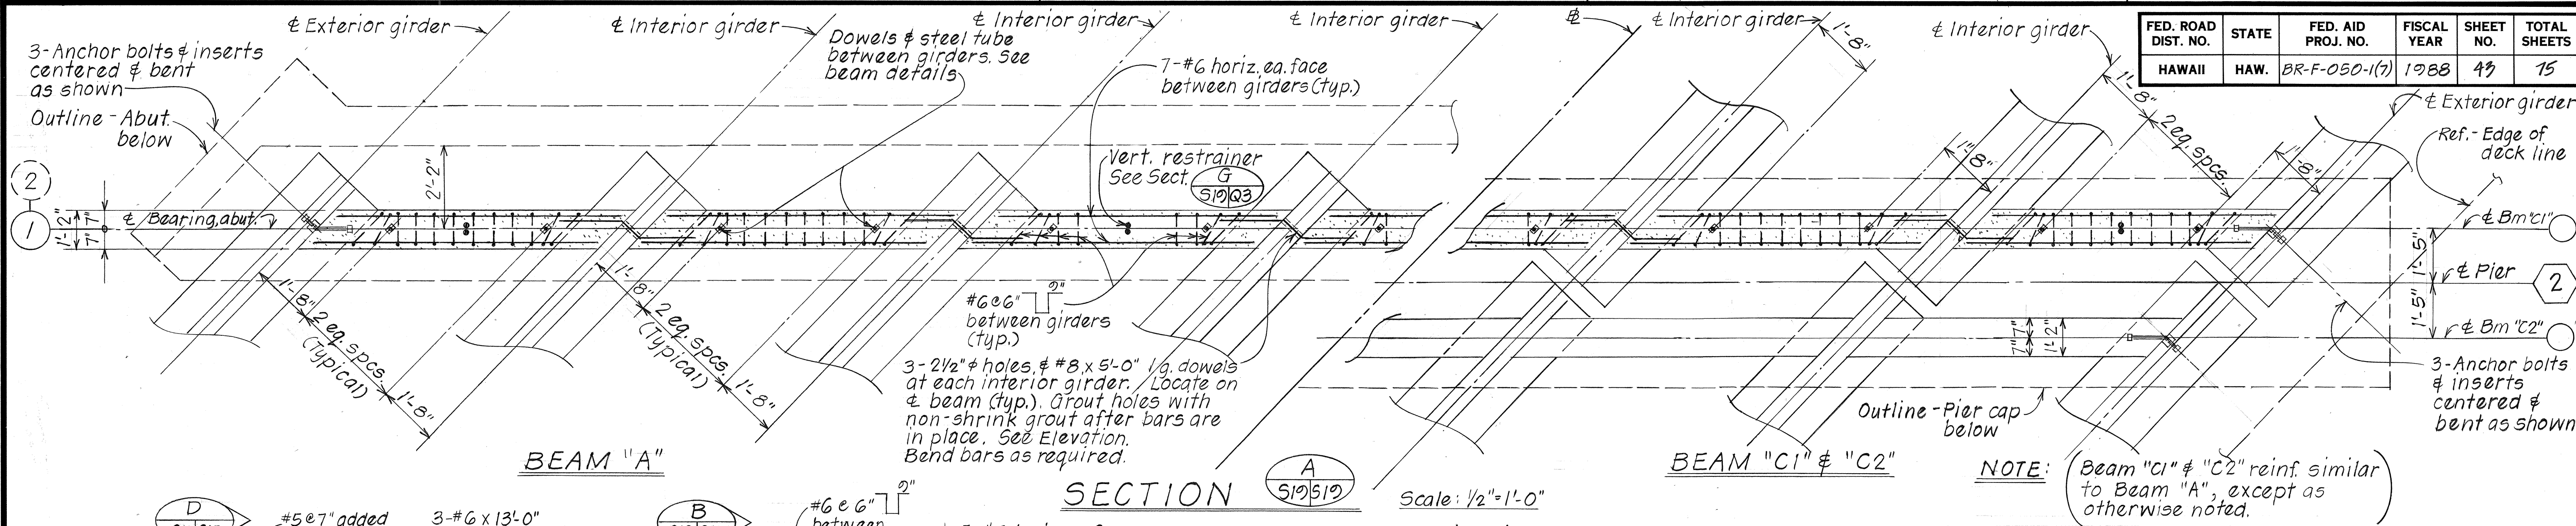

SURVEY PLOTTED BY	DATE
DRAWN BY	1/82
TRACED BY	1/82
QUANTITIES BY	1/82
CHECKED BY	1/82
ORIGINAL PLAN	
NOTE BOOK	
NO.	

STATE OF HAWAII
DEPARTMENT OF TRANSPORTATION
HIGHWAYS DIVISION






HULEIA STREAM BRIDGE

BEAM "A" DETAILS
BEAM "C1" & "C2" DETAILS
KAUMUALII HWY.
PROJ. NO. BR-F-050-1(7)

Scale: As Noted Date: Aug. 1987

SHEET NO. 519 OF 22 SHEETS

FED. ROAD DIST. NO.	STATE	FED. AID PROJ. NO.	FISCAL YEAR	SHEET NO.	TOTAL SHEETS
HAWAII	HAW.	BR-F-050-1(7)	1988	44	75

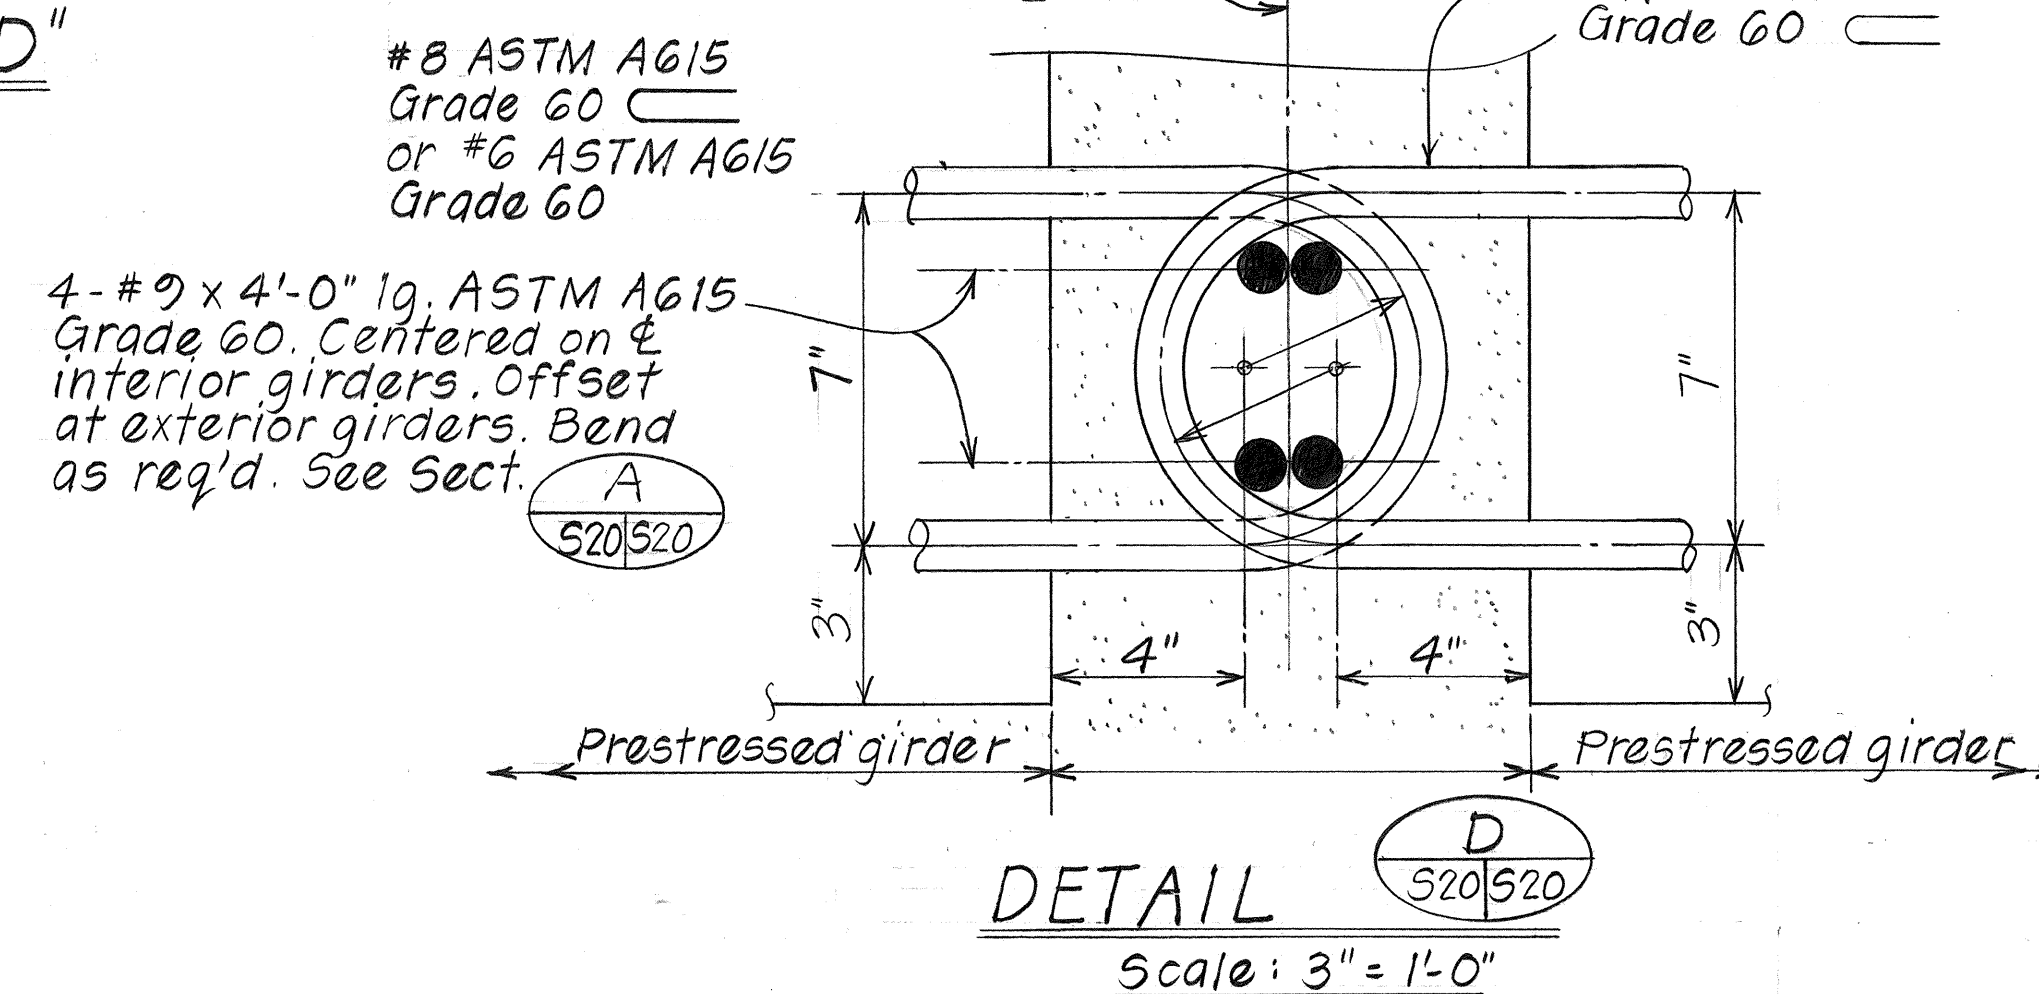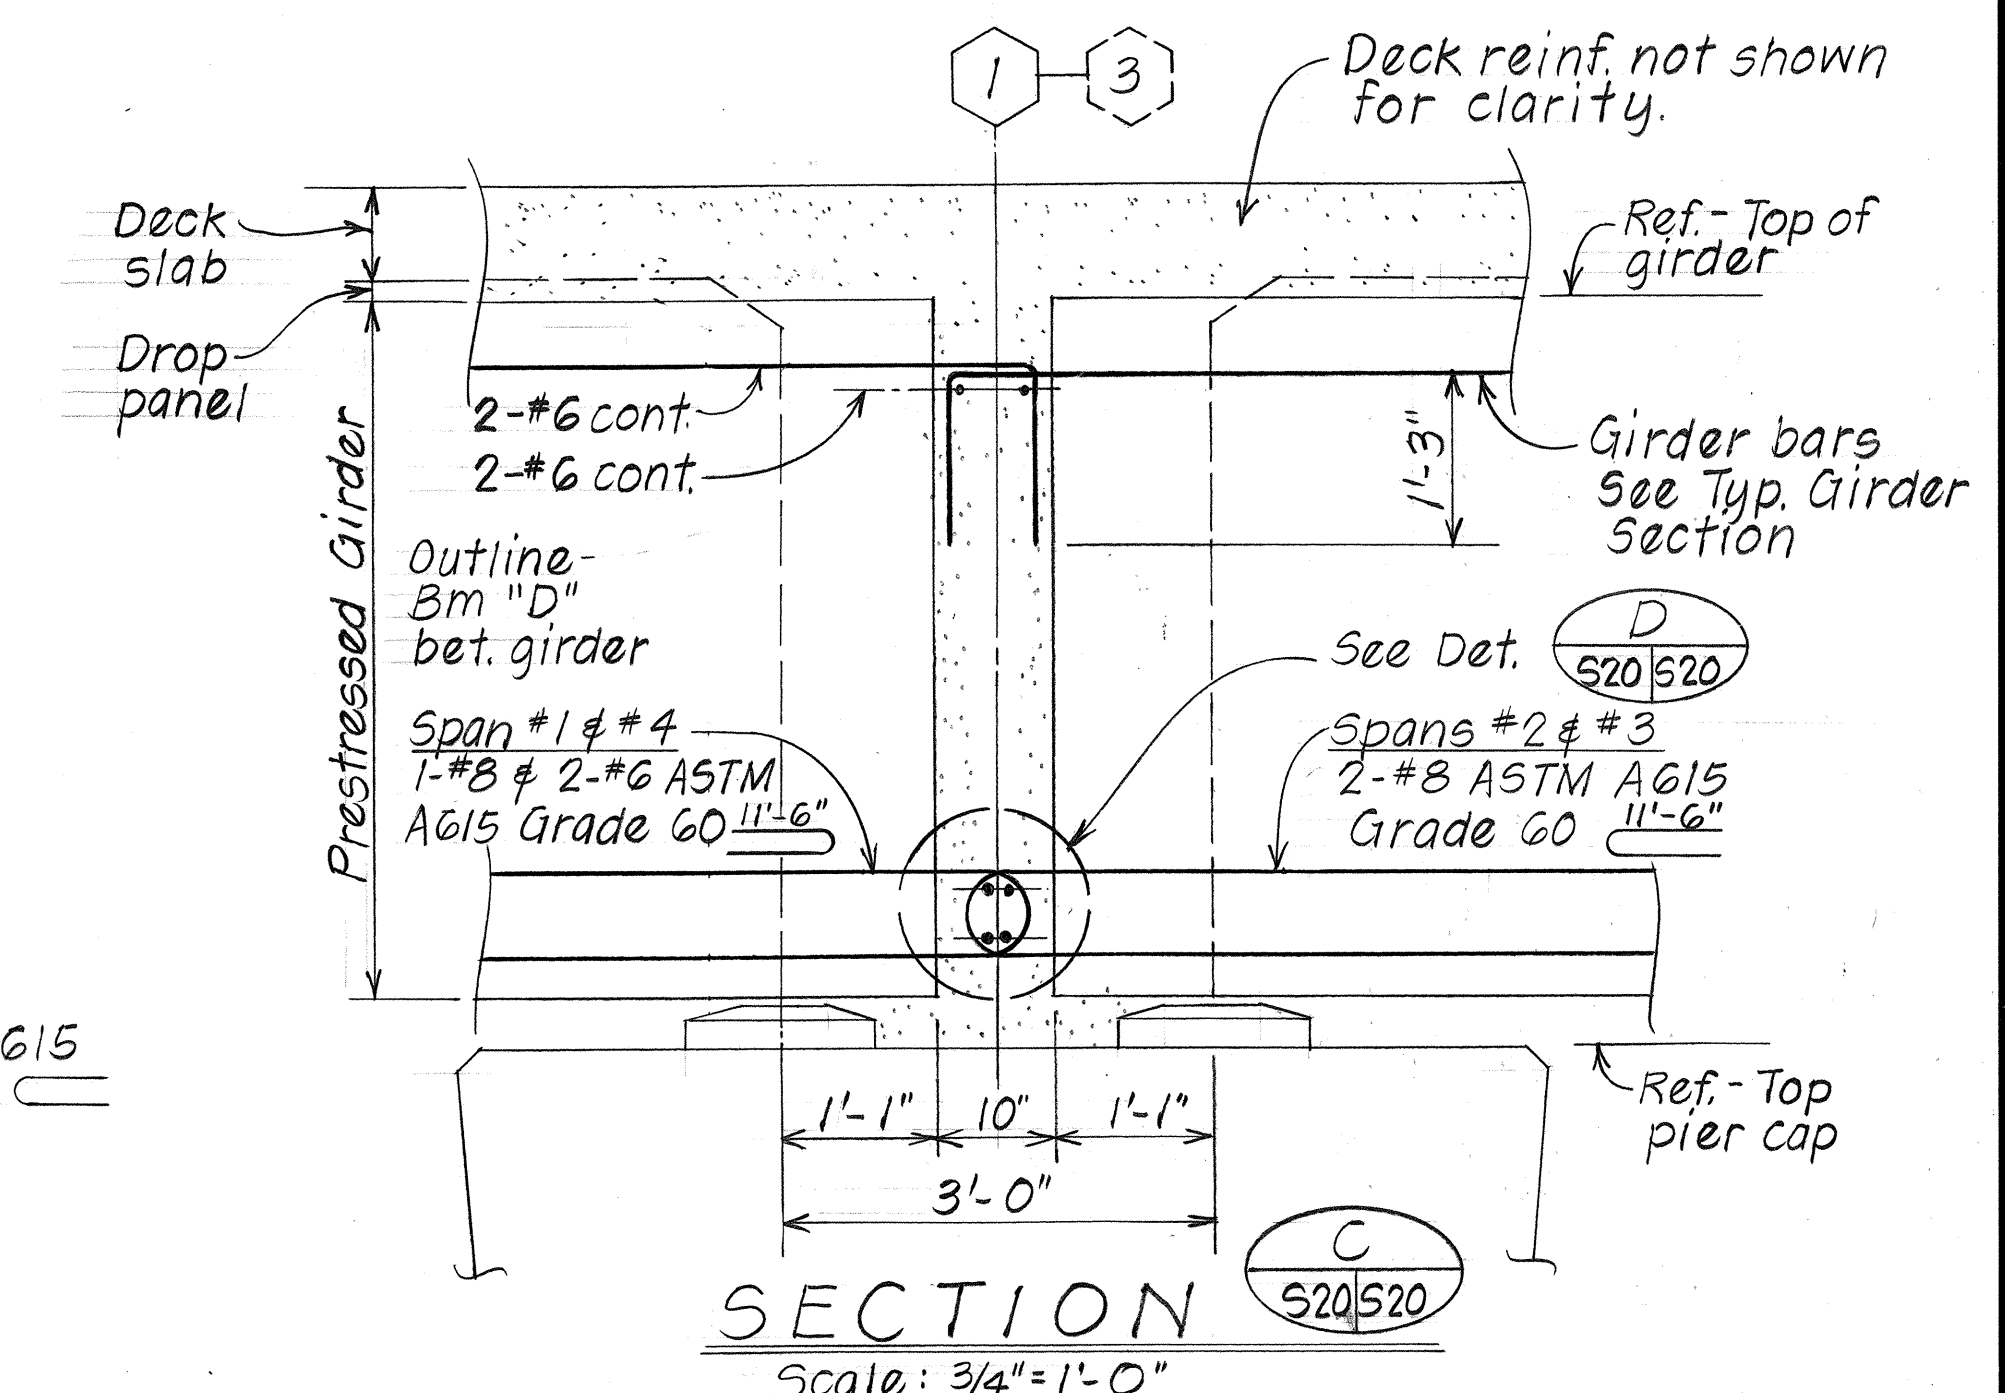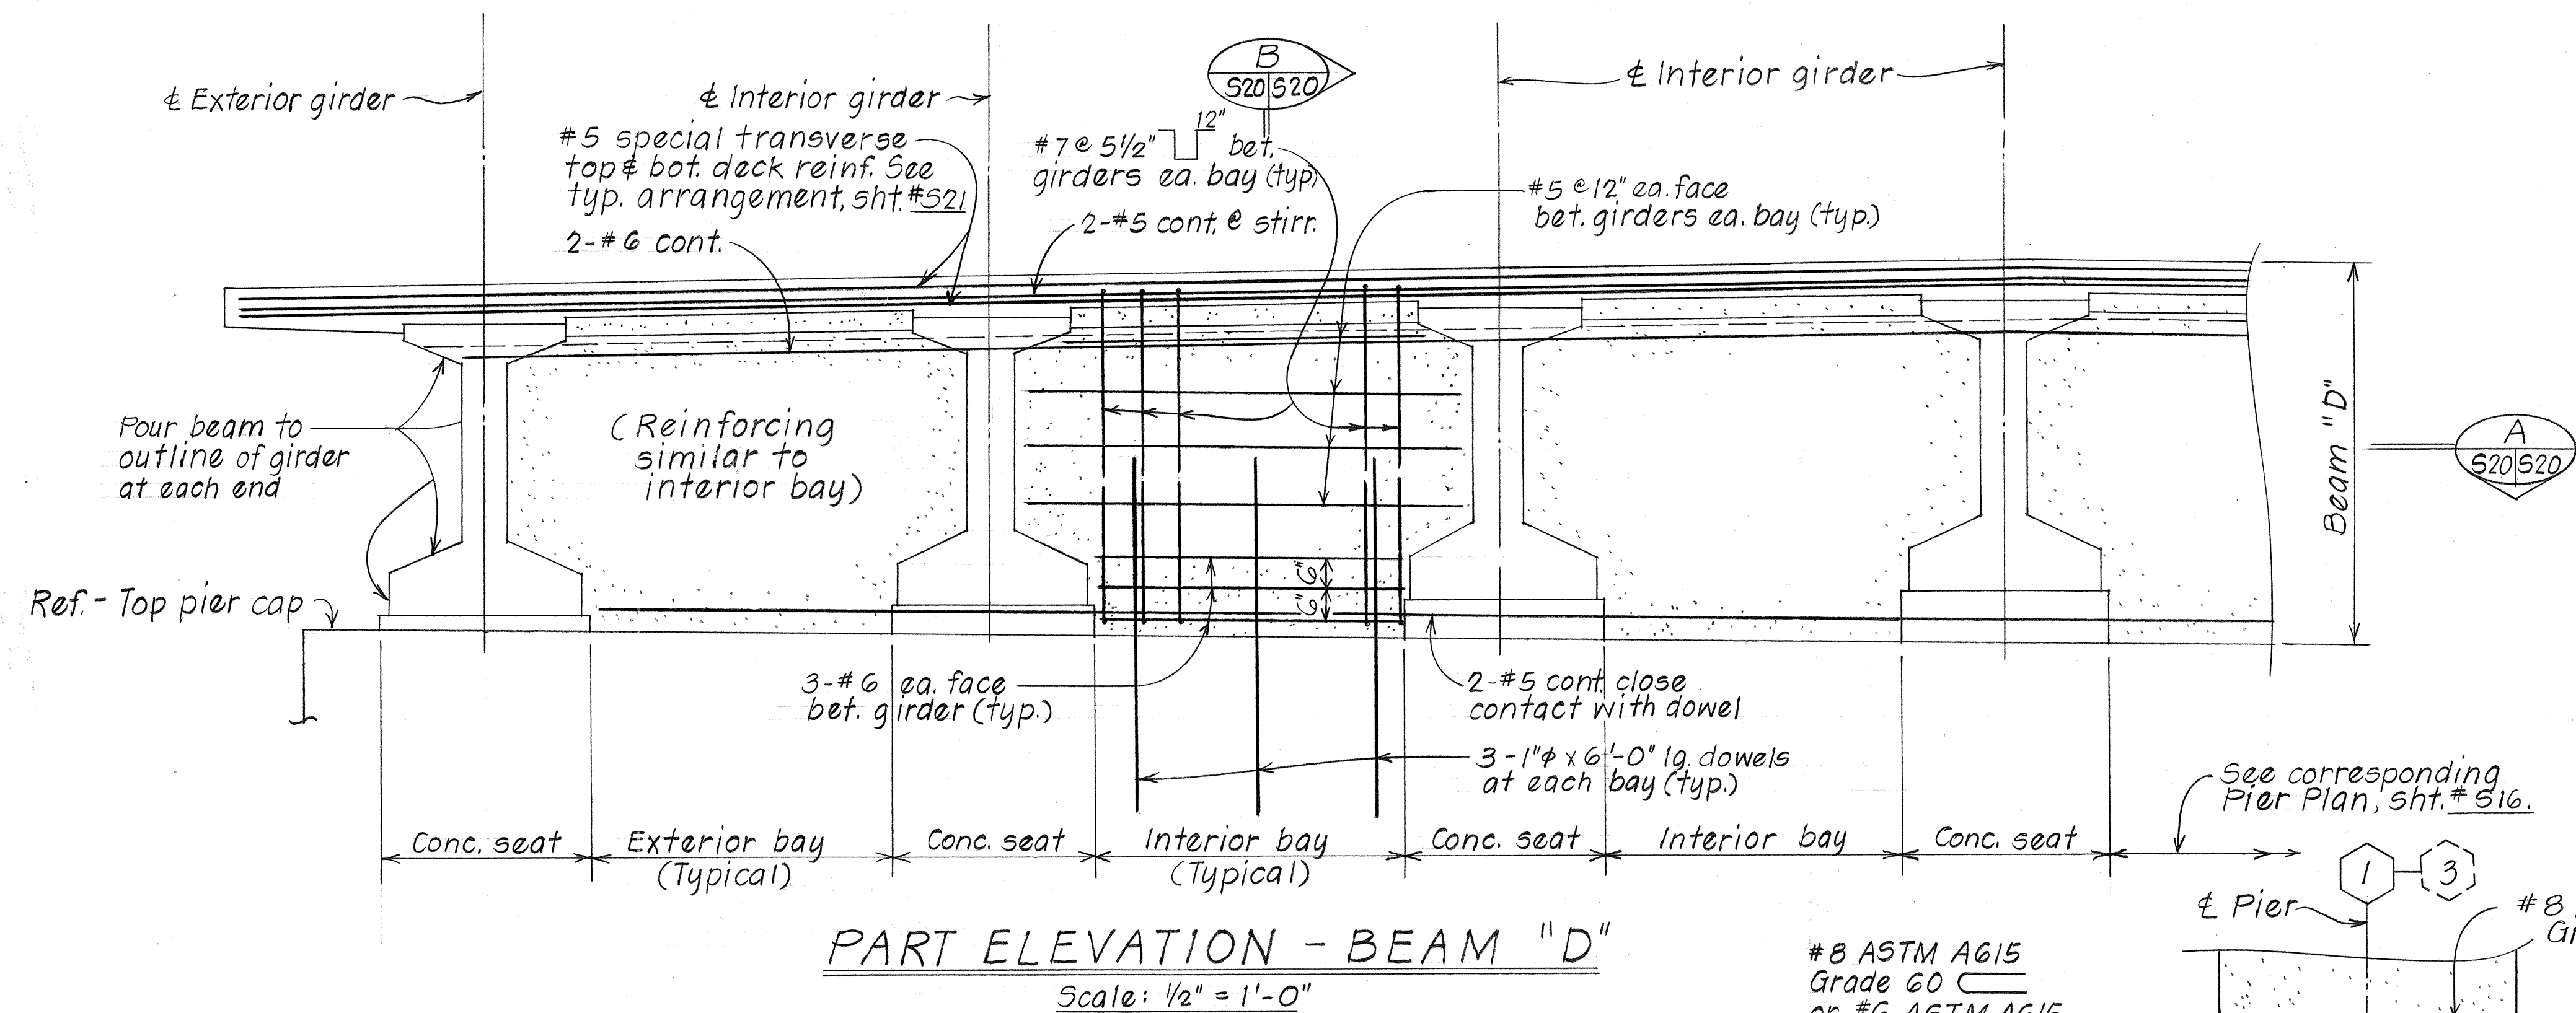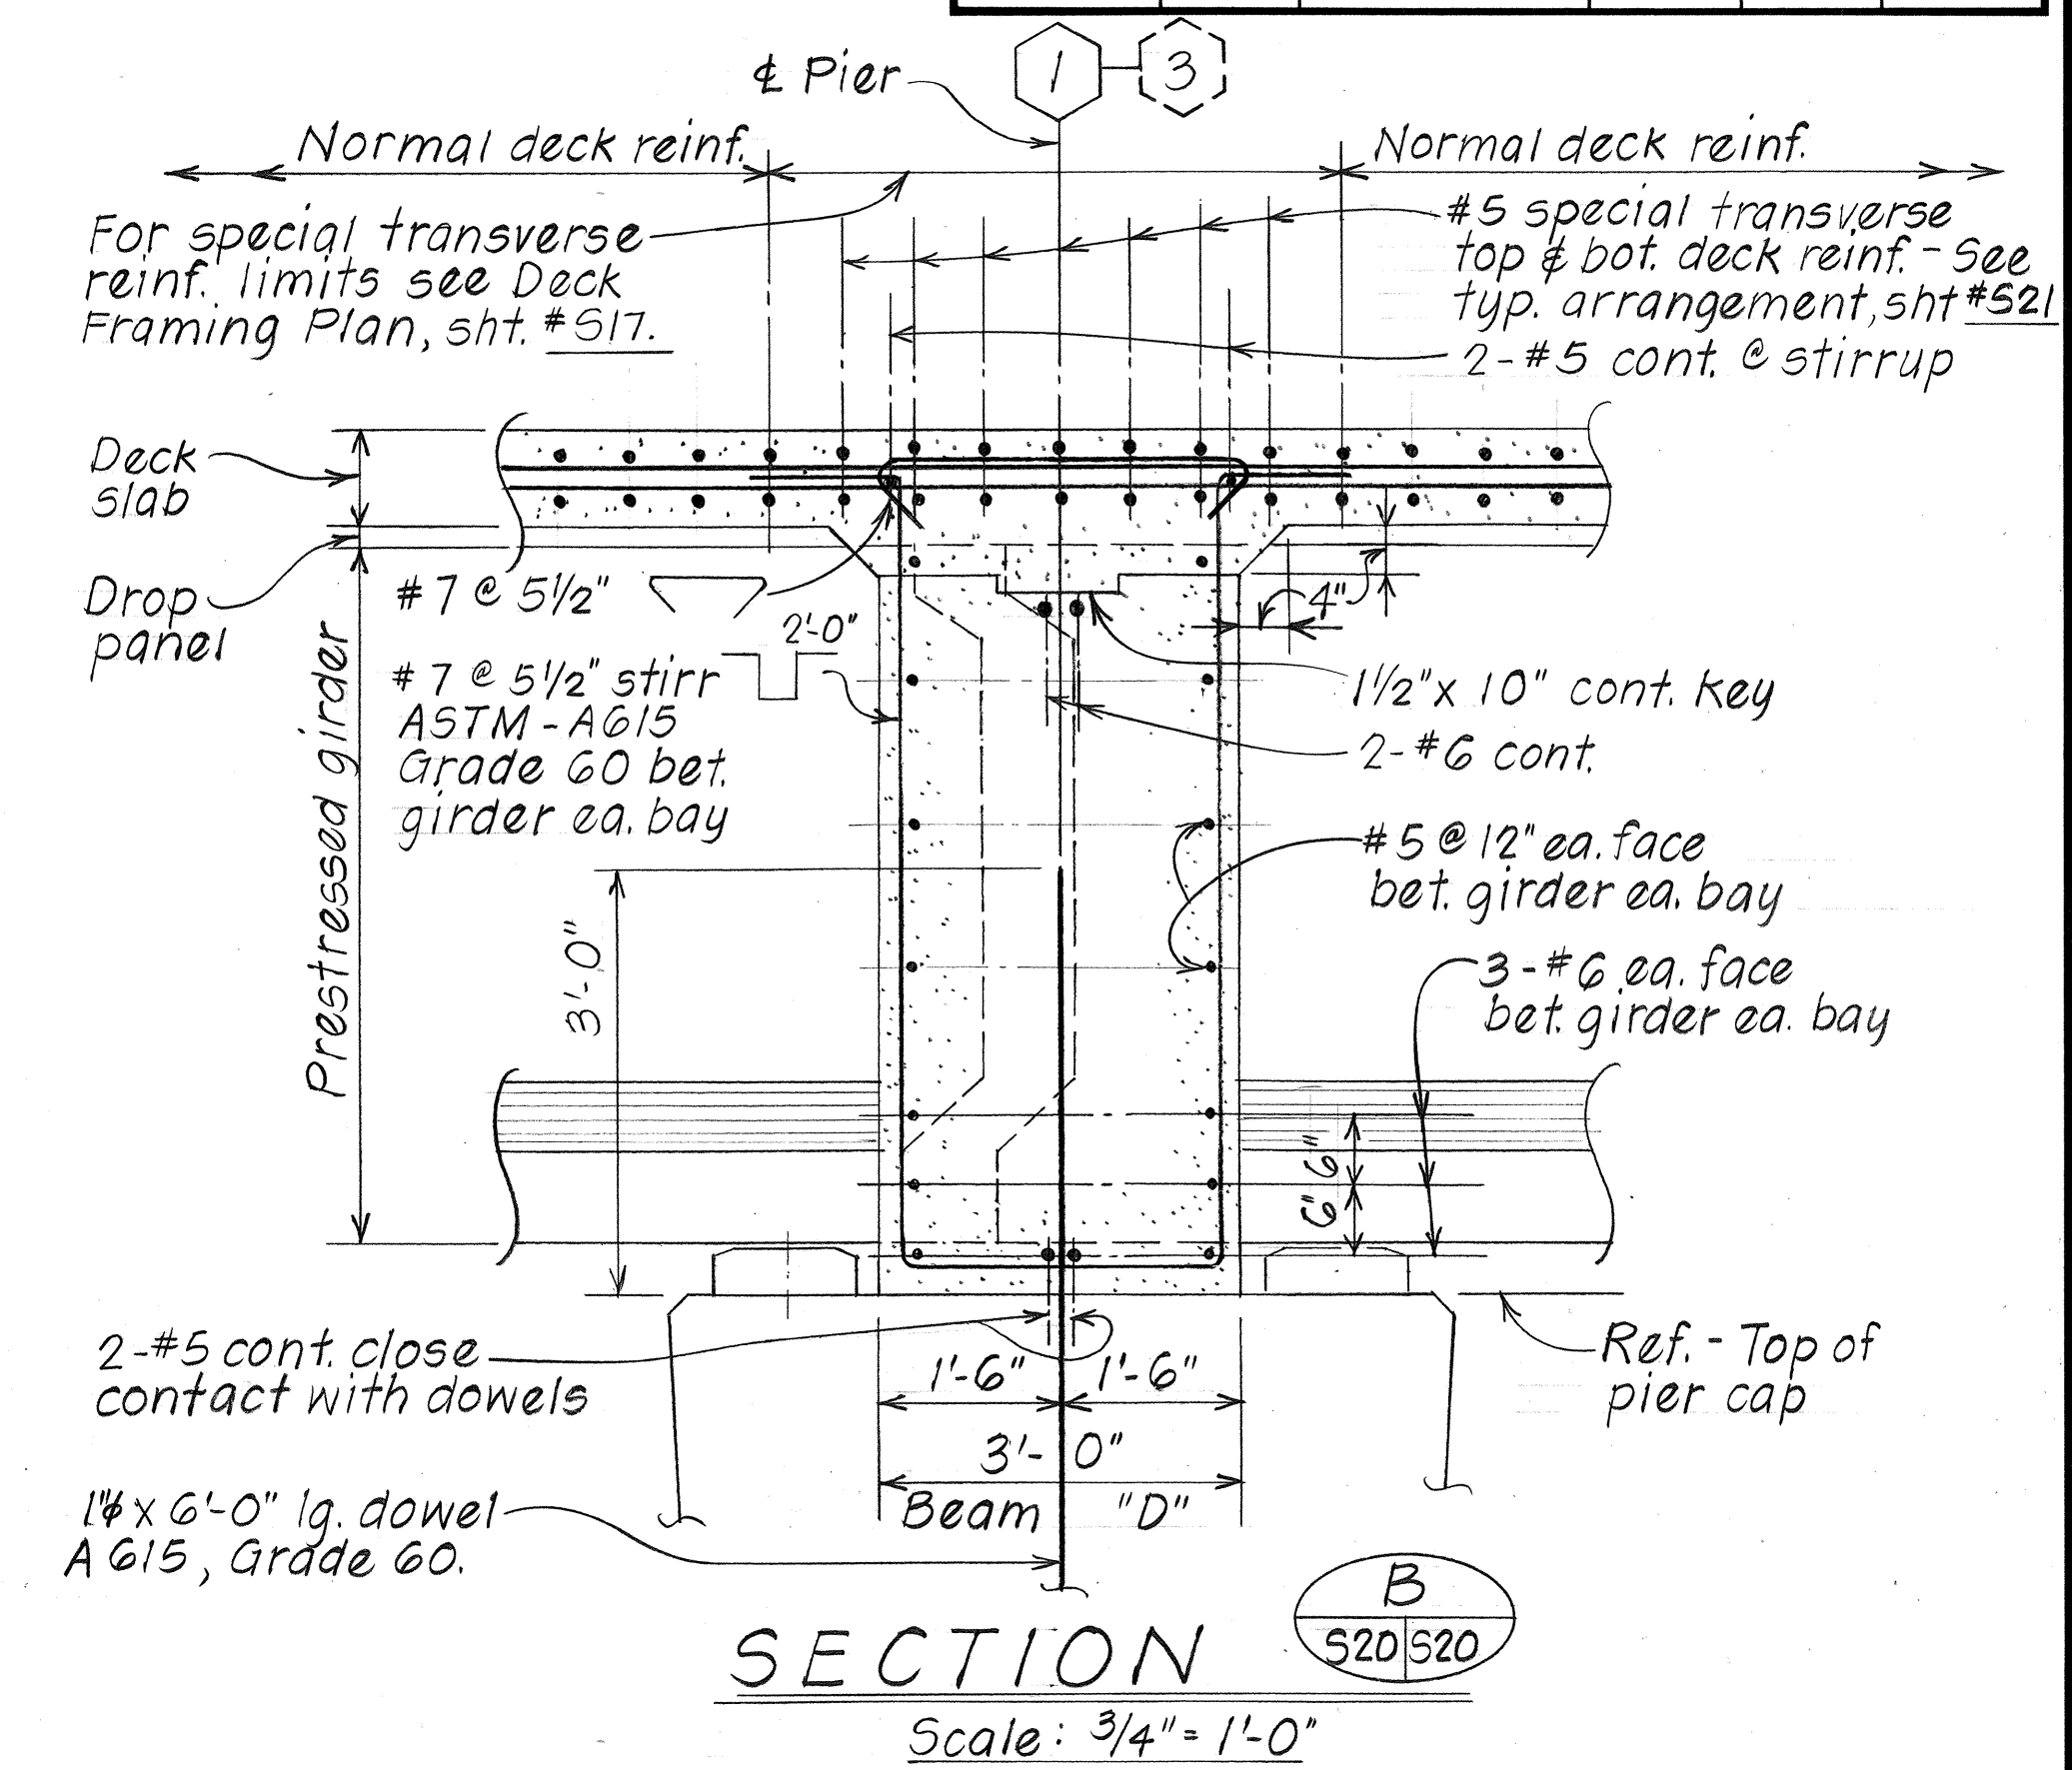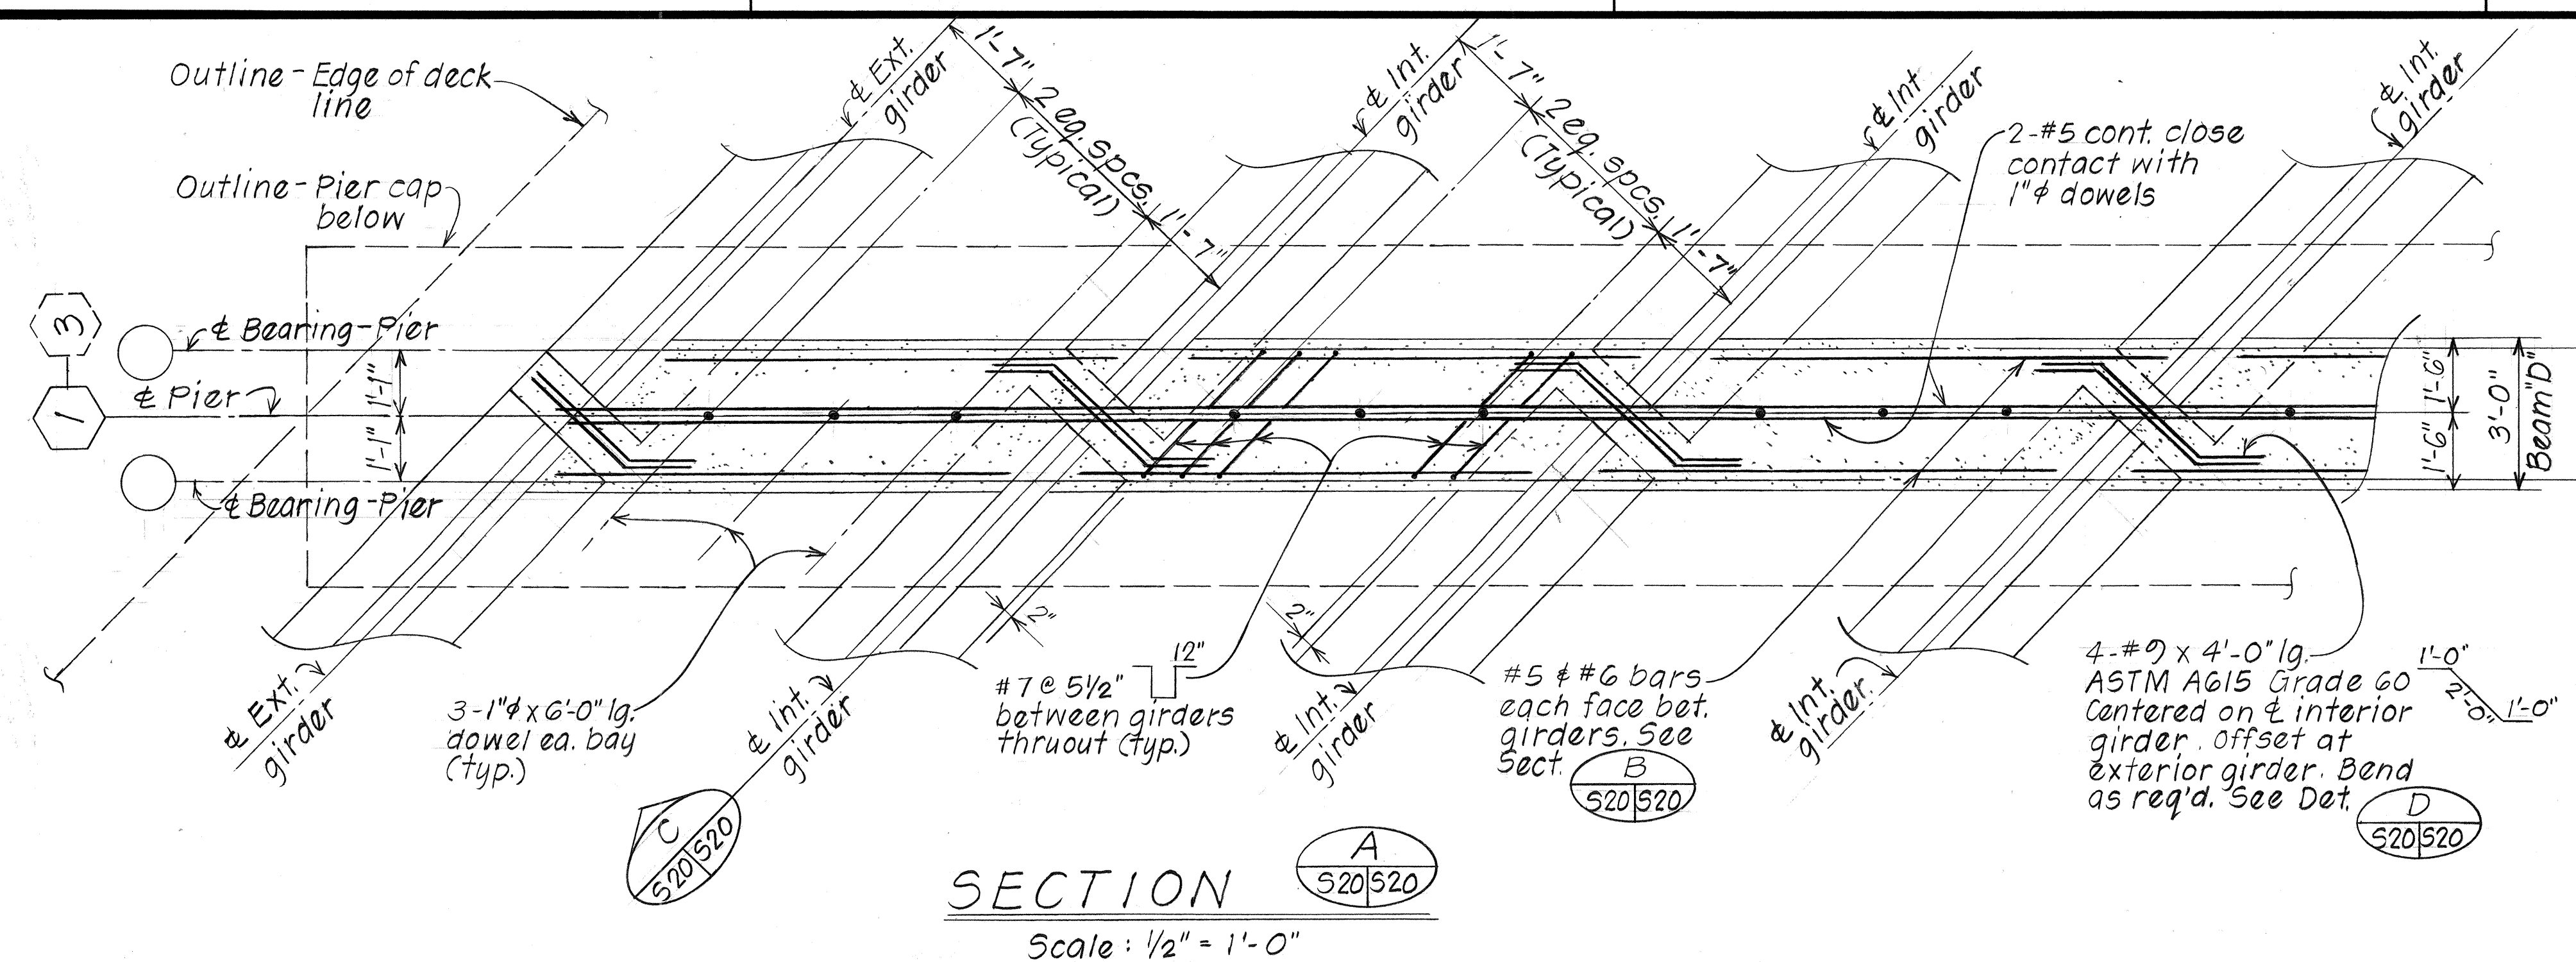

SURVEY PLOTTED BY	DATE
DRAWN BY	1/87
TRACED BY	1/87
QUANTITIES BY	1/87
CHECKED BY	1/87

STATE OF HAWAII
DEPARTMENT OF TRANSPORTATION
HIGHWAYS DIVISION


HULEIA STREAM BRIDGE

BEAM "D" DETAILS
KAUMUALII HWY.
PROJ. NO. BR-F-050-1(7)

Scale: As Noted Date: Aug. 1987

SHEET NO. 520 OF 22 SHEETS

FED. ROAD DIST. NO.	STATE	FED. AID PROJ. NO.	FISCAL YEAR	SHEET NO.	TOTAL SHEETS
HAWAII	HAW.	BR-F-050-1(7)	1988	45	15

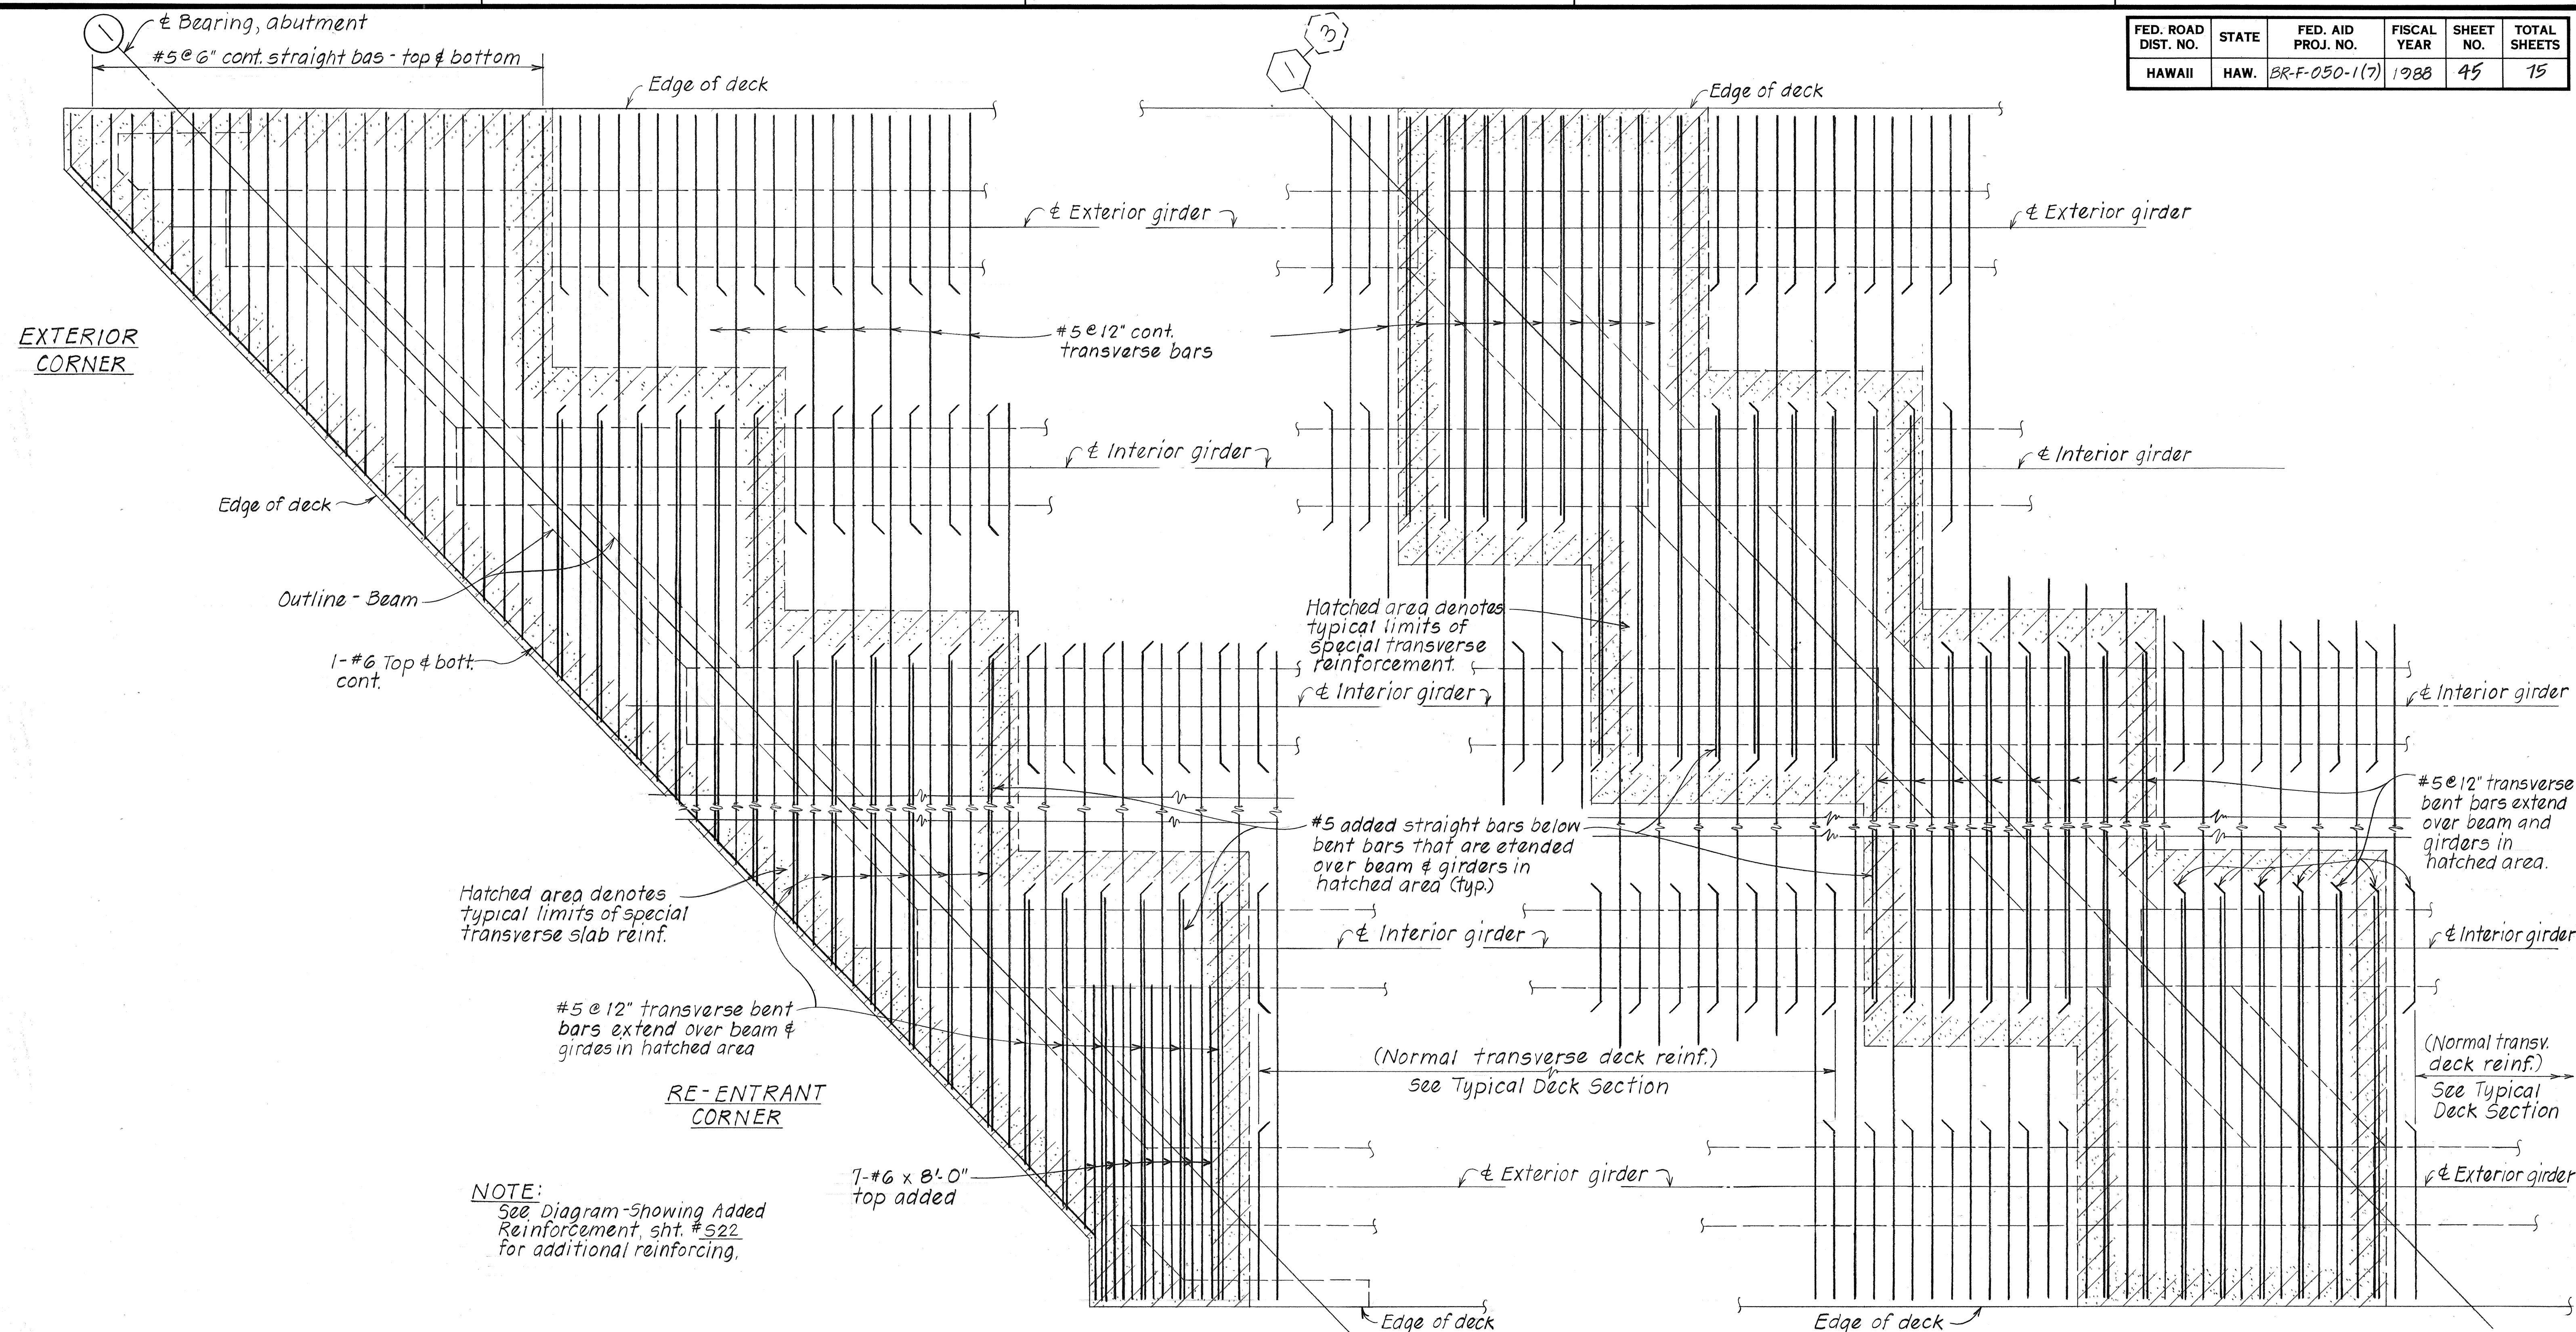

(DIAGRAM - SHOWING TRANSVERSE DECK REINFORCEMENT)

A
517521

ABUTMENT ① - AS SHOWN

(DIAGRAM - SHOWING TRANSVERSE DECK REINFORCEMENT)

B
517521

AT PIER ① & ③

ABUTMENT ② & PIER ② - SIMILAR EXCEPT AS OTHERWISE NOTED

PART PLAN - SPECIAL DECK REINFORCEMENT

AT ABUTMENTS & PIERS

Scale: 1/2" = 1'-0"

STATE OF HAWAII
DEPARTMENT OF TRANSPORTATION
HIGHWAYS DIVISION

HULEIA STREAM BRIDGE

PART PLAN - SPECIAL DECK REINF.

KAUMUALII HWY.
PROJ. NO. BR-F-050-1(7)


Scale: As Noted Date: Aug. 1987

SHEET NO. 521 OF 22 SHEETS



ORIGINAL PLAN
NOTE BOOK
No.

SURVEY PLOTTED BY: L.M.A.
DATE: 7/87
DRAWN BY: L.M.A.
DATE: 7/87
CHECKED BY: L.M.A.
DATE: 7/87

FED. ROAD DIST. NO.	STATE	FED. AID PROJ. NO.	FISCAL YEAR	SHEET NO.	TOTAL SHEETS
HAWAII	HAW.	BR-F-050-1(7)	1988	46	15

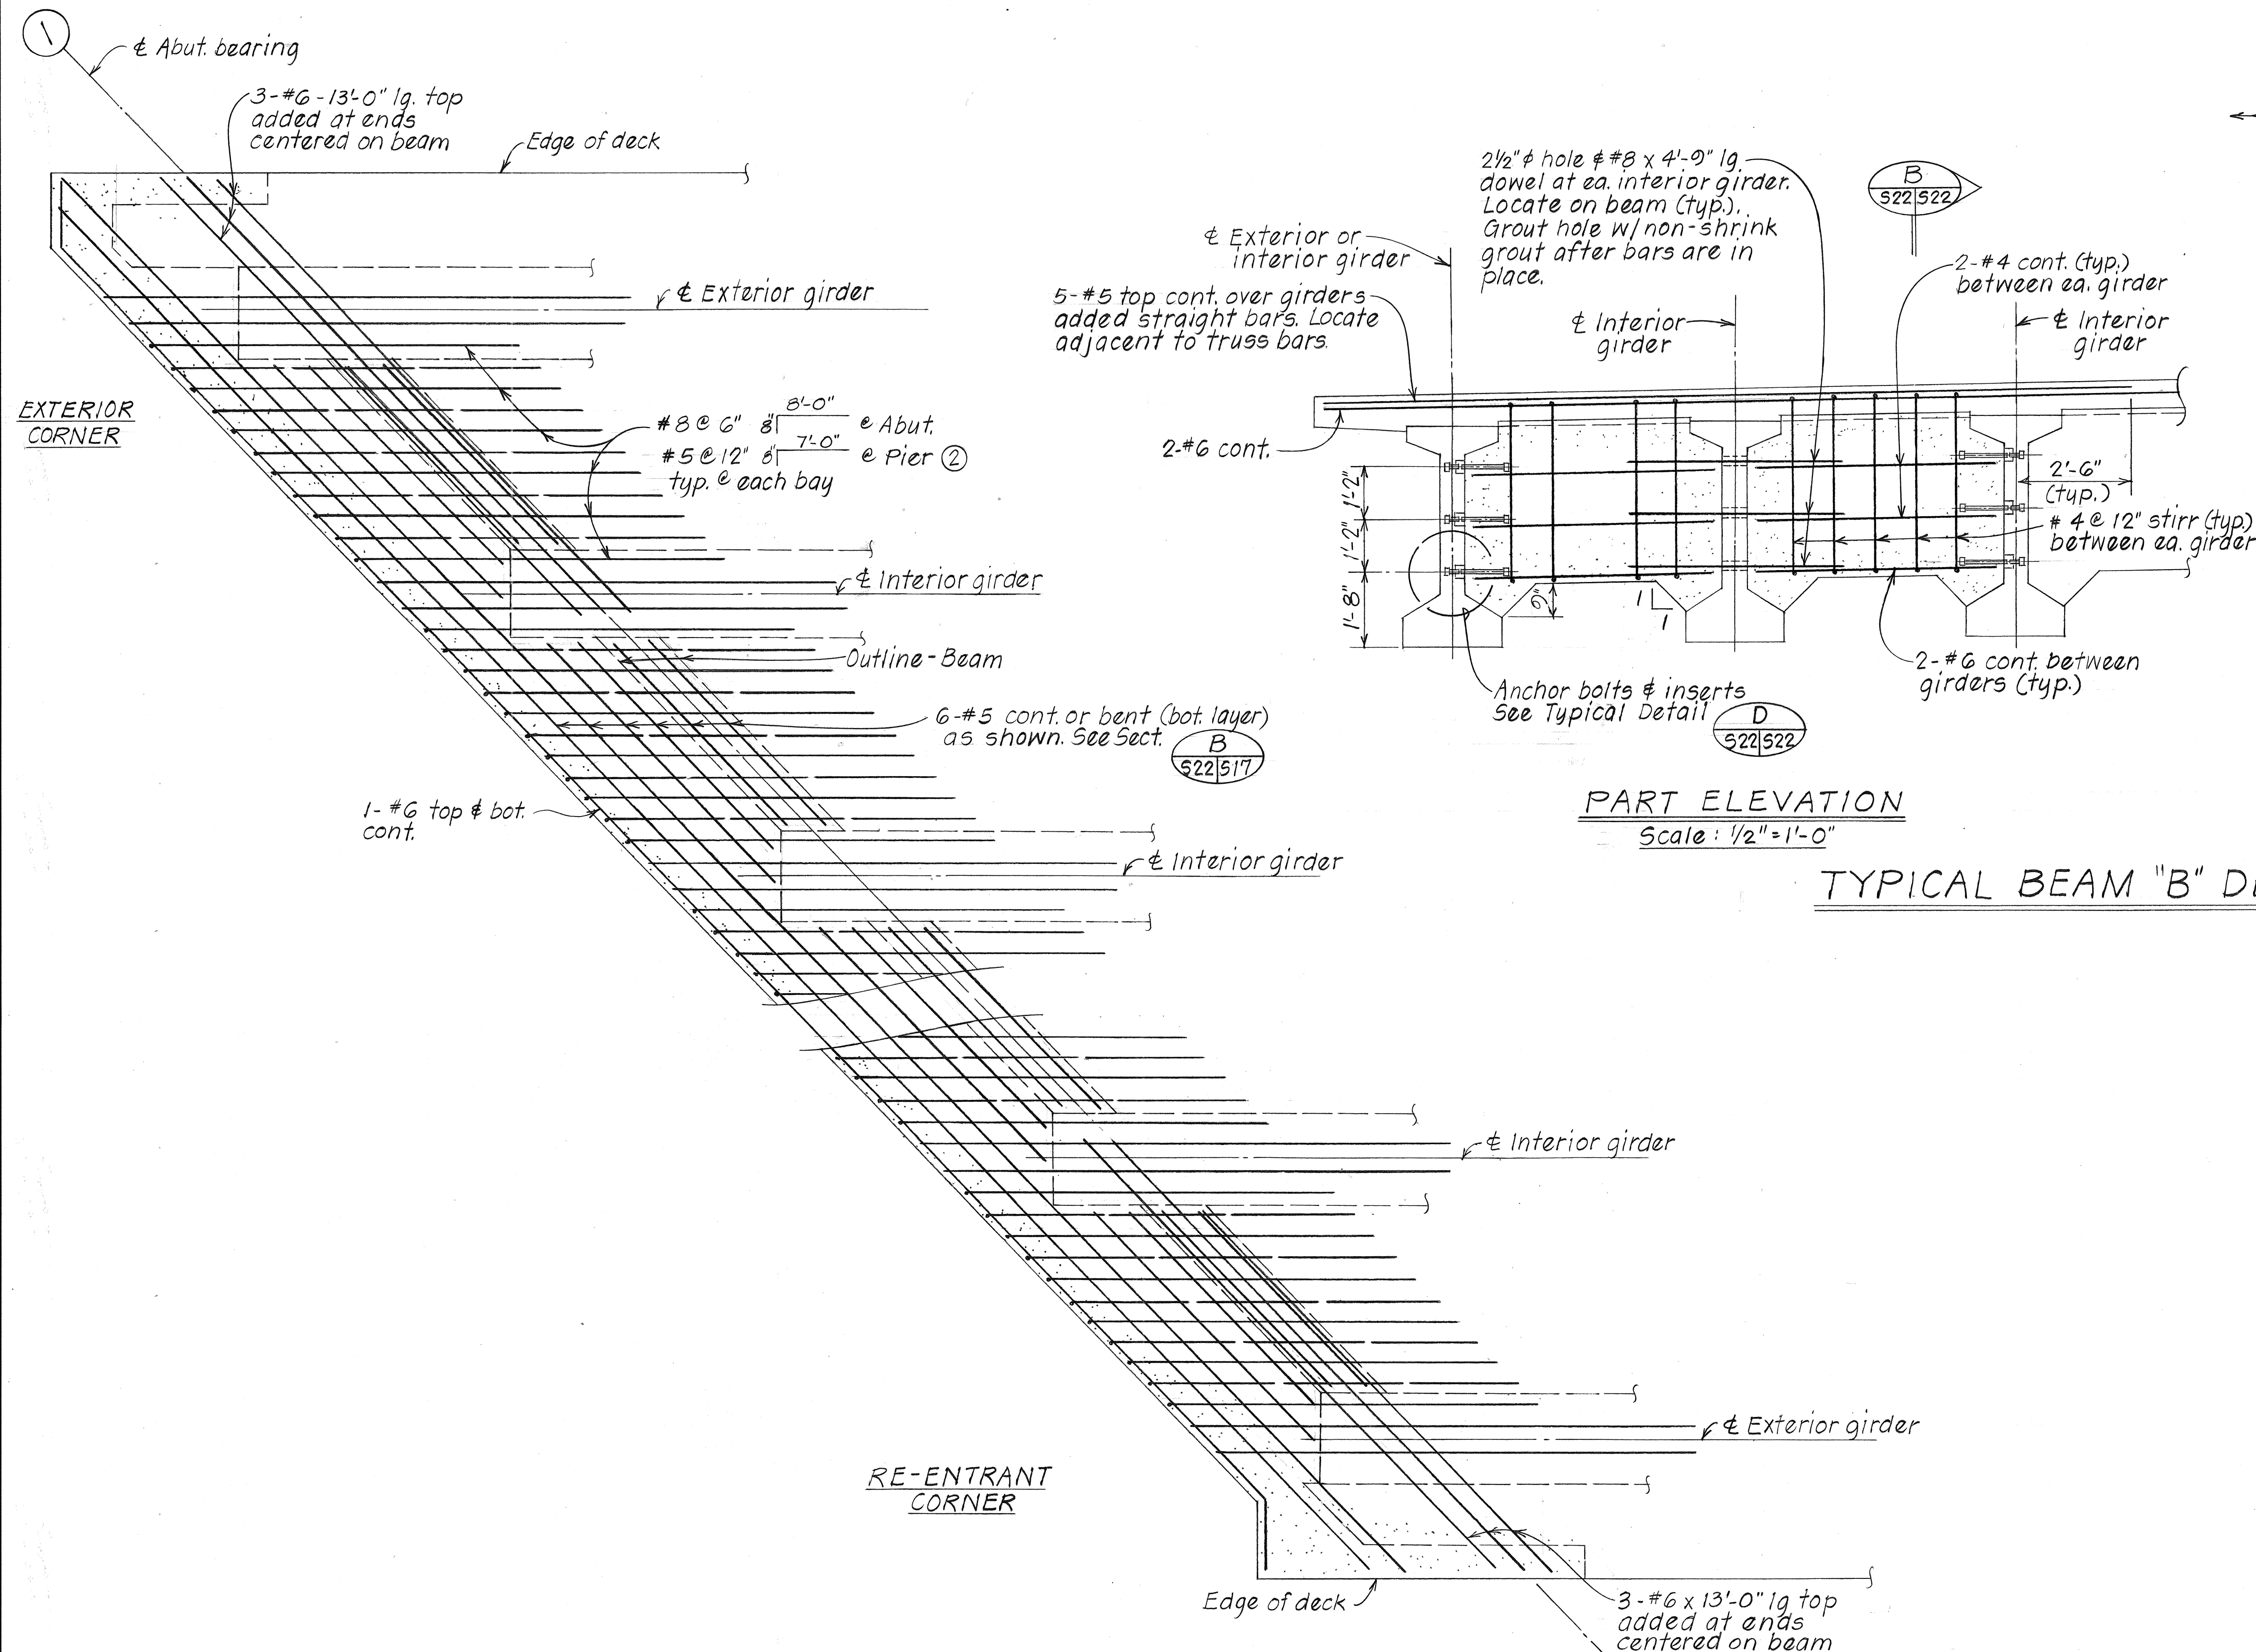

(SHOWING ADDED REINFORCEMENT)
PART PLAN - SPECIAL DECK REINFORCEMENT AT ABUTMENTS & PIER 2
Scale: 1/2" = 1'-0"

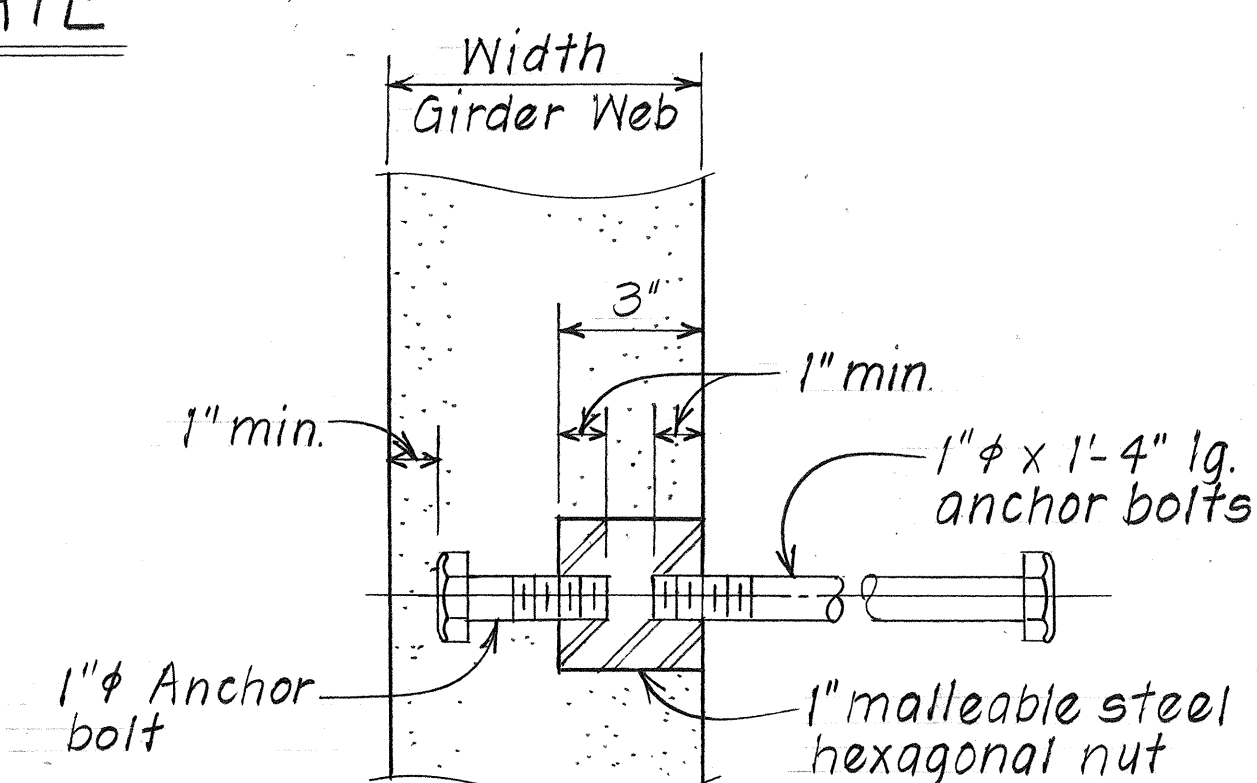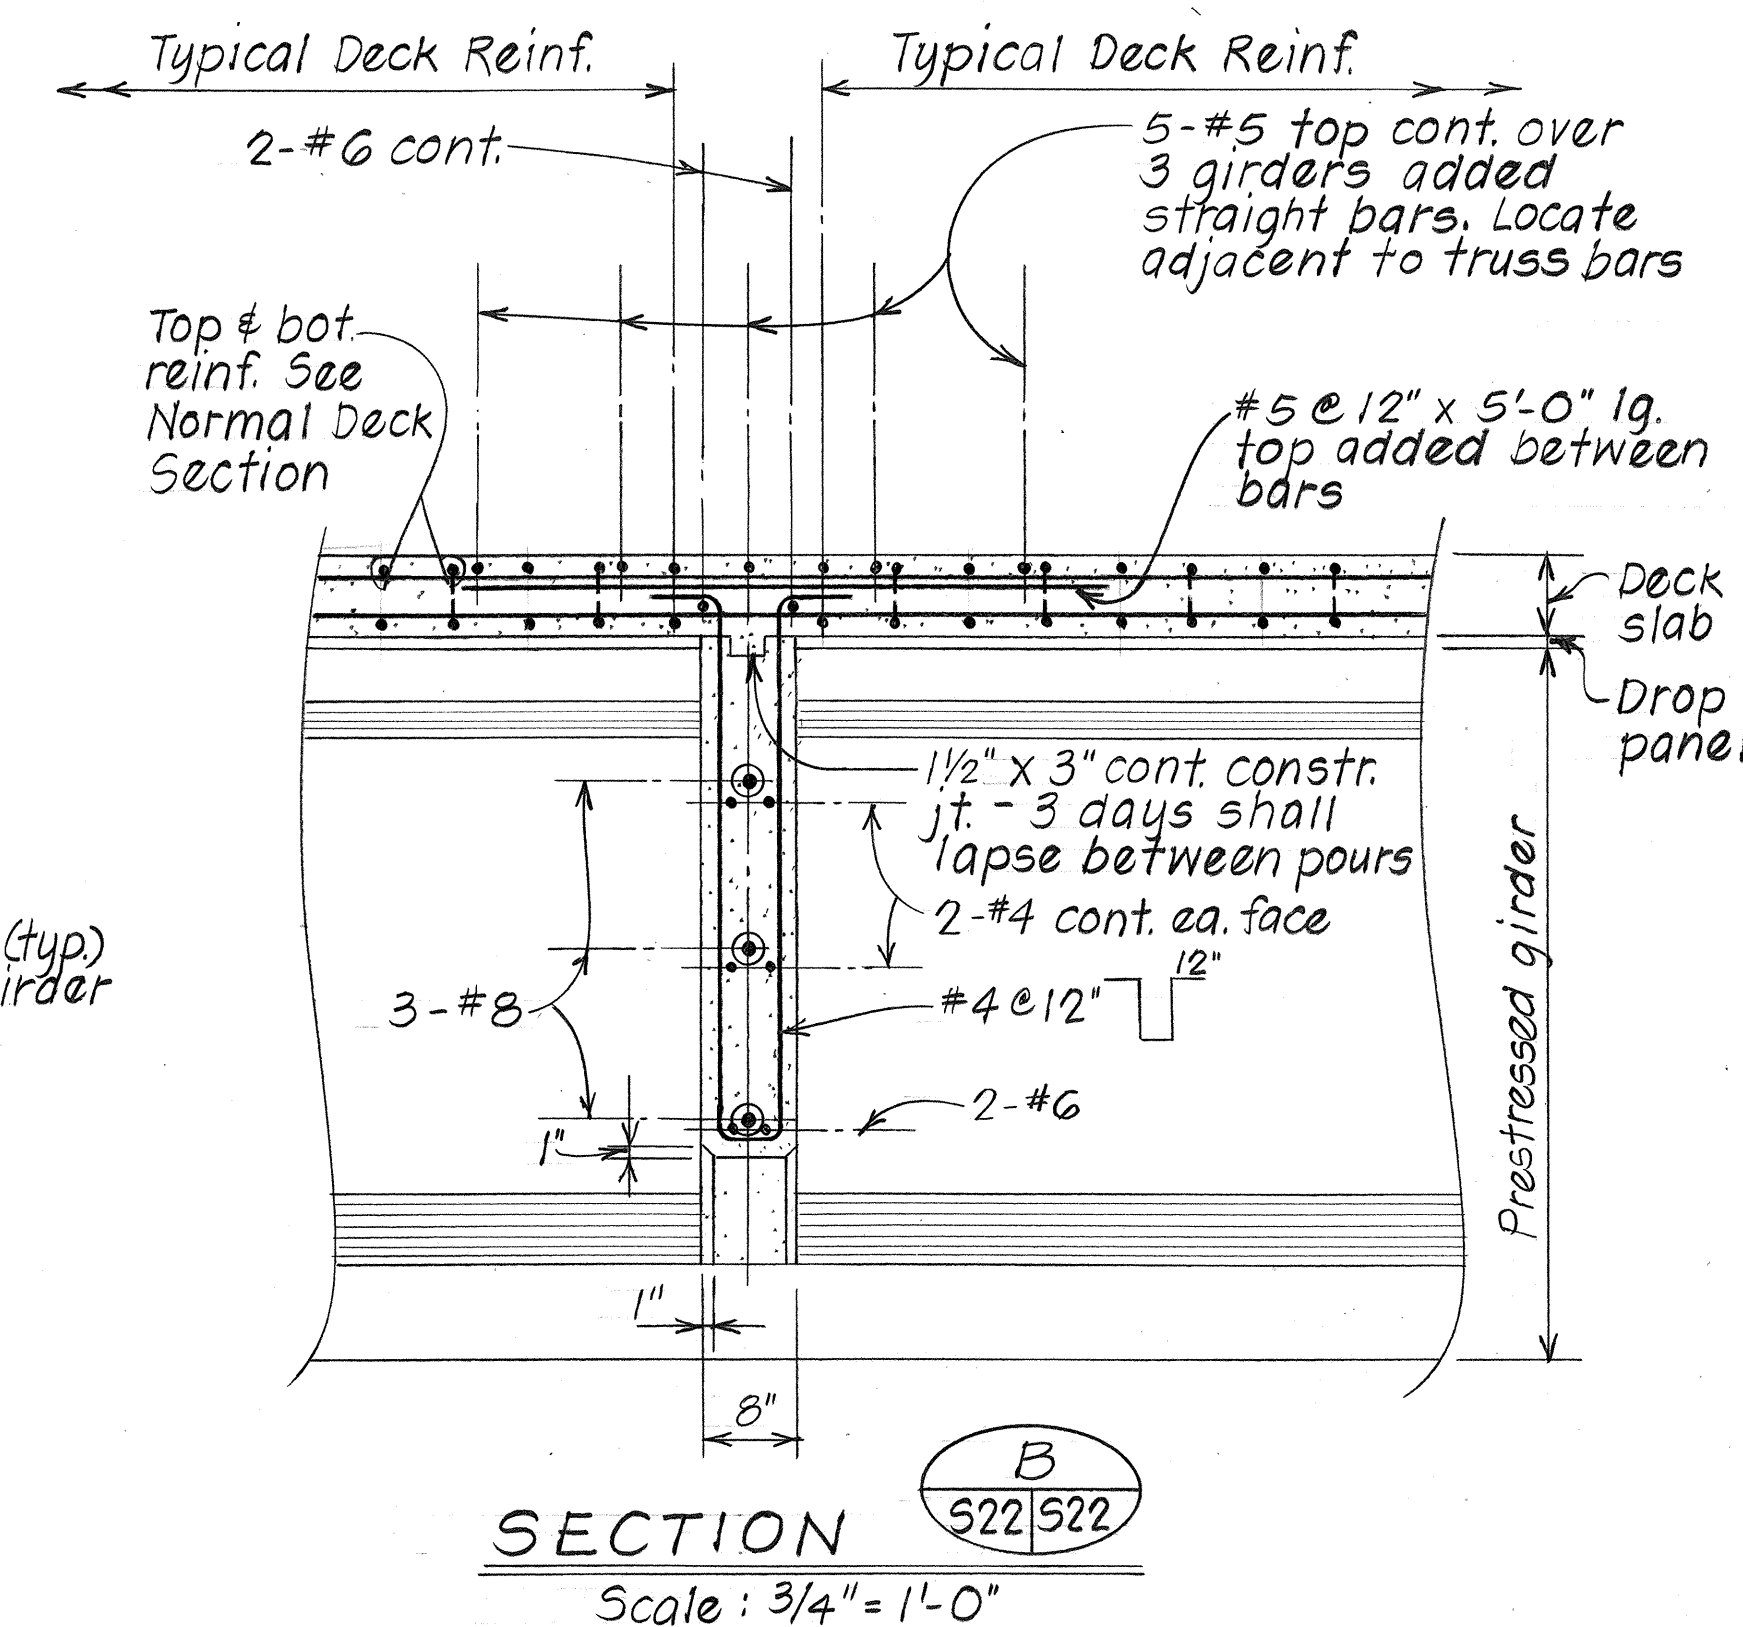

NOTE: Anchor bolts & inserts incidental to concrete & will not be paid for separately.
TYPICAL INSERT DETAIL
Scale: 3" = 1'-0"

PART ELEVATION
Scale: 1/2" = 1'-0"

TYPICAL BEAM "B" DETAIL




SURVEY PLOTTED BY	DATE
DRAWN BY	1/87
TRACED BY	1/87
QUANTITIES BY	1/87
CHECKED BY	1/87
ORIGINAL PLAN	
NOTE BOOK	
NO.	

STATE OF HAWAII DEPARTMENT OF TRANSPORTATION HIGHWAYS DIVISION
HULEIA STREAM BRIDGE
PART PLAN-SPECIAL DECK REINF.
BEAM "B" DETAILS
KAUMUALII HWY.
PROJ. NO. BR-F-050-1(7)
Scale: As Noted Date: Aug. 1987
SHEET NO. 522 OF 22 SHEETS

FED. ROAD DIST. NO.	STATE	FED. AID PROJ. NO.	FISCAL YEAR	SHEET NO.	TOTAL SHEETS
HAWAII	HAW.	BR-F-050-1(7)	1988	47	75

BUNDLING OF PRESTRESSING REINFORCEMENT

1. Strands may be bundled in groups as shown.
2. The minimum distance "S" between groups or individual strands: 2" for 1/2" strands.
3. "S" is measured between centers of adjacent strands.

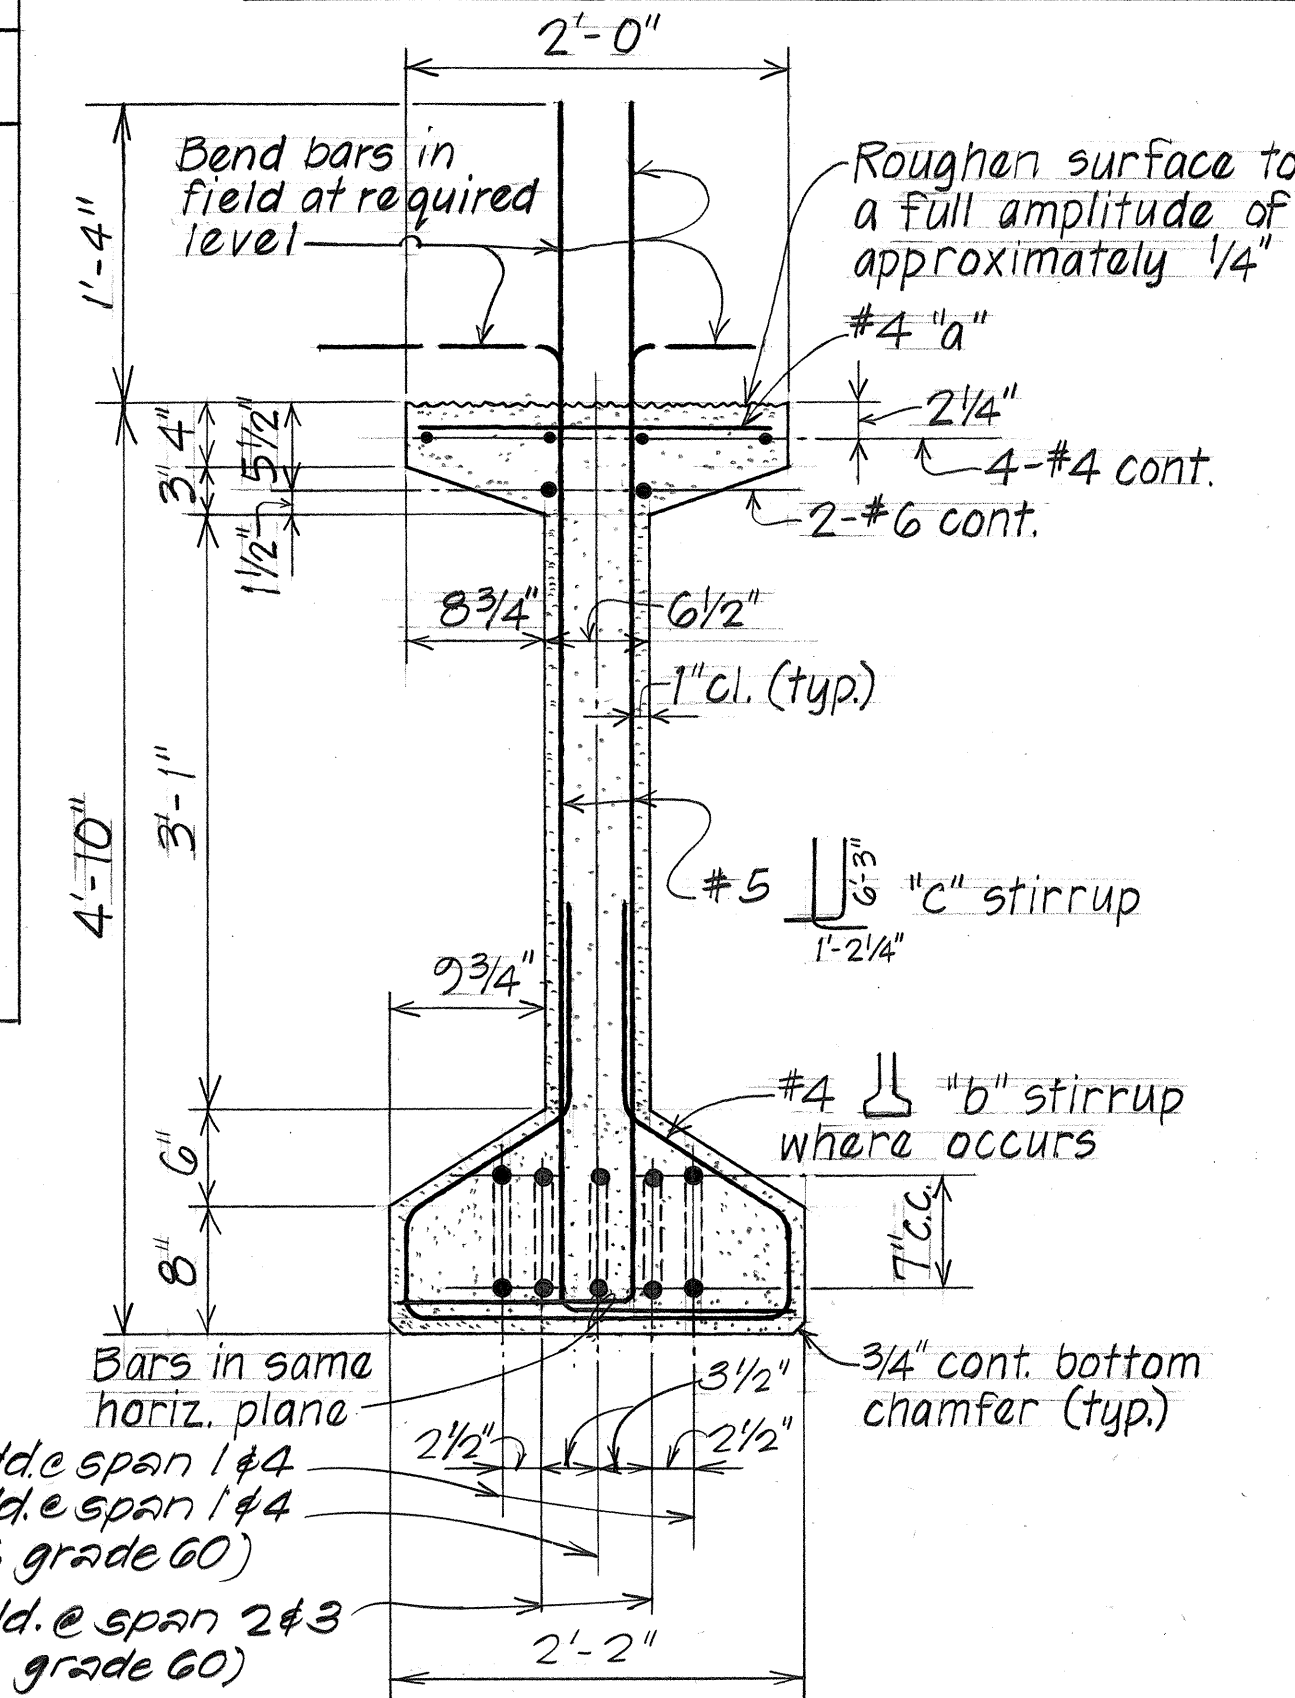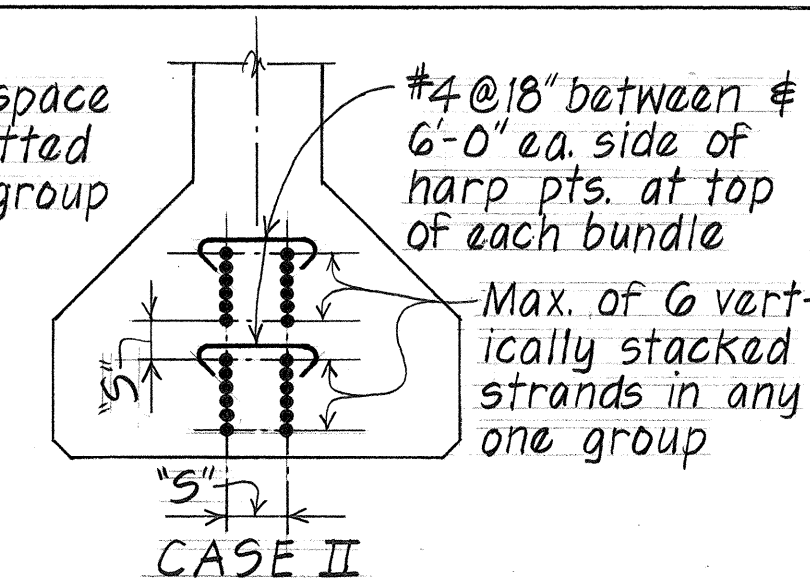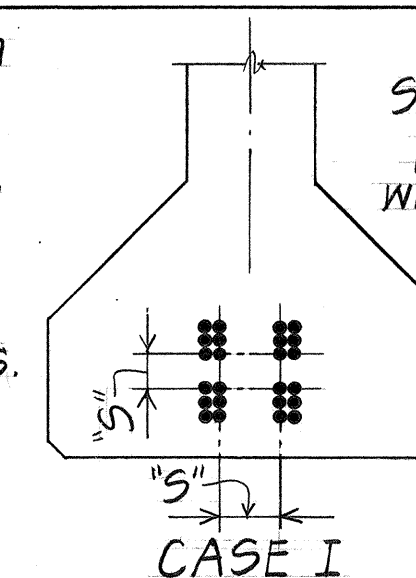

TYPICAL PRESTRESSED CONCRETE GIRDER
TYPE PG-IV
No Scale

GENERAL NOTES

1. All strand patterns shall be approved by the Engineer.
2. Forms must be removed and the beams inspected before strands are cut.
3. For additional holes and inserts in prestressed girders for beam connections refer to corresponding beam details. See Sht. #519, 520 & #522.
4. For additional prestressed girder details not covered by these drawings refer to corresponding detail plans.
5. The calculated camber includes the effect of the initial prestress force and weight of the girder upon removal from the prestressing bed. Calculated camber values shown do not account for any camber growth of the girder. The actual camber at time of deck pour shall not exceed the calculated camber by more than 100%. Calculated midspan camber = 1.91/16 inches. Contractor shall submit record of cambers to the Engineer. This record shall include cambers at time of detensioning, delivery, and deck pour.

PRESTRESSED CONCRETE GIRDERS:

$f'_c = 6000$ psi @ 28 days
 $f_{ci} = 4350$ psi @ transfer


PRESTRESSED STRANDS:

- A. 1/2" ϕ 270 ksi, 7 wire stressed-relieved strands (ASTM A416)
Total losses other than friction = 45,000 psi
- B. Allowable stresses in strands shall be in accordance with Design Specifications (See General Structure Notes)

GIRDER DIMENSION SCHEDULE

GIRDER TYPE	DIMENSION									
	"a"	"b"	"c"	"d"	"e"	"f"	"g"	"h"	L_1	L_2
TYPE PG-IV	18'5/16"	25'3/8"	5'7/16"	10'-3"	15'1/8"	17'3/8"	20'	23'3/8"	5'-0"	12'-0"

ELEVATION - TYPE PG-IV GIRDER END DETAILS

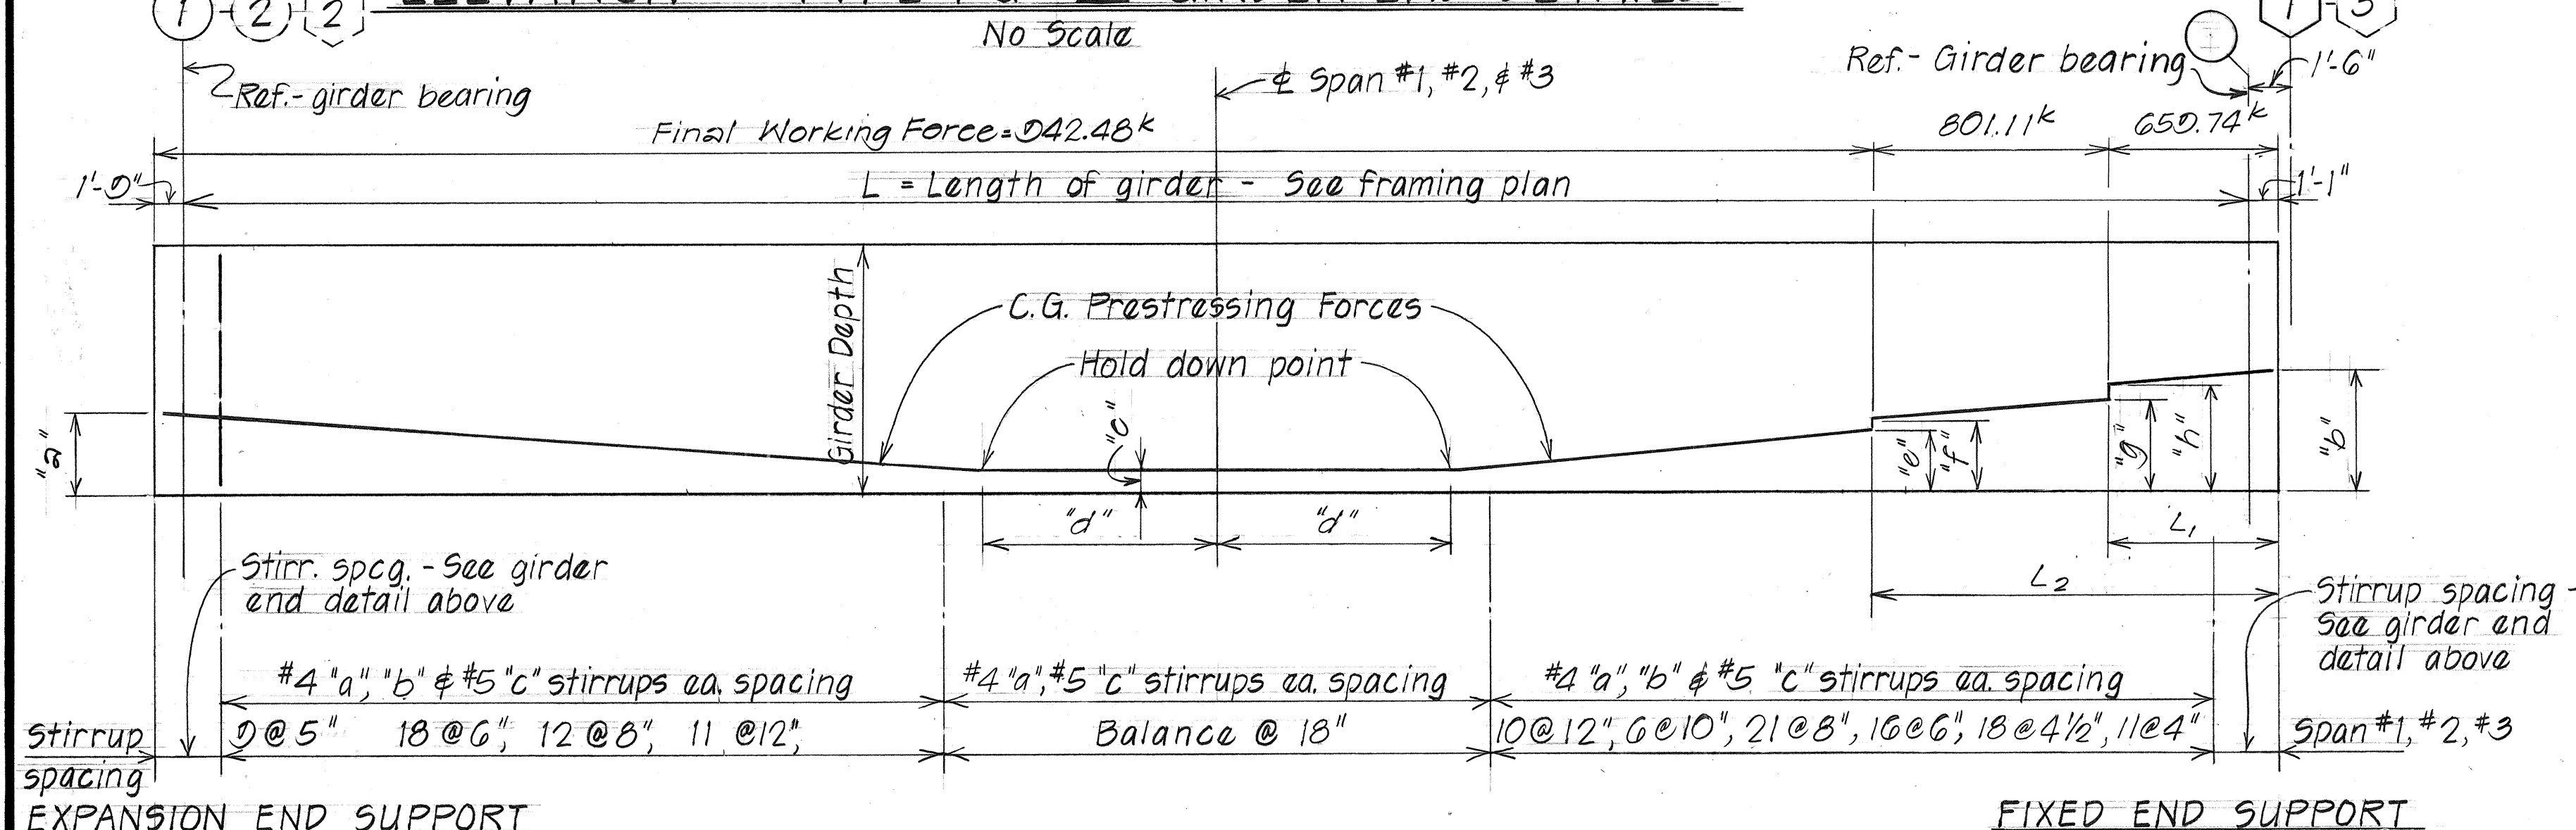


TYPICAL TYPE PG-IV GIRDER DETAIL

No Scale

SURVEY PLOTTED BY	DATE
DRAWN BY	
TRACED BY	
DESIGNED BY	
CHECKED BY	
ORIGINAL PLAN	
NOTE BOOK	
No.	

FED. ROAD DIST. NO.	STATE	FED. AID PROJ. NO.	FISCAL YEAR	SHEET NO.	TOTAL SHEETS
HAWAII	HAW.	BR-F-050-1(7)	1988	48	75

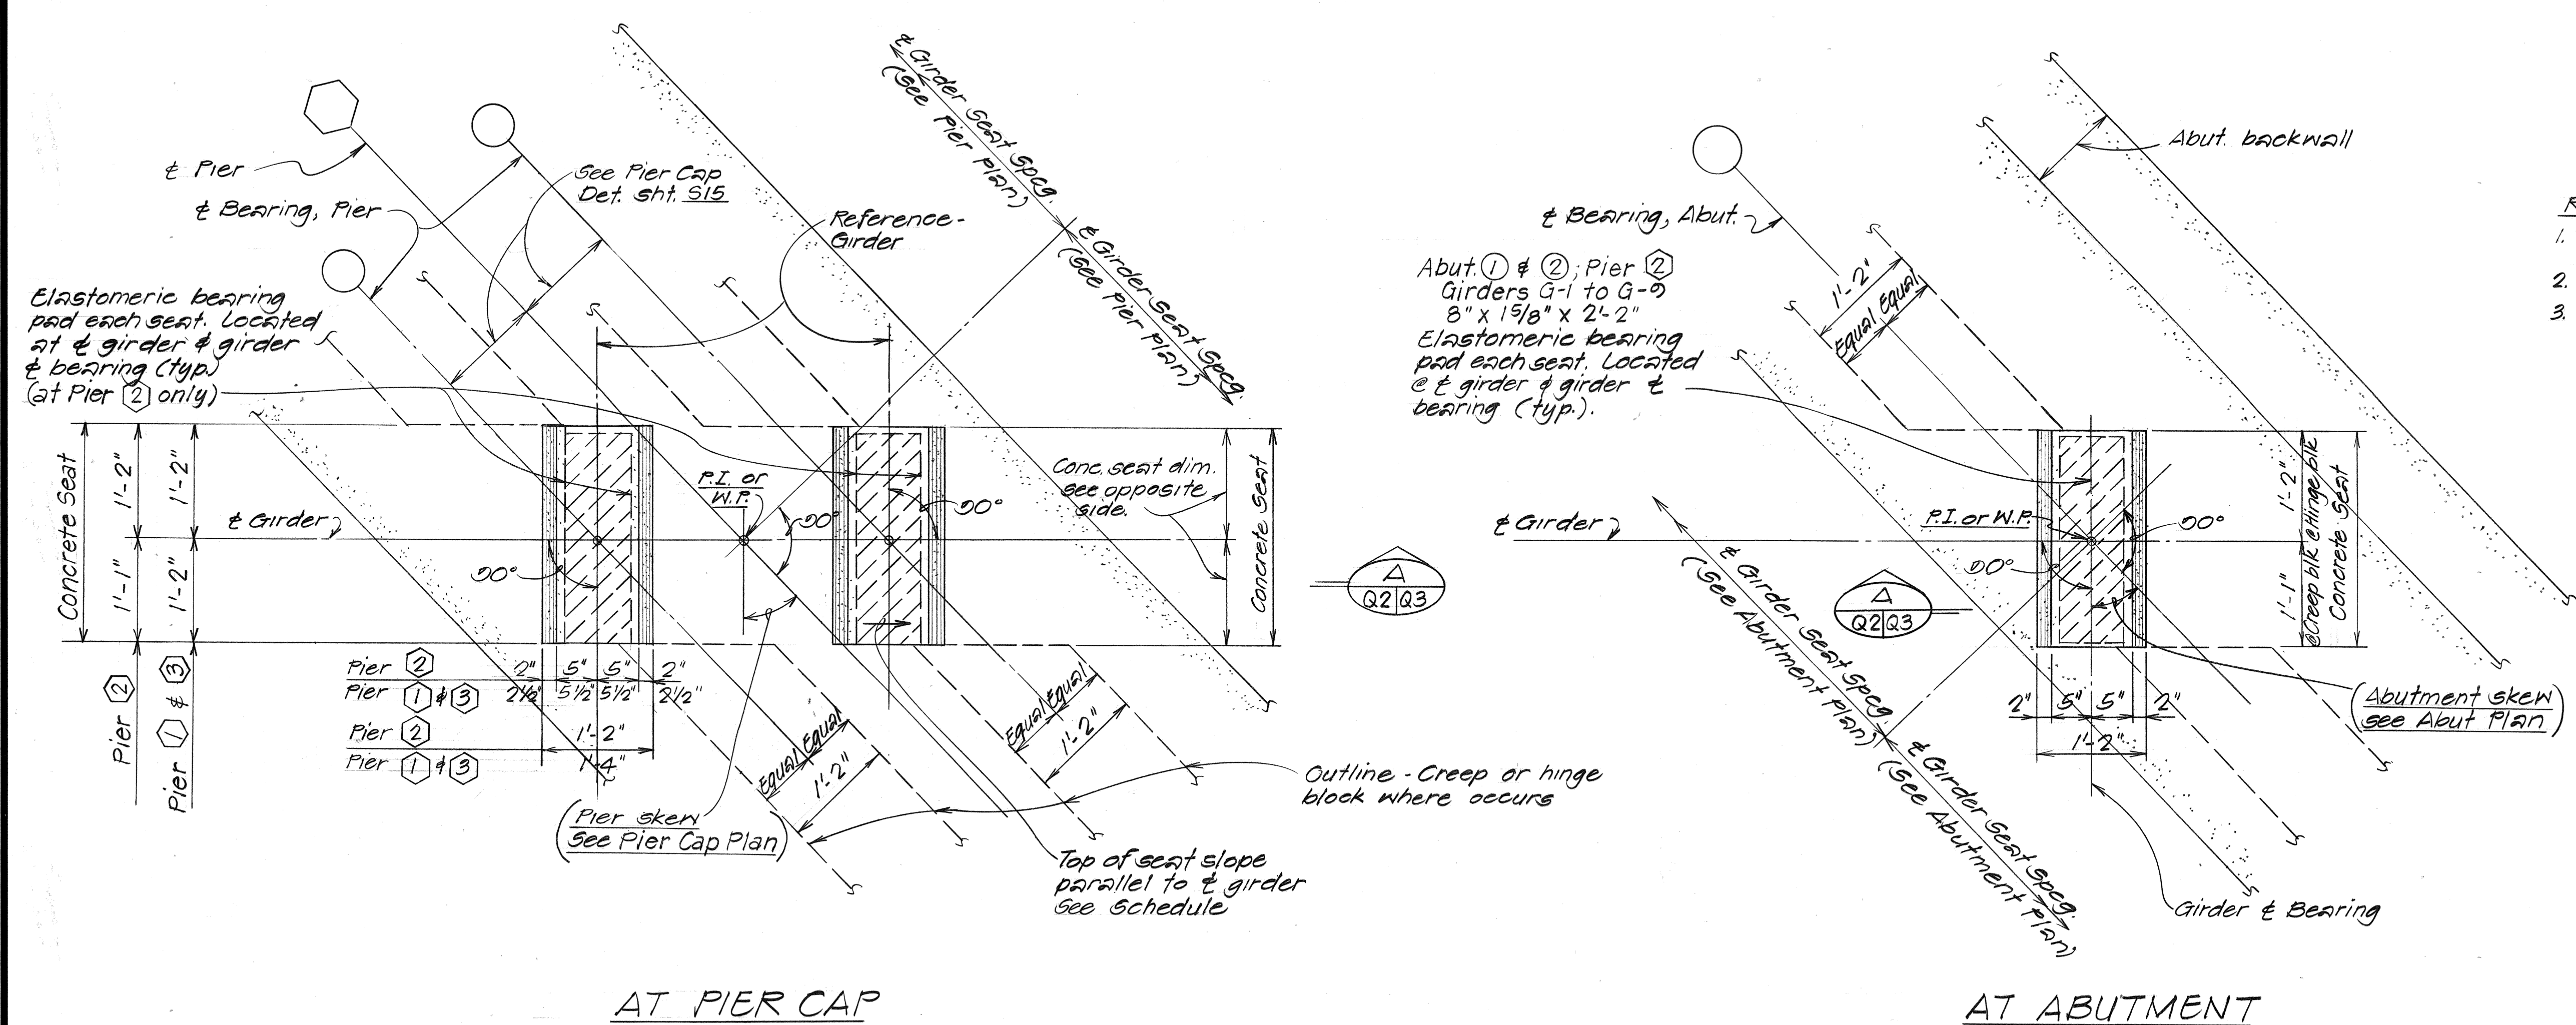

- REFERENCE NOTE:
1. Refer to sht. Q3 for concrete seat, hinge & creep block details.
 2. Refer to sht. S1 & S2 for abutment details.
 3. Refer to sht. S16 for pier cap details.

NOTE:

All abut. bearing seat elevations are based on steel laminated elastomeric bearing pads. If fabric laminations are used in lieu of the steel, appropriate revisions shall be made to the bearing seat elevations to reflect the reduction in thickness of the bearing pads. Any such revision shall be approved by the Engineer.

PART PLAN - TYPICAL GIRDER CONCRETE SEAT
Scale: 1" = 1'-0"

TOP CONCRETE SEAT ELEVATION & SLOPE SCHEDULE (AT GIRDER & BEARING)													
LOCATION GIRDER	ABUTMENT BEARING	DIRECTION	①		DIRECTION	②		DIRECTION	③		DIRECTION	④	
	①	TOP SEAT SLOPE	③	④	TOP SEAT SLOPE	⑤	⑥	TOP SEAT SLOPE	④	③	TOP SEAT SLOPE	②	ABUTMENT BEARING
G-1	363.65	- 1/16:12	- 363.01	363.00	+ 0:12	+ 362.96	362.98	+ 1/8:12	+ 364.01	364.05	+ 3/16:12	+ 365.70	
G-2	363.79	- DO	- 363.20	363.19	+ DO	+ 363.19	363.22	+ DO	+ 364.30	364.34	+ DO	+ 366.04	
G-3	363.85	- DO	- 363.30	363.30	+ DO	+ 363.35	363.37	+ DO	+ 364.50	364.54	+ 3/16:12	+ 366.29	
G-4	363.91	- DO	- 363.41	363.41	+ 0:12	+ 363.51	363.53	+ 1/8:12	+ 364.71	364.75	+ 7/32:12	+ 366.55	
G-5	363.74	- 1/16:12	- 363.29	363.29	+ 1/32:12	+ 363.43	363.46	+ 5/32:12	+ 364.68	364.72	+ DO	+ 366.57	
G-6	363.56	- 1/32:12	- 363.16	363.16	+ DO	+ 363.35	363.36	+ DO	+ 364.65	364.69	+ DO	+ 366.58	
G-7	363.38	- DO	- 363.03	363.03	+ DO	+ 363.27	363.30	+ DO	+ 364.62	364.66	+ DO	+ 366.60	
G-8	363.21	- DO	- 362.90	362.91	+ DO	+ 363.19	363.22	+ DO	+ 364.59	364.63	+ 7/32:12	+ 366.62	
G-9	362.95	- 1/32:12	- 362.70	362.70	+ 1/32:12	+ 363.03	363.07	+ 5/32:12	+ 364.48	364.52	+ 1/4:12	+ 366.56	

STATE OF HAWAII

DEPARTMENT OF TRANSPORTATION

HIGHWAYS DIVISION

TYPICAL DETAILS

PLAN - GIRDER CONCRETE SEAT

& MISCELLANEOUS SCHEDULES

KAUMUALII HIGHWAY


PROJ. NO. BR-F-050-1(7)

Scale: As Noted Date: Aug. 1987

SHEET NO. Q2 OF 7 SHEETS


SURVEY PLOTTED BY	DATE
DRAWN BY	
TRACED BY	
CHECKED BY	
NO.	

FED. ROAD DIST. NO.	STATE	FED. AID PROJ. NO.	FISCAL YEAR	SHEET NO.	TOTAL SHEETS
HAWAII	HAW.	BR-F-050-1(7)	1988	50	15

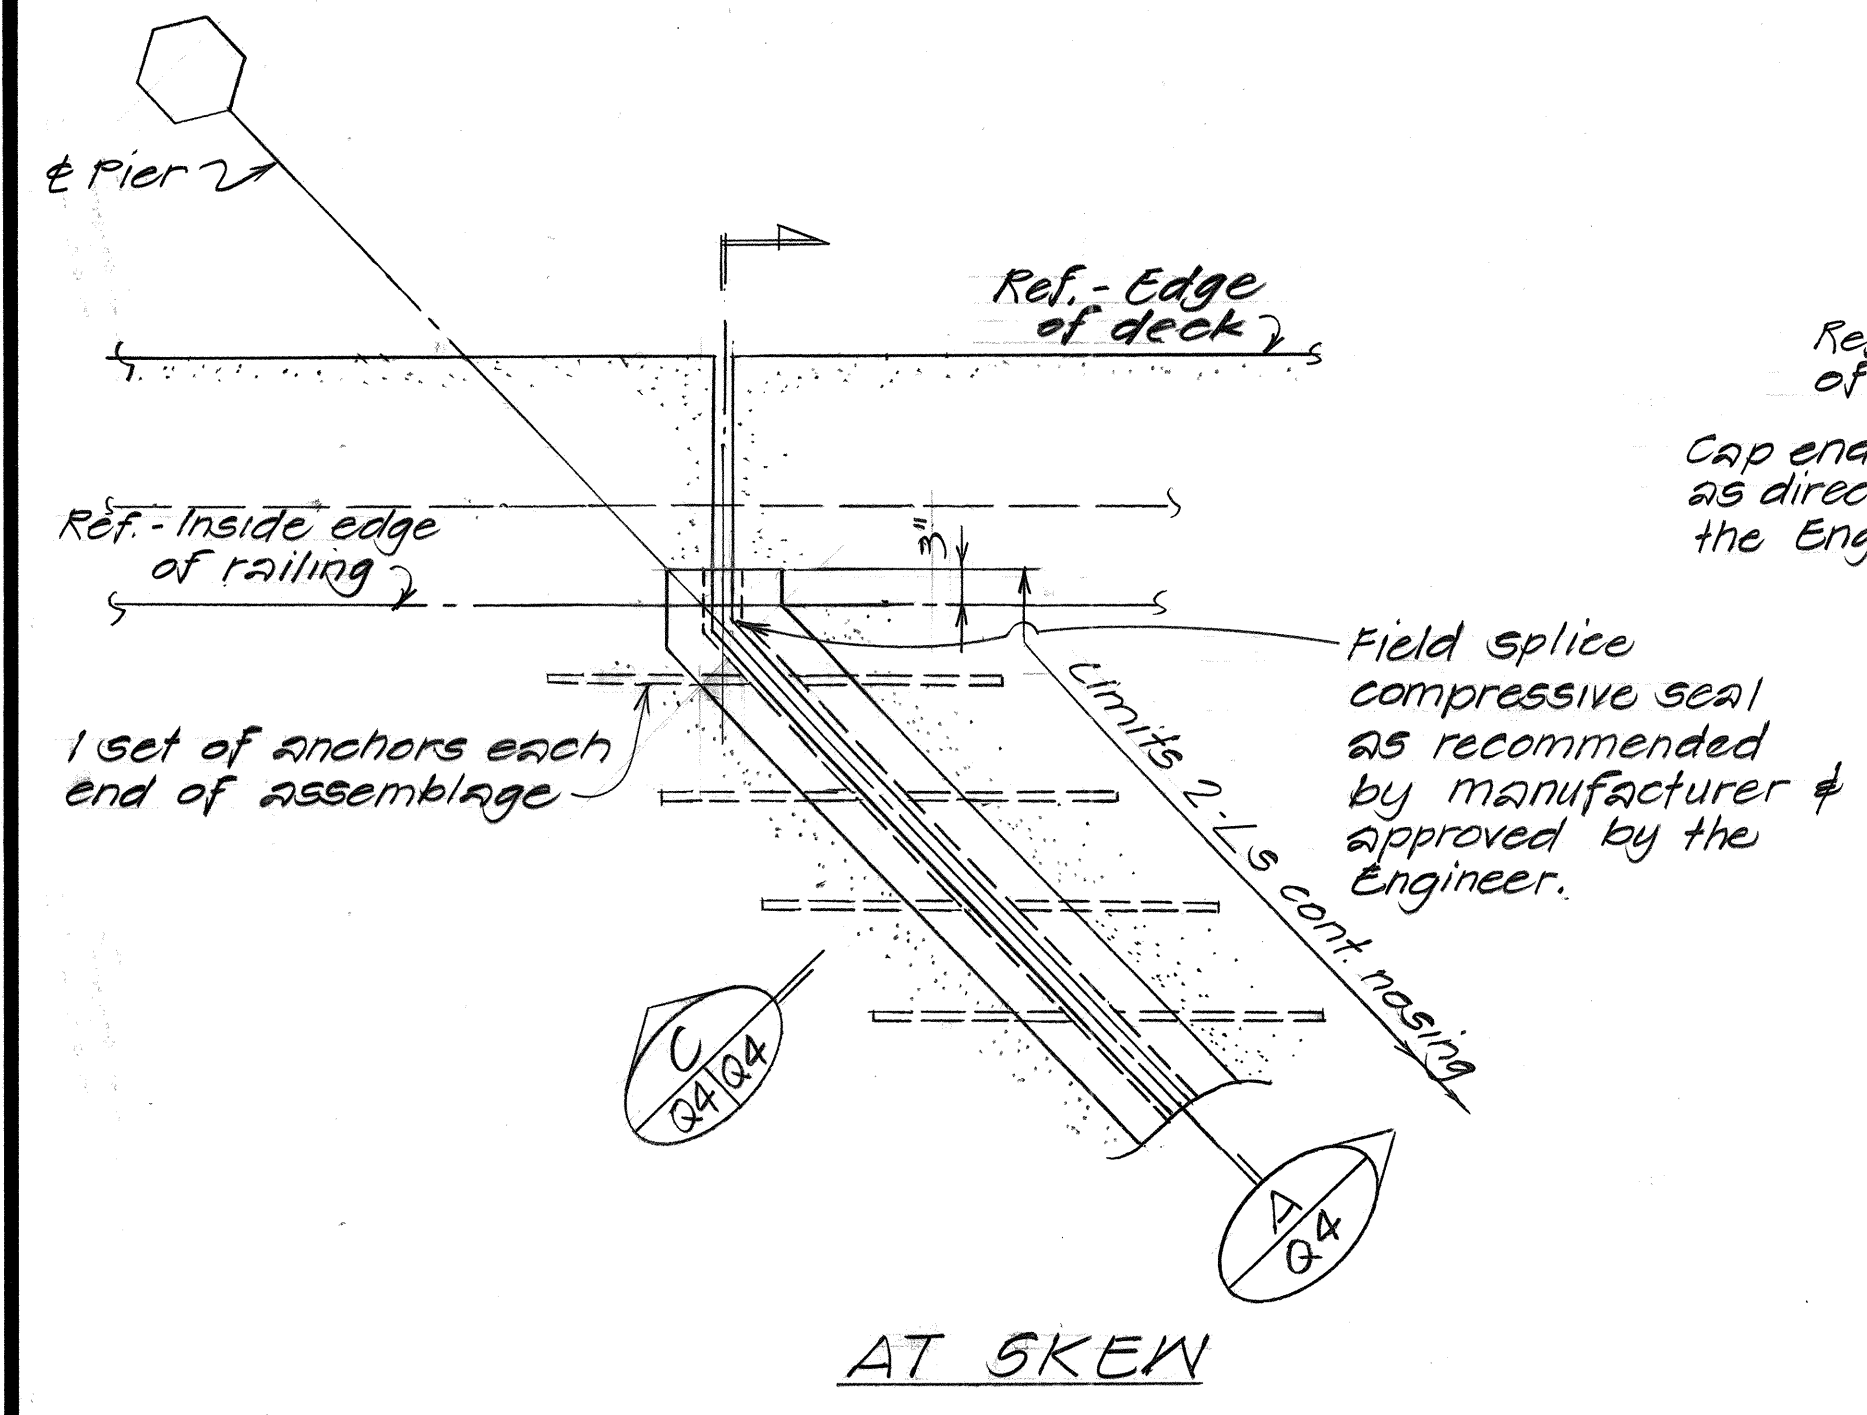


PART PLAN scale: 3/4" = 1'-0"


DECK EXPANSION JOINT & SEALER SCHEDULE						
LOCATION	DECK EXP. JOINT SIZE	Groove Dim.		Steel Angle Protective Nosing	JOINT SEALER (Dimensions & Tolerances)	
		W	D		U	H
PIERS Q2	1/2"	1 1/2"	6"	6 x 3 1/2 x 1/2	3 + 1/4 - 0	3 1/2 ± 3/16
PIER Q6						

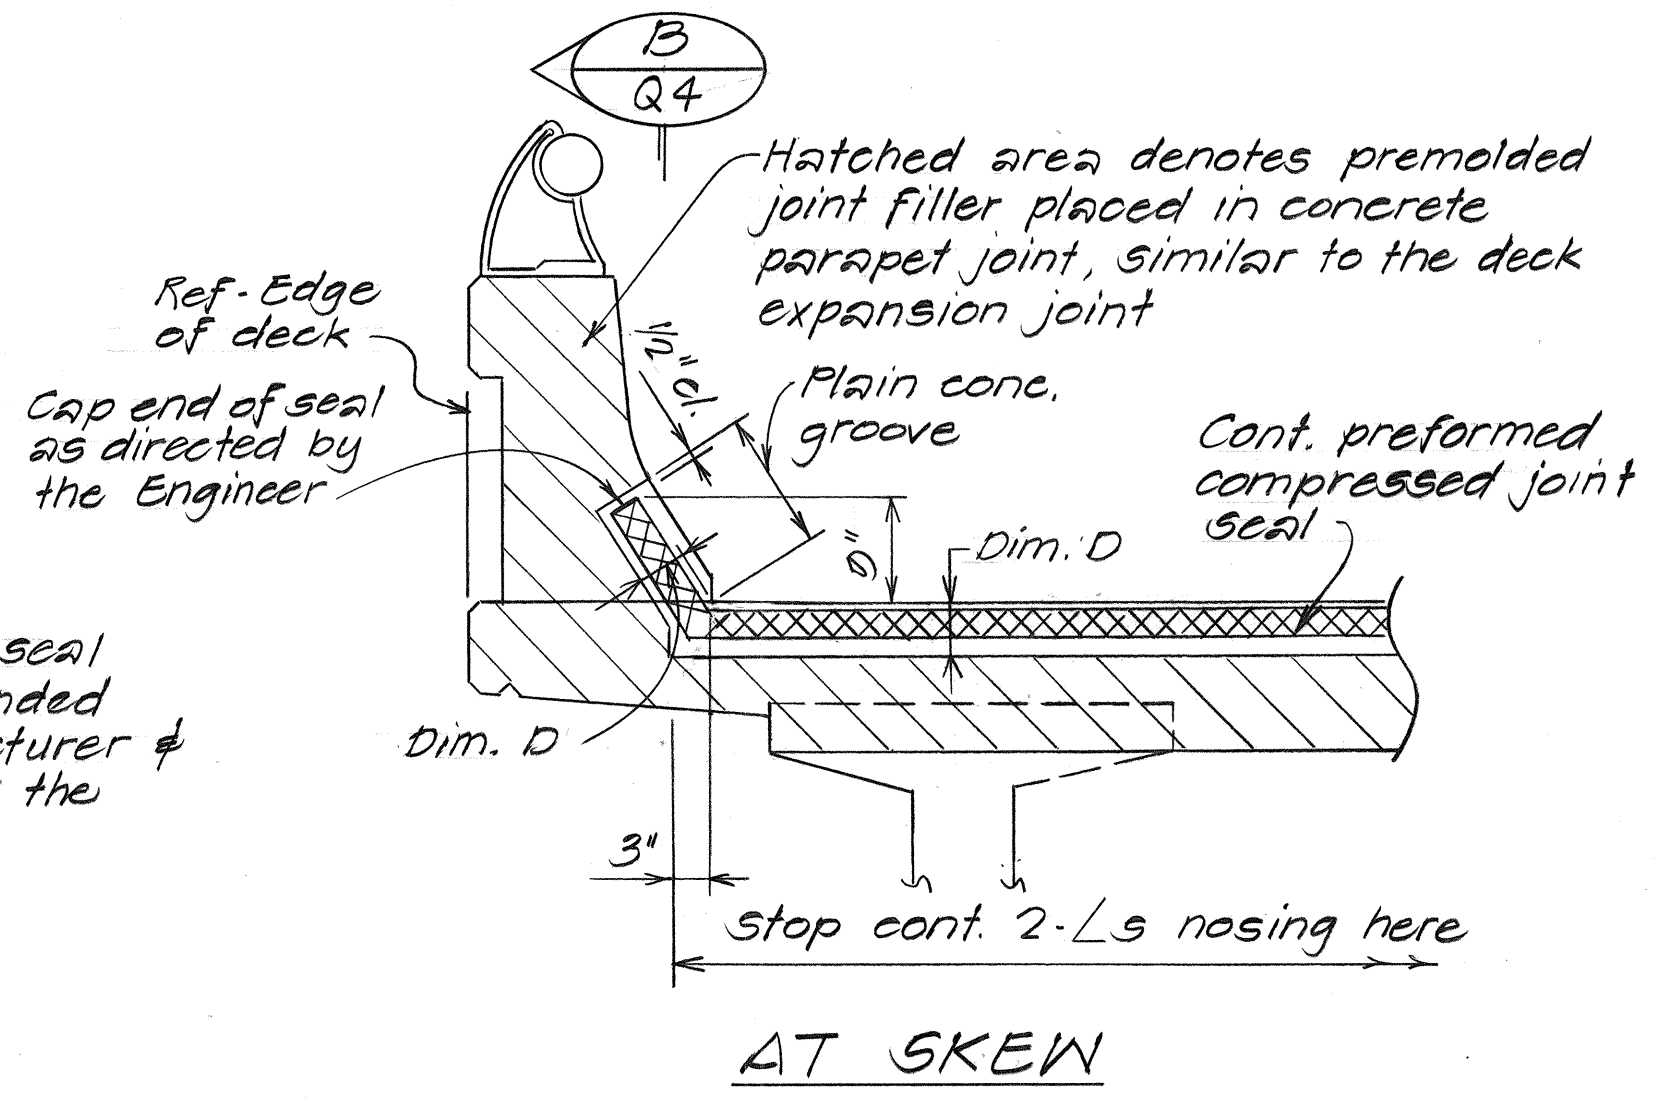


AT SKEW SECTION B Q4 scale: 3/4" = 1'-0"

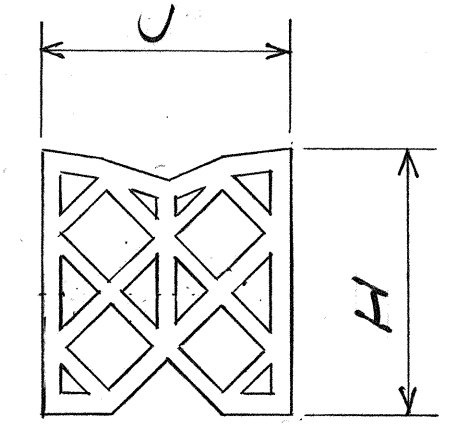

JOINT SEAL

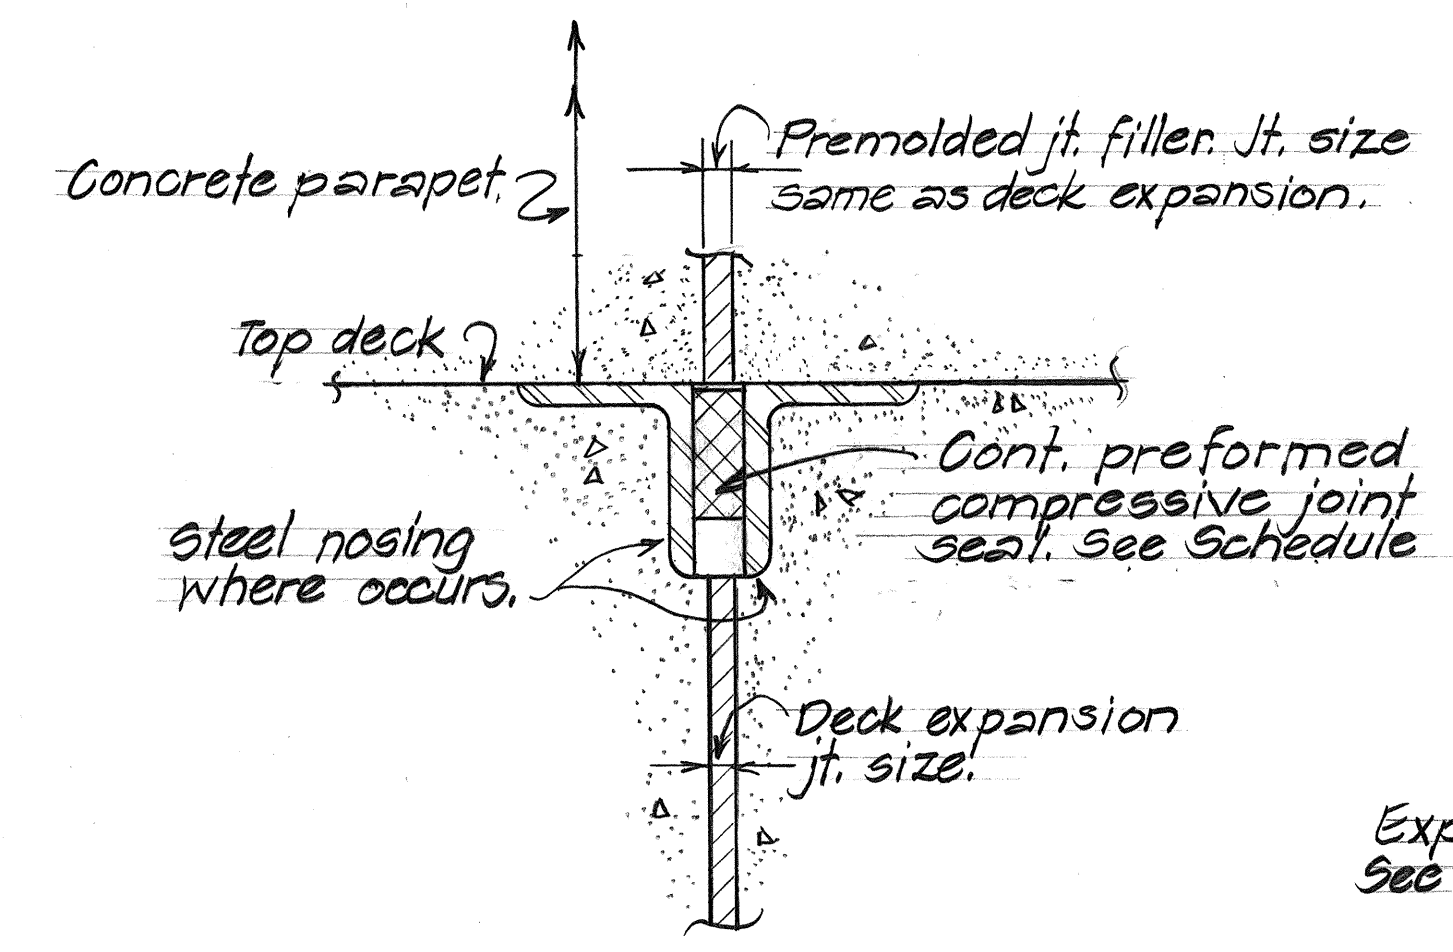


SECTION B Q4 No Scale

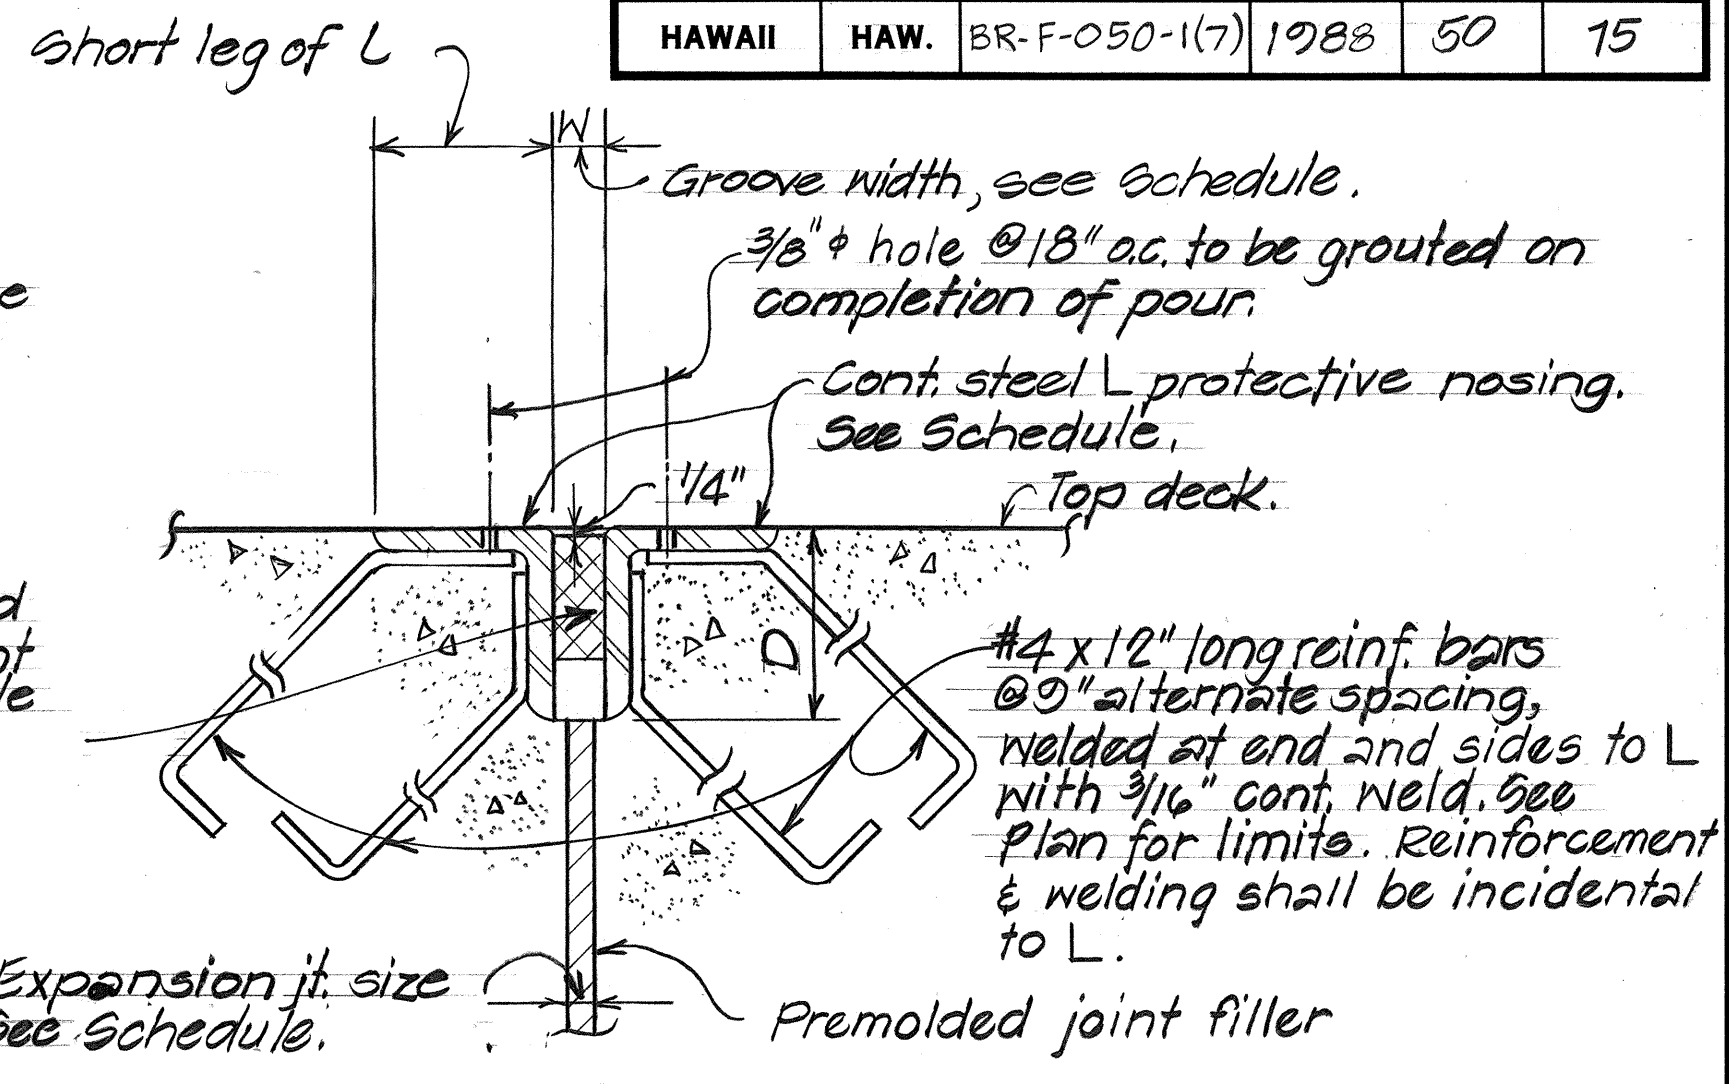

AT STEEL ANGLE PROTECTIVE NOSING SECTION C Q4 Q4 No Scale

- NOTE:
1. Steel angle protective nosing assemblage shall be hot-dipped galvanized after fabrication.
 2. Preformed compressive joint seal and all other components of the protective nosing assemblage, including the steel angles, shall be incidental to concrete & will not be paid for separately.
 3. Preformed compressive seal shall be the structural type used in bridge decks.

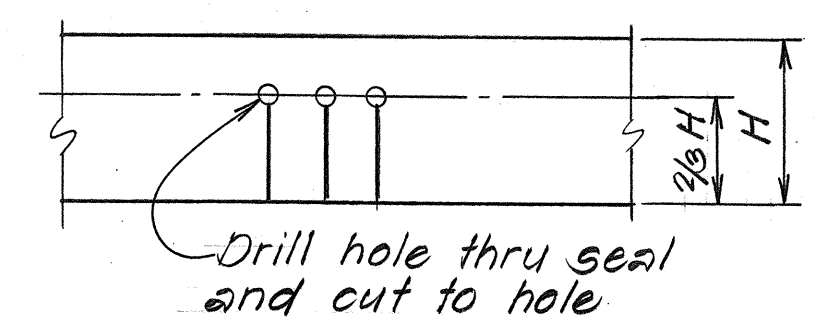


DETAIL OF SEAL AT BEND

TYPICAL TRANSVERSE DECK EXPANSION JOINT DETAIL


NOTE:

Transverse deck construction joint shall be used at these locations. The portion of the pour indicated between construction joints over the pier shall not be poured until the pours for the adjacent positive moment areas have been completed.


Transverse deck construction joints may be eliminated if permitted by the Engineer in writing. If the construction joints are eliminated, water reducing and retarding admixture conforming to AASHTO Designation: M194, Type D, shall be added to the deck concrete over the pier within the indicated lines. The type of the admixture shall be such that the amount of dosage used will produce the retardation required. The type and dosage of the admixture, and the method of pour shall be approved by the Engineer.

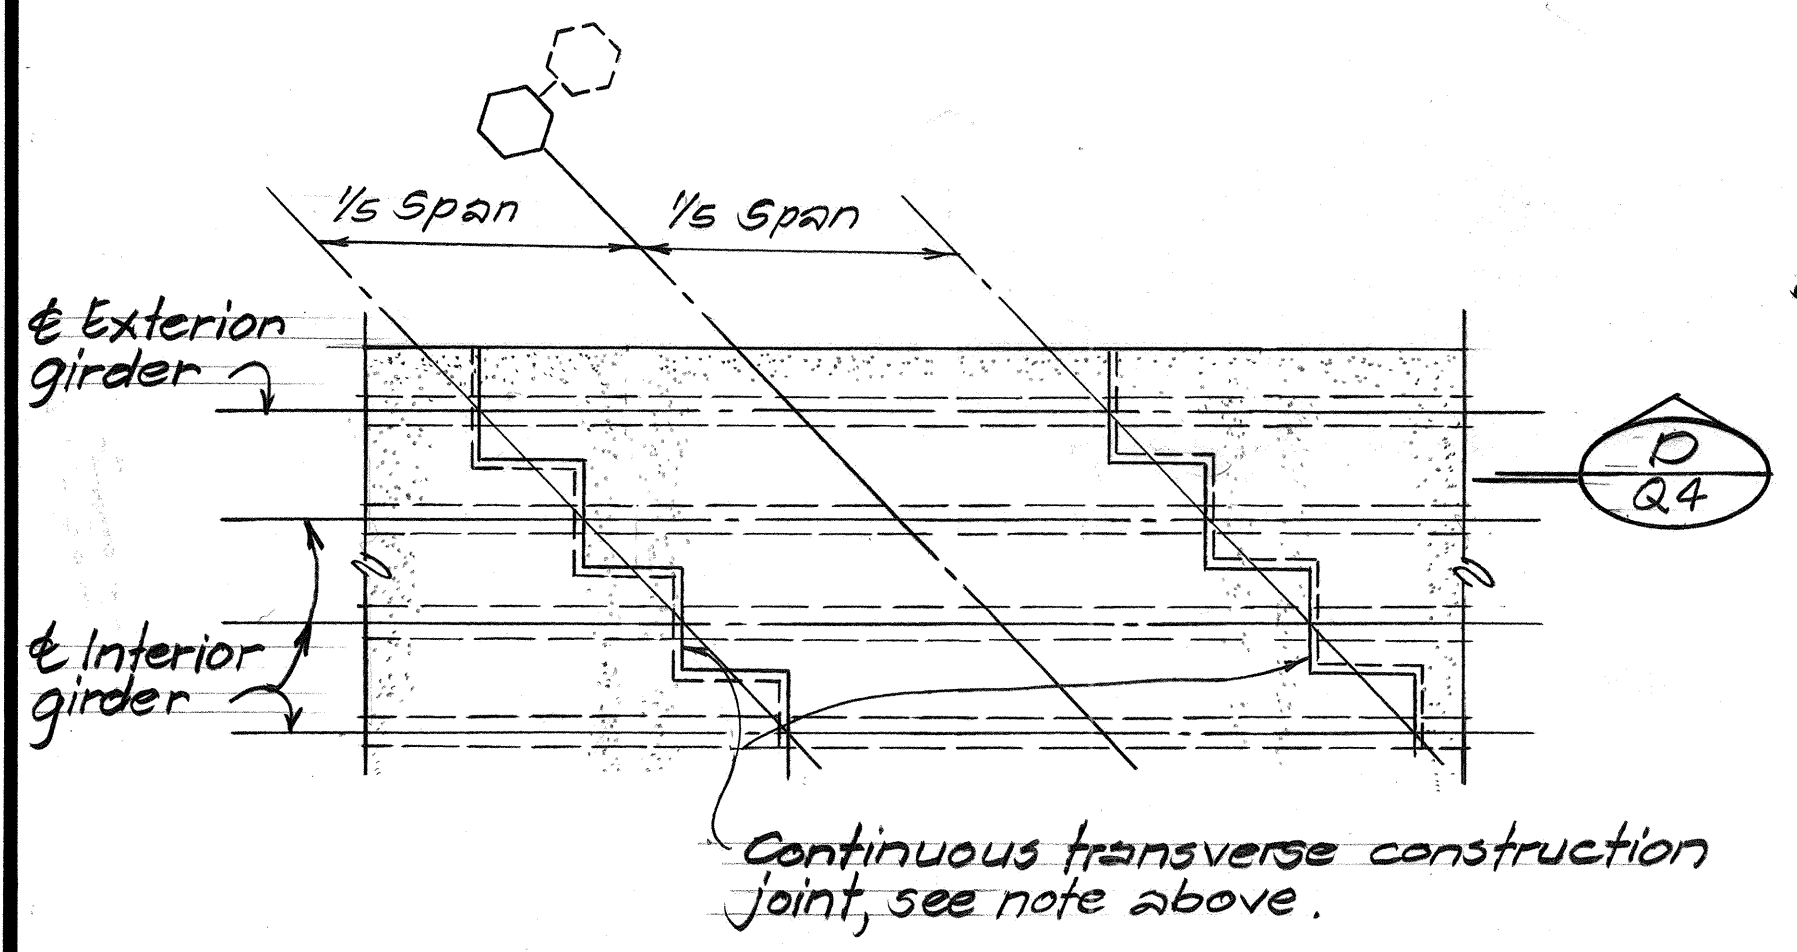

PART PLAN

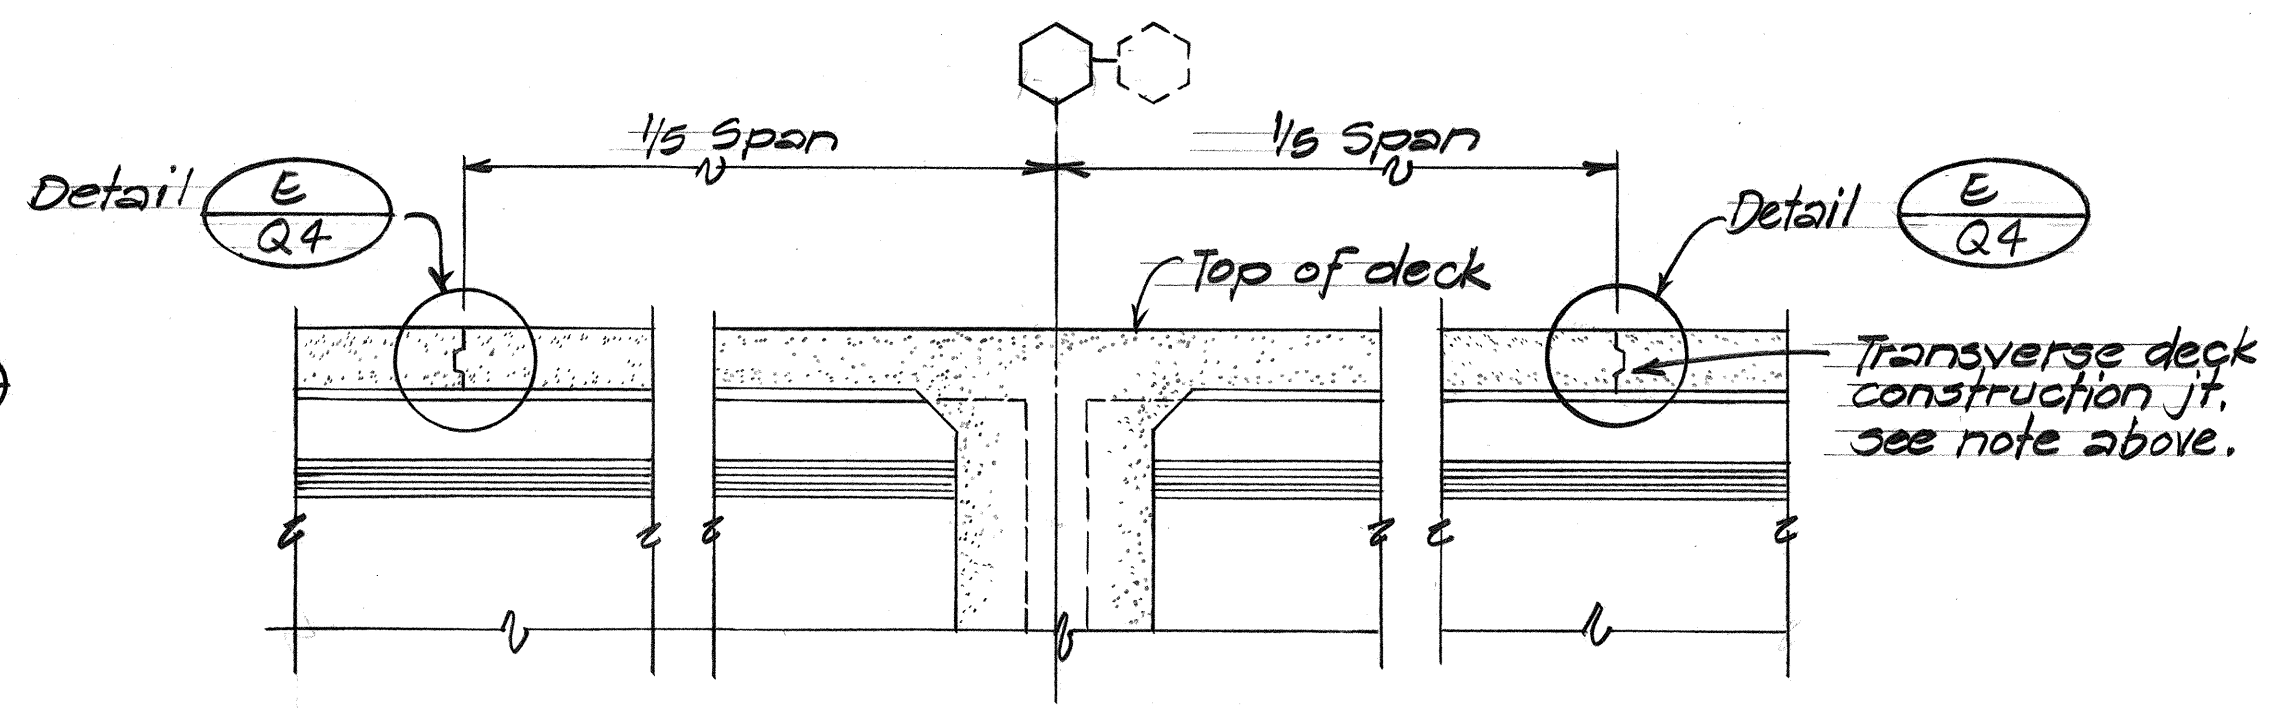

DETAIL D Q4 (CONTINUOUS SLAB OVER PIER) TYPICAL TRANSVERSE DECK CONSTRUCTION JOINT DETAIL

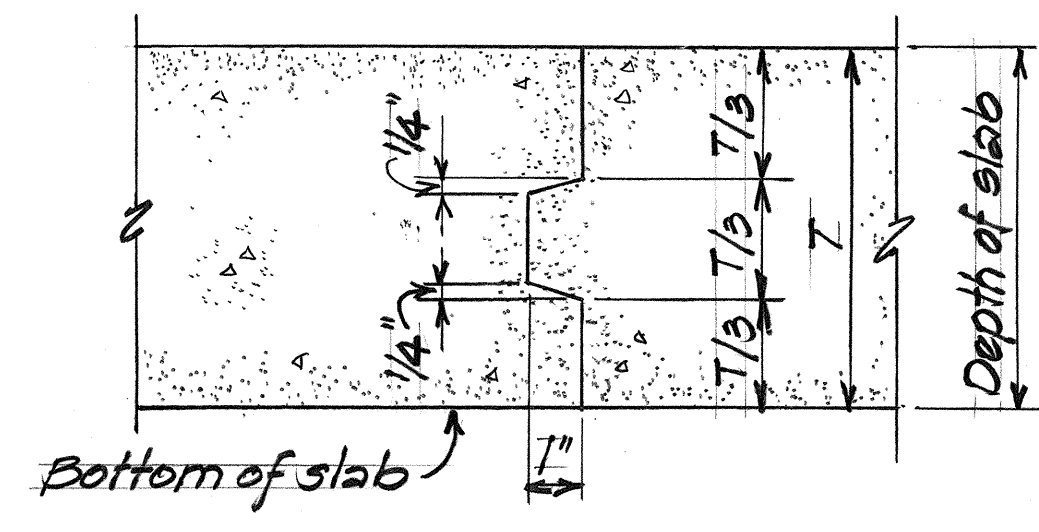

DETAIL E Q4

STATE OF HAWAII
DEPARTMENT OF TRANSPORTATION
HIGHWAYS DIVISION

TYPICAL DETAILS
TRANSVERSE DECK EXPANSION
AND CONSTRUCTION JT. DETAILS
KAUAI HIGHWAY
PROJ. NO. BR-F-050-1(7)
Scale: As Shown Date: Aug. 1987

SHEET NO. Q4 OF 7 SHEETS


DATE	
SURVEY PLOTTED BY	
DRAWN BY	
TRACED BY	
CHECKED BY	
NO.	

END ELEVATION

* Casting to be supplied with a standard scratch brush finish on entire gating rib surface and as indicated by an asterisk (*). Finish shall be approved by the Engineer. Casting to be neatly trimmed and any protruding flash to be broken off. Unless otherwise specified, draft angles to be 3° corner radii to be $\pm \frac{3}{32}"R$, fillet radii to be $\frac{3}{16}"R$, casting tol. to be $\pm \frac{1}{16}"$, wall thickness to be $\pm \frac{1}{32}"$. Dimensions may be as shown or as shown in parenthesis ().

Scale: 3" = 1'-0"


Toggle Bolt - Cadmium plating on steel -
Type NS 0.0005" thick ASTM-A165 (all parts).

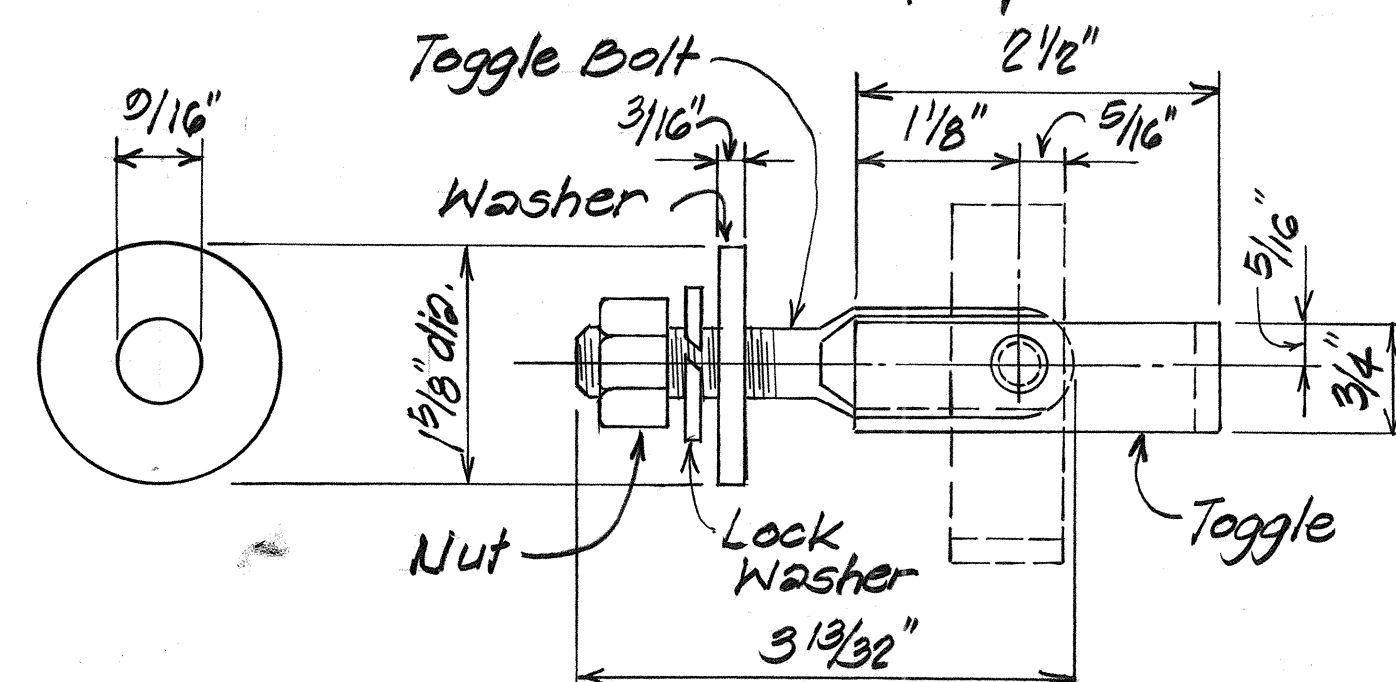

WASHER


SIDE ELEVATION ASSEMBLAGE

Special rivet - material
1038 C.R. steel, heat
treated ASTM A195

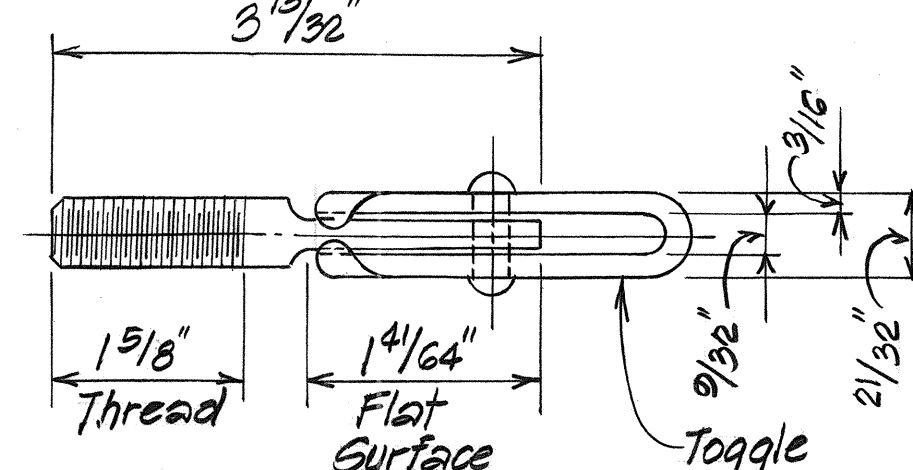


TOP PLAN


1/2" ϕ STEEL TOGGLE BOLT DETAIL

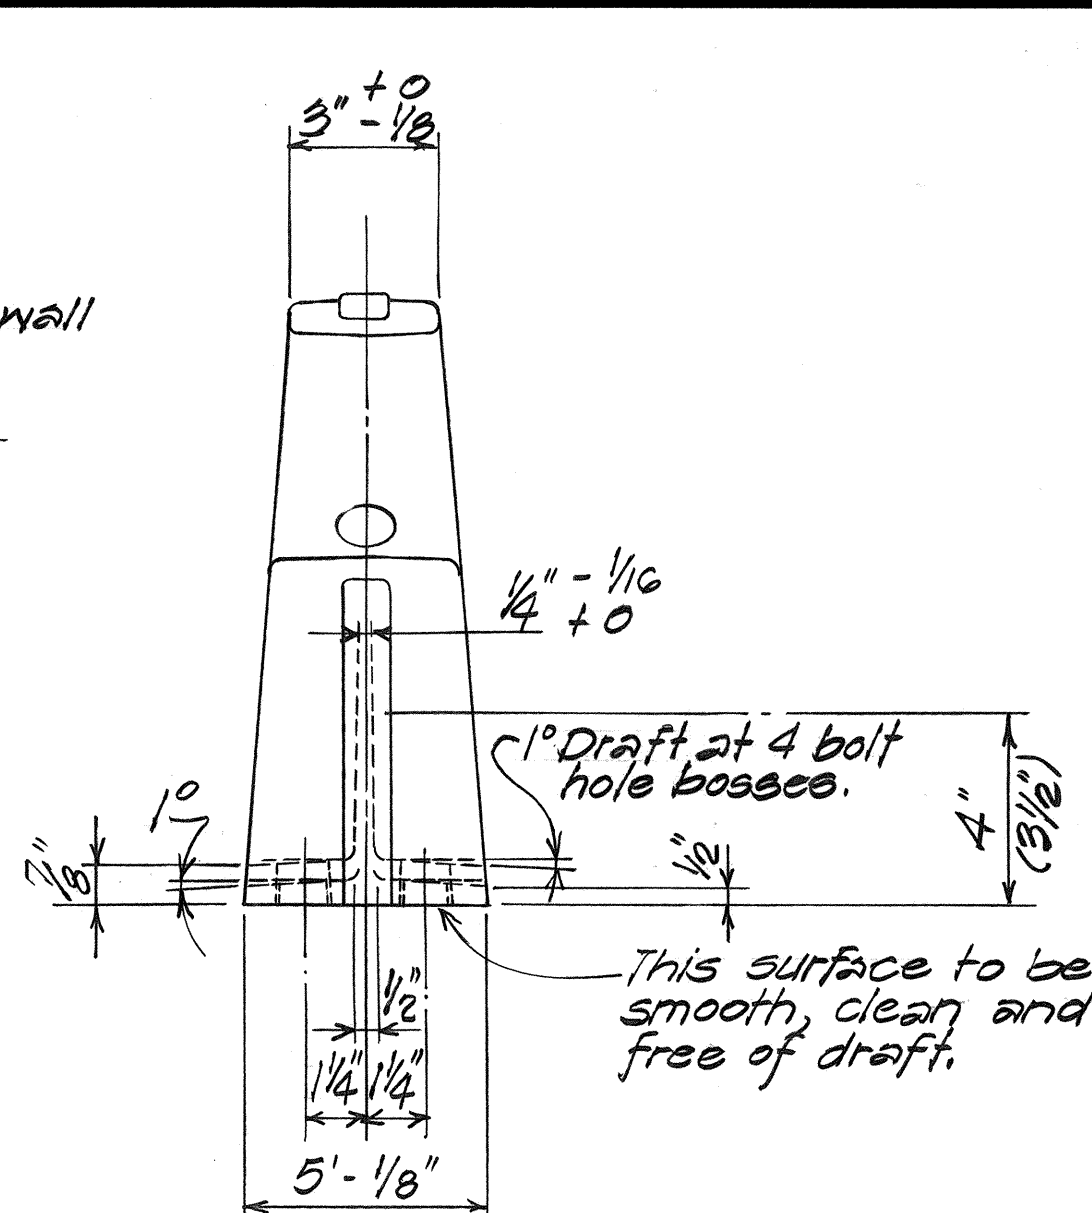


This surface
to be cast
flat.

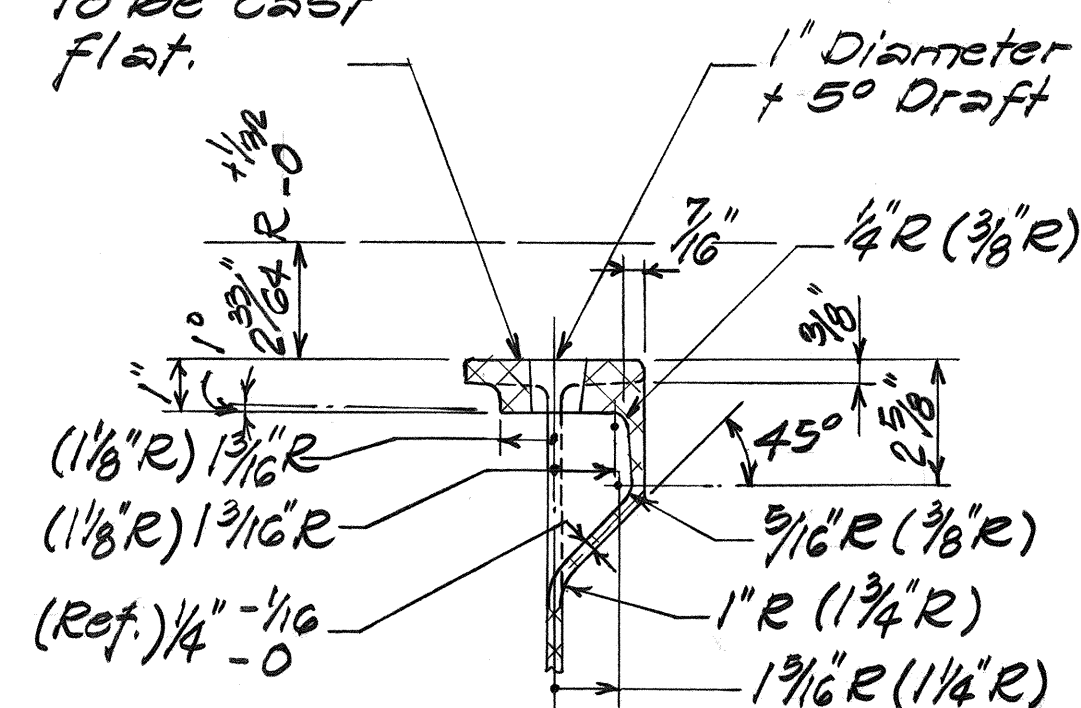

SECTION $\left(\frac{A}{Q6} \right)$

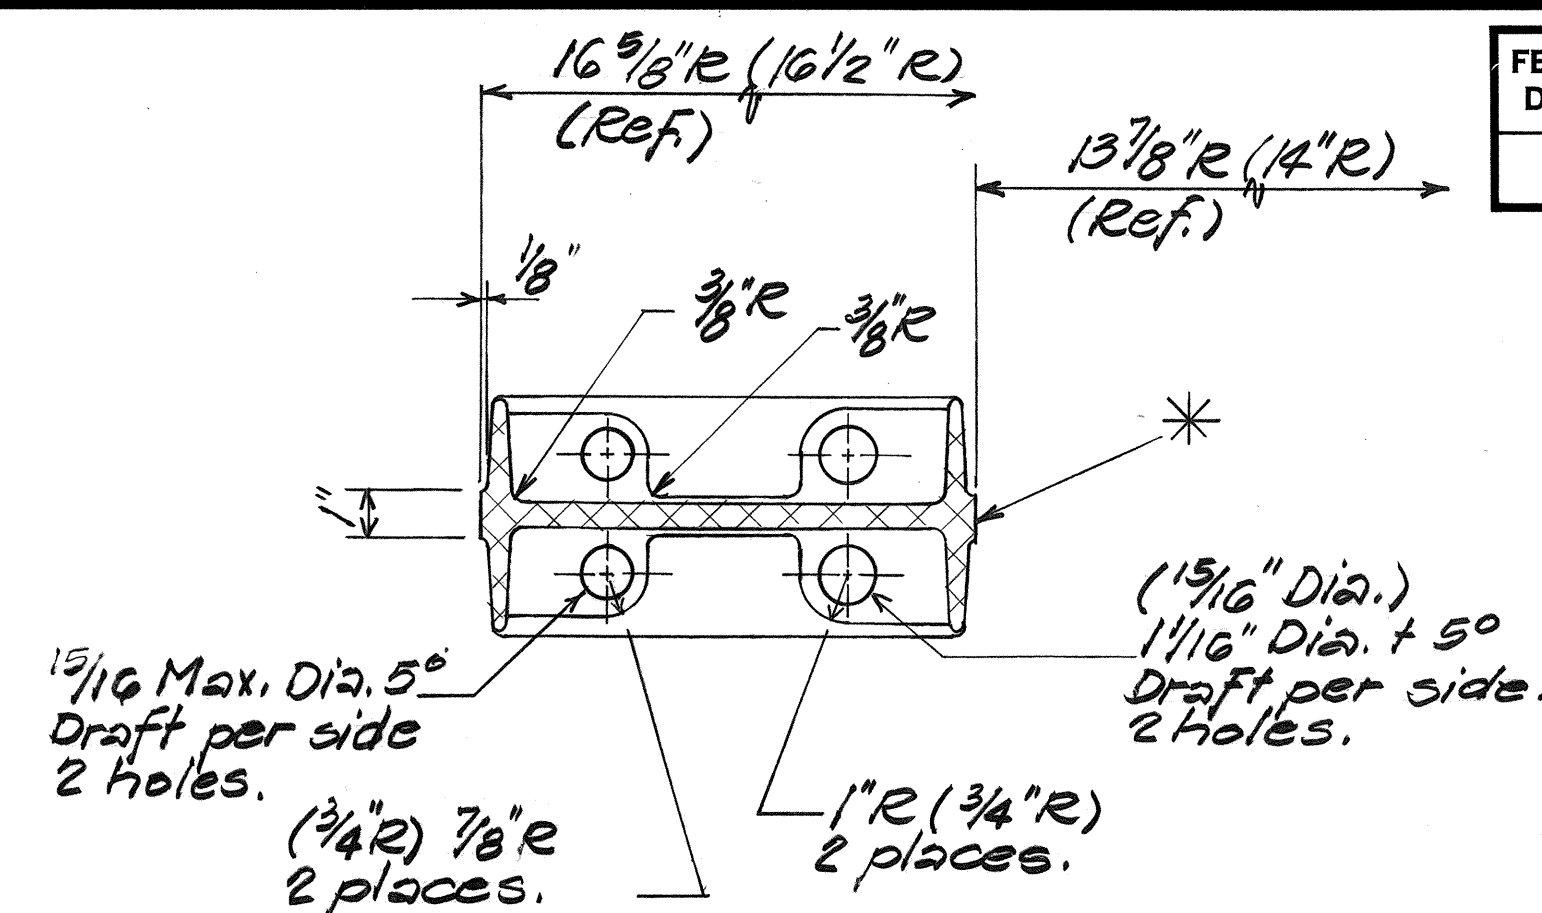


SECTION B
Q6

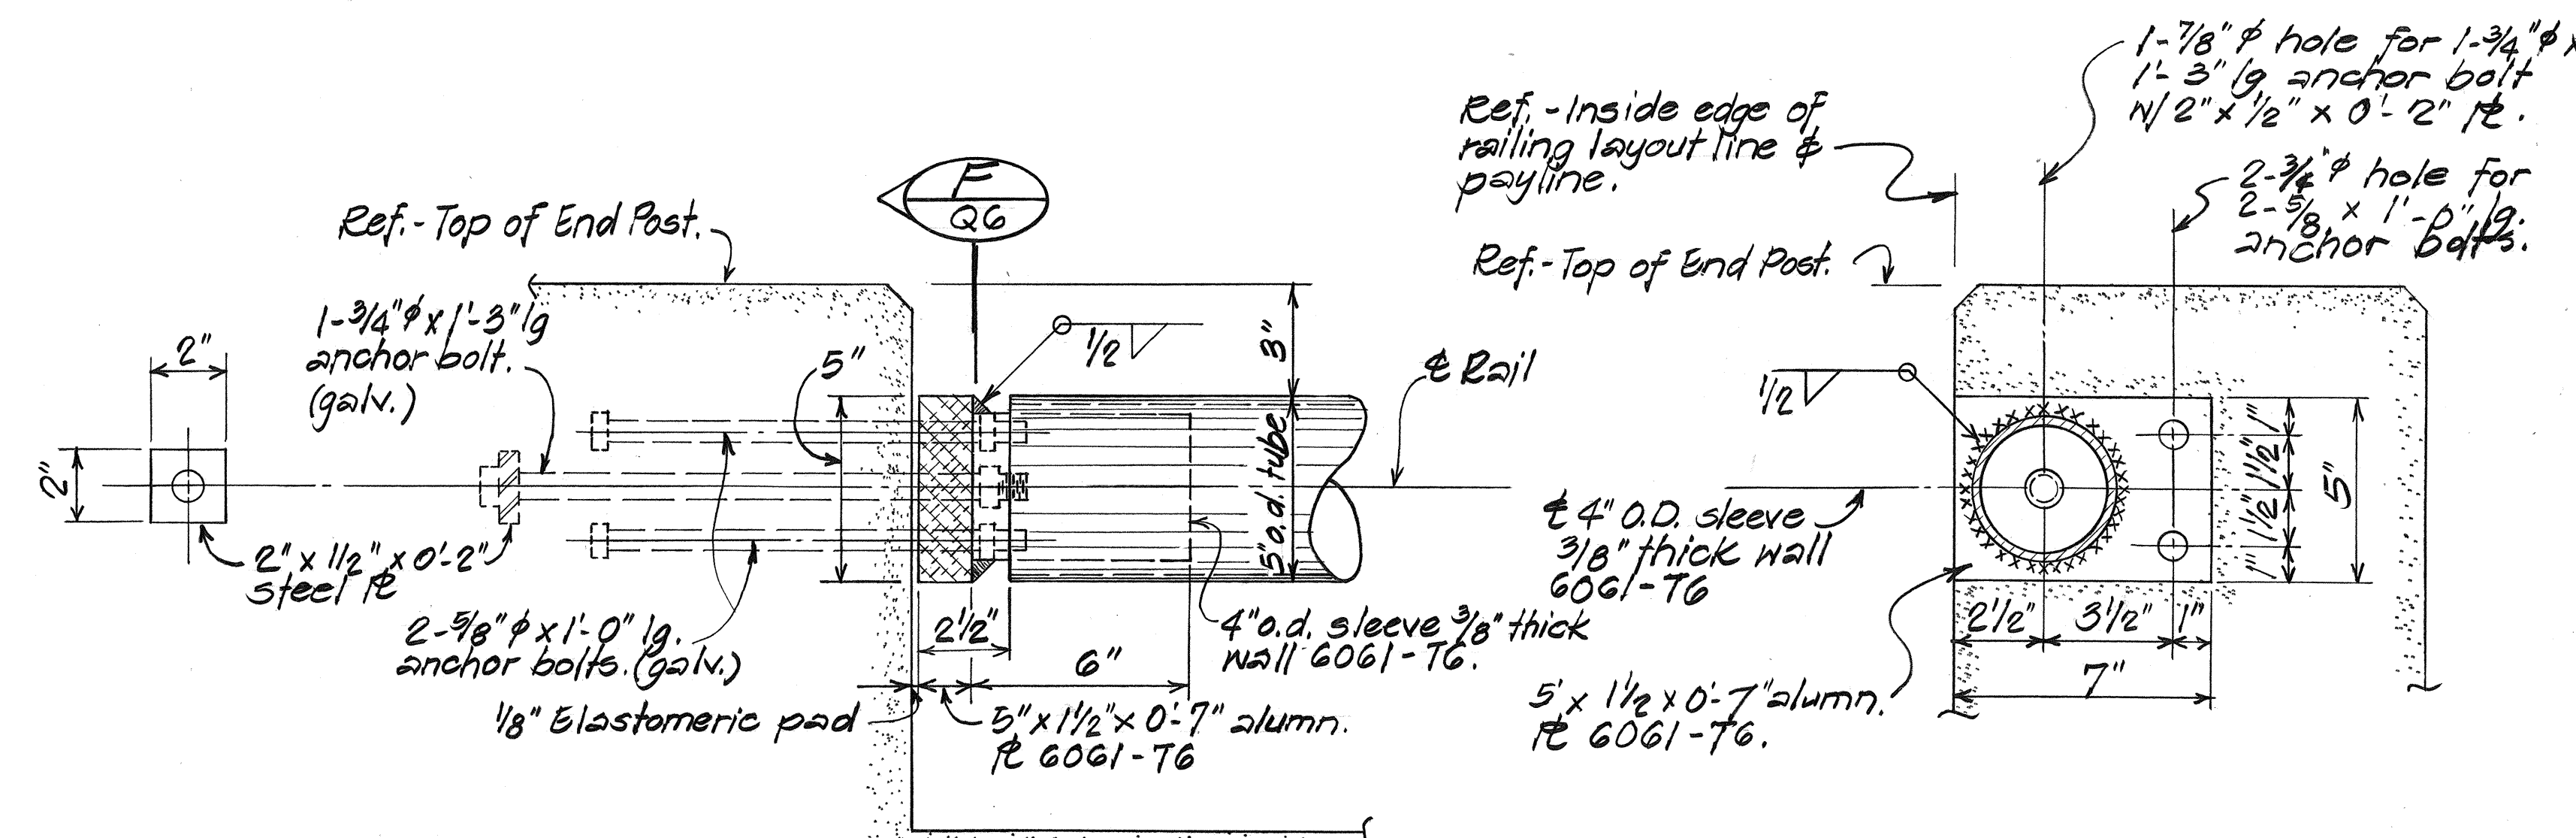SECTION $\frac{C}{Q6}$ 

TYPICAL DETAIL 

METAL RAIL SLEEVE AT END POST

Scale: 3" = 1'-0"

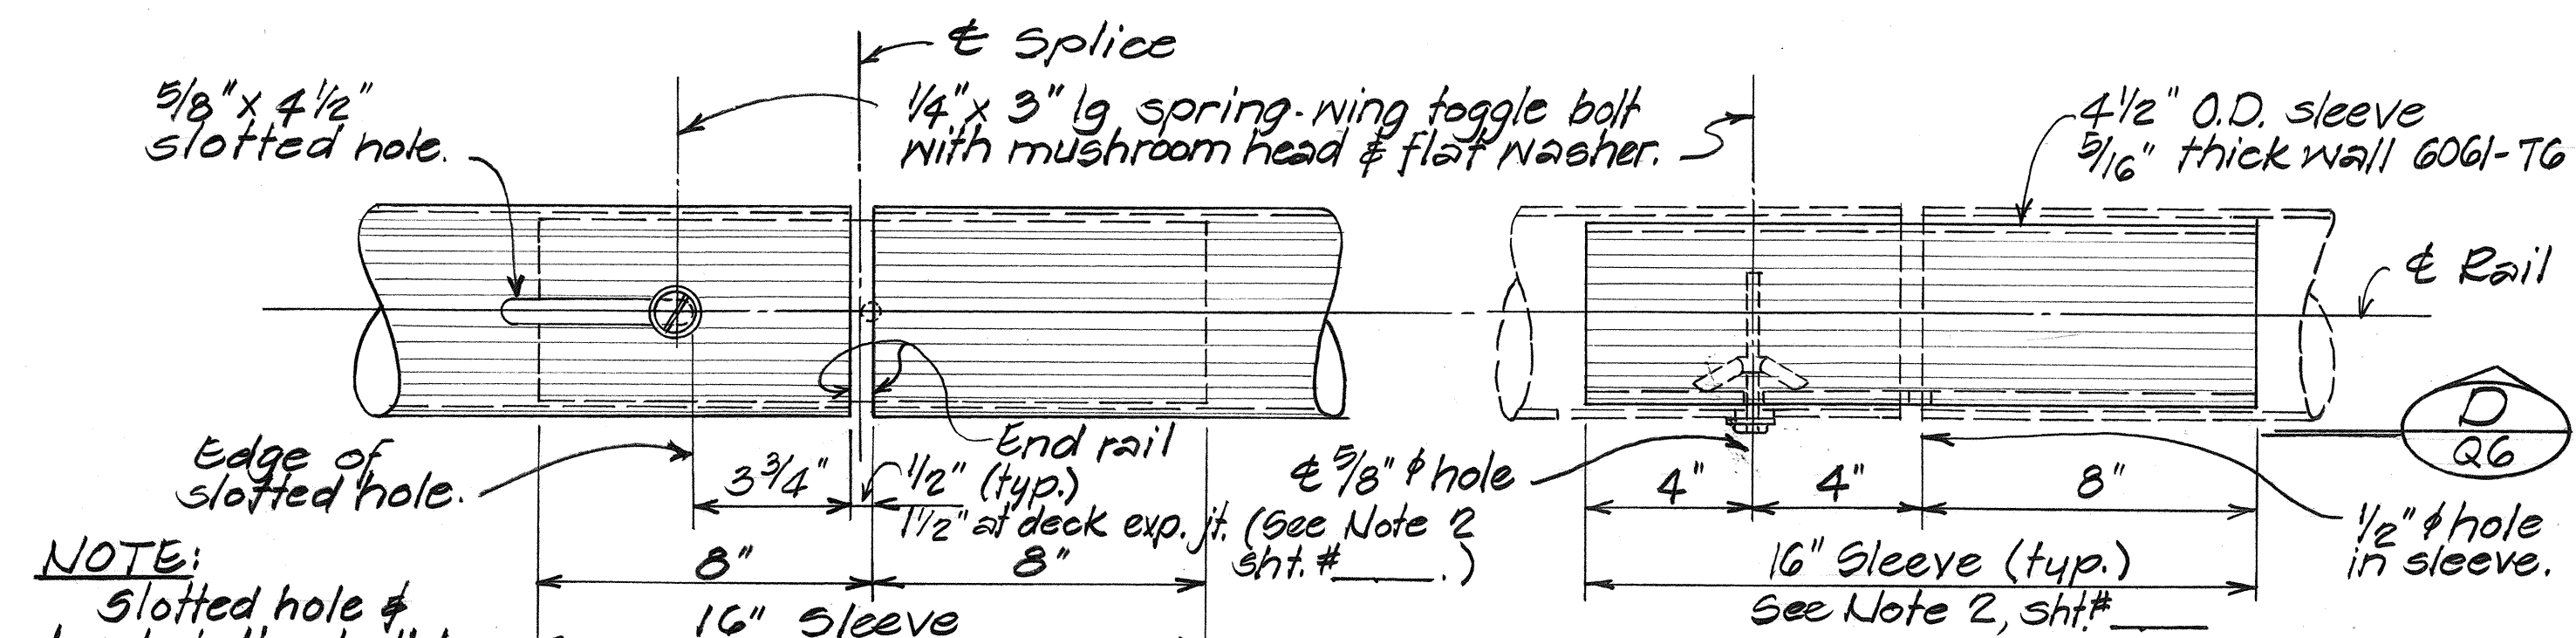


REFLECTED VIEW


TUBE SPLICE DETAIL

Scale: 3" = 1'-0"

Anchor bolts shall be embedded such that the thread are excluded from the shear plane & approximately 2 threads are exposed above the nut.

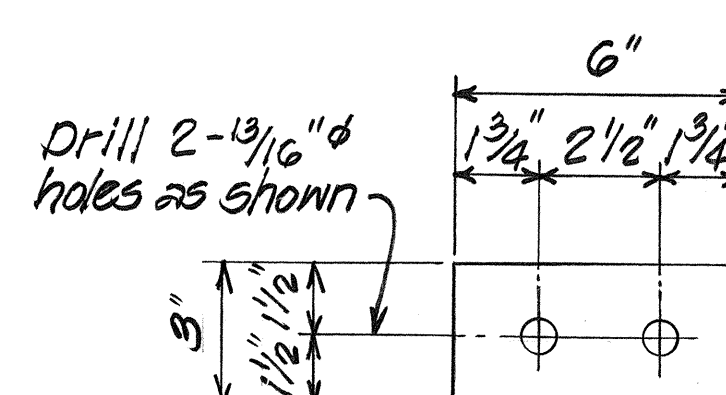

PLAN

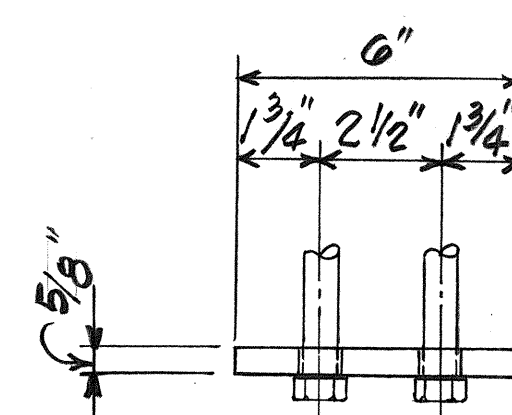

ELEVATION

ANCHOR & DETAIL

ANCHOR BOLT

TYPICAL RAIL POST

STEEL ANCHOR BOLT ASSEMBLY

Scale: 3" = 1'-0"

STATE OF HAWAII
DEPARTMENT OF TRANSPORTATION
HIGHWAYS DIVISION

TYPICAL DETAILS

ALUMINUM BRIDGE RAILING
TYPE - ONE RAIL ON PARAPET
KAUAMUALII HIGHWAY
PROJ. NO. BR-F-050-1(7)


Scale : As Shown Date: Aug. 1987

SHEET NO. 06 OF 7 SHEETS

Still Anchor Bolt Assembly $n = 2-38 \text{ 21}$
Slip 3-1

$\pm 1 - 3/4"$ hole for $5/8"$ ϕ x $1' - 0"$ lg.
 H.S. anchor bolt w/ cap fl. washer
 ϕ nut / Rail. See "Terminal
 Connector" Det. for exact loc.

$\pm 4 - 1"$ ϕ holes for $7/8"$ ϕ x $1' - 0"$ lg. H.S.
 anchor bolt w/ cap fl. washer ϕ nut / Rail
 See "Terminal Connector" Det. for exact
 loc., no.s. & size.

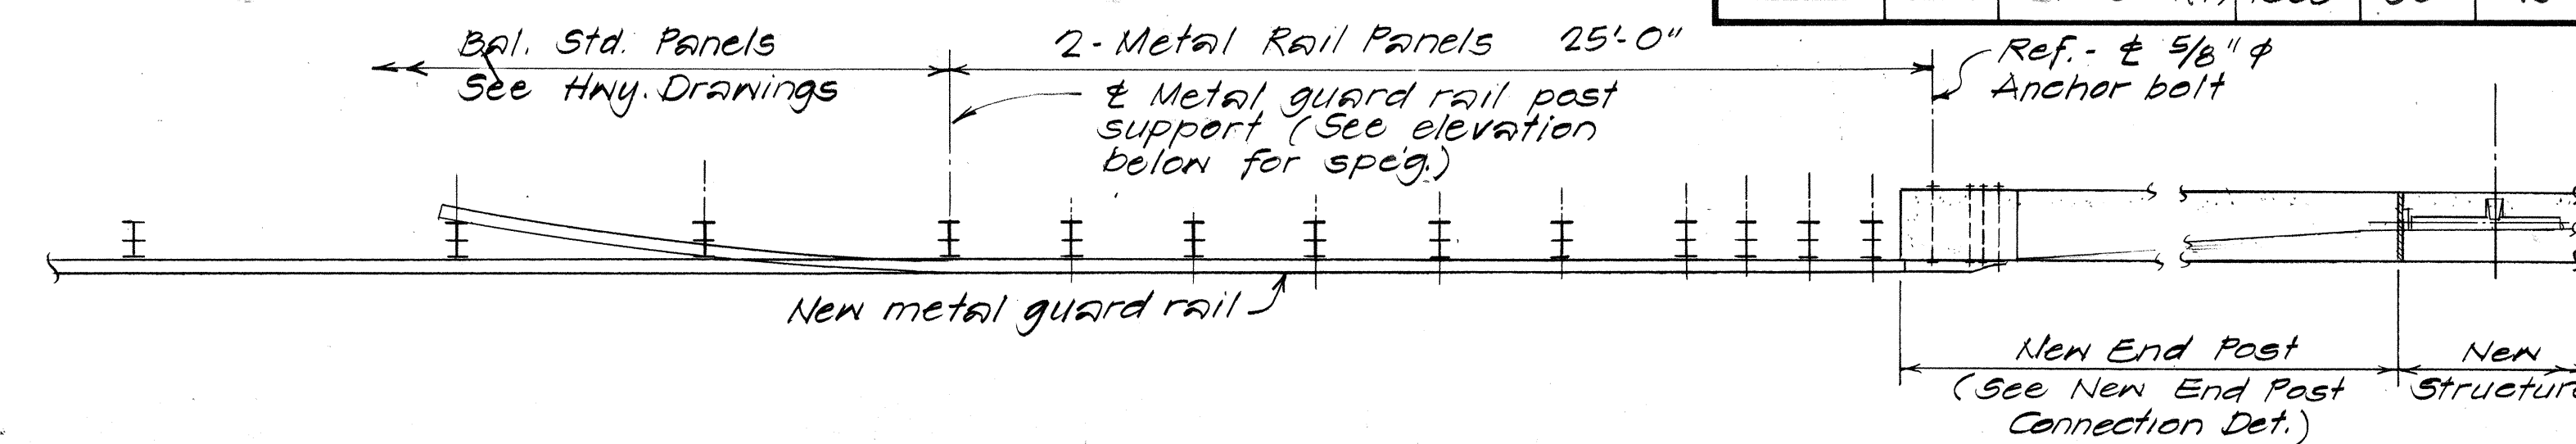

PLAN

L = See Schedule

New End Post

3'-0"

2'-6"

2"

Terminal Connector

4-1" ϕ holes for 7/8" ϕ anchor bolts/rn see PLAN above W.P. "A"

90°

2'-0"

10"

"A"

Ref. Fin. gr.

A Q7

B Q7

See "Typ. Metal Guard Rail Layout at New End Post"

Ref. End of conc. End Post

Metal Guard Rail

See "Typ. Metal Guard Rail Layout at New End Post"

Lap in direction of traffic

± Metal guard rail

± Rub rail

Bal. - Std. Panels
 See Htly Drawing

1-Std. Panel (Single)

1-Std. Panel (Double)

2-Std. Metal Guard Rail Panels (Single)

6 - spcs. @ 3'-1 1/2" = 18'-0"

4 spcs. @ 1'-6 3/4" = 6'-3"

Metal Guard Rail

Rub Rail

Guard Rail Post Support

Ref. - 1/2" x 3/8" anchor bolt

± Metal guard rail support

± Metal guard rails

± Rub rail

Ref. - Fin gr.

New End Post
 (See New End Post Connection Det.)

New Structure


ELEVATION

TYPICAL METAL GUARD RAIL LAYOUT AT NEW END POST

Scale: $\frac{1}{4}" = 1'-0"$

1. All anchor bolts shall be high strength bolts conforming to the requirements of ASTM A325 & Galv.
2. "Terminal Connector" including anchor bolts, nuts and washers, shall be galvanized.
3. "Terminal Connector" shall be fabricated from 10 gauge steel conforming to the requirements of AASHTO M180.
4. First 25'-0" of guard rail and rub rail adjoining "Terminal Connector" shall be galvanized steel.
5. Place name & date of structure as shown. For location, see "Layout Plan" on contract drawing. Date will be year structure is completed. For letter size and detail see Standard Plans B-01.


ELEVATION

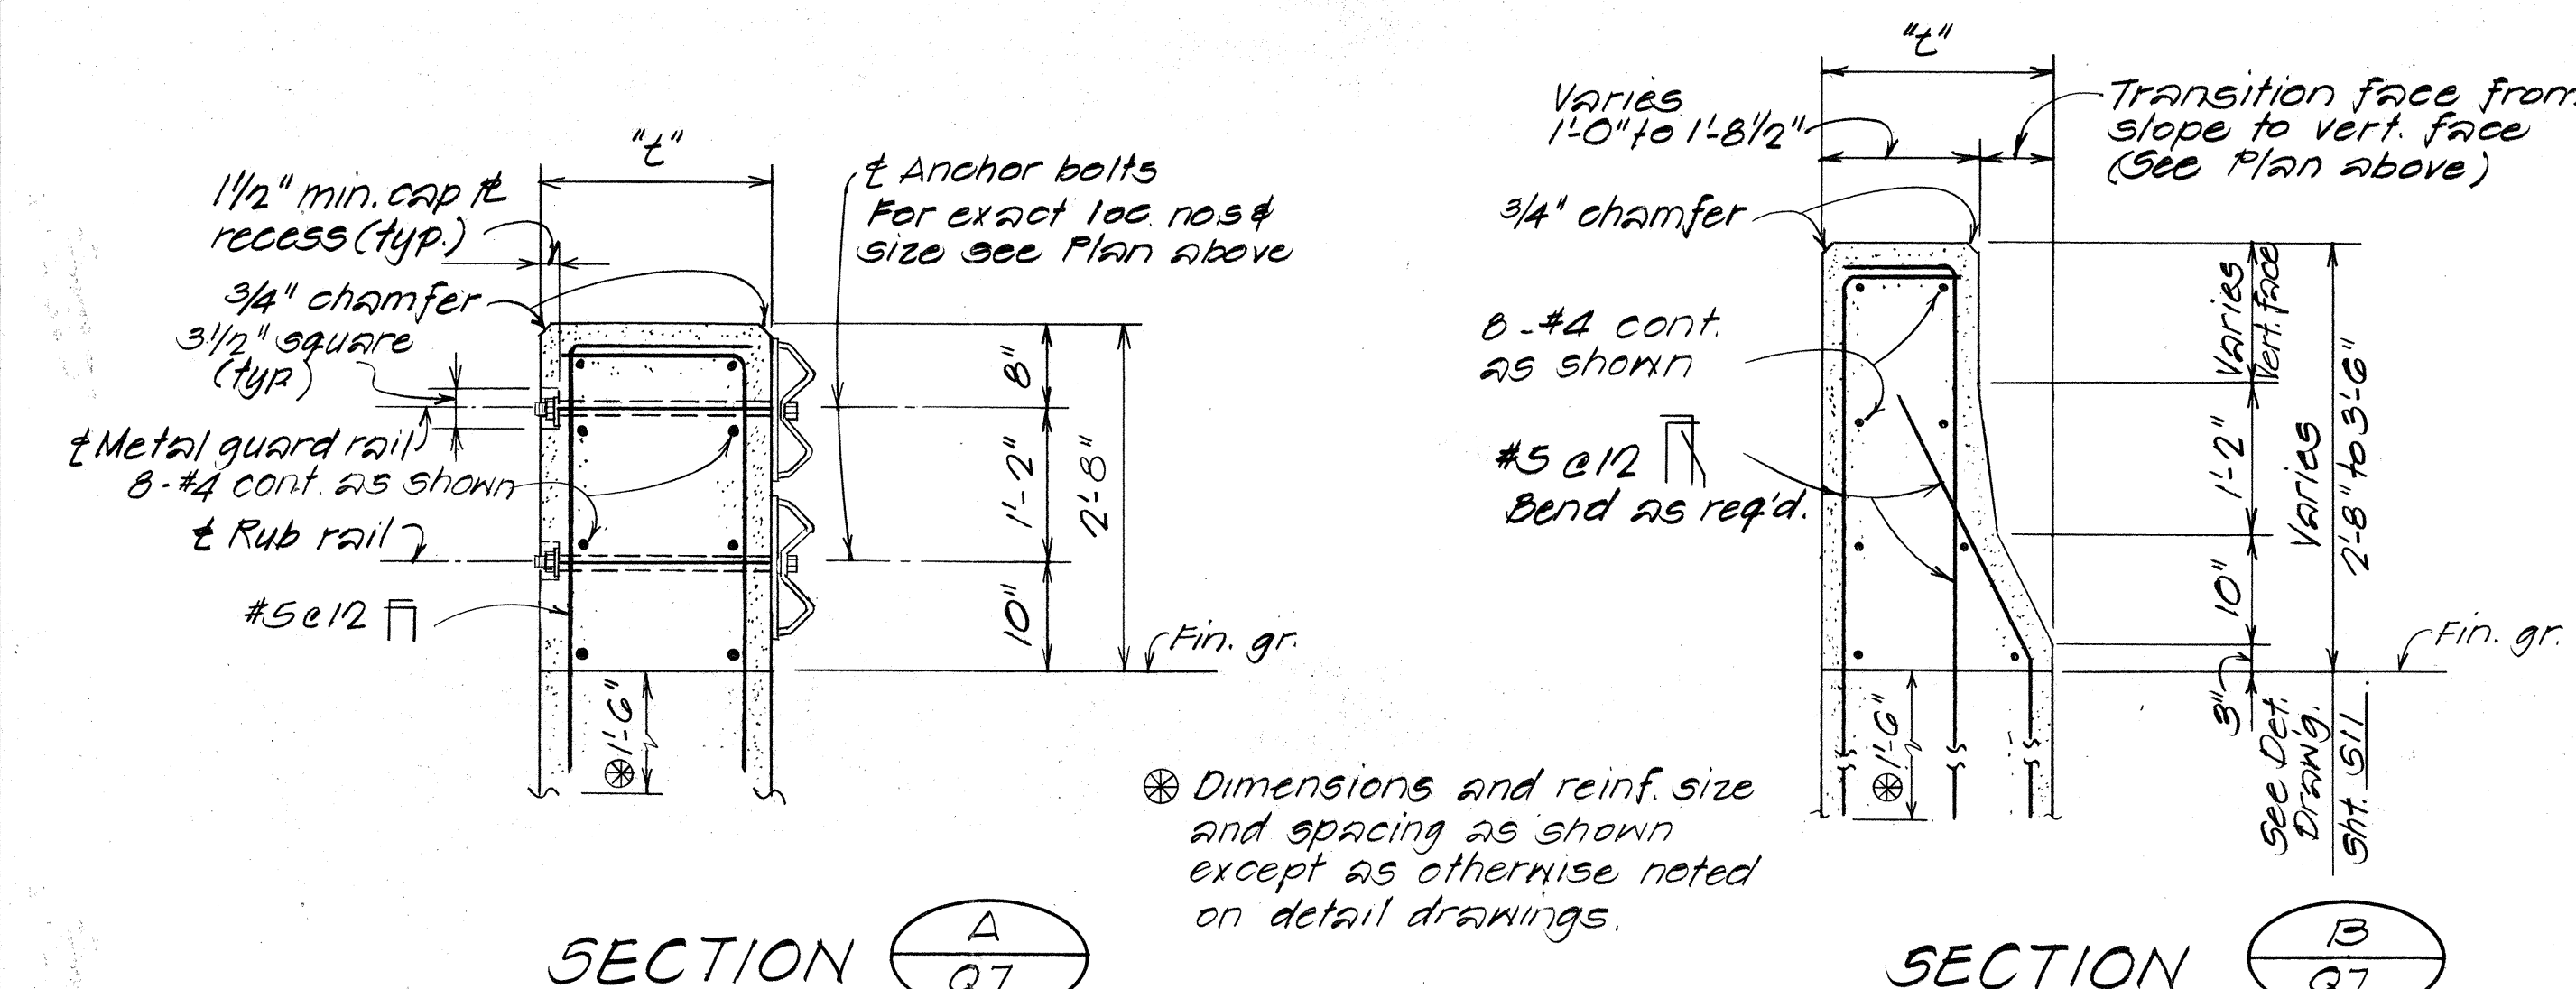SECTION SECTION


B
Q7

TYPICAL END POST CONNECTION DETAIL

Scale: $3/4" = 1'-0"$

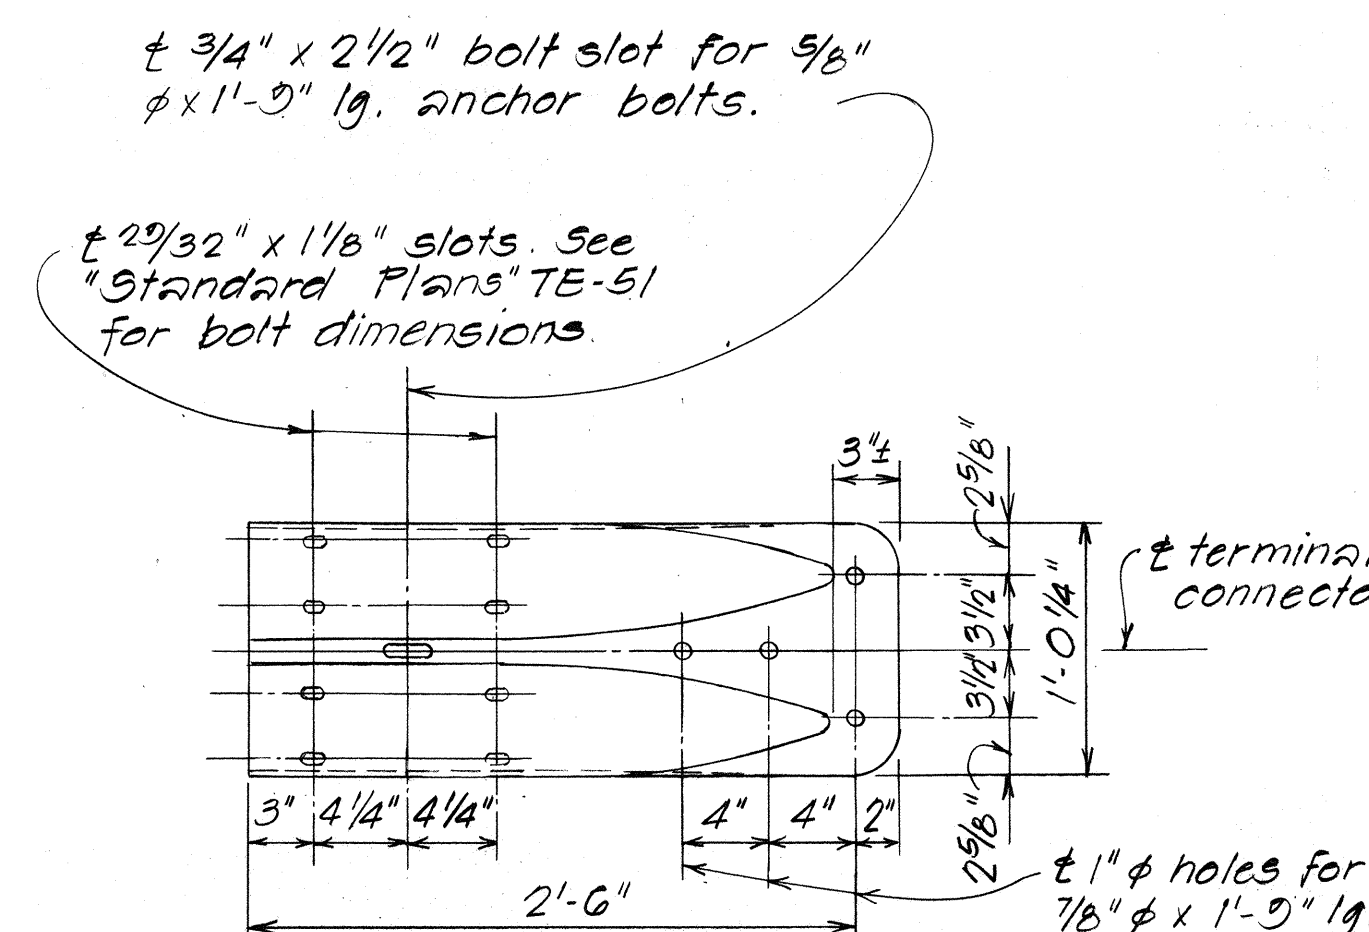

TERMINAL CONNECTOR DETAIL N.T.S

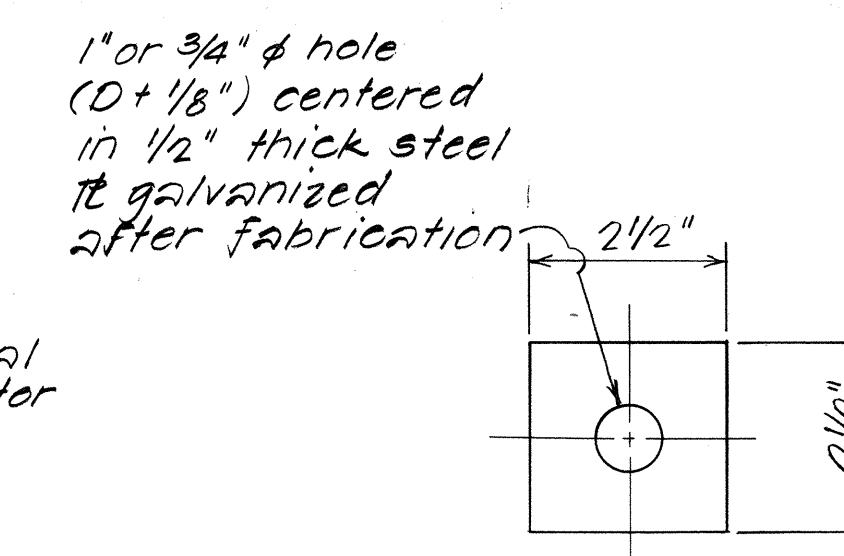

TYPICAL CAP #

DETAIL

N. T. S.

TYPICAL DETAILS
METAL GUARD RAIL CONNECTION
AT CONCRETE END POST

PROJ. NO. BR-F-050-1(7)

Scale: As Shown Date: Aug. 1987

SHEET No. 07 OF 7 SHEETS