


ORIGINAL	SURVEYED	DATE
SURVEY	BY	
NOTE BOOK	NO.	
AREAS CHECKED		


FINAL	SURVEYED	DATE
SURVEY	BY	
NOTE BOOK	NO.	
AREAS CHECKED		

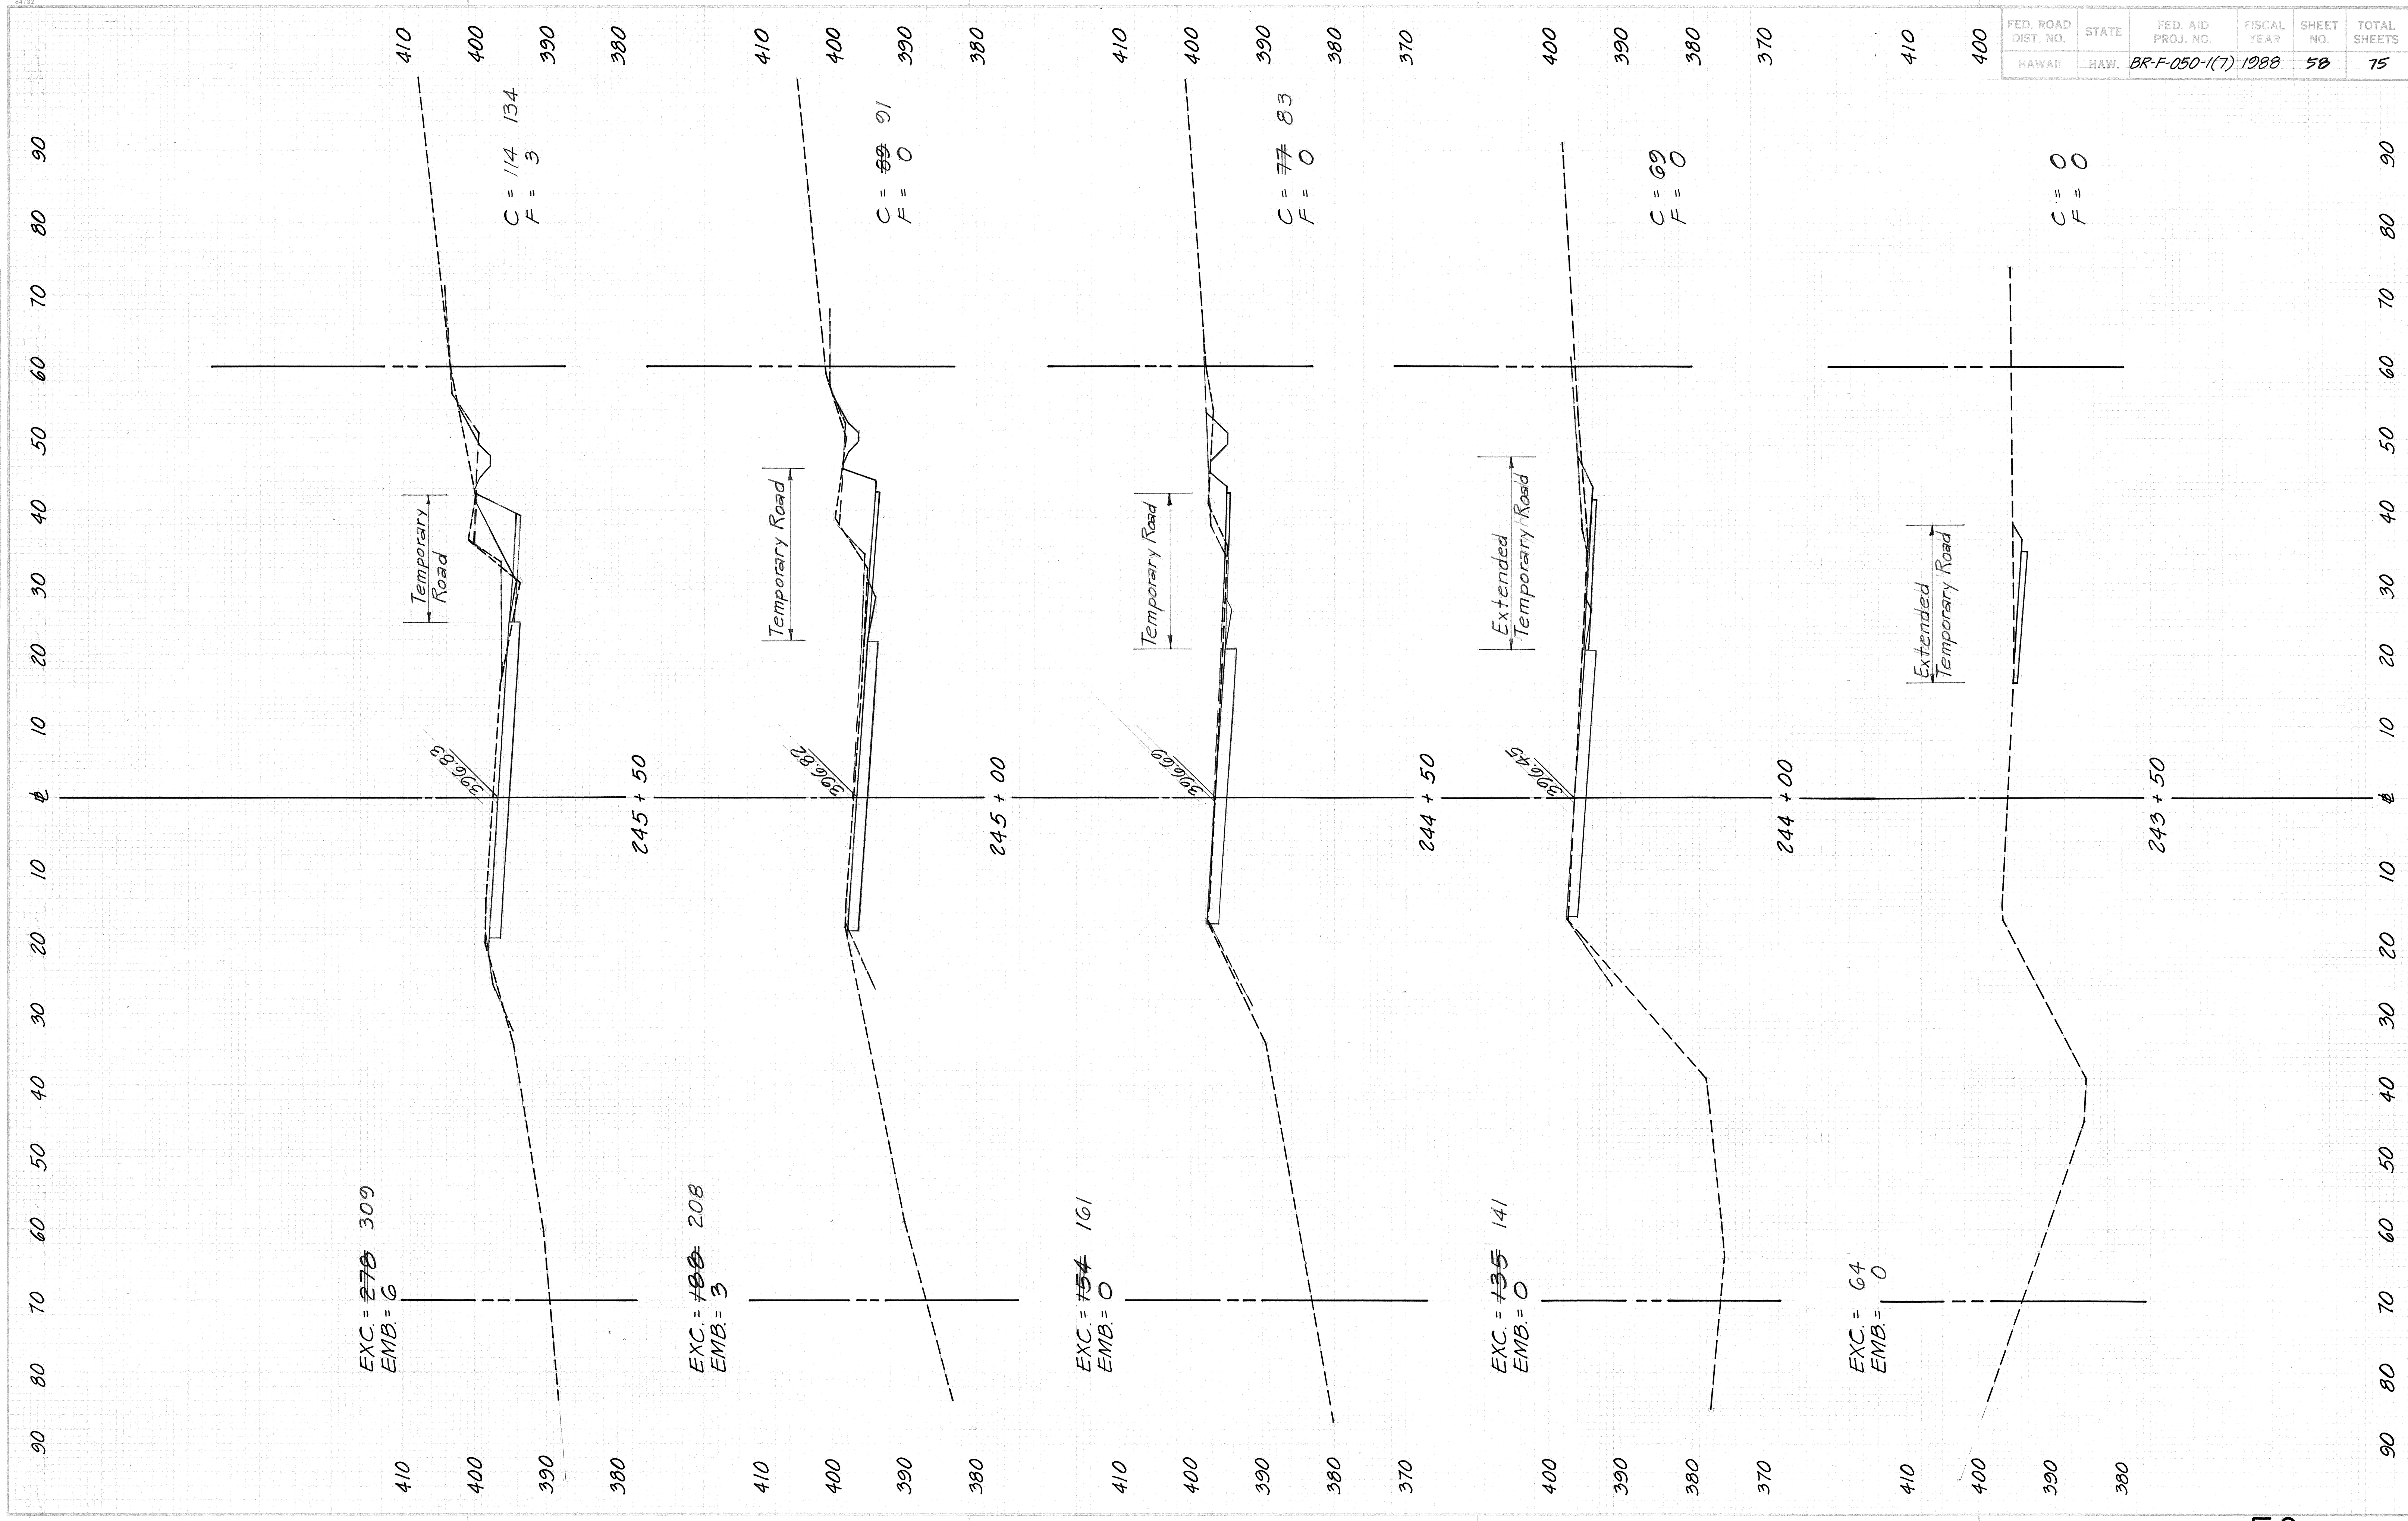

FED. ROAD DIST. NO.	STATE	FED. AID PROJ. NO.	FISCAL YEAR	SHEET NO.	TOTAL SHEETS
HAWAII	HAW.	BR-F-050-1(7)	1988	58	75


ORIGINAL			BY		DATE
SURVEY	SURVEYED				
	PLOTTED				
NOTE BOOK	TEMPLATE				
	AREAS				
NO.	AREAS CHECKED				

FINAL SURVEY	SURVEYED	BY	DATE
NOTE BOOK	PLOTTED		
	TEMPLATE		
	AREAS		
Nº	AREAS OPENED		

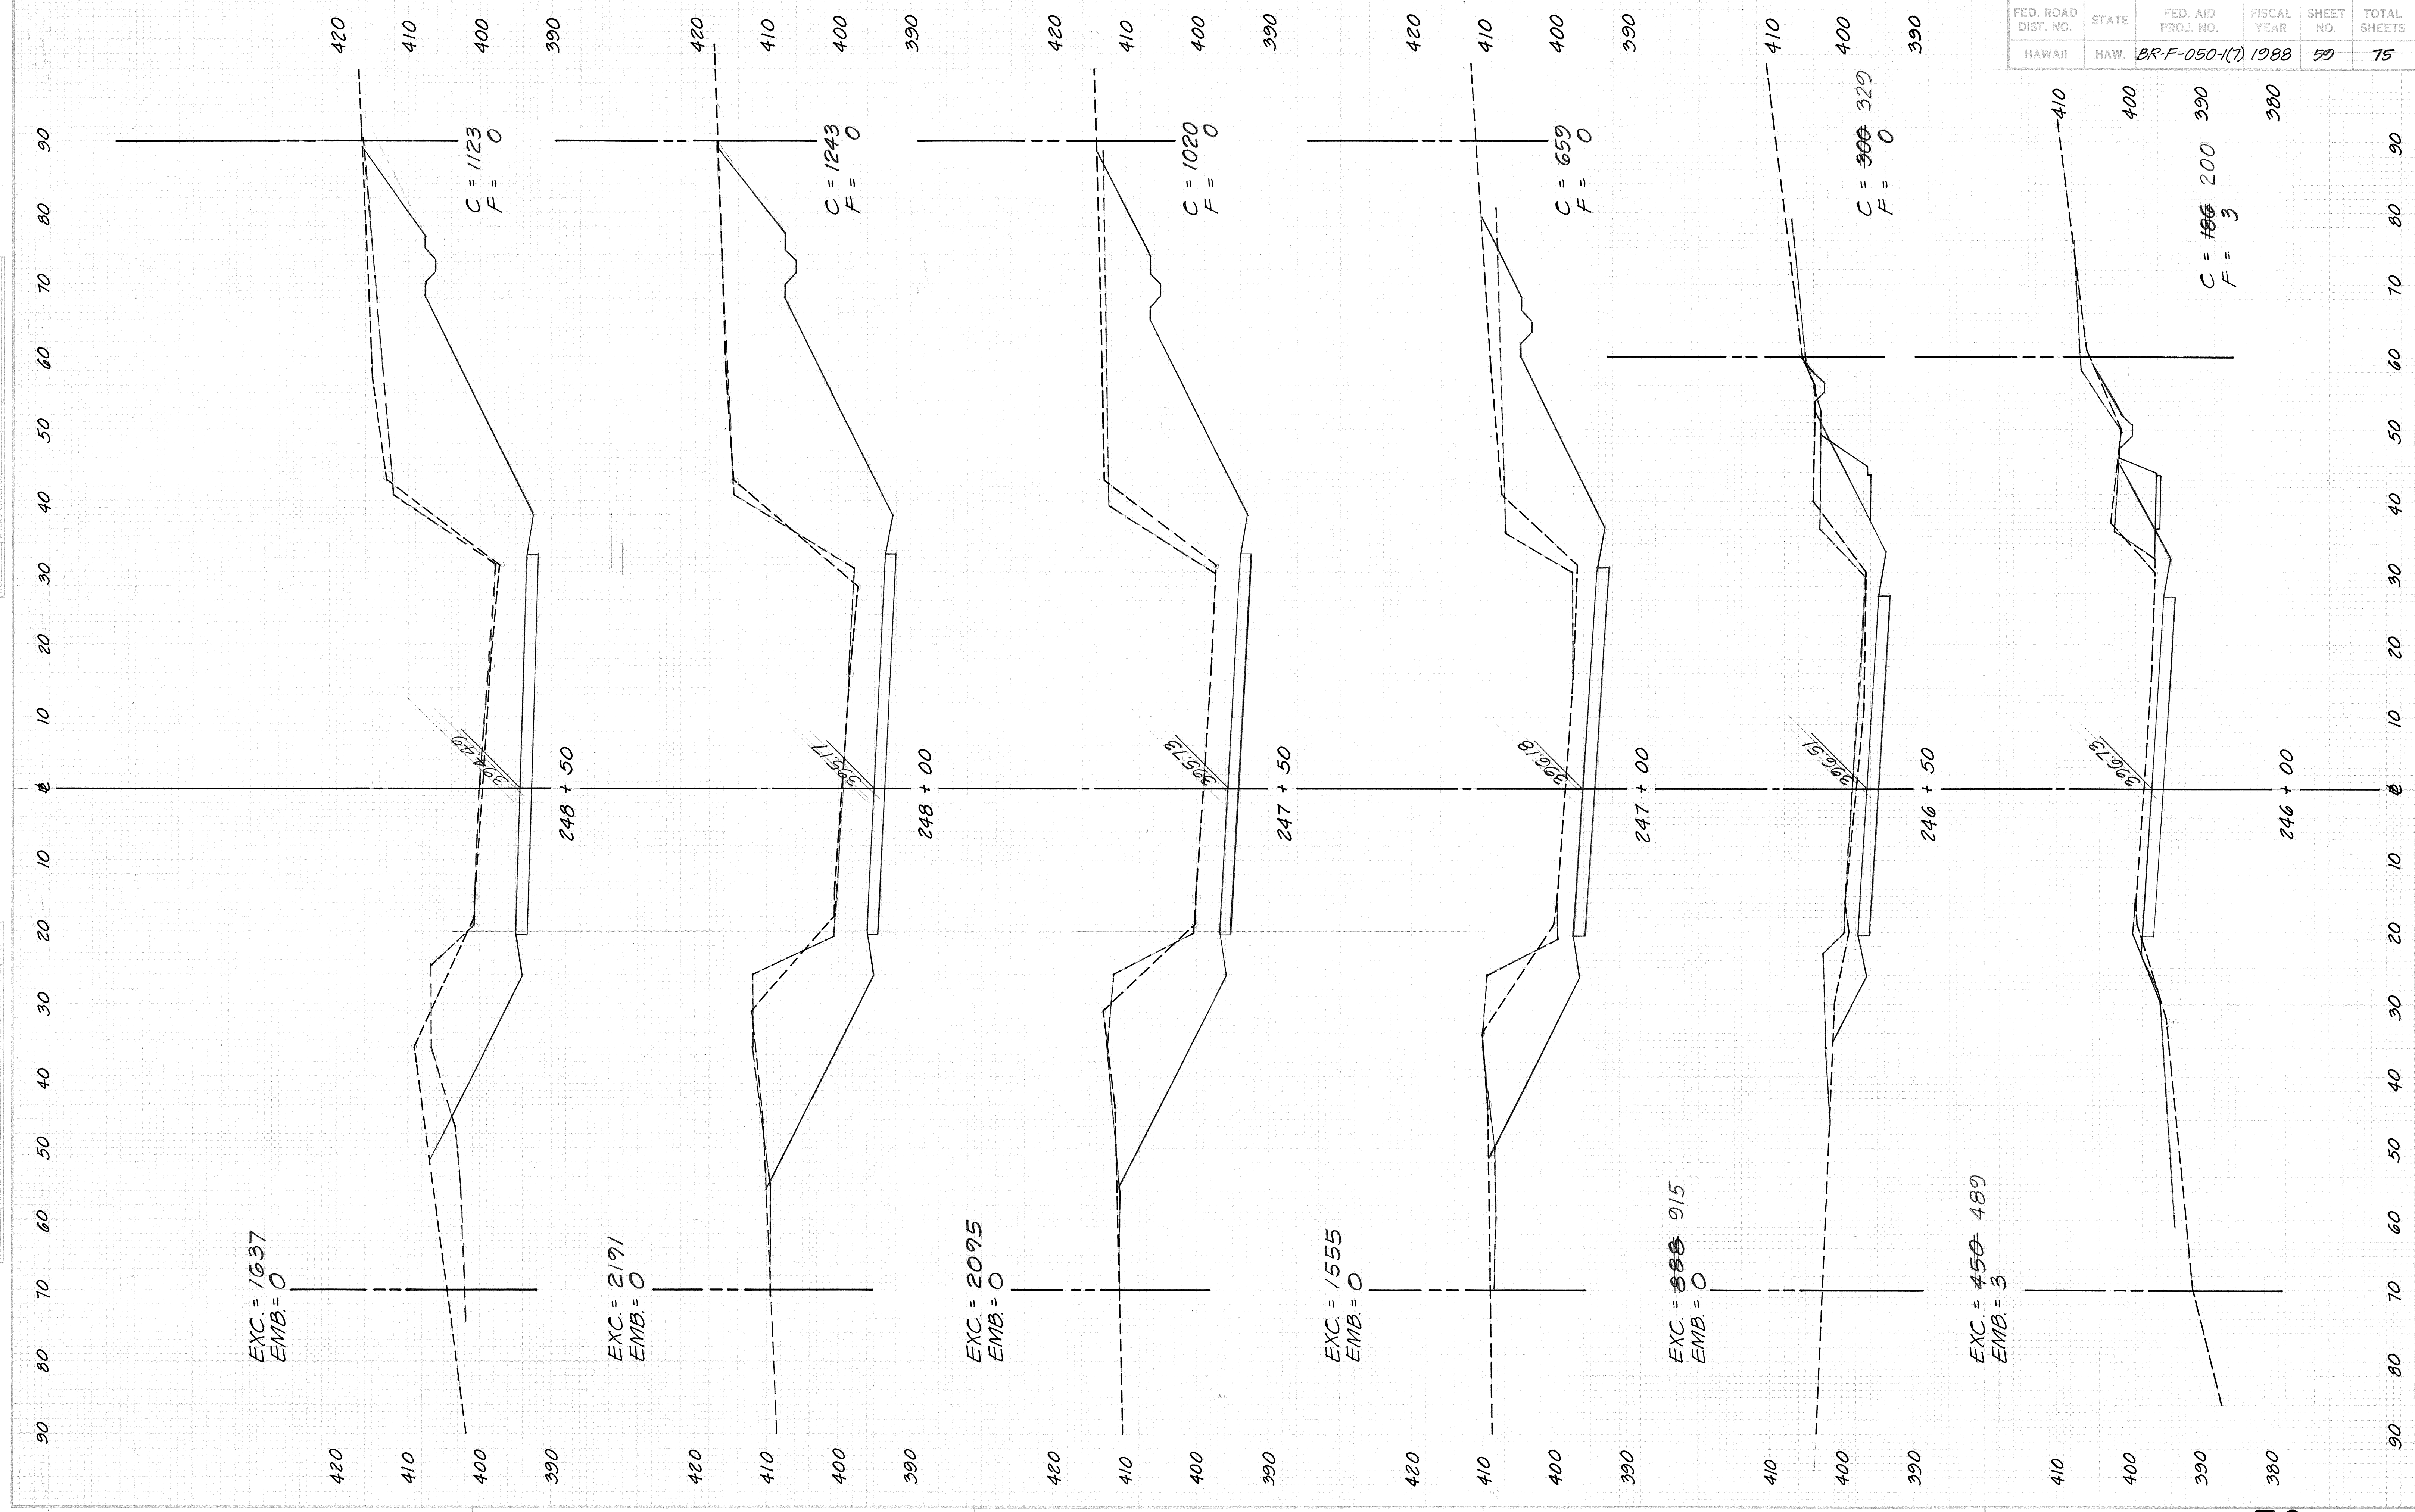

ORIGINAL	SURVEYED	DATE
SURVEY	BY	
NOTE BOOK	NO.	
AREAS CHECKED		


FINAL	SURVEYED	DATE
SURVEY	BY	
NOTE BOOK	NO.	
AREAS CHECKED		

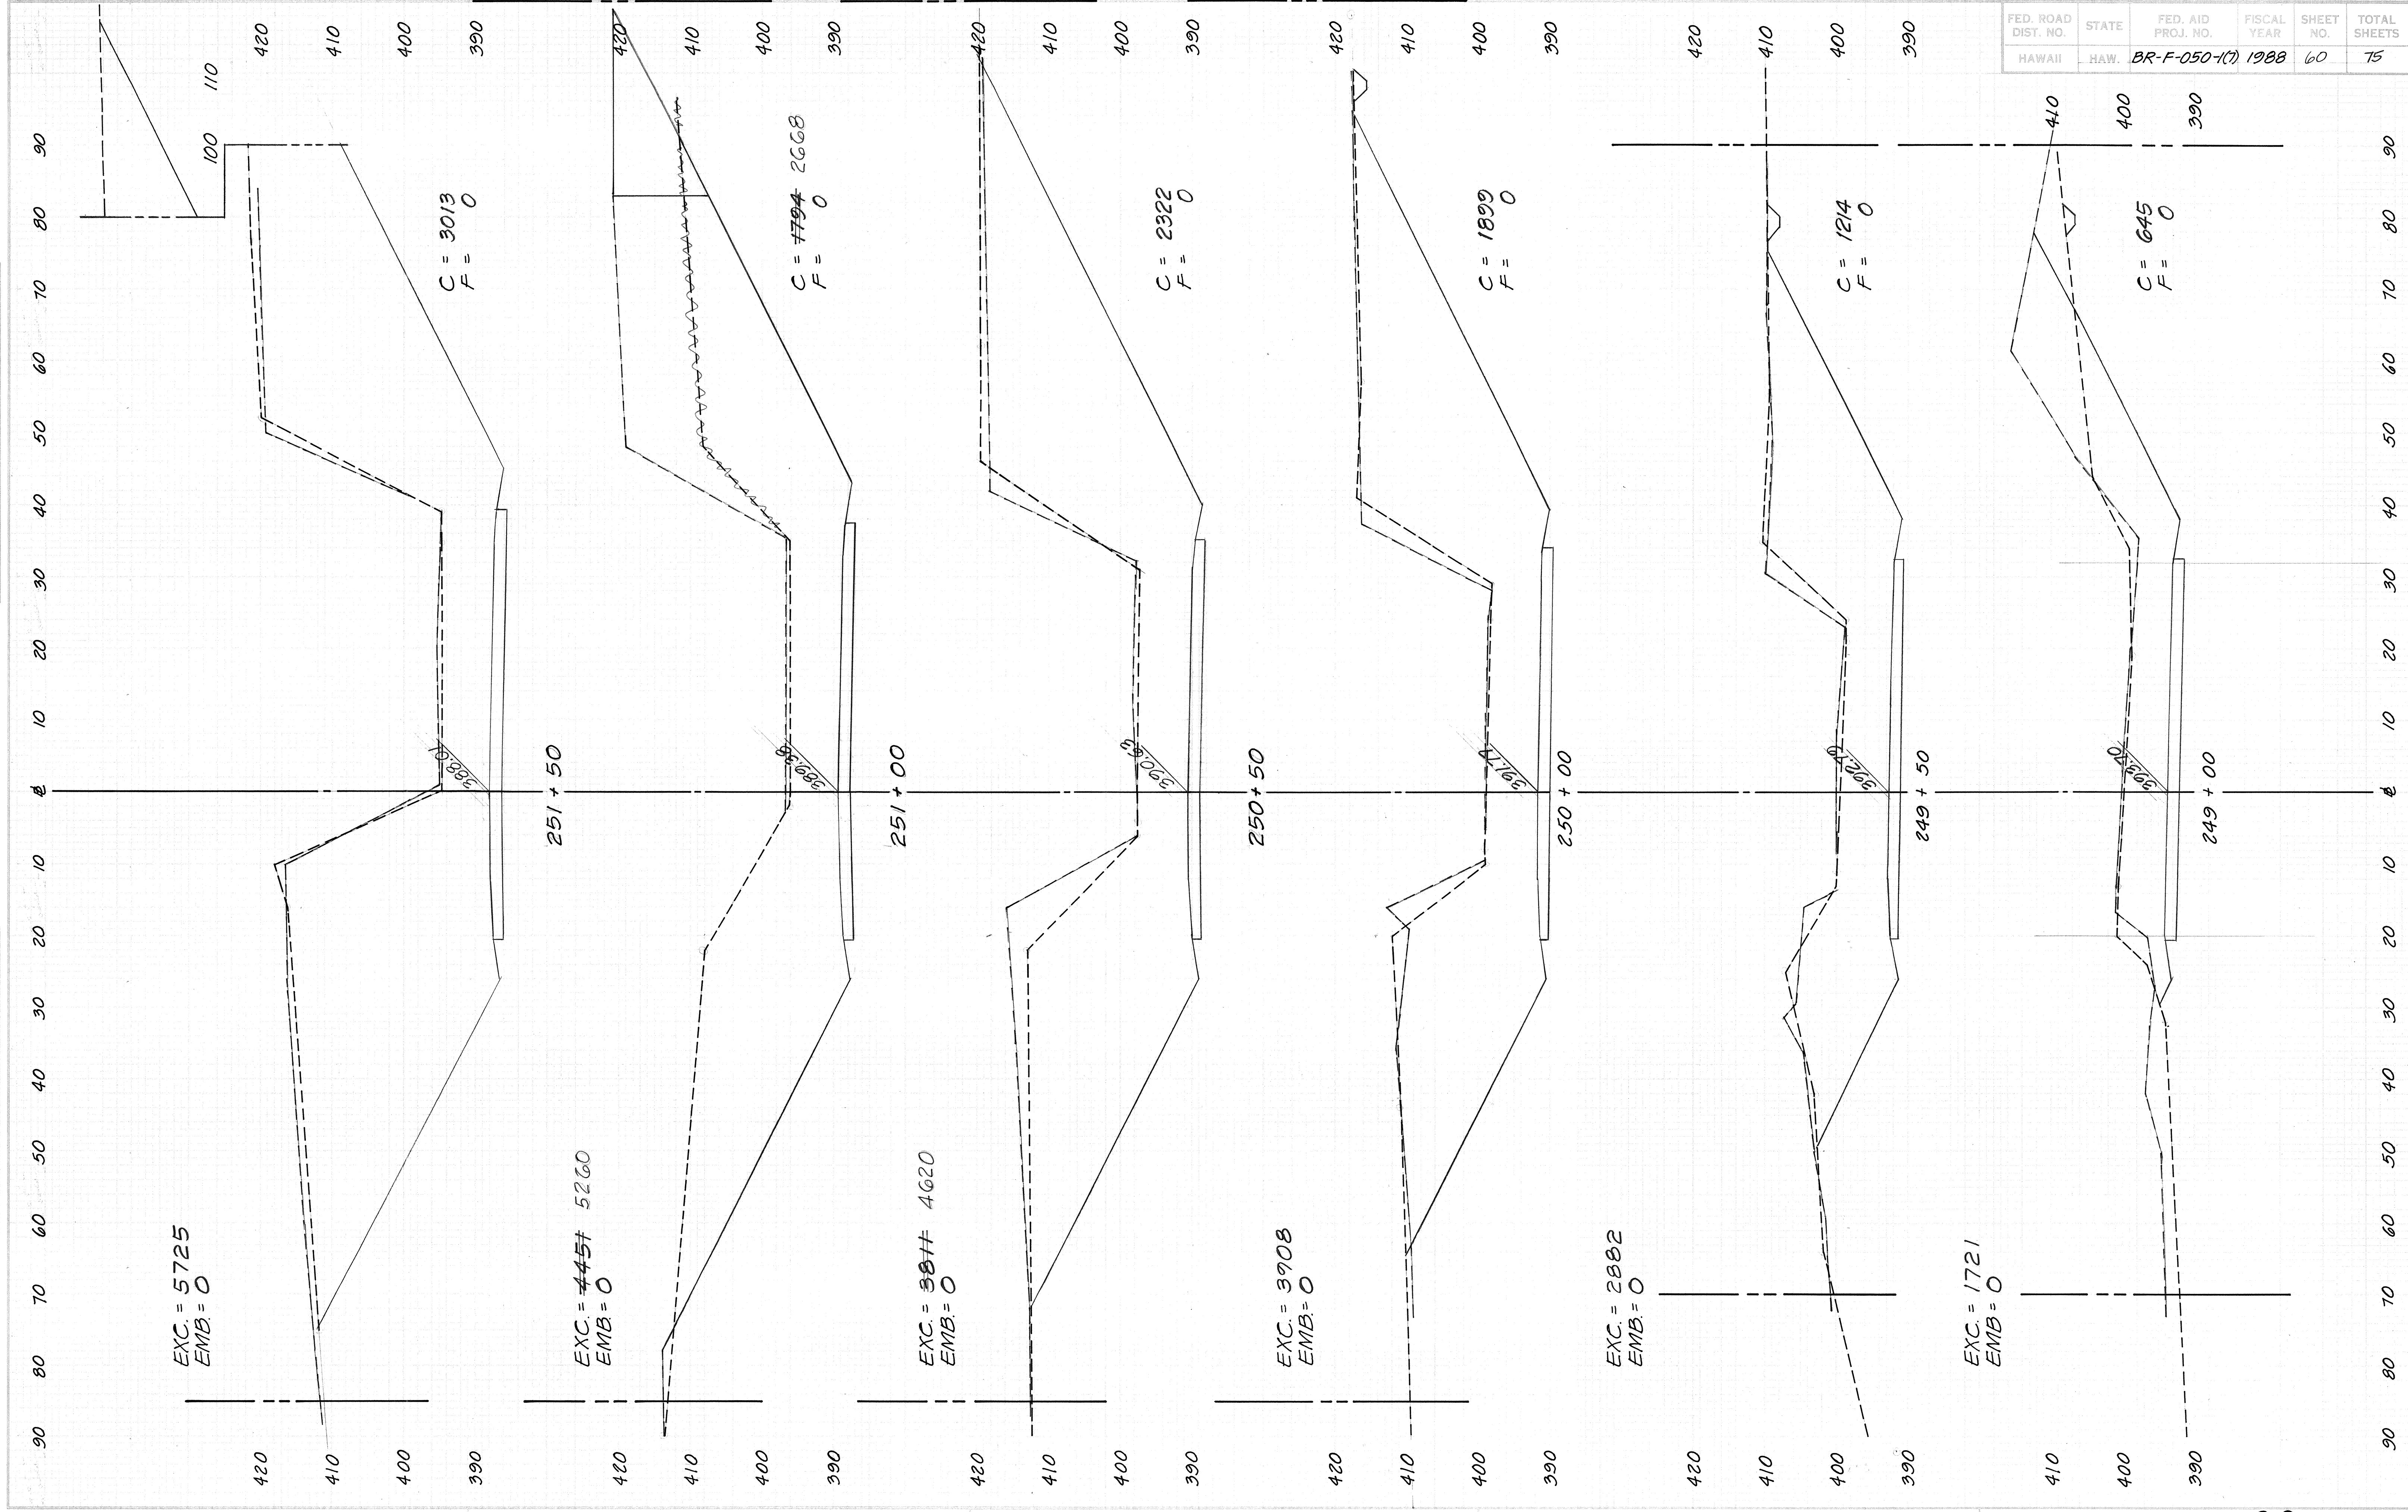

FED. ROAD DIST. NO.	STATE	FED. AID PROJ. NO.	FISCAL YEAR	SHEET NO.	TOTAL SHEETS
HAWAII	HAW.	BR-F-050-1(7)	1988	60	75


ORIGINAL	SURVEYED	BY	DATE
NO.	NO.	NO.	NO.
NOTE BOOK	TEMPLATE	AREAS CHECKED	

FINAL	SURVEYED	BY	DATE
NO.	NO.	NO.	NO.
NOTE BOOK	TEMPLATE	AREAS CHECKED	

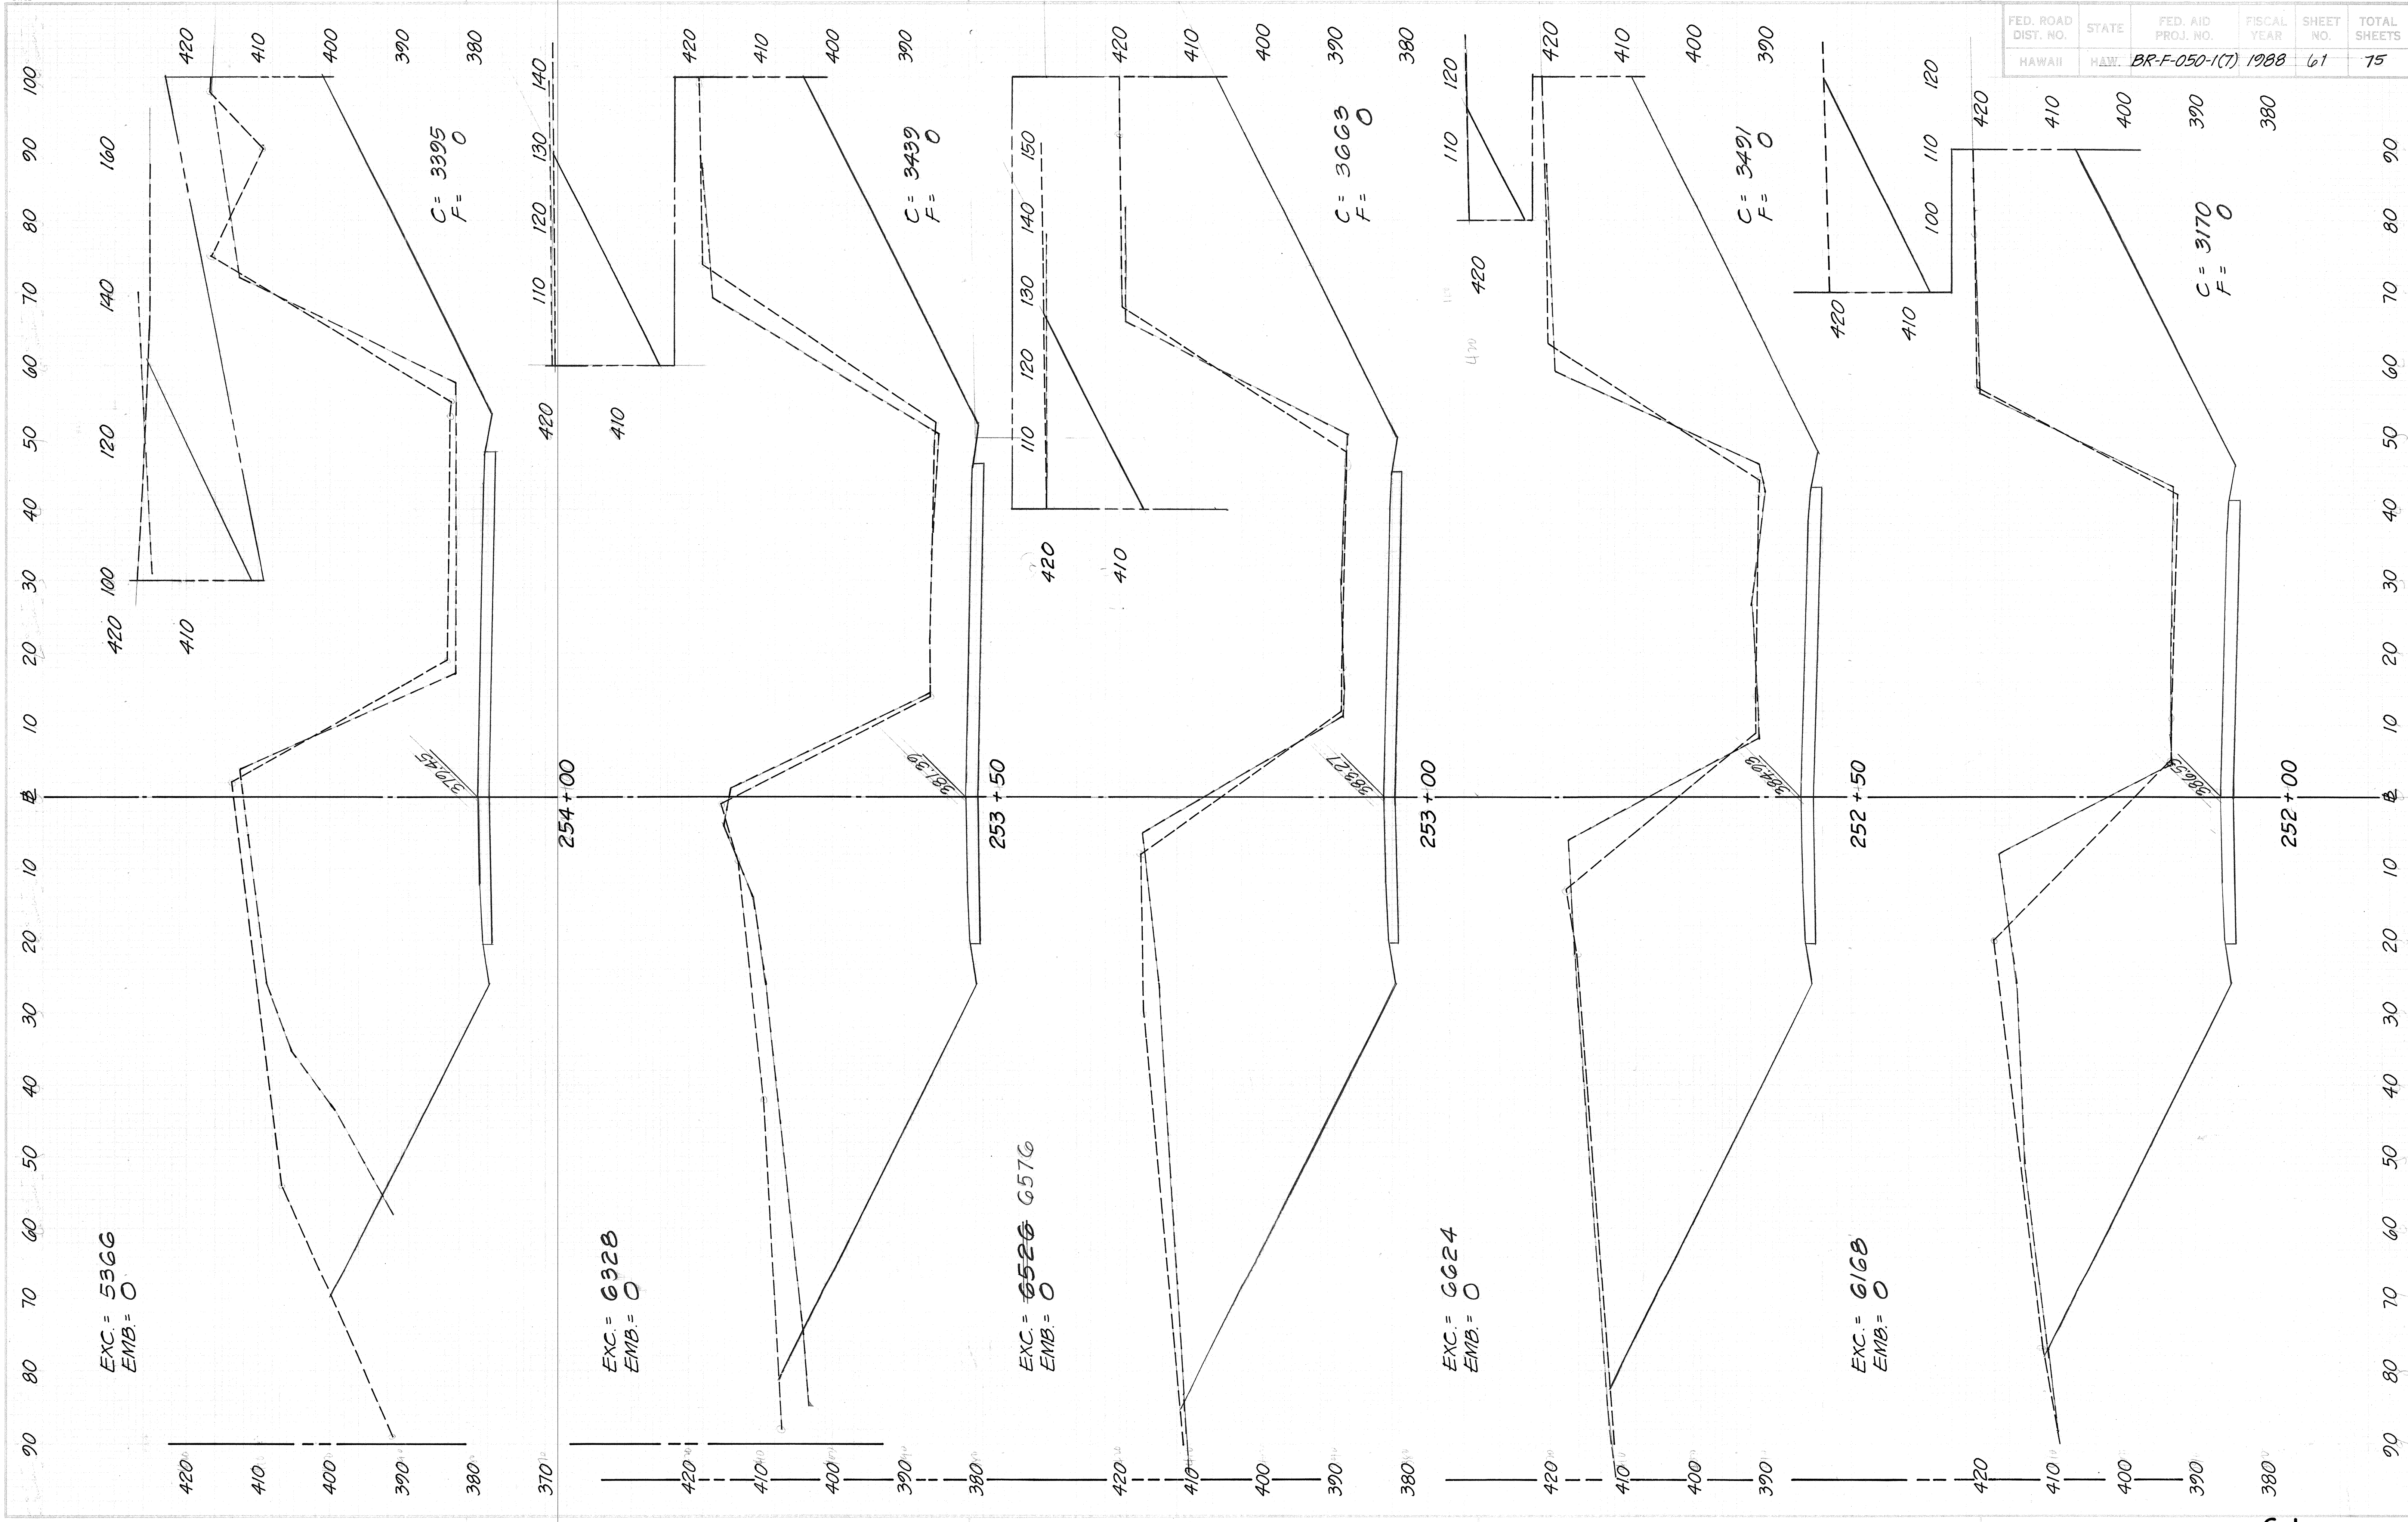


ORIGINAL	SURVEYED	DATE
SURVEY	BY	
NOTE BOOK	NO.	
AREAS CHECKED	AREAS	

FINAL	SURVEYED	DATE
SURVEY	BY	
NOTE BOOK	NO.	
AREAS CHECKED	AREAS	

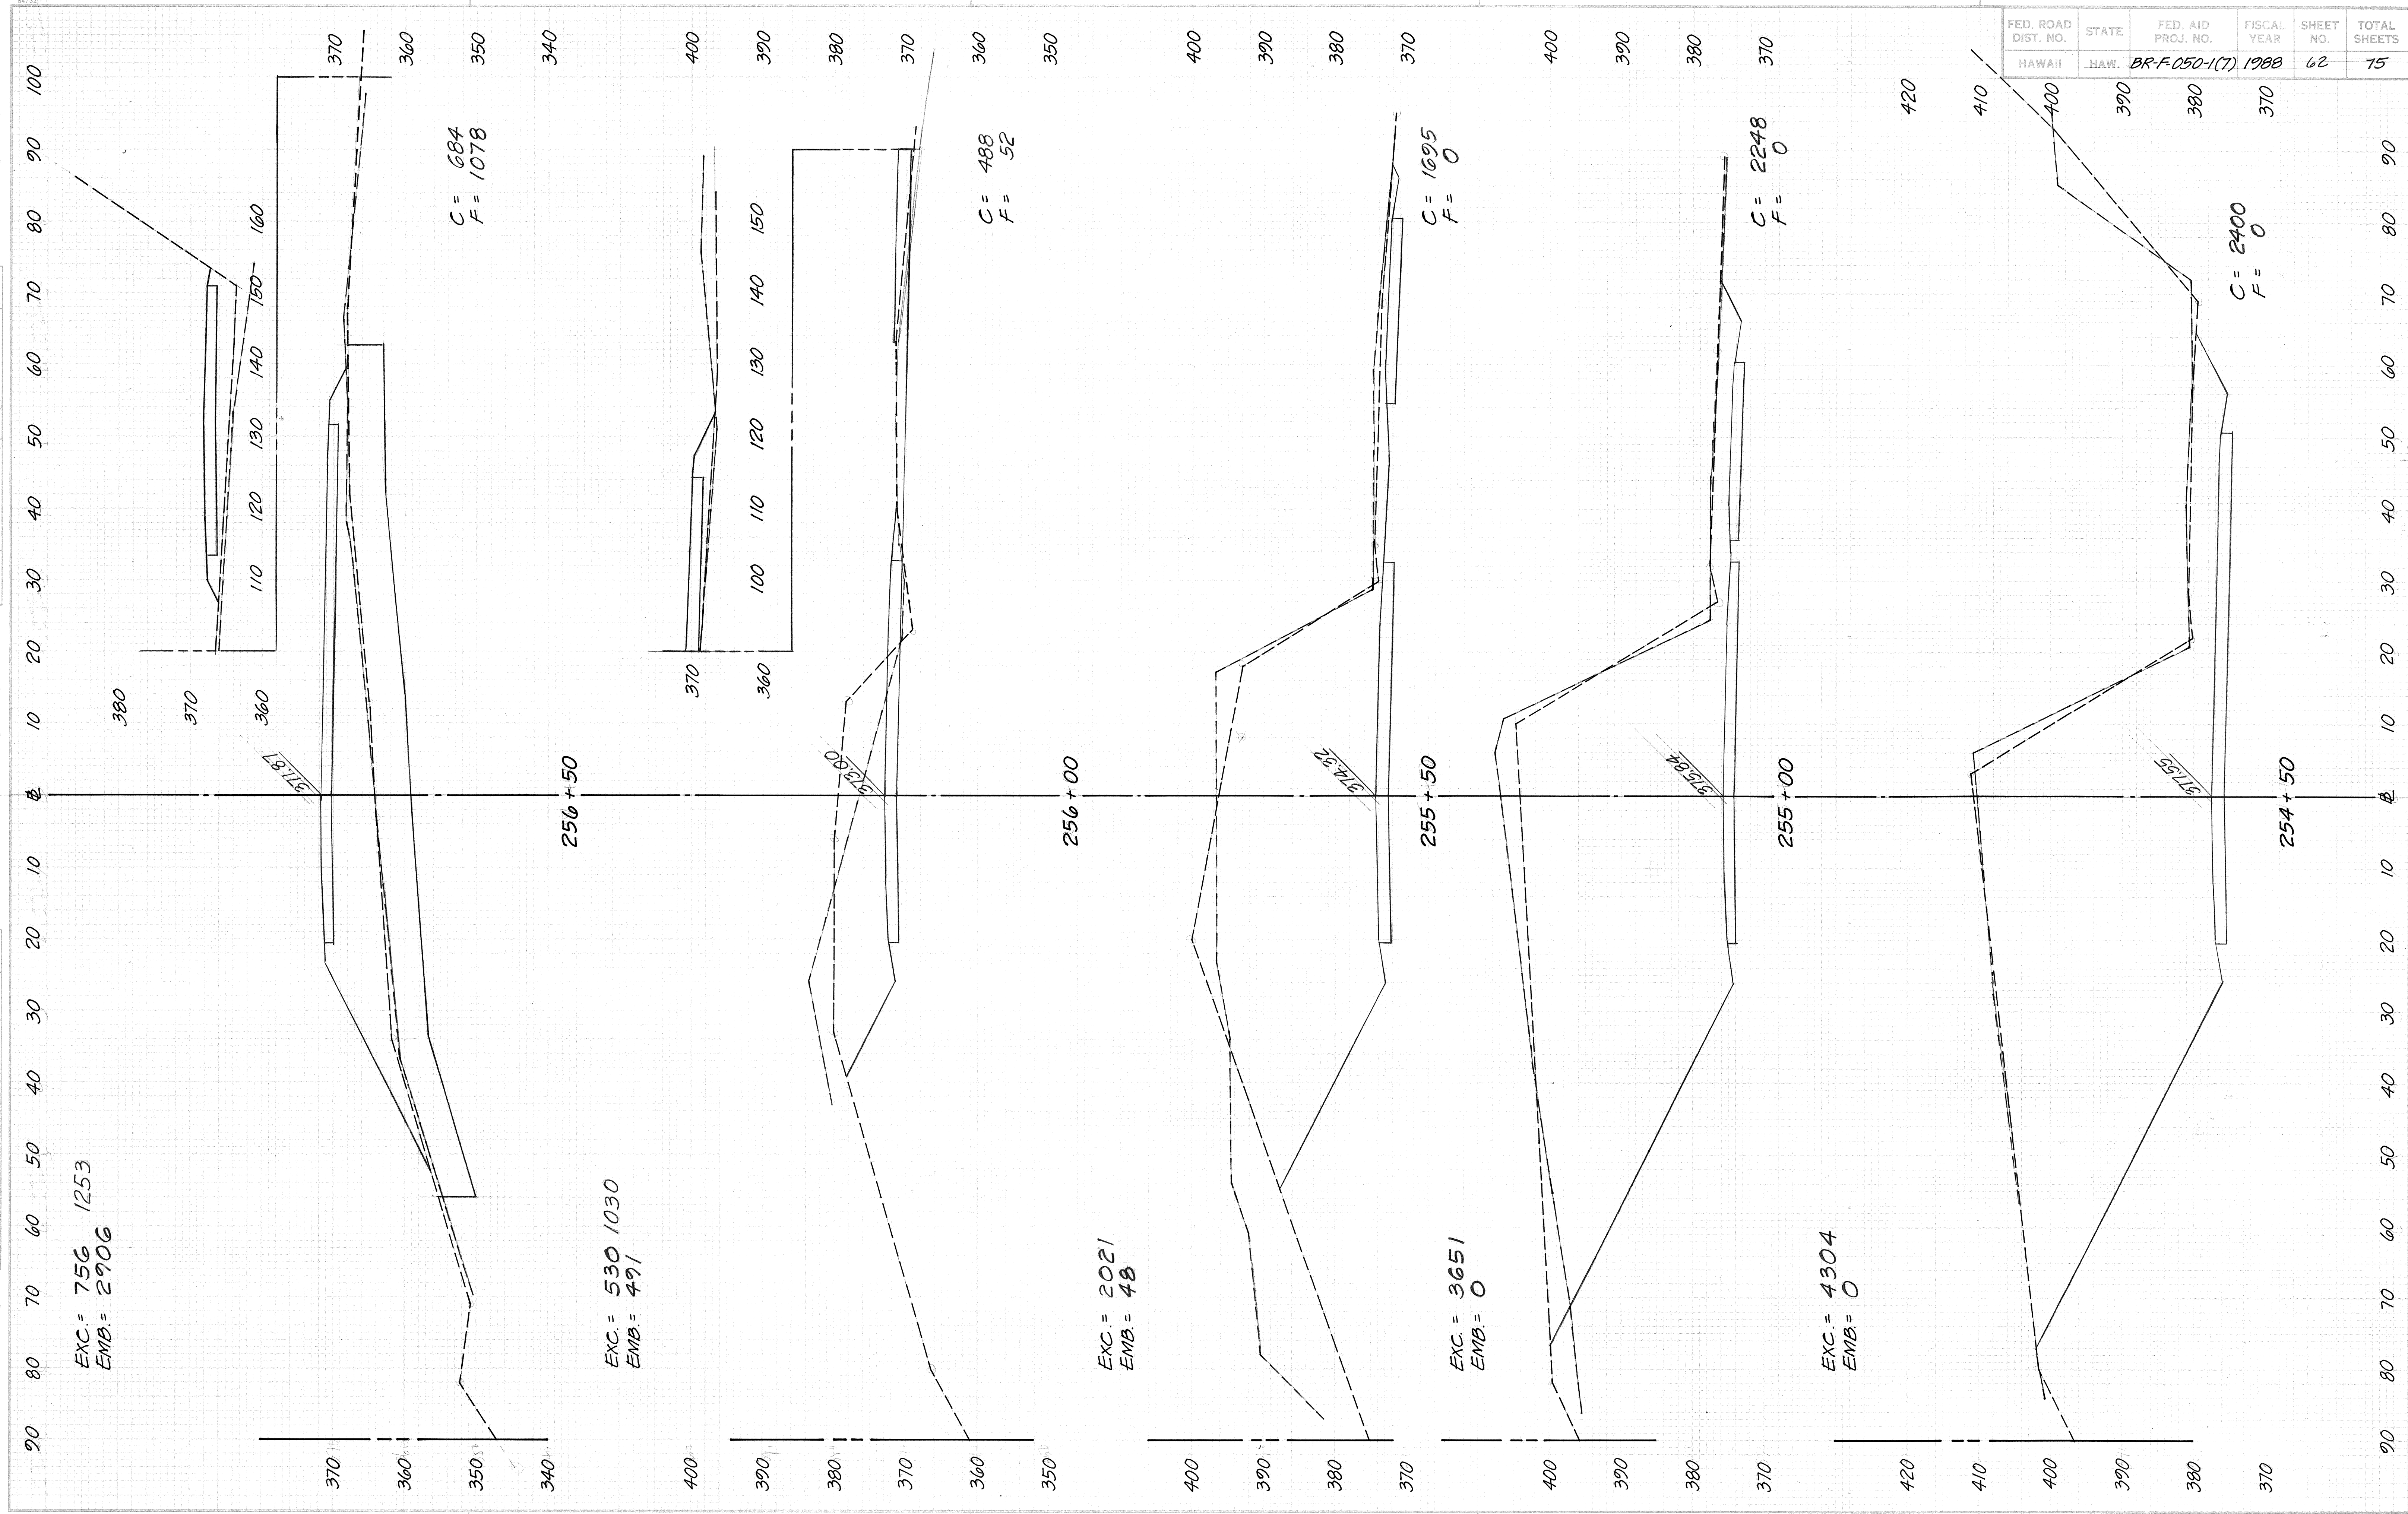

ORIGINAL	SURVEYED	DATE
SURVEY	BY	
NOTE BOOK	NO.	
AREAS	AREAS CHECKED	


FINAL	SURVEYED	DATE
SURVEY	BY	
NOTE BOOK	NO.	
AREAS	AREAS CHECKED	

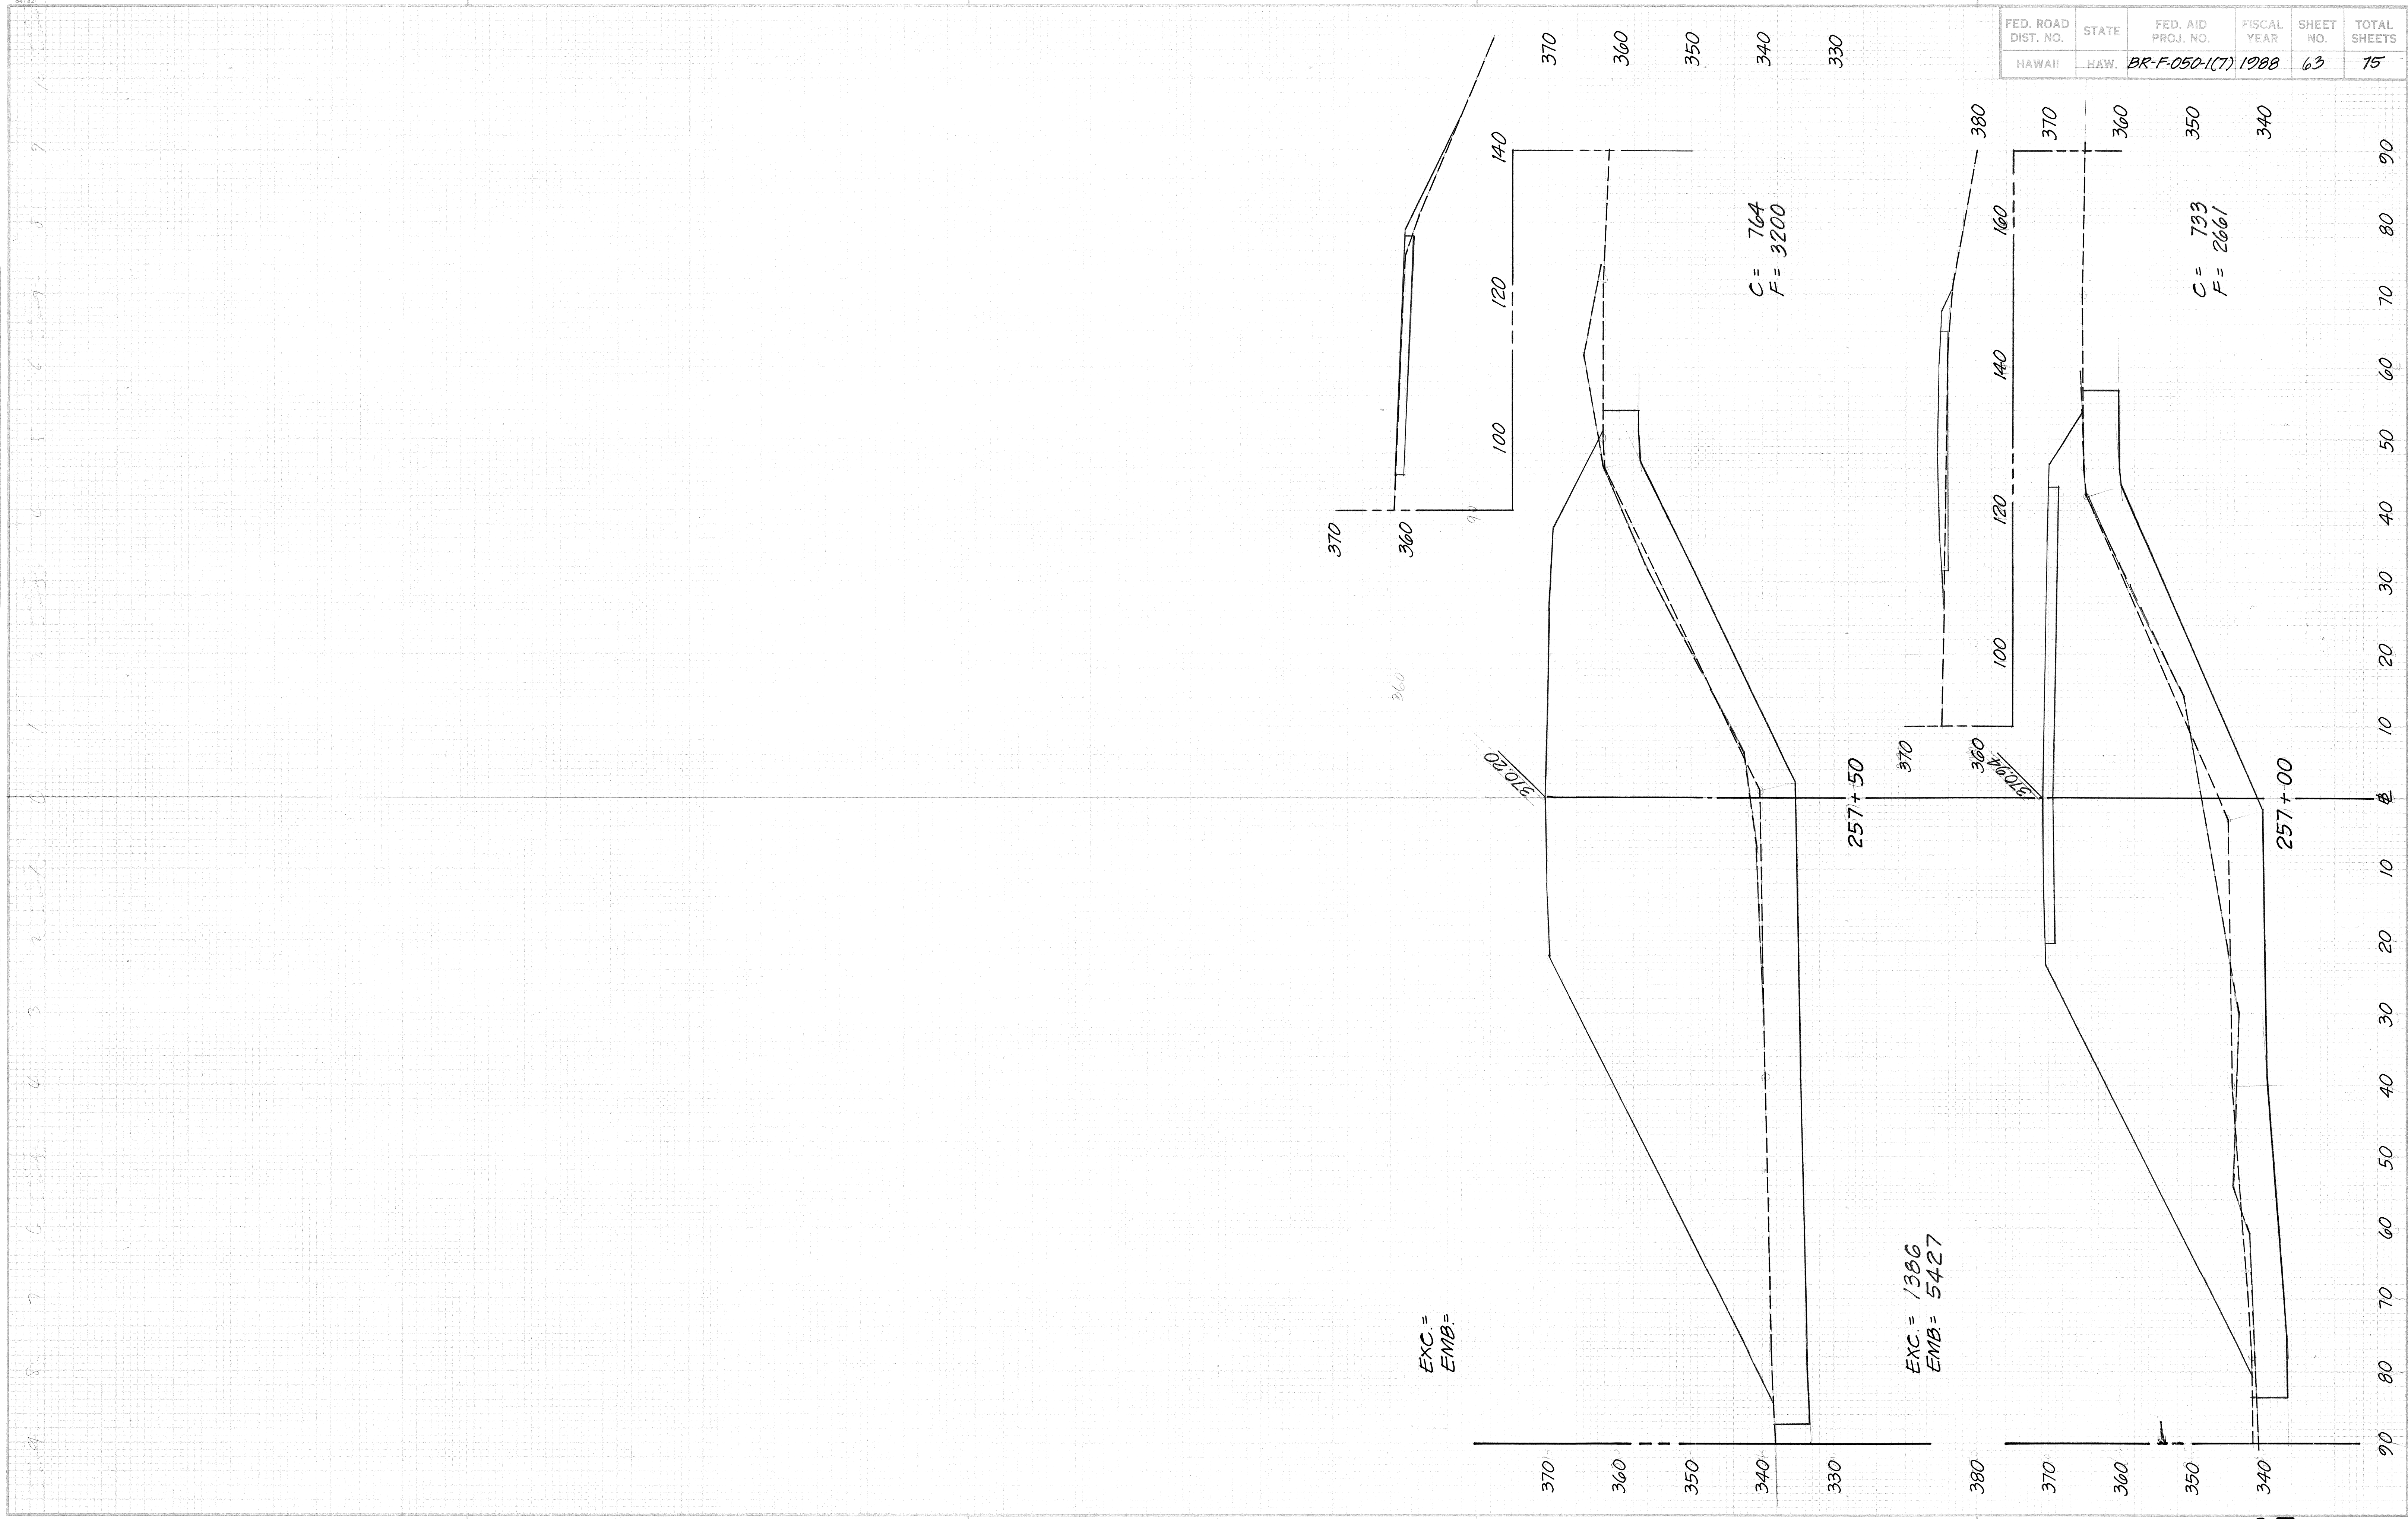


FED. ROAD DIST. NO.	STATE	FED. AID PROJ. NO.	FISCAL YEAR	SHEET NO.	TOTAL SHEETS
HAWAII	HAW.	BR-F-050-1(7)	1988	63	75

FED. ROAD DIST. NO.	STATE	FED. AID PROJ. NO.	FISCAL YEAR	SHEET NO.	TOTAL SHEETS
HAWAII	HAW.	BR-F-050-1(7)	1988	64	75

Exc. = 68
EMB. = 162

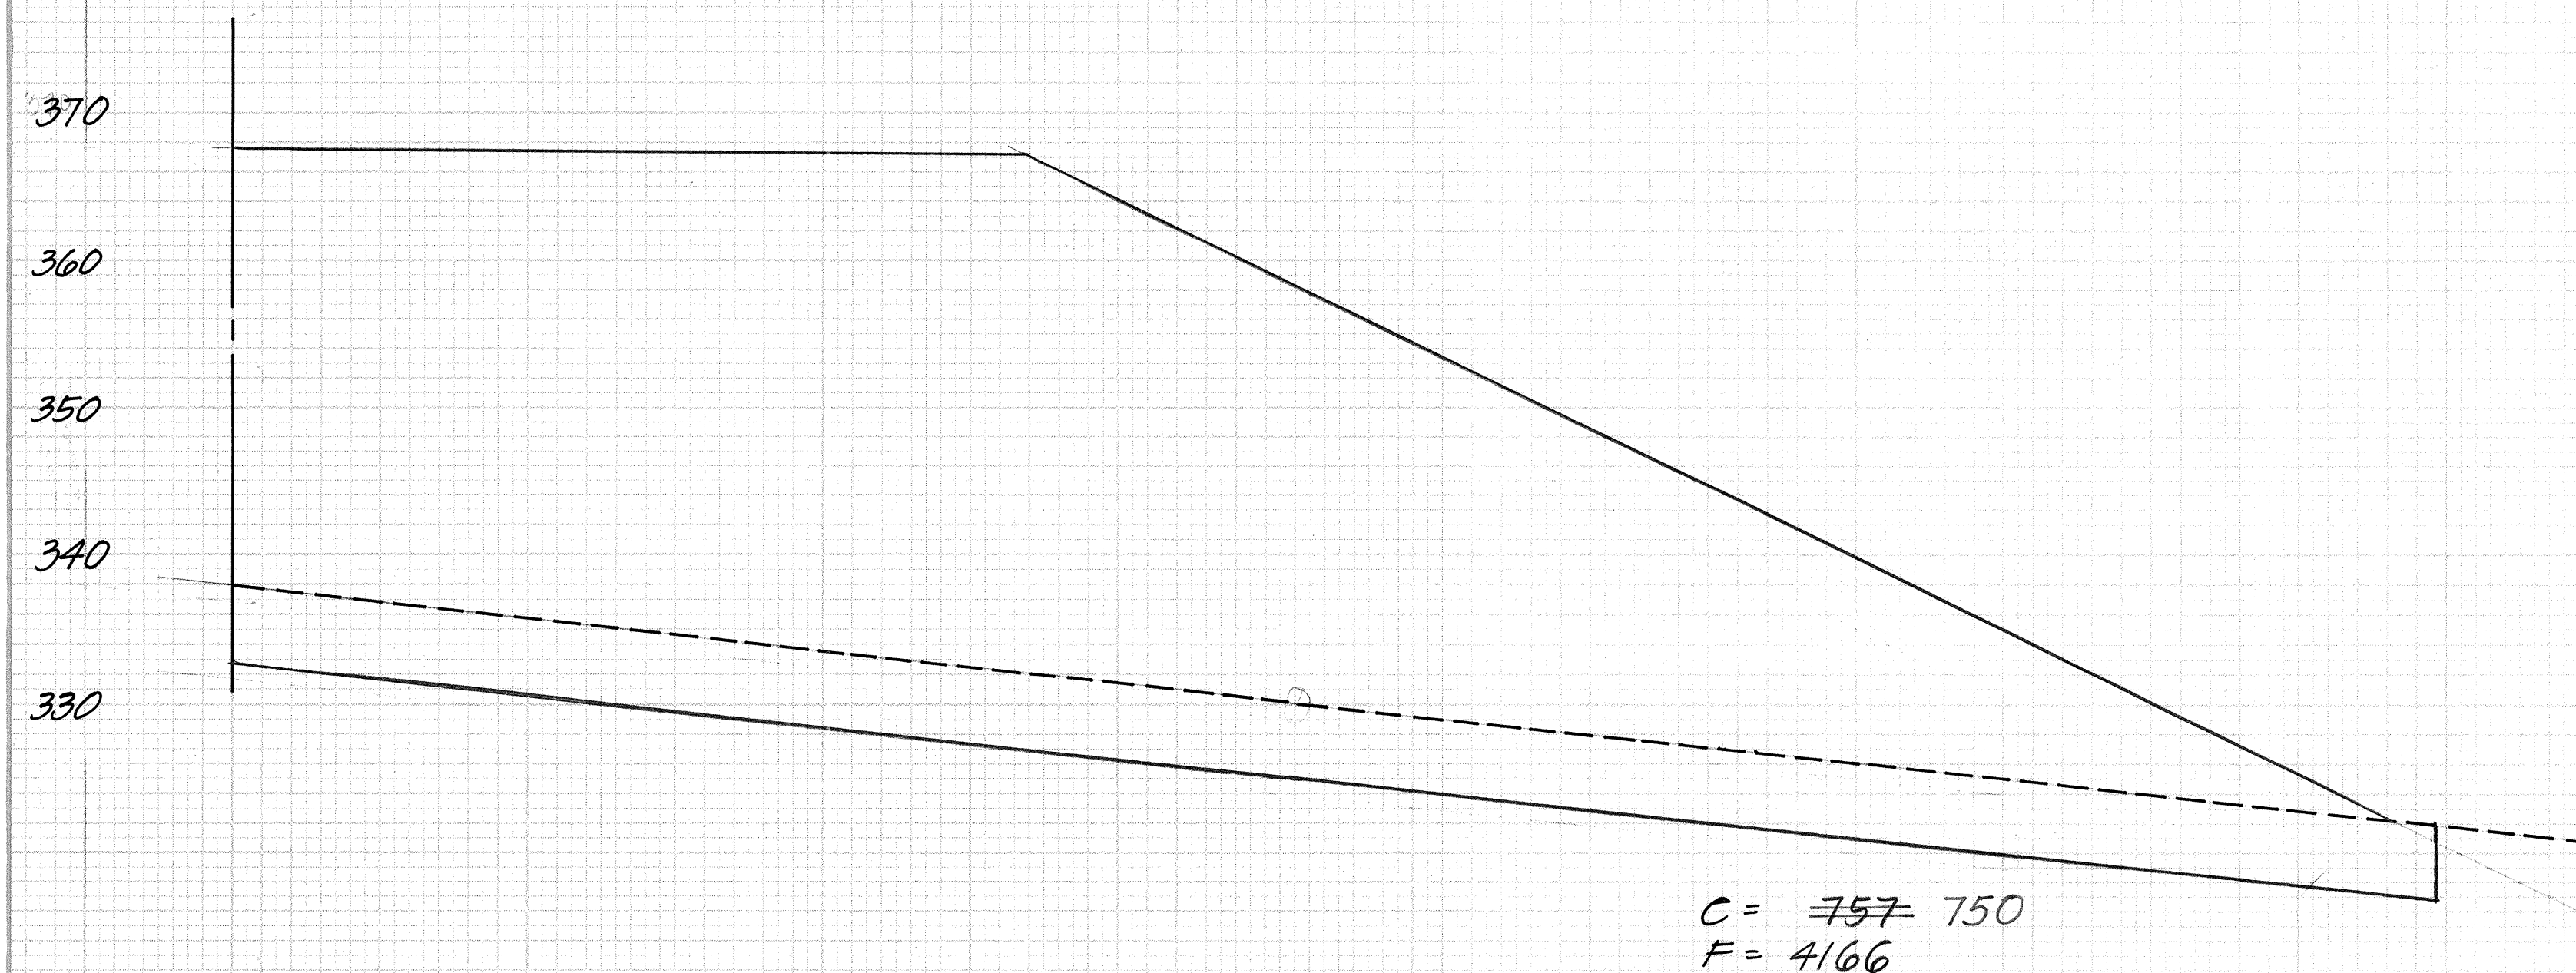


Exc. = ~~424~~ 462.20
EMB. = 1589

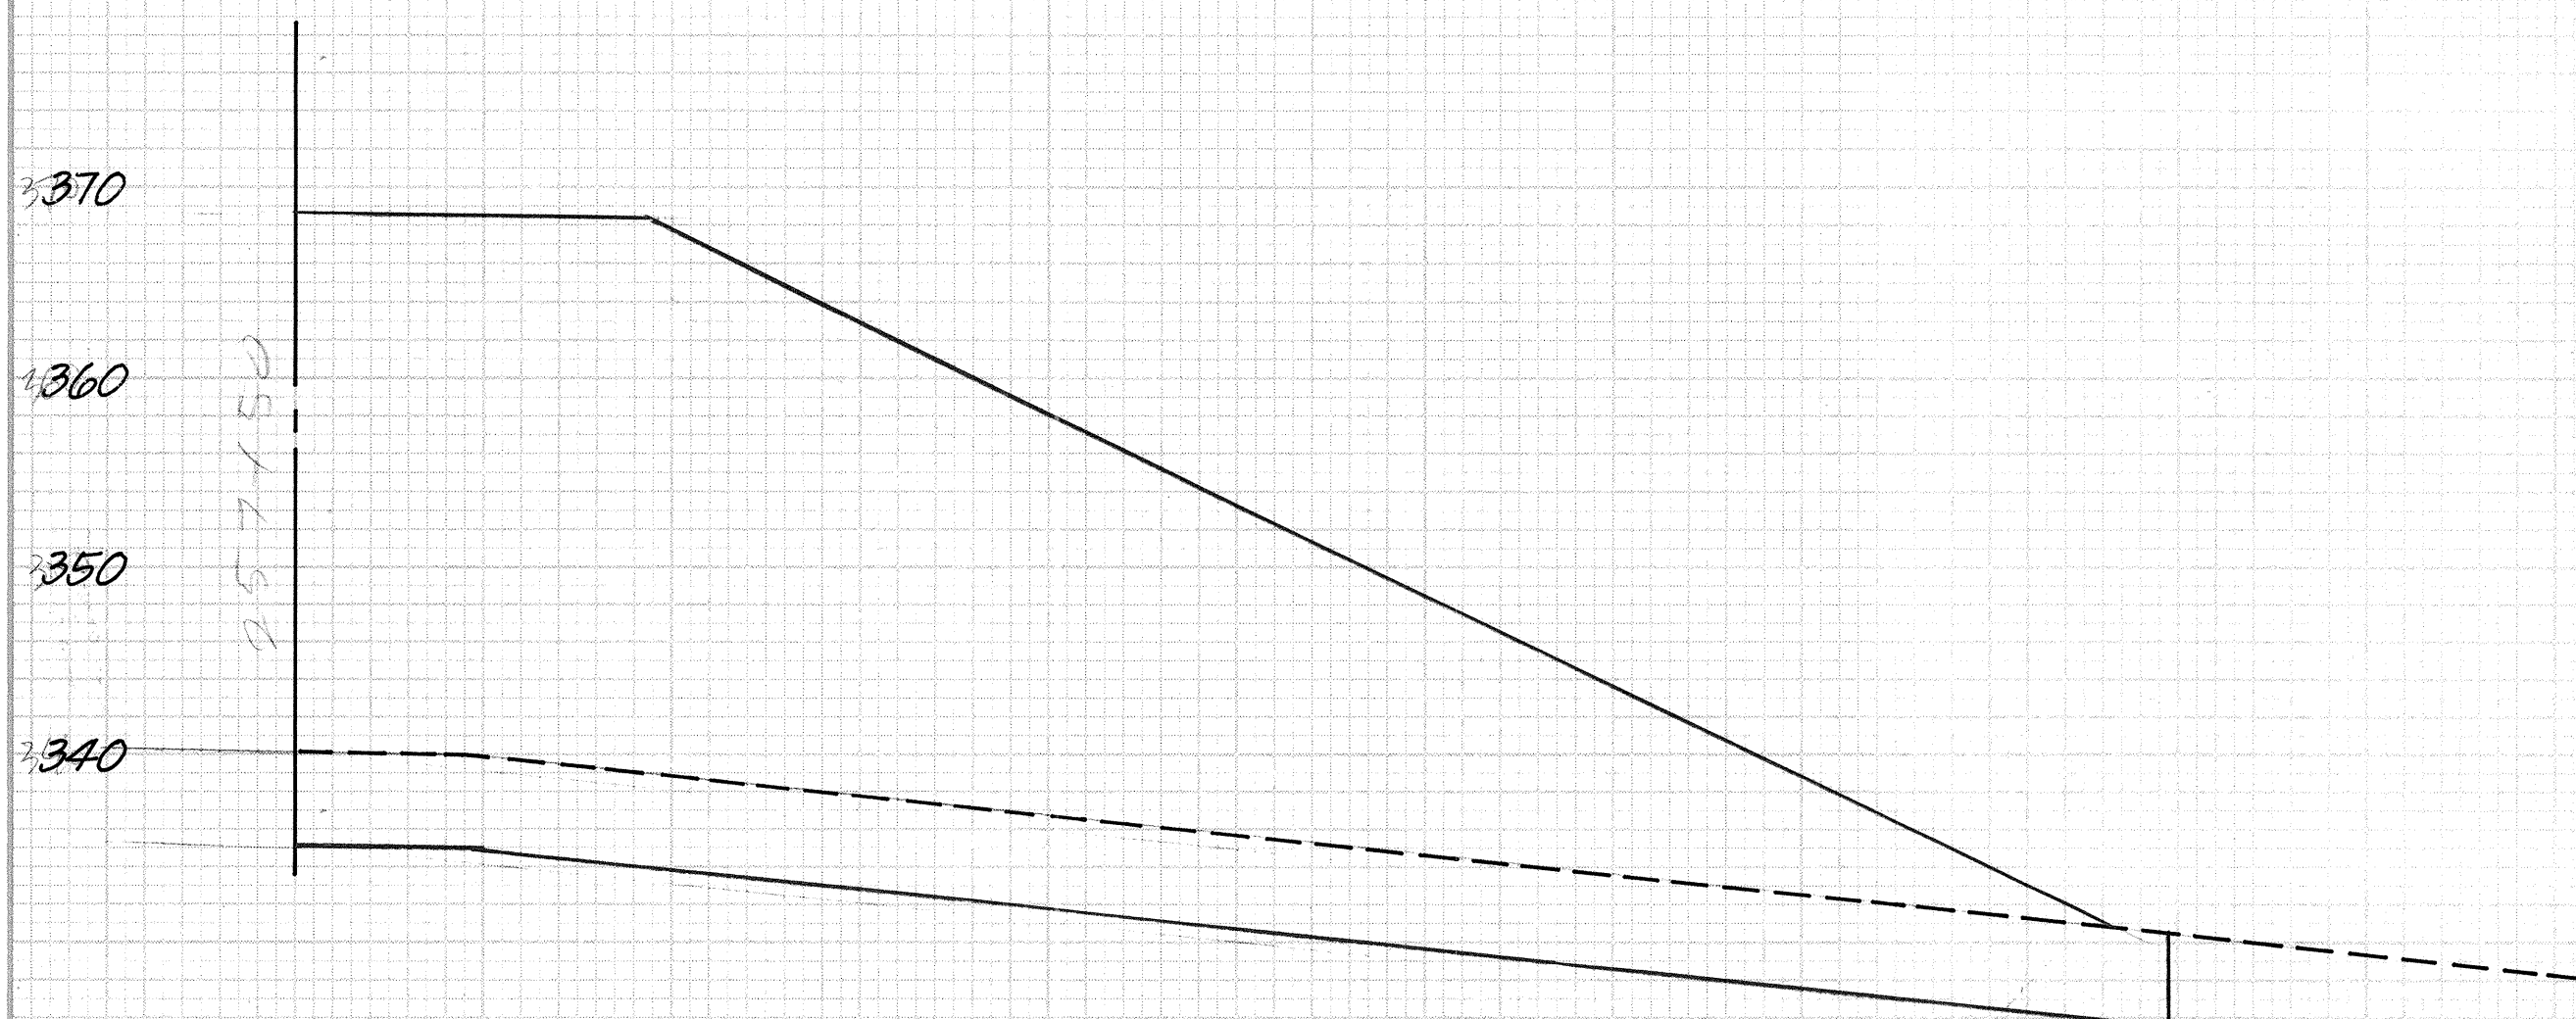

Exc. = ~~467~~ 413.60
EMB. = 2356

AT BASELINE

C = 505 498
F = 2195

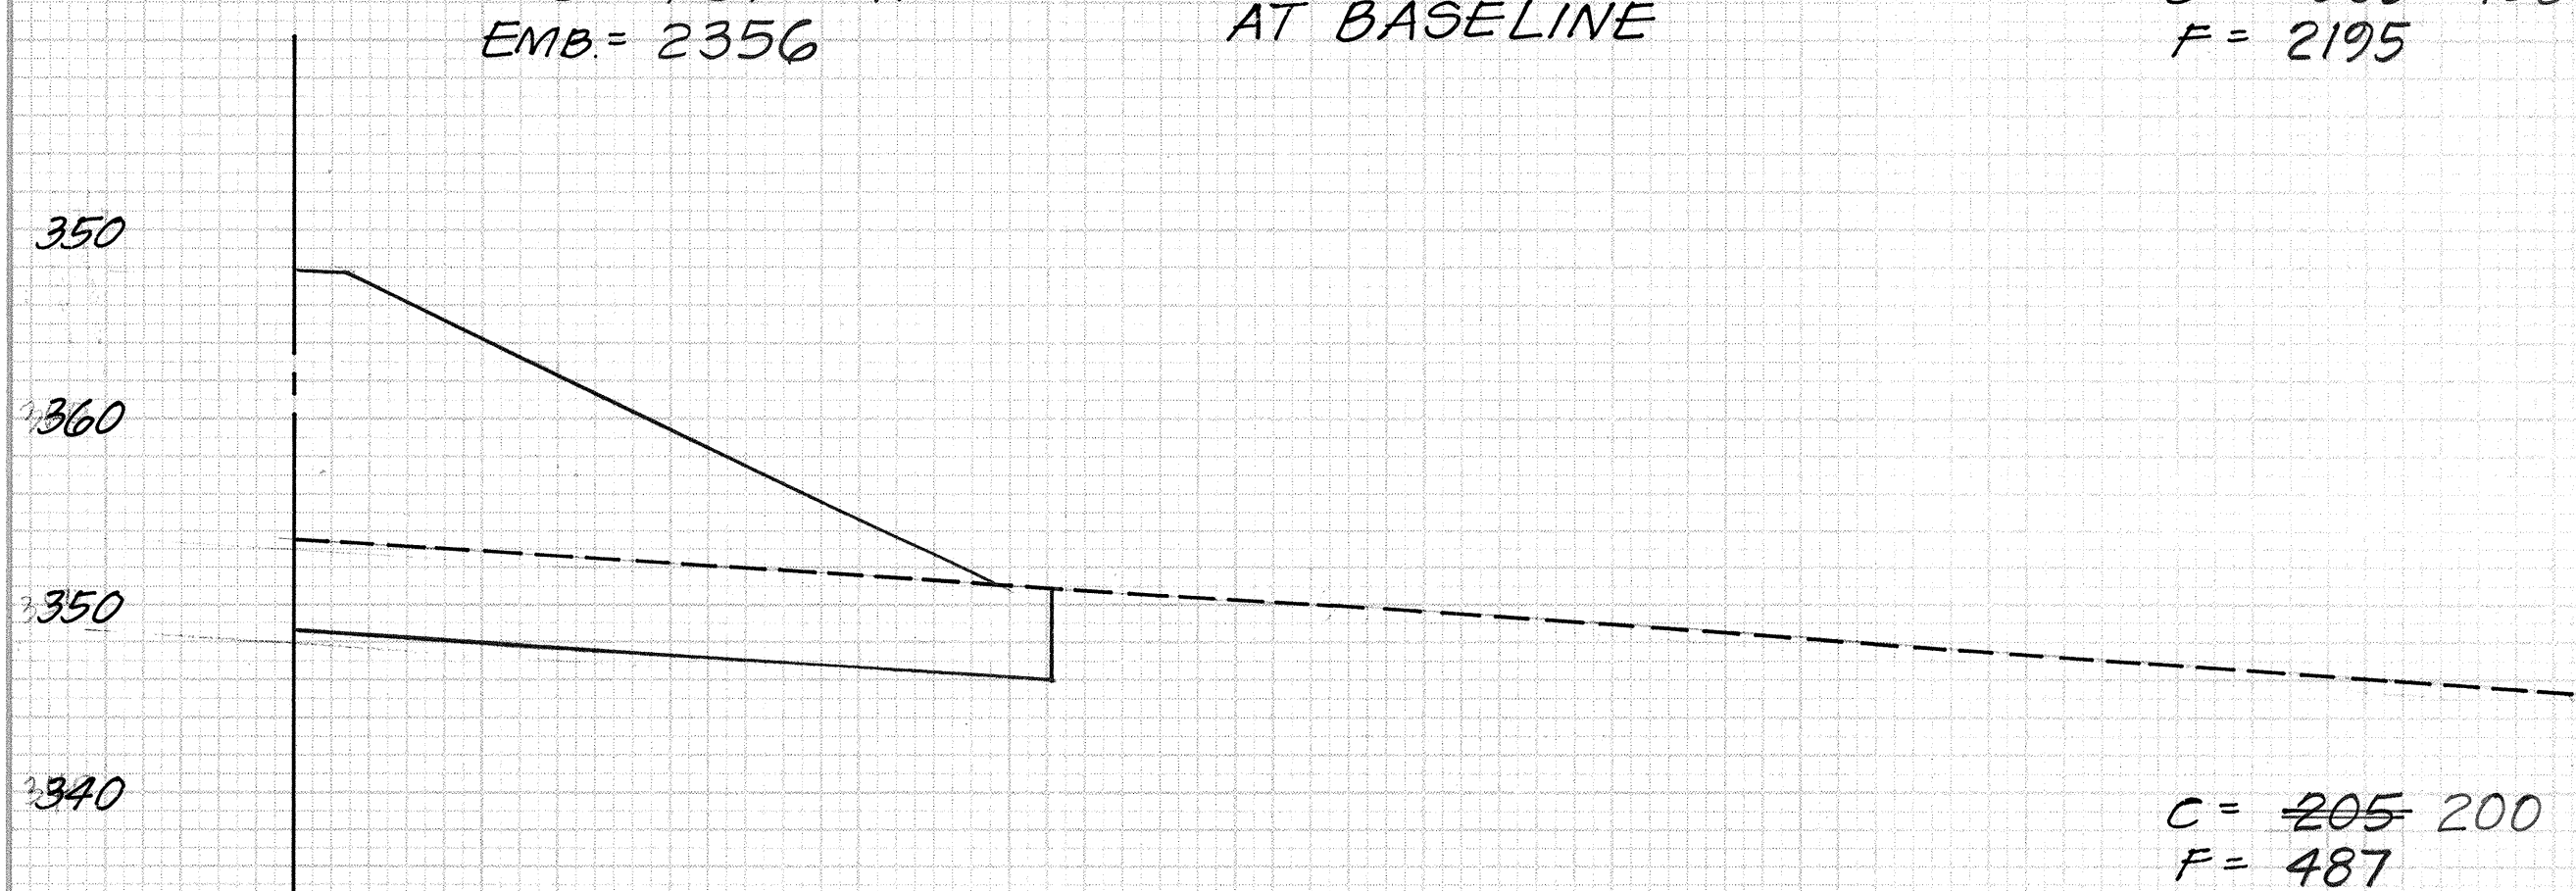

Exc. = 704
EMB. = 3857

32' 0/3 RIGHT


C = 205 200
F = 487

257+50

258+00

258+50


Exc. = 192
EMB. = 484

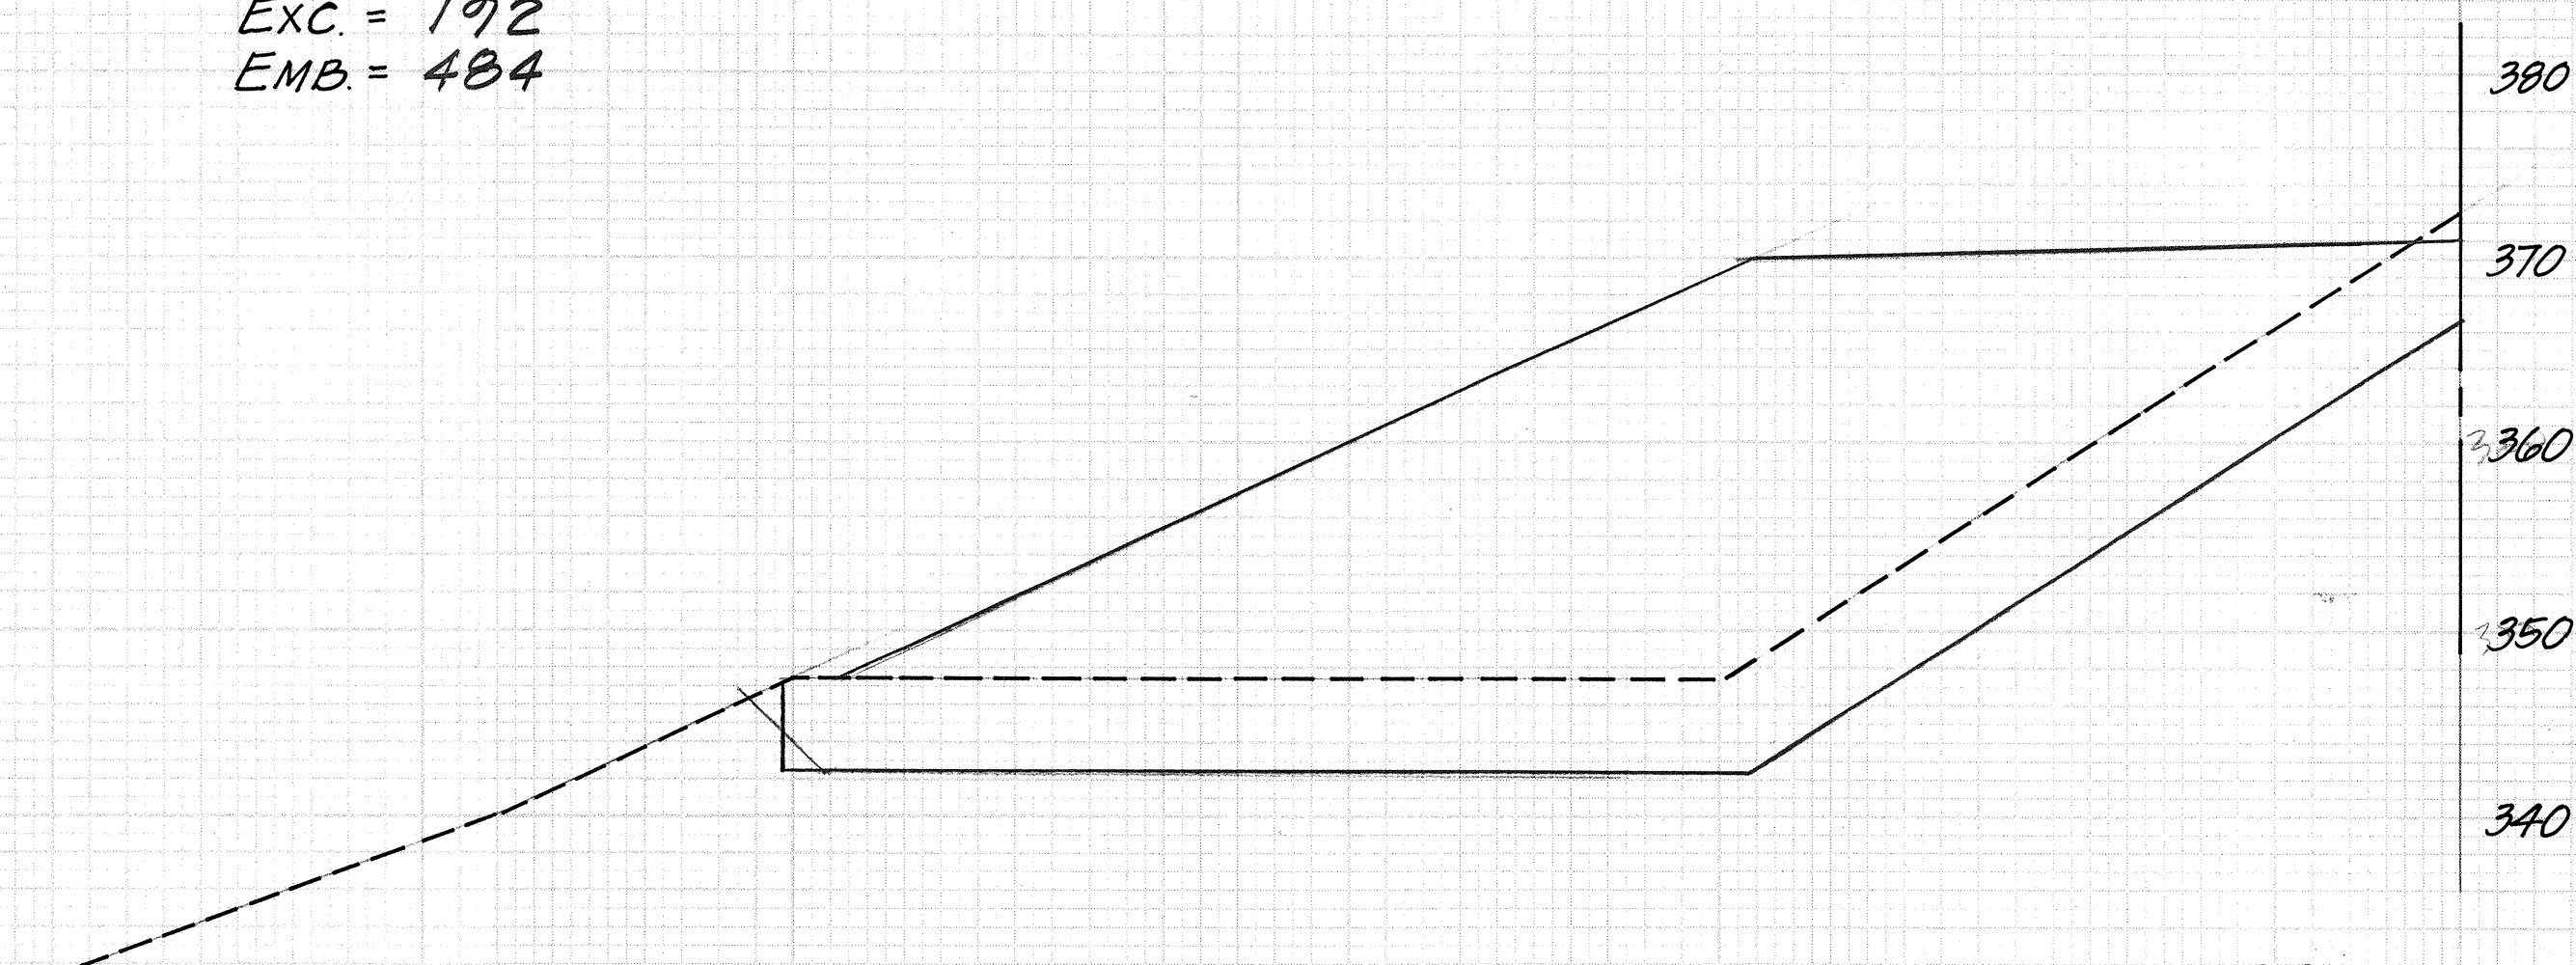

Exc. = ~~476~~ 374.10
EMB. = 1142

20' 0/3 LEFT


C = 485
F = 1440

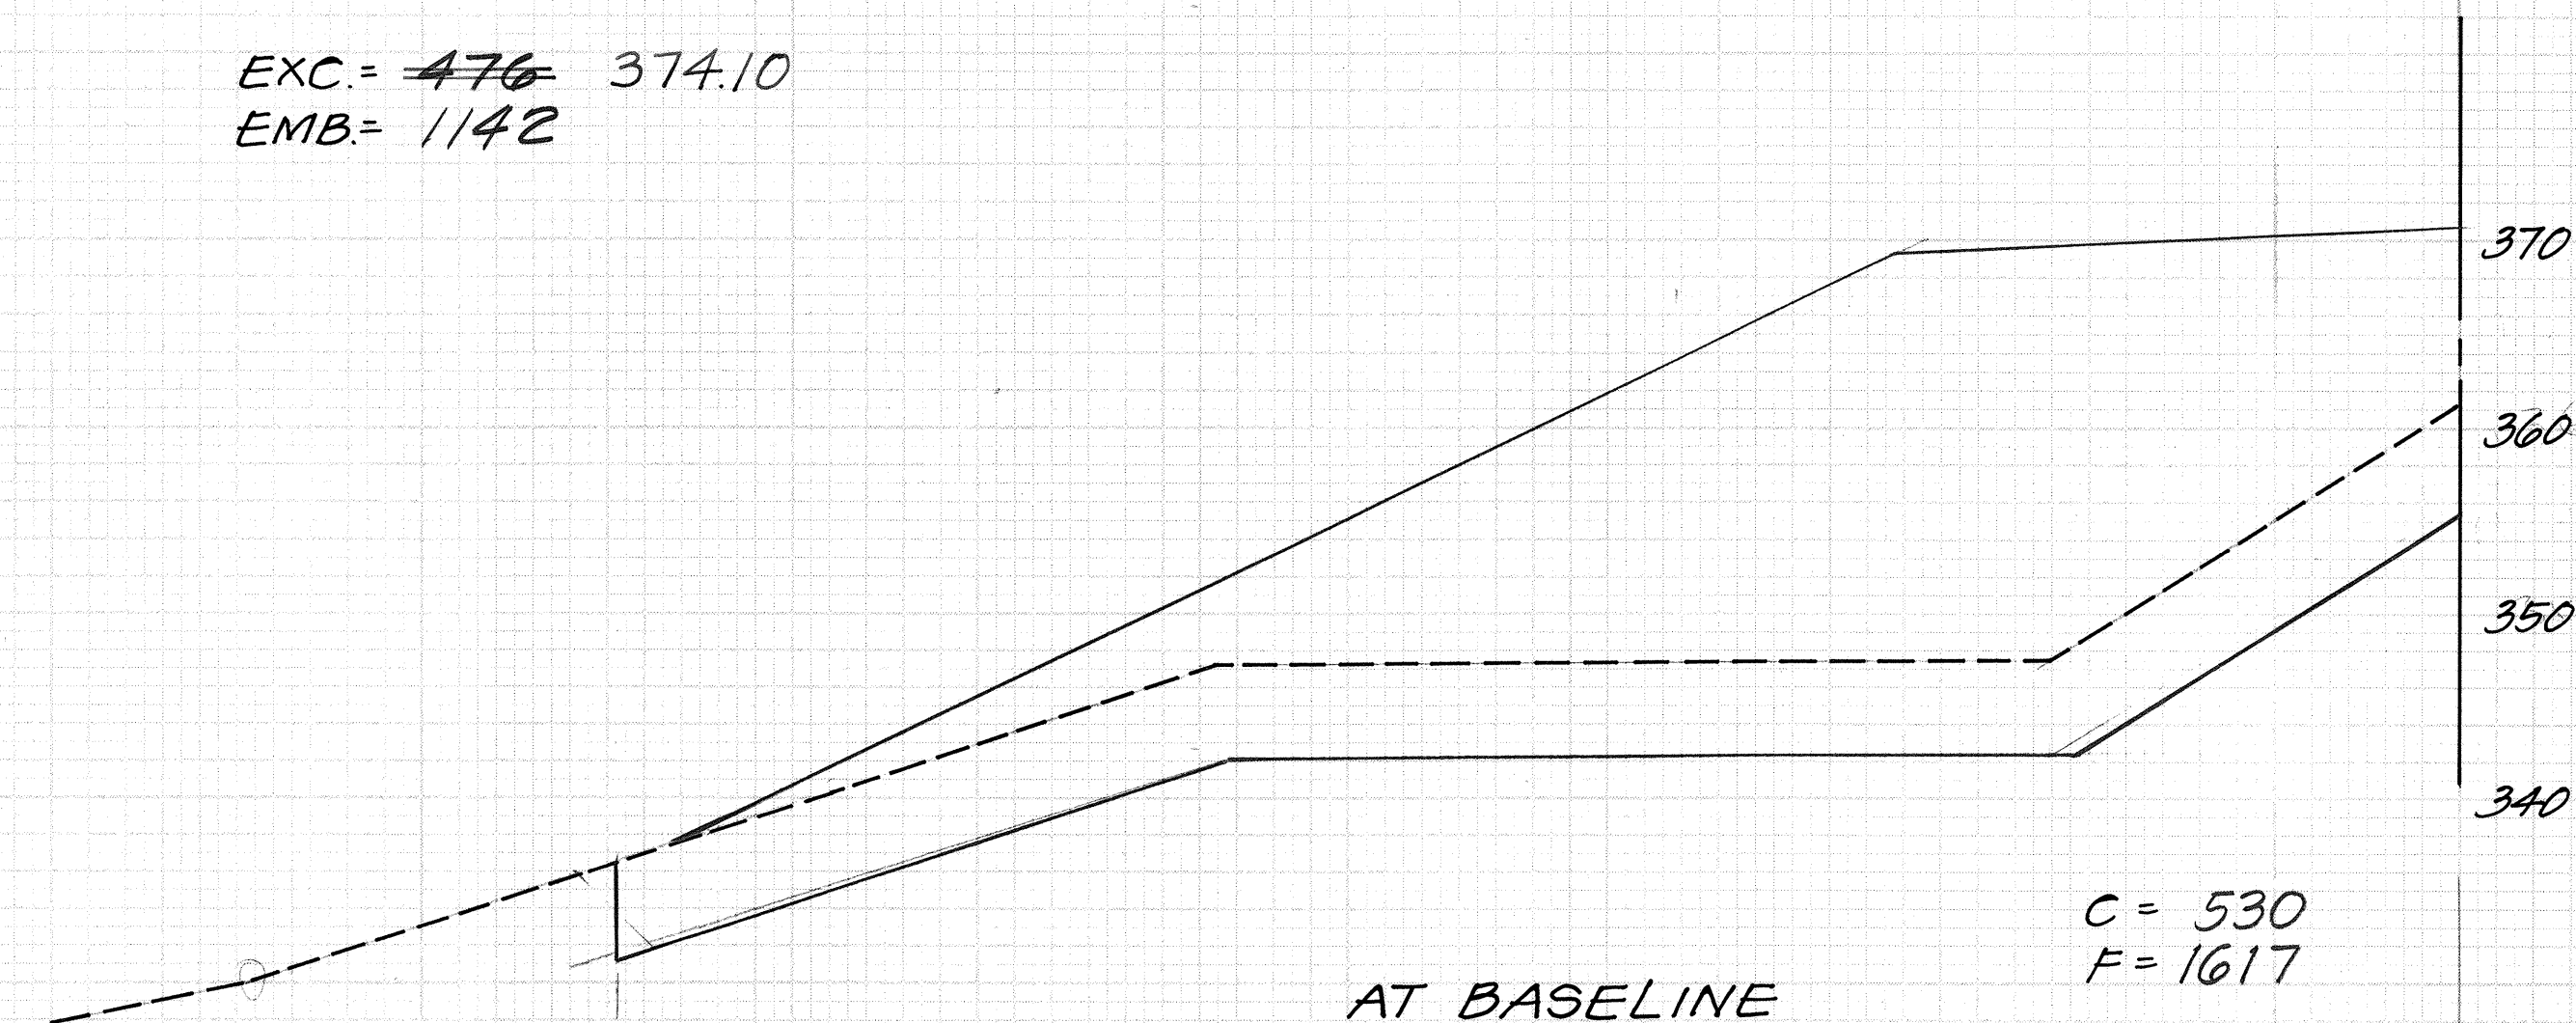

Exc. = ~~376~~ 471.10
EMB. = 1132

AT BASELINE

C = 530
F = 1617

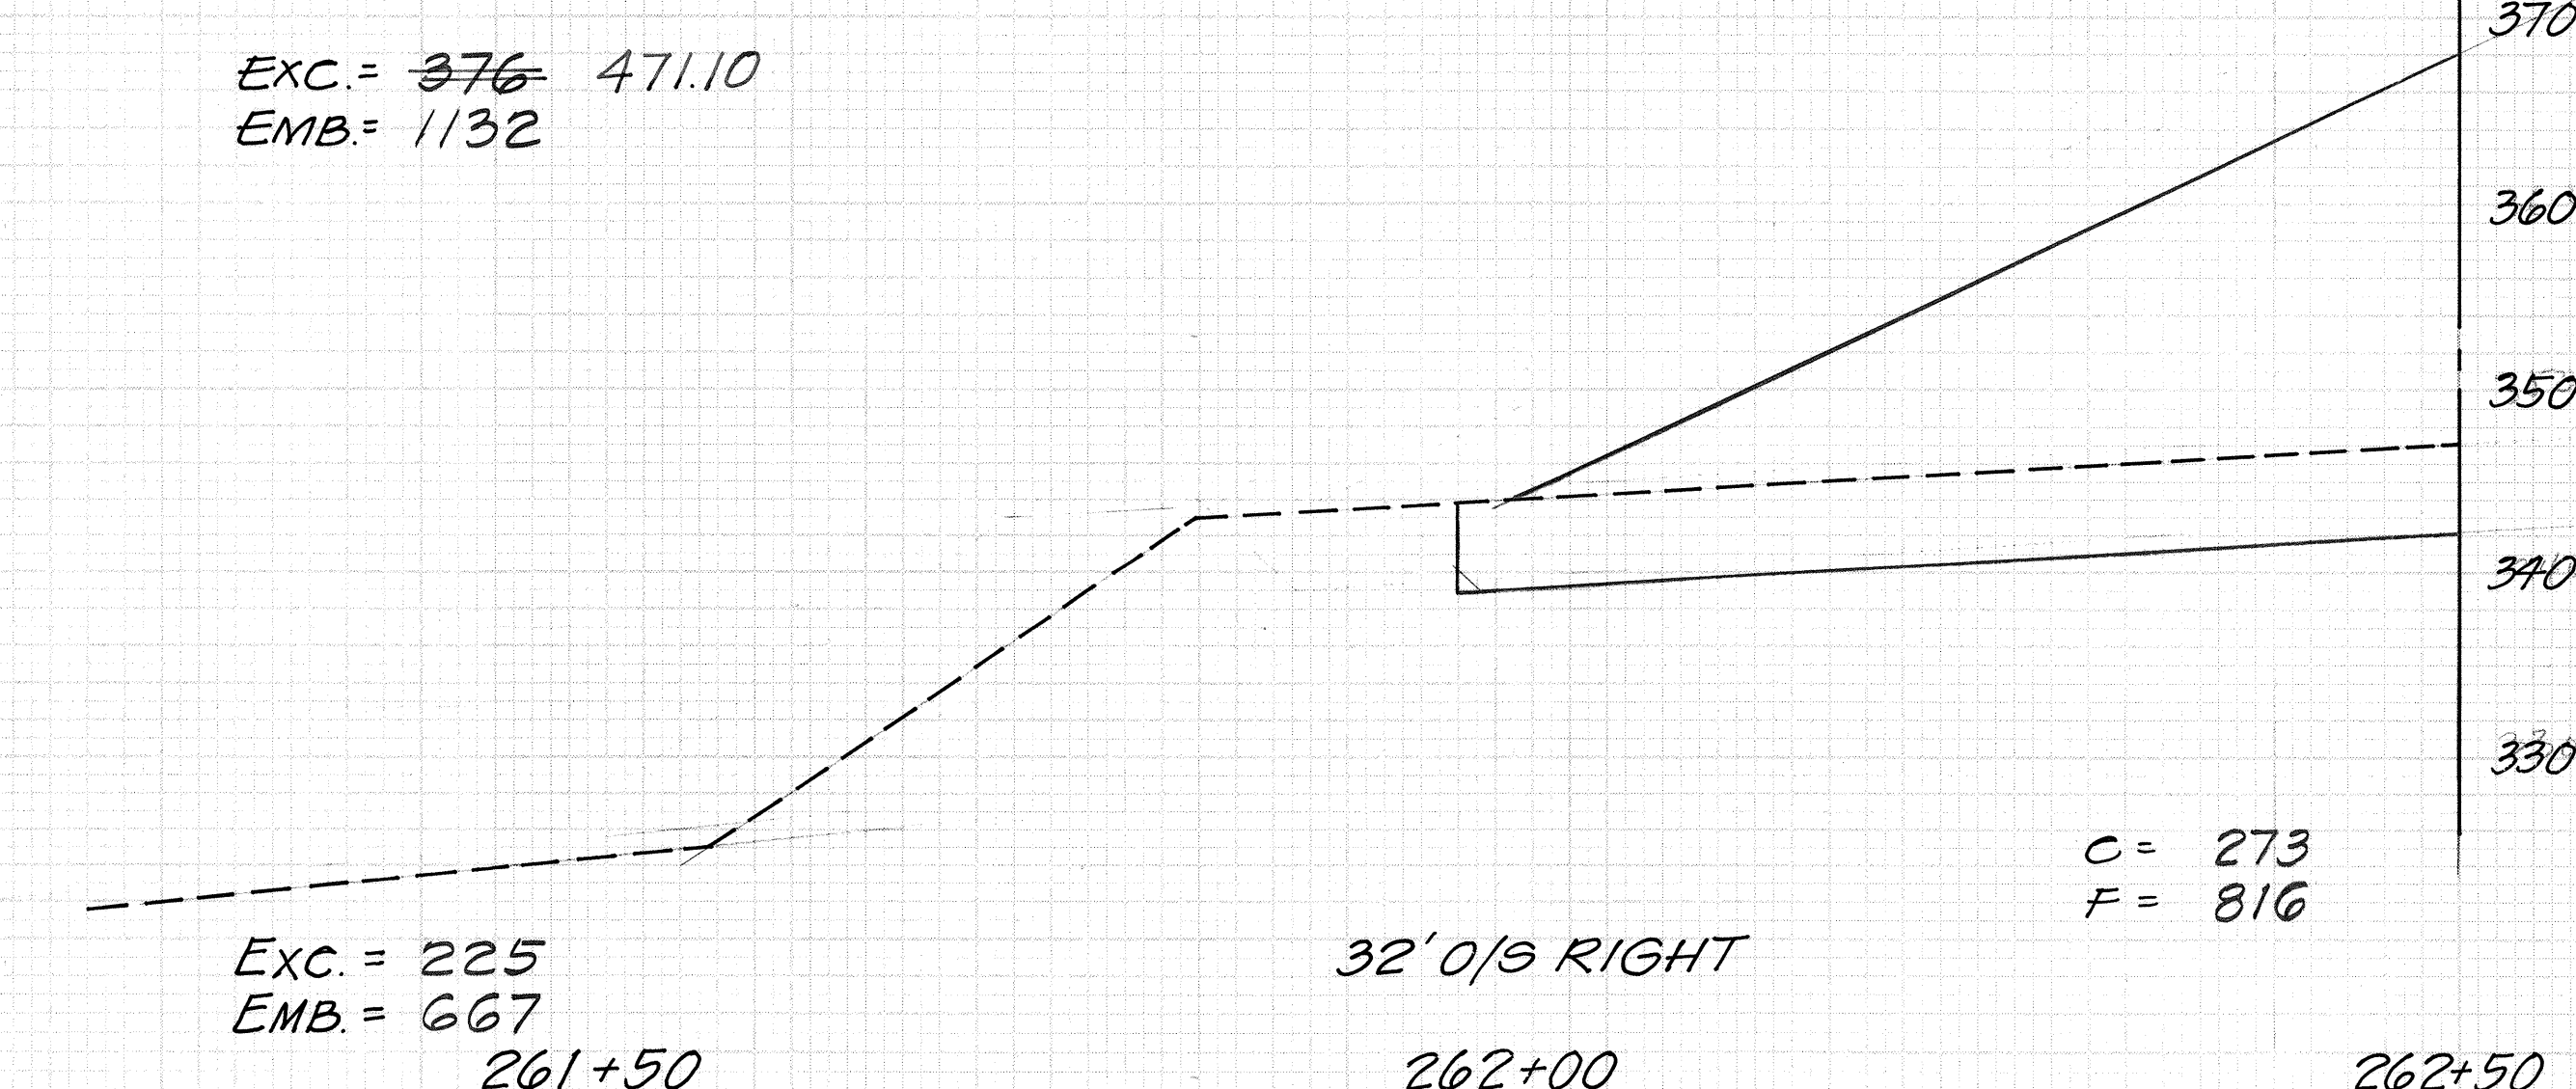

Exc. = 225
EMB. = 667

32' 0/3 RIGHT

C = 273
F = 816


261+50

262+00

262+50

FINAL	SURVEYED	BY	DATE
NO.	NO.		
NO.	NO.		
NO.	NO.		


ORIGINAL	SURVEYED	BY	DATE
NO.	NO.		
NO.	NO.		
NO.	NO.		

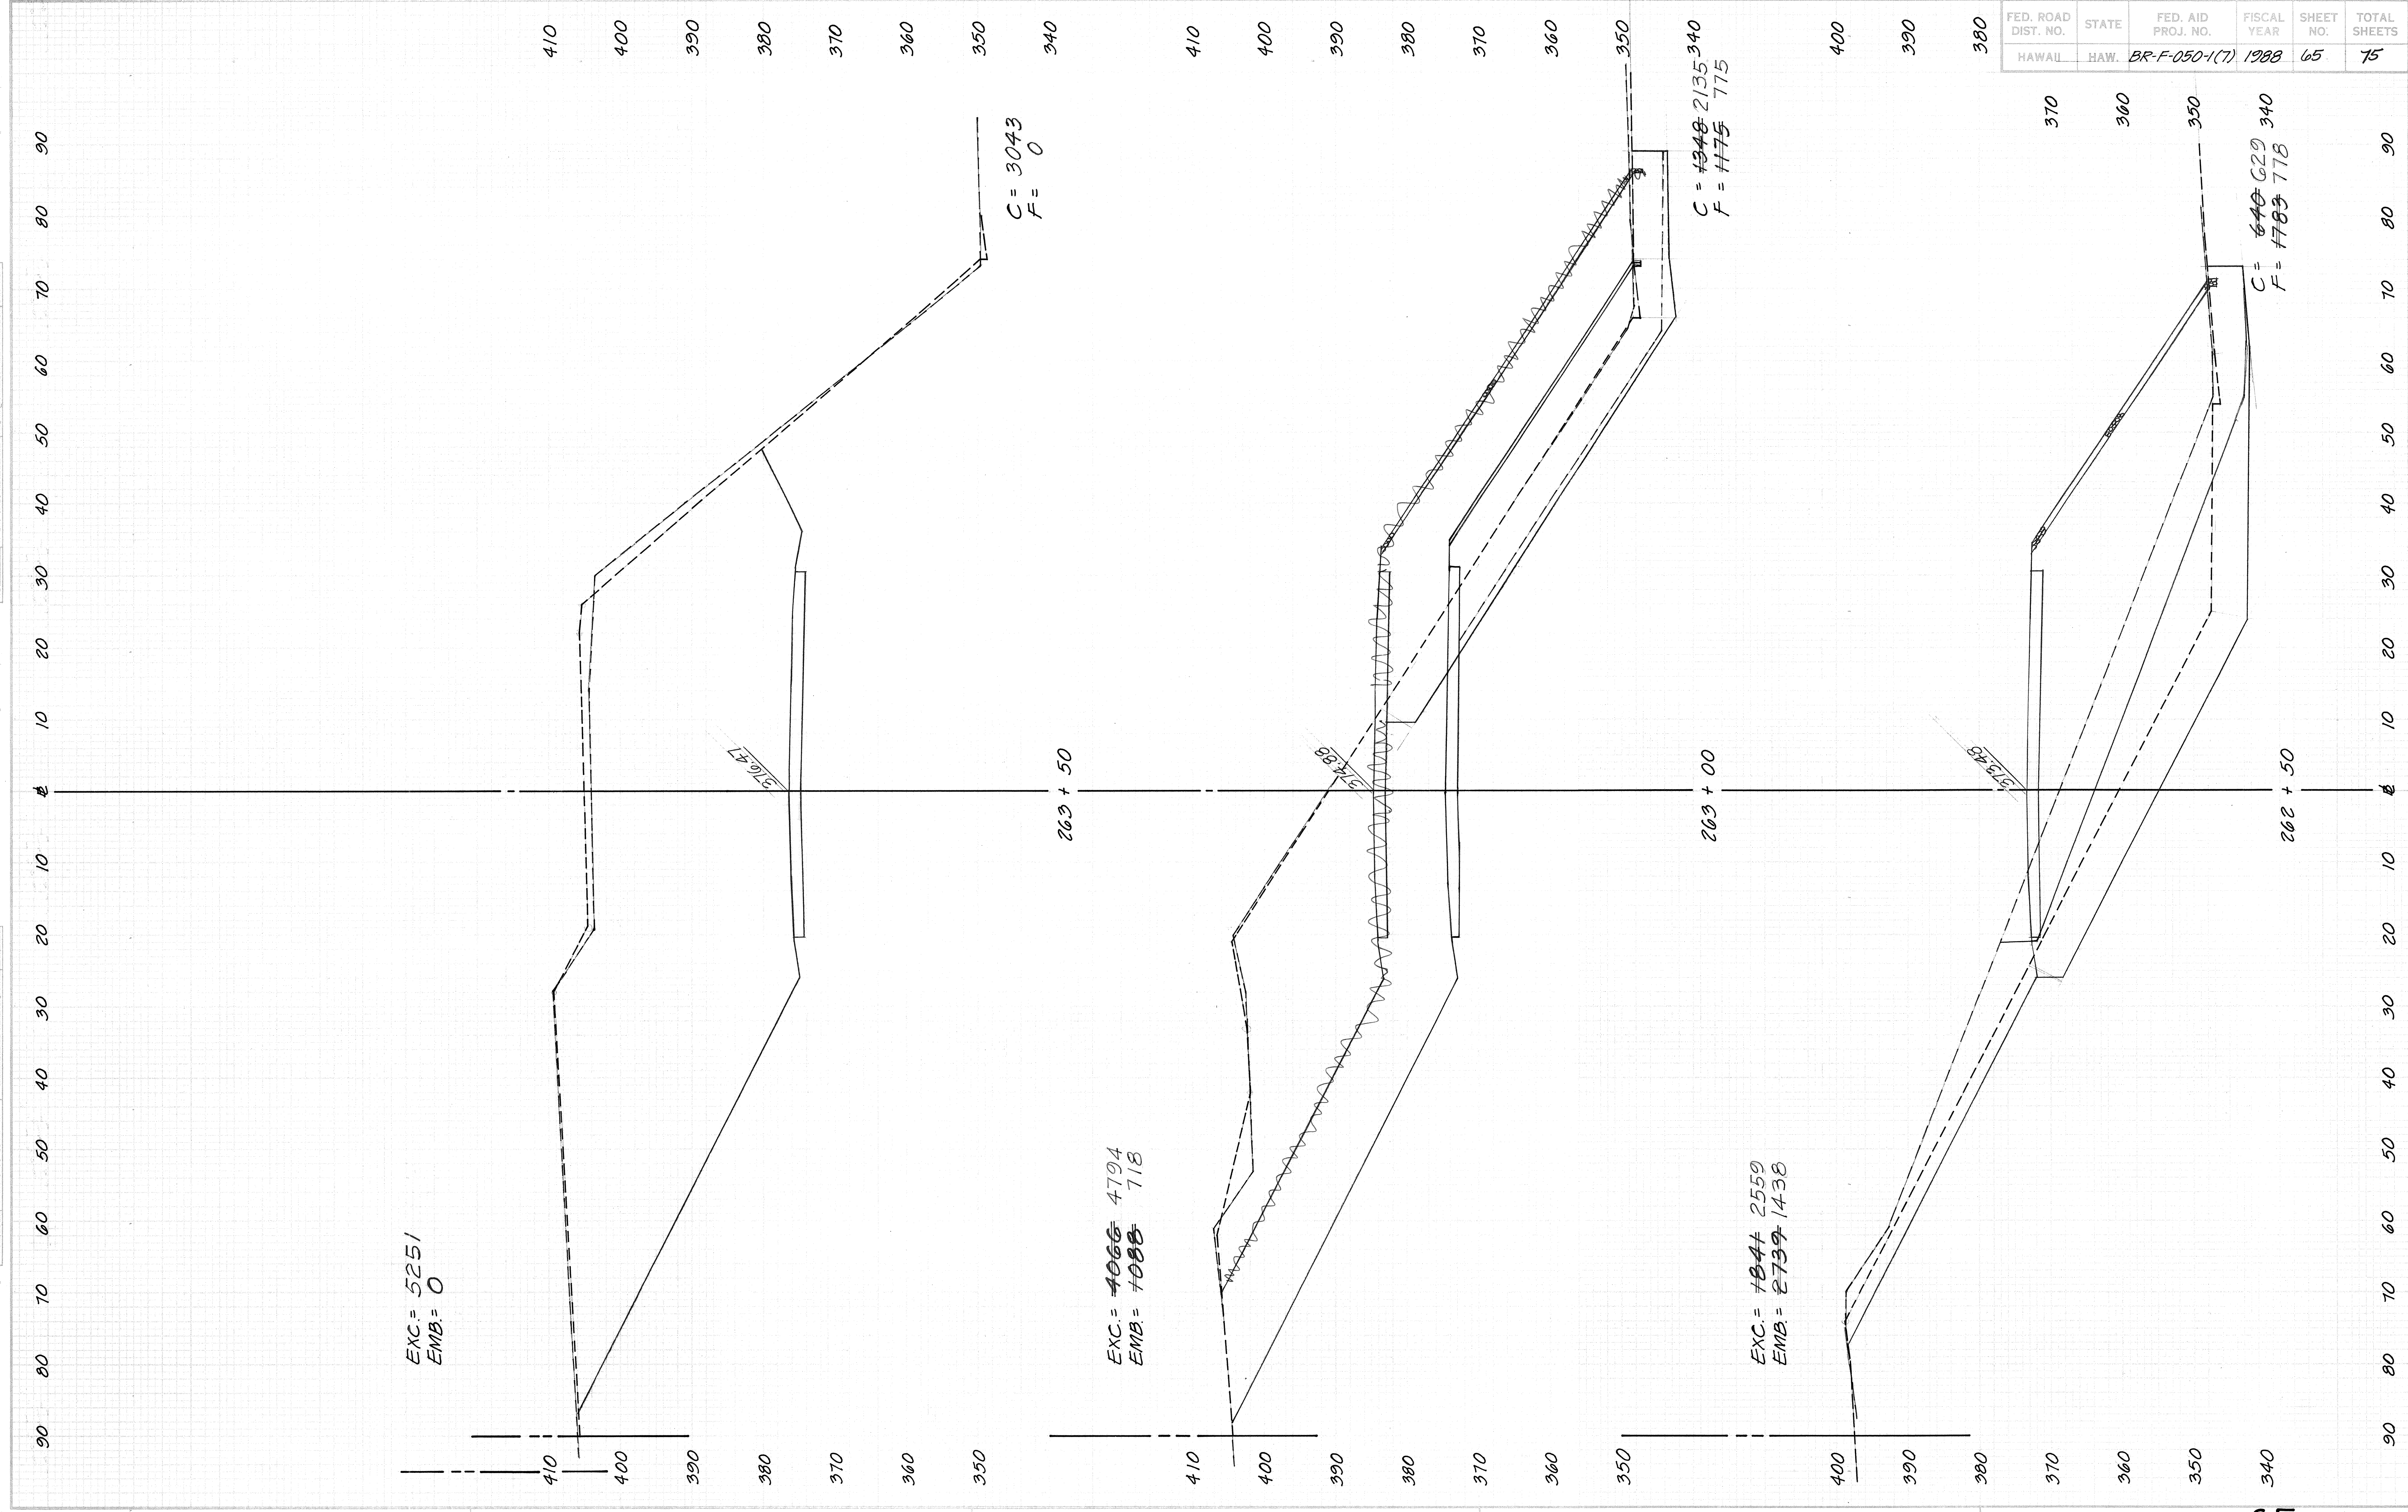

FED. ROAD DIST. NO.	STATE	FED. AID PROJ. NO.	FISCAL YEAR	SHEET NO.	TOTAL SHEETS
HAWAII	HAW.	BR-F-050-1(7)	1988	65	75

ORIGINAL SURVEY	SURVEYED	BY	DATE
NO.	NOTE BOOK	TEMP.	
	AREAS CHECKED		


FINAL SURVEY	SURVEYED	BY	DATE
NO.	NOTE BOOK	TEMP.	
	AREAS CHECKED		

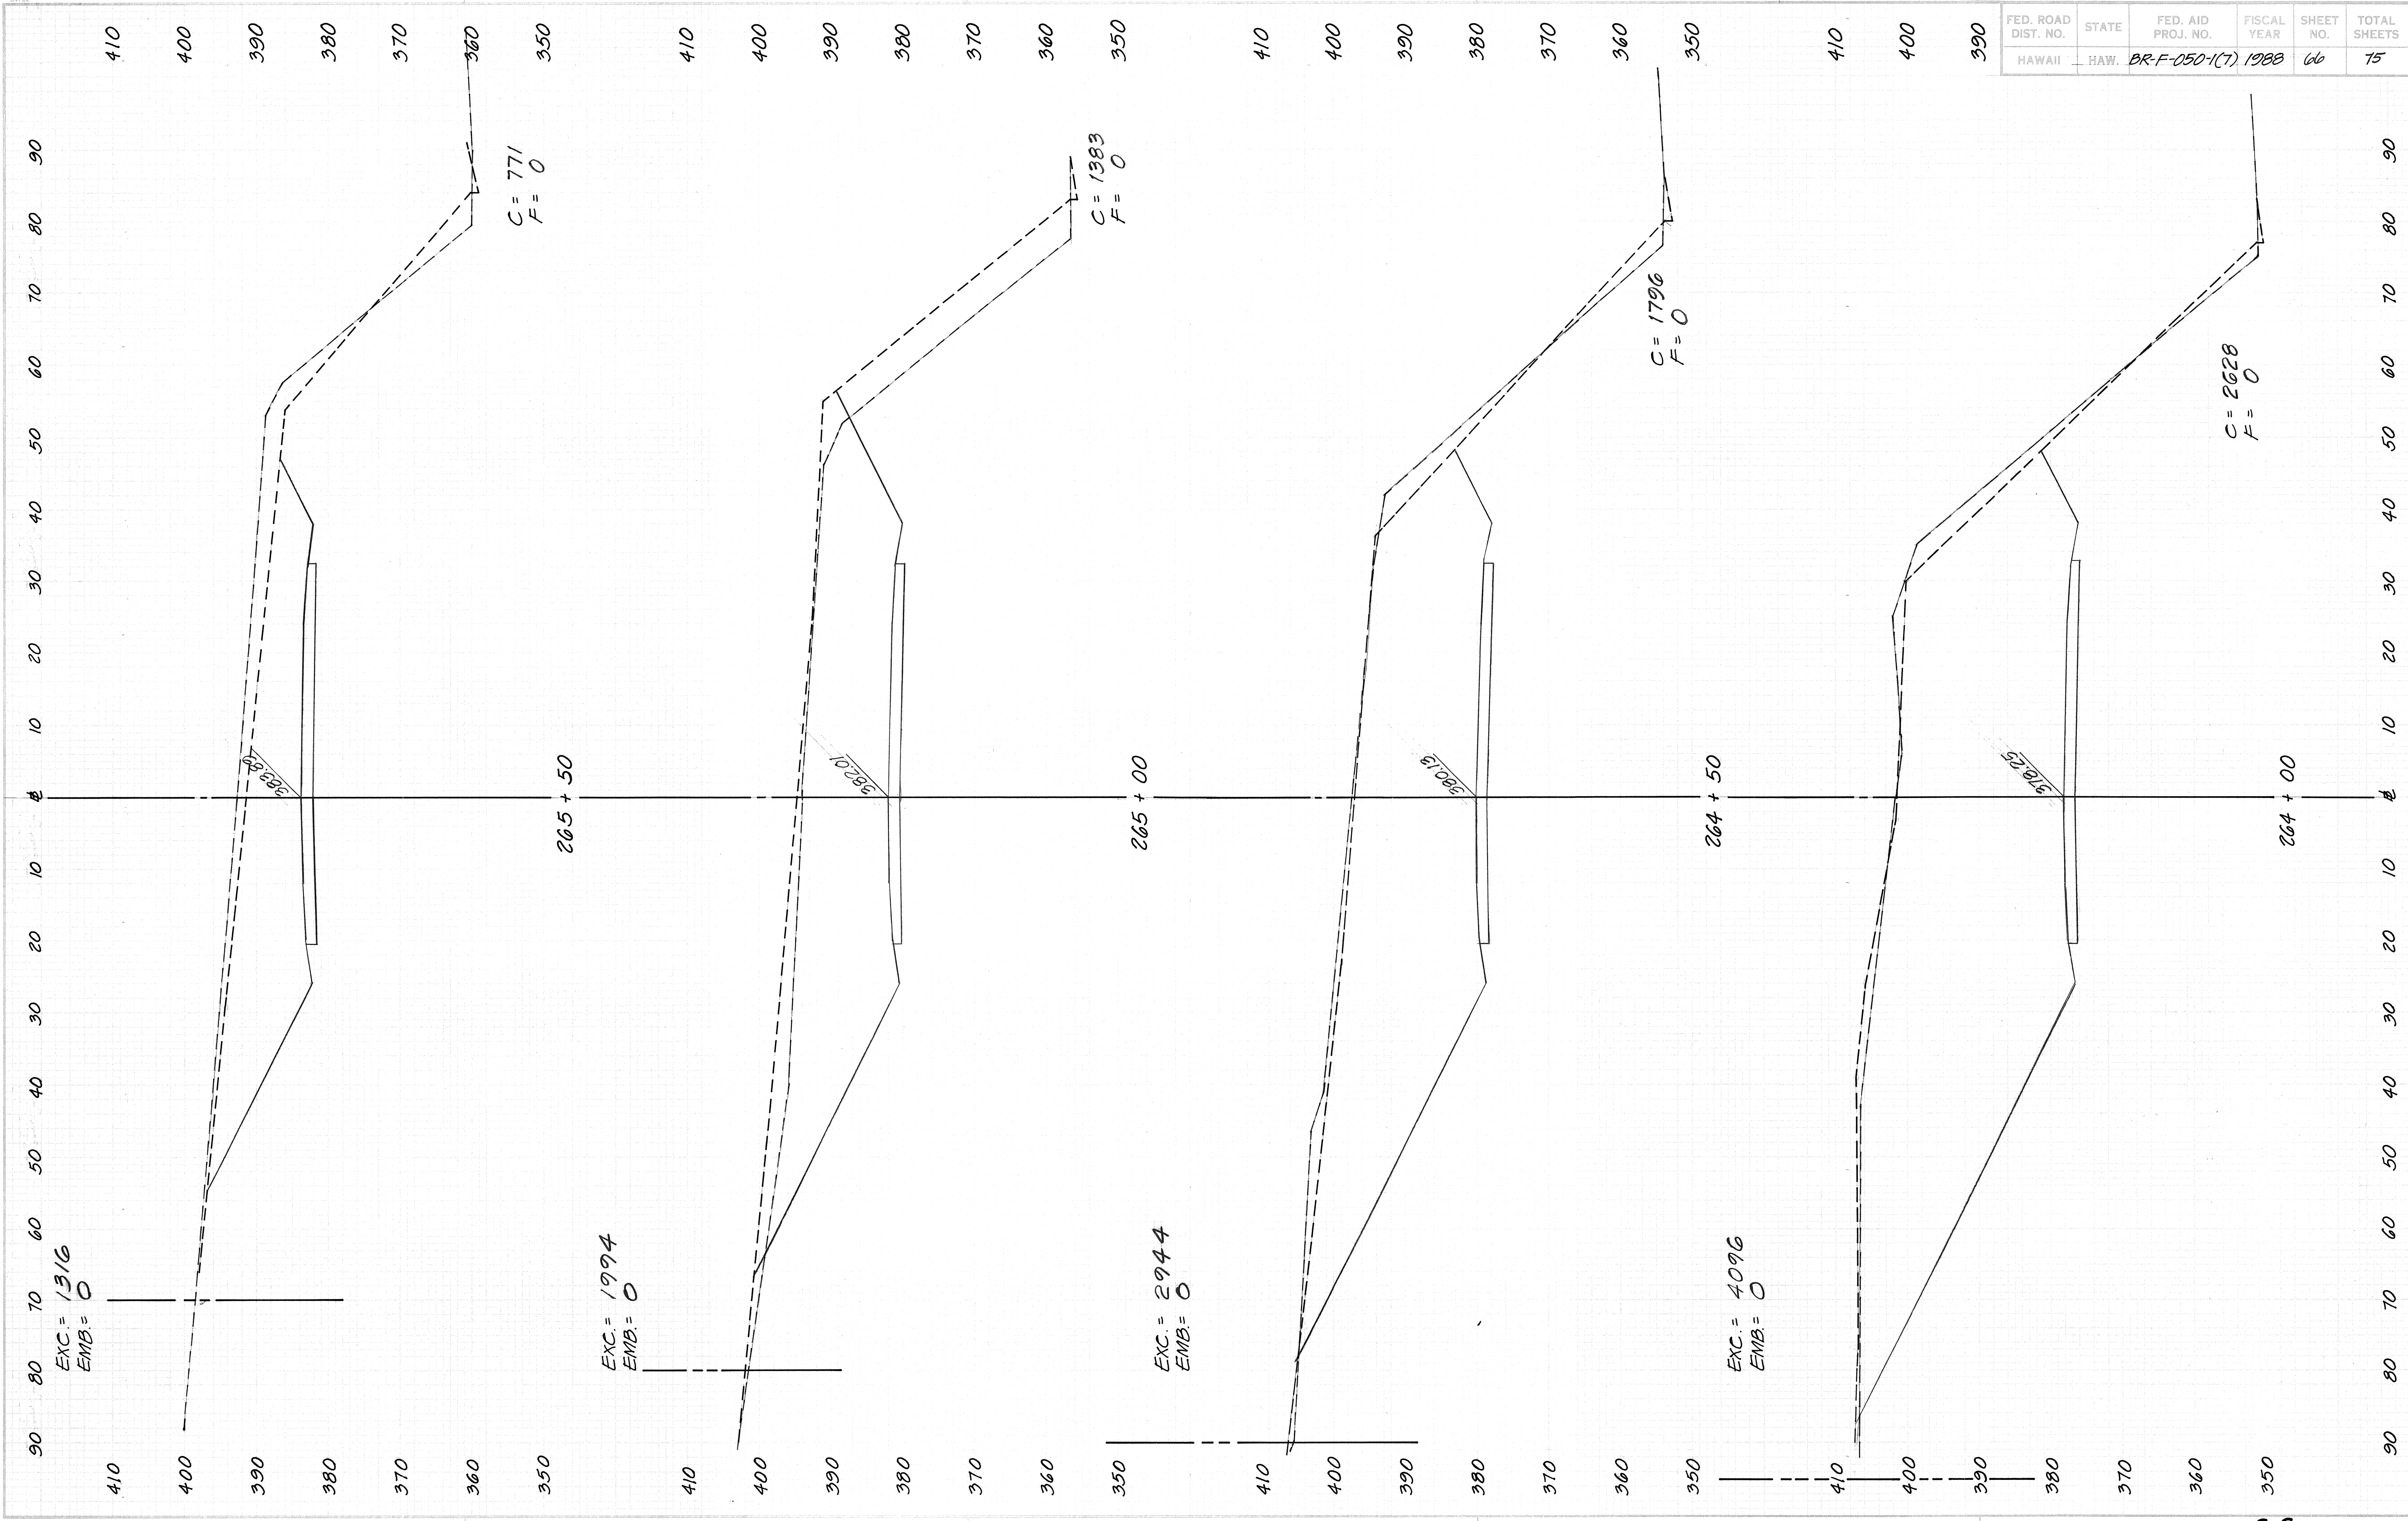

FED. ROAD DIST. NO.	STATE	FED. AID PROJ. NO.	FISCAL YEAR	SHEET NO.	TOTAL SHEETS
HAWAII	HAW.	BR-F-050-1(7)	1988	66	75

ORIGINAL	SURVEY	DATE
NO.	BY	
NOTE BOOK	AREAS	
NO.	AREAS CHECKED	


FINAL	SURVEY	DATE
NO.	BY	
NOTE BOOK	AREAS	
NO.	AREAS CHECKED	

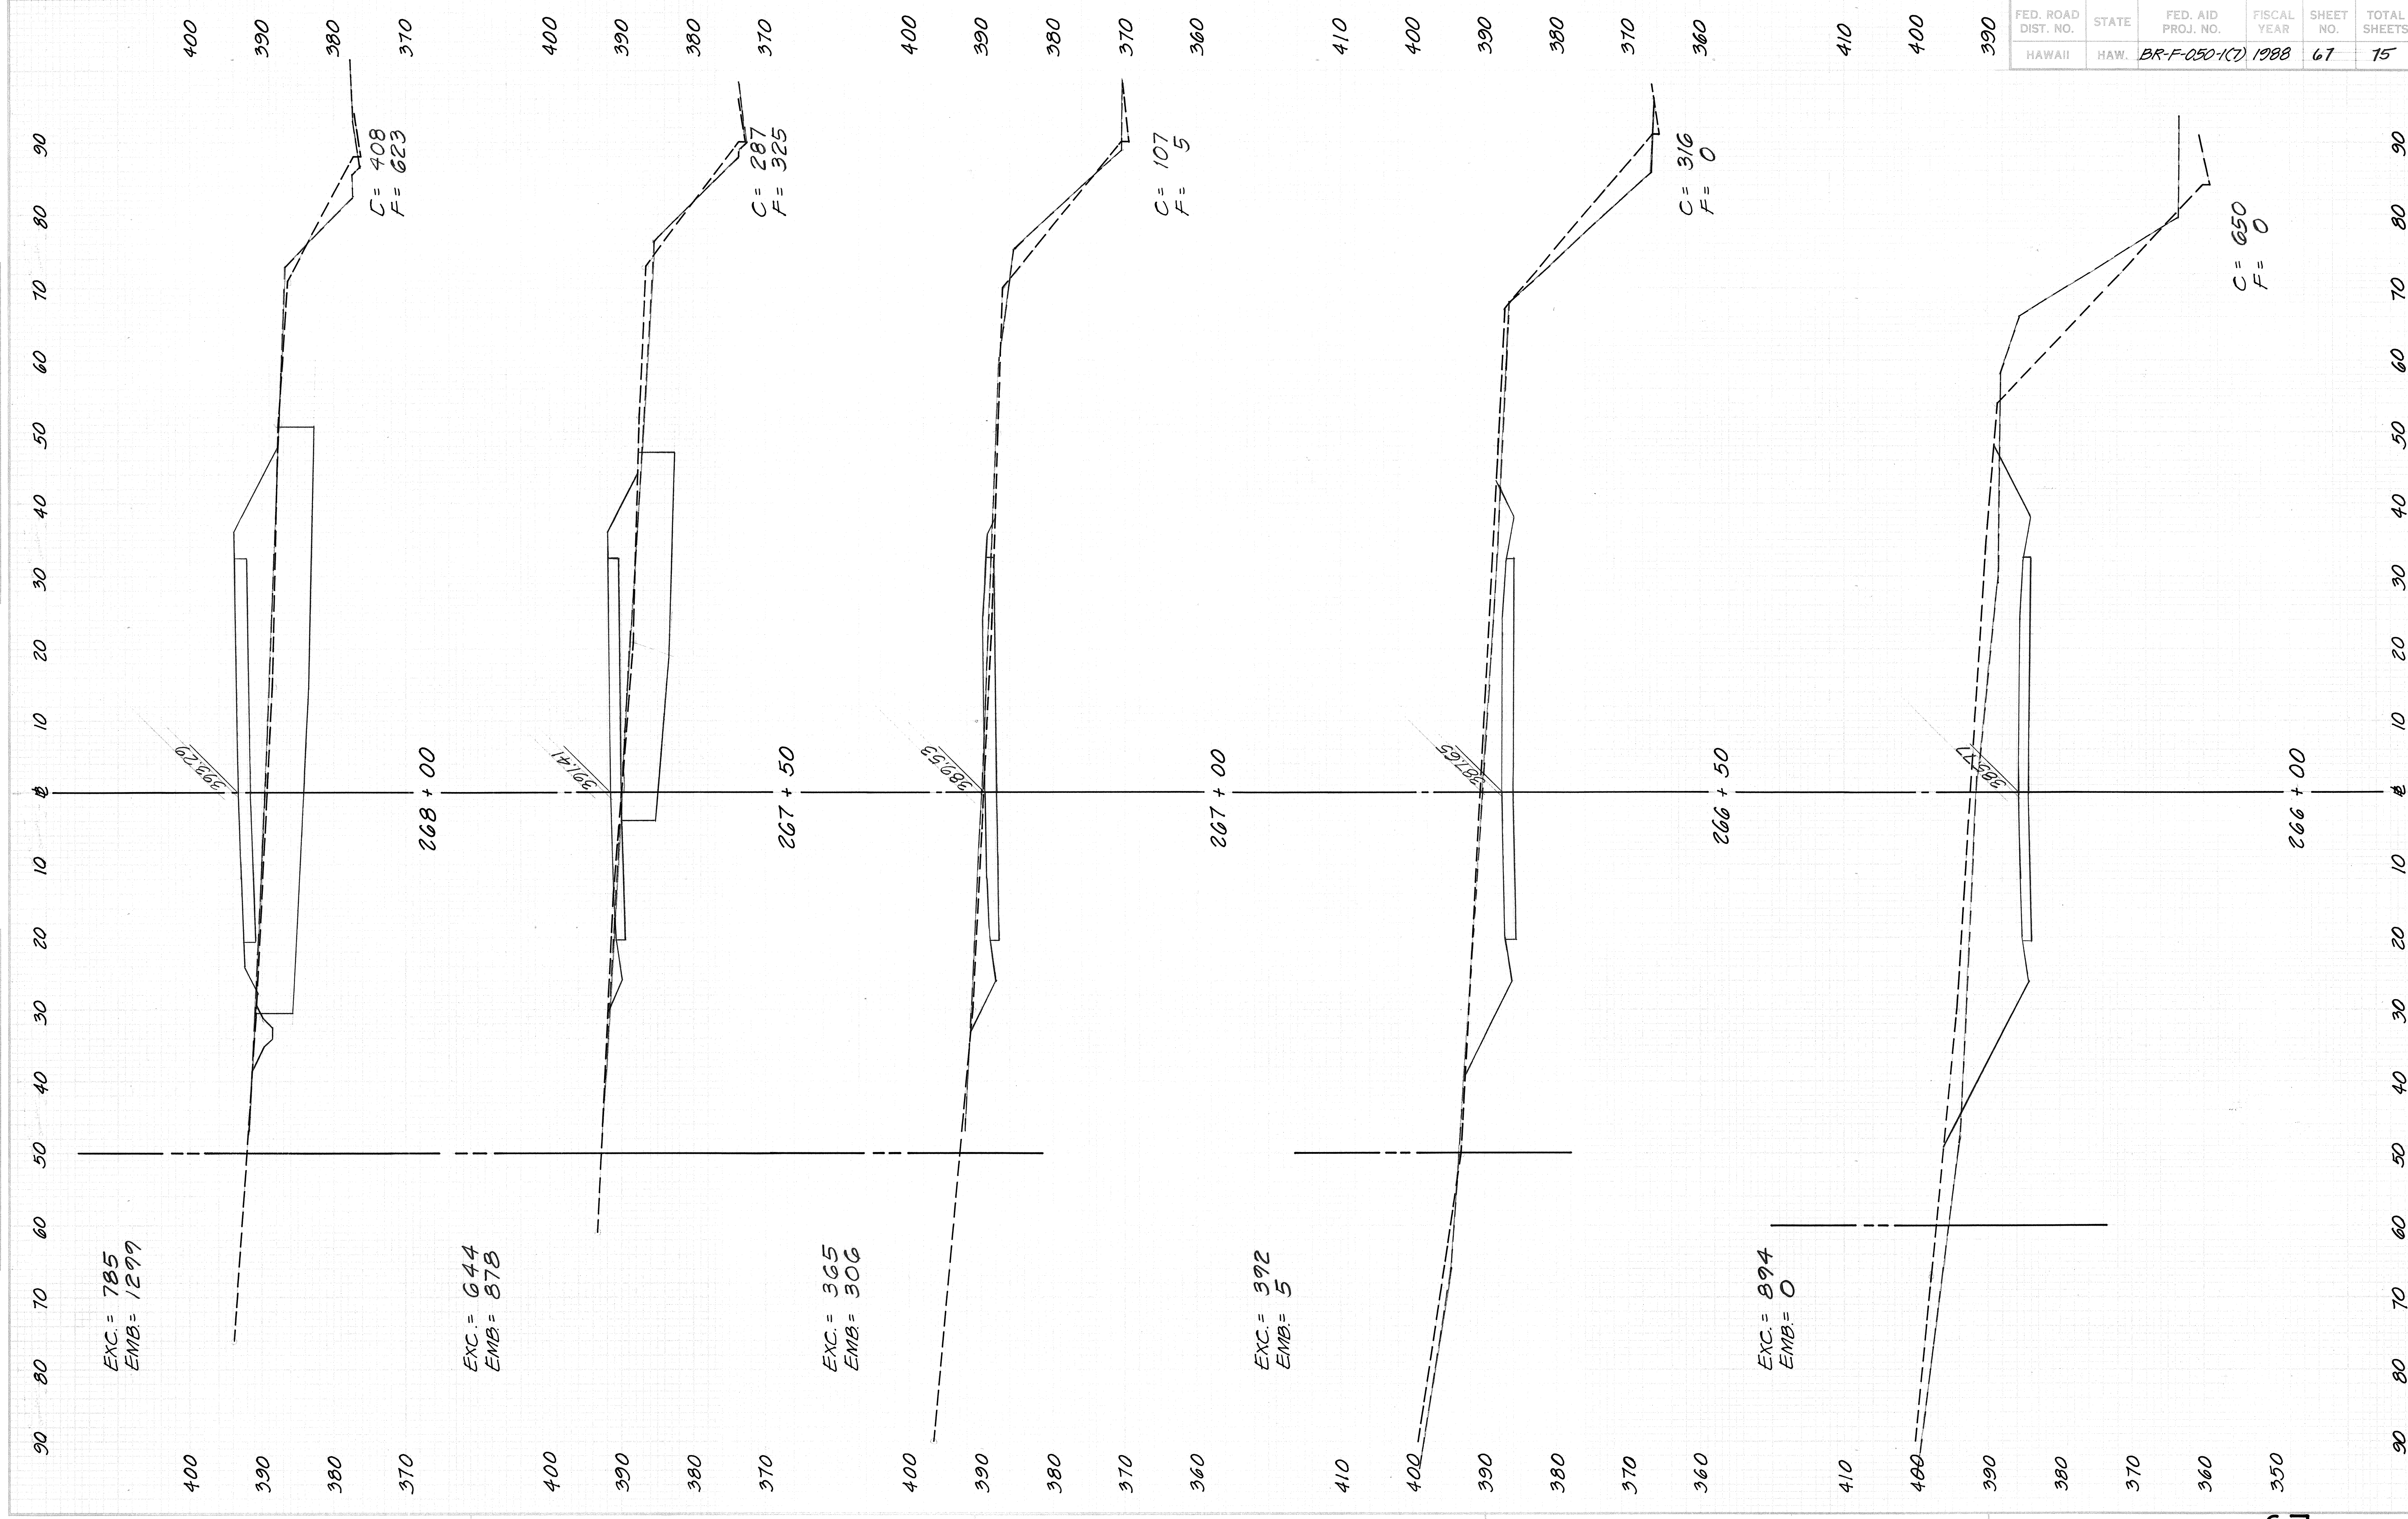

FED. ROAD DIST. NO.	STATE	FED. AID PROJ. NO.	FISCAL YEAR	SHEET NO.	TOTAL SHEETS
HAWAII	HAW.	BR-F-050-1(C)	1988	67	15

ORIGINAL SURVEY	SURVEYED	BY	DATE
NOTE BOOK	NO.		
AREAS CHECKED			


FINAL SURVEY	SURVEYED	BY	DATE
NOTE BOOK	NO.		
AREAS CHECKED			

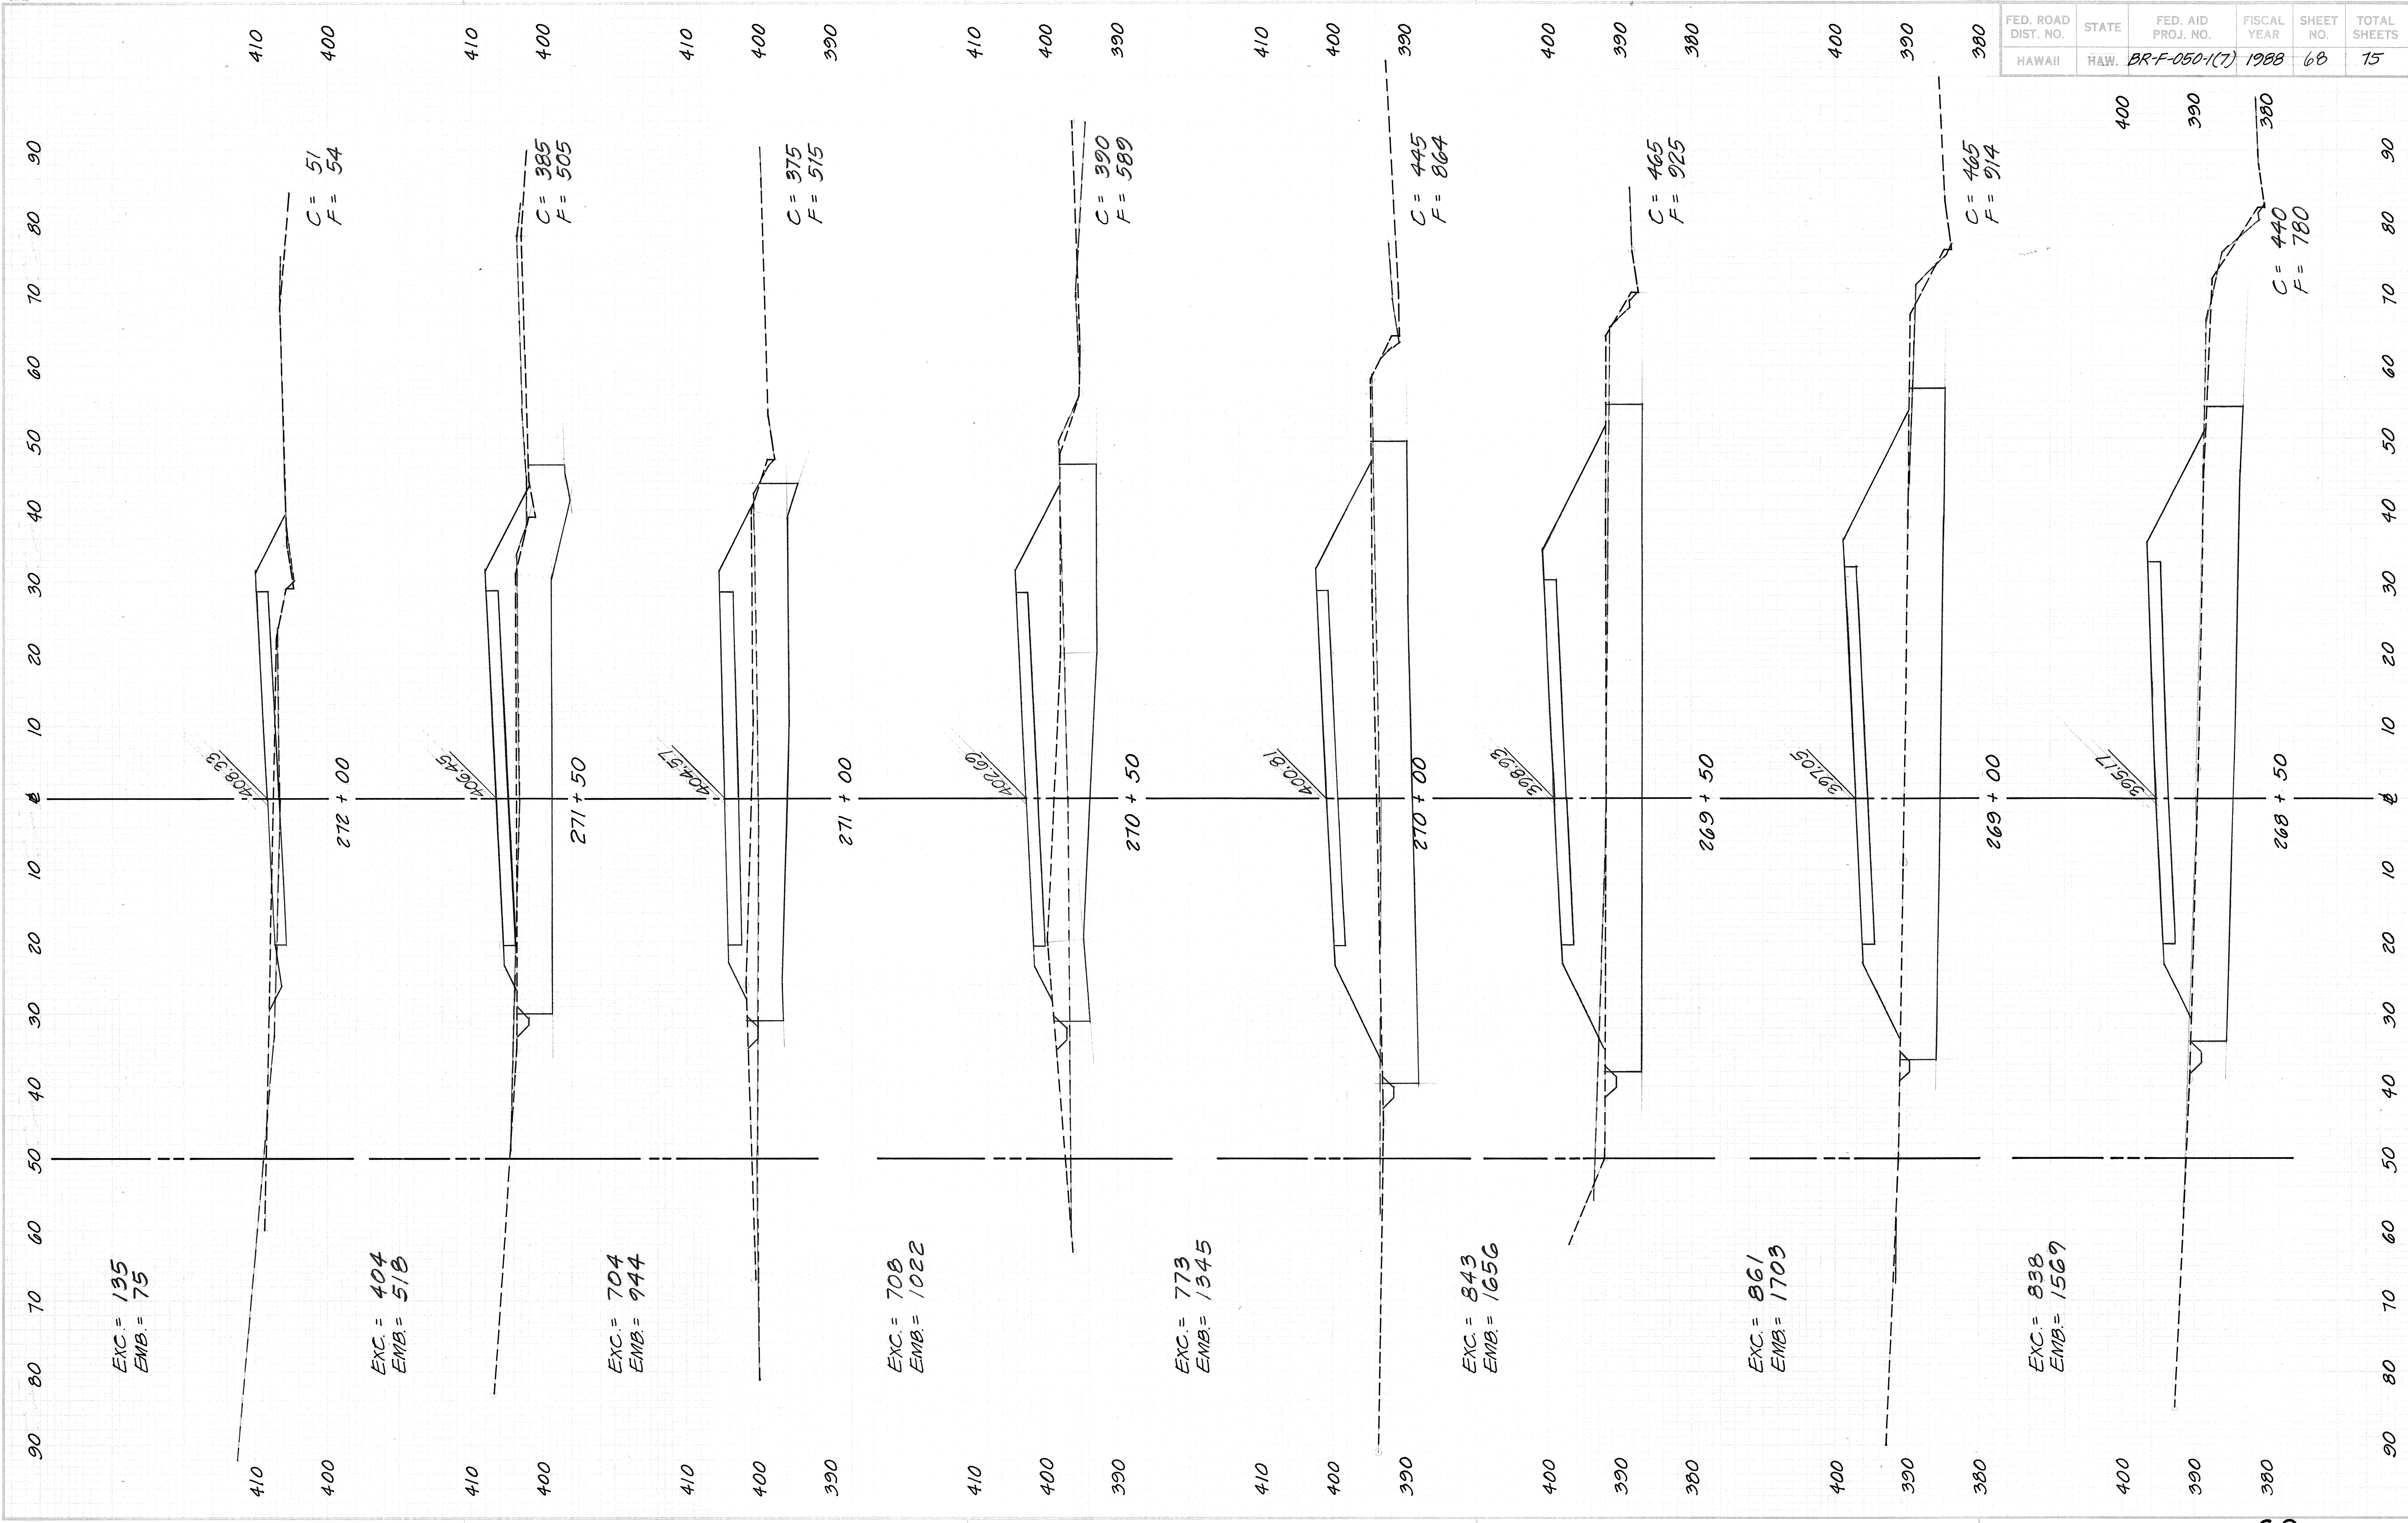

FED. ROAD DIST. NO.	STATE	FED. AID PROJ. NO.	FISCAL YEAR	SHEET NO.	TOTAL SHEETS
HAWAII	HAW.	BR-F-050-1(7)	1988	68	15

ORIGINAL	SURVEYED	DATE
SURVEY	PLOTTED	
NOTE BOOK	REMARKS	
NO.	AREAS CHECKED	


FINAL	SURVEYED	DATE
SURVEY	PLOTTED	
NOTE BOOK	REMARKS	
NO.	AREAS CHECKED	

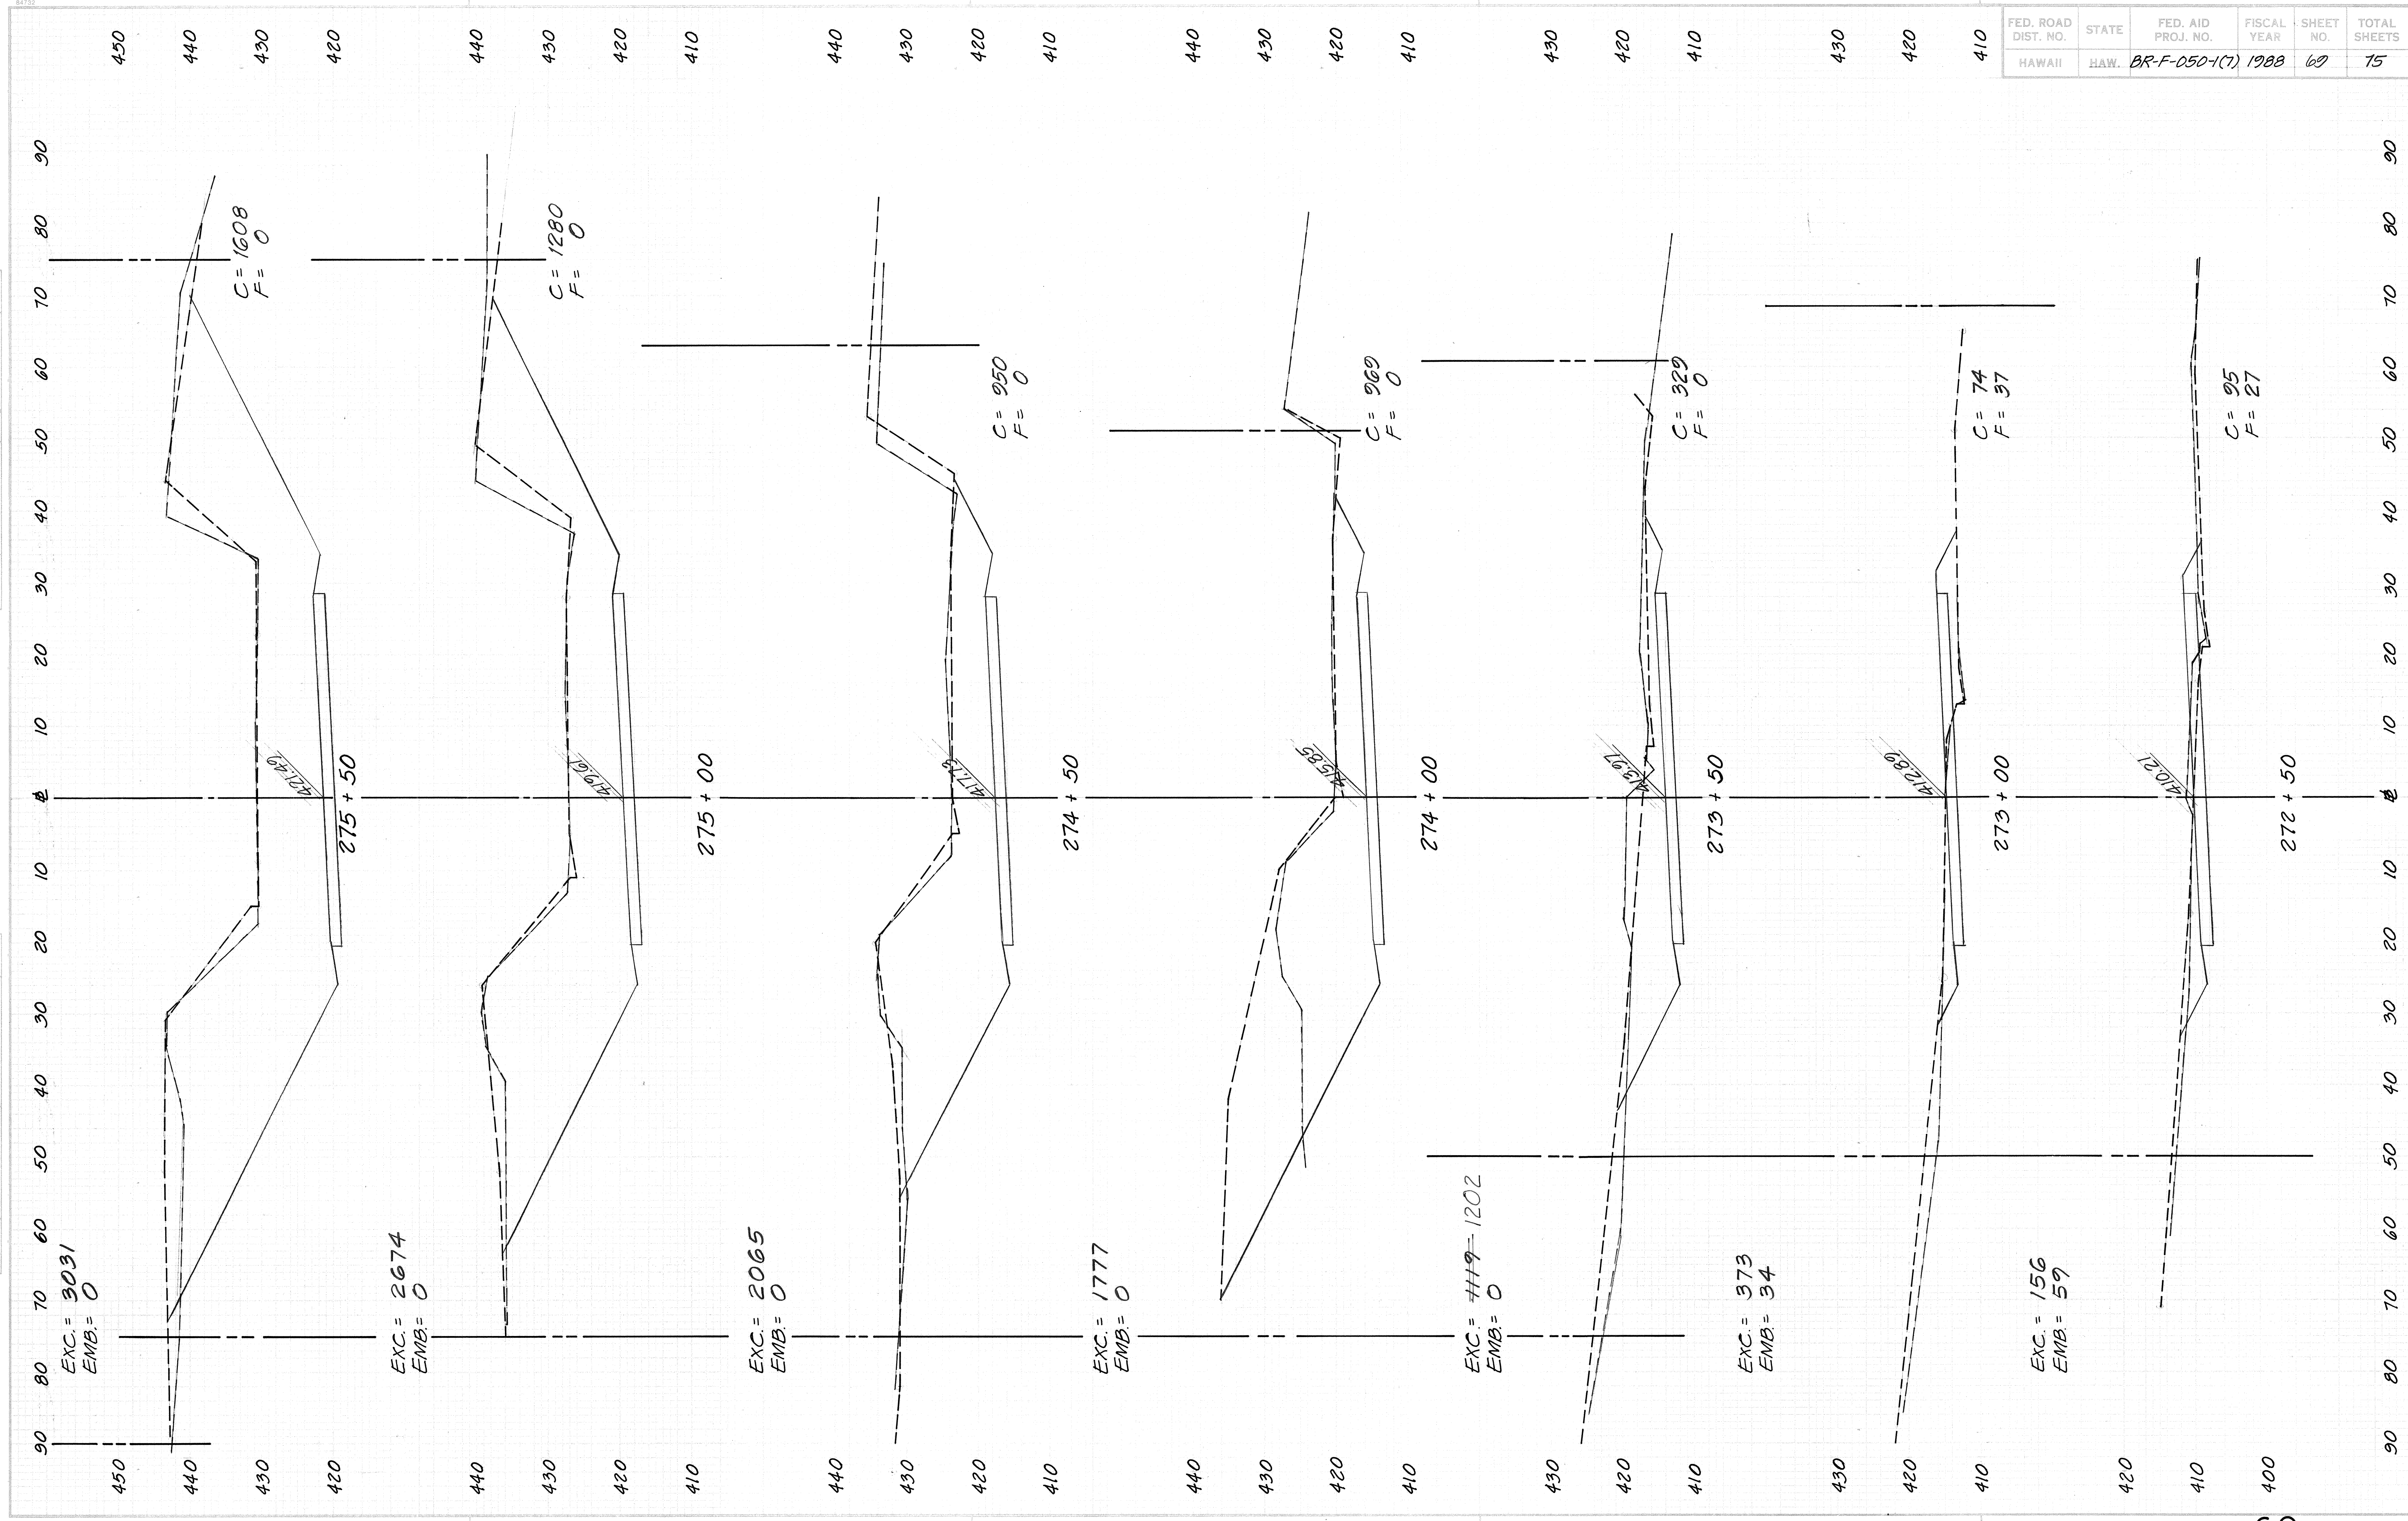

FED. ROAD DIST. NO.	STATE	FED. AID PROJ. NO.	FISCAL YEAR	SHEET NO.	TOTAL SHEETS
HAWAII	HAW.	BR-F-050-1(7)	1988	69	75

ORIGINAL	SURVEYED	BY	DATE
SURVEY	PLOTTED		
NOTE BOOK	DATE		
NO.	AREAS CHECKED		


FINAL	SURVEYED	BY	DATE
SURVEY	PLOTTED		
NOTE BOOK	DATE		
NO.	AREAS CHECKED		

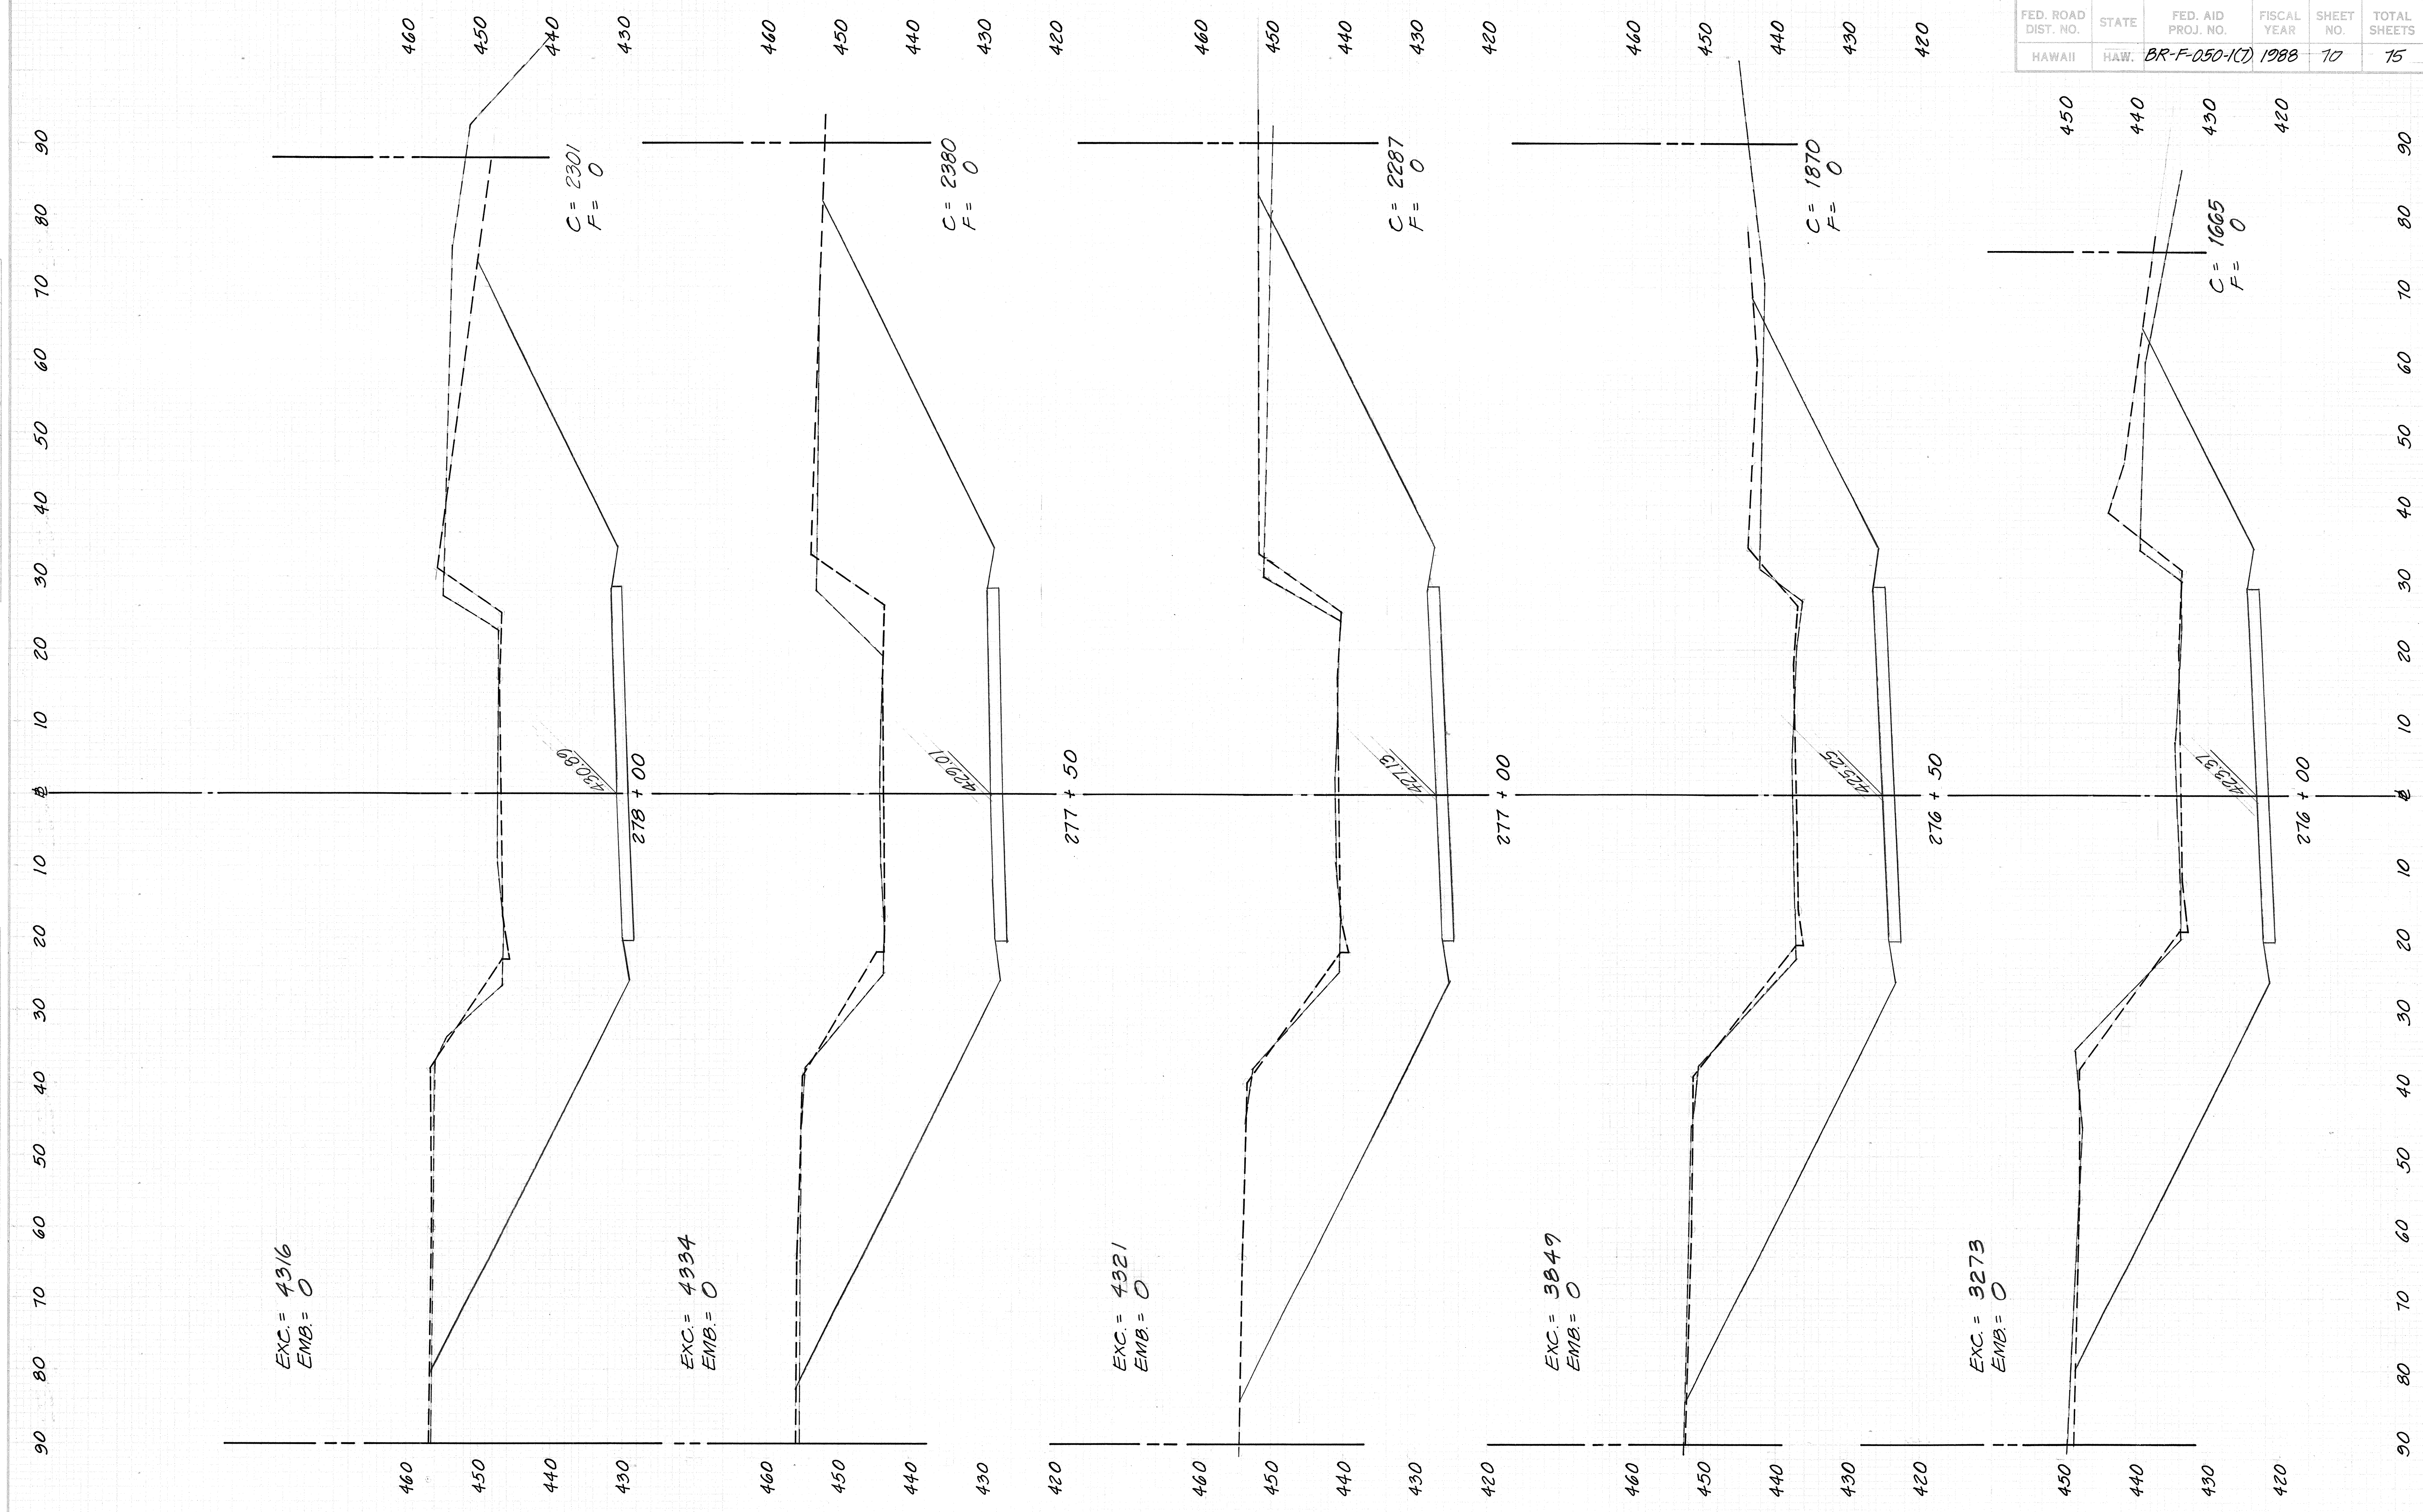

FED. ROAD DIST. NO.	STATE	FED. AID PROJ. NO.	FISCAL YEAR	SHEET NO.	TOTAL SHEETS
HAWAII	HAW.	BR-F-050-1C7	1988	70	75

ORIGINAL	SURVEYED	BY	DATE
SURVEY	PLOTTED		
NOTE BOOK	TEMPLATE		
NO.	AREAS CHECKED		


FINAL	SURVEYED	BY	DATE
SURVEY	PLOTTED		
NOTE BOOK	TEMPLATE		
NO.	AREAS CHECKED		

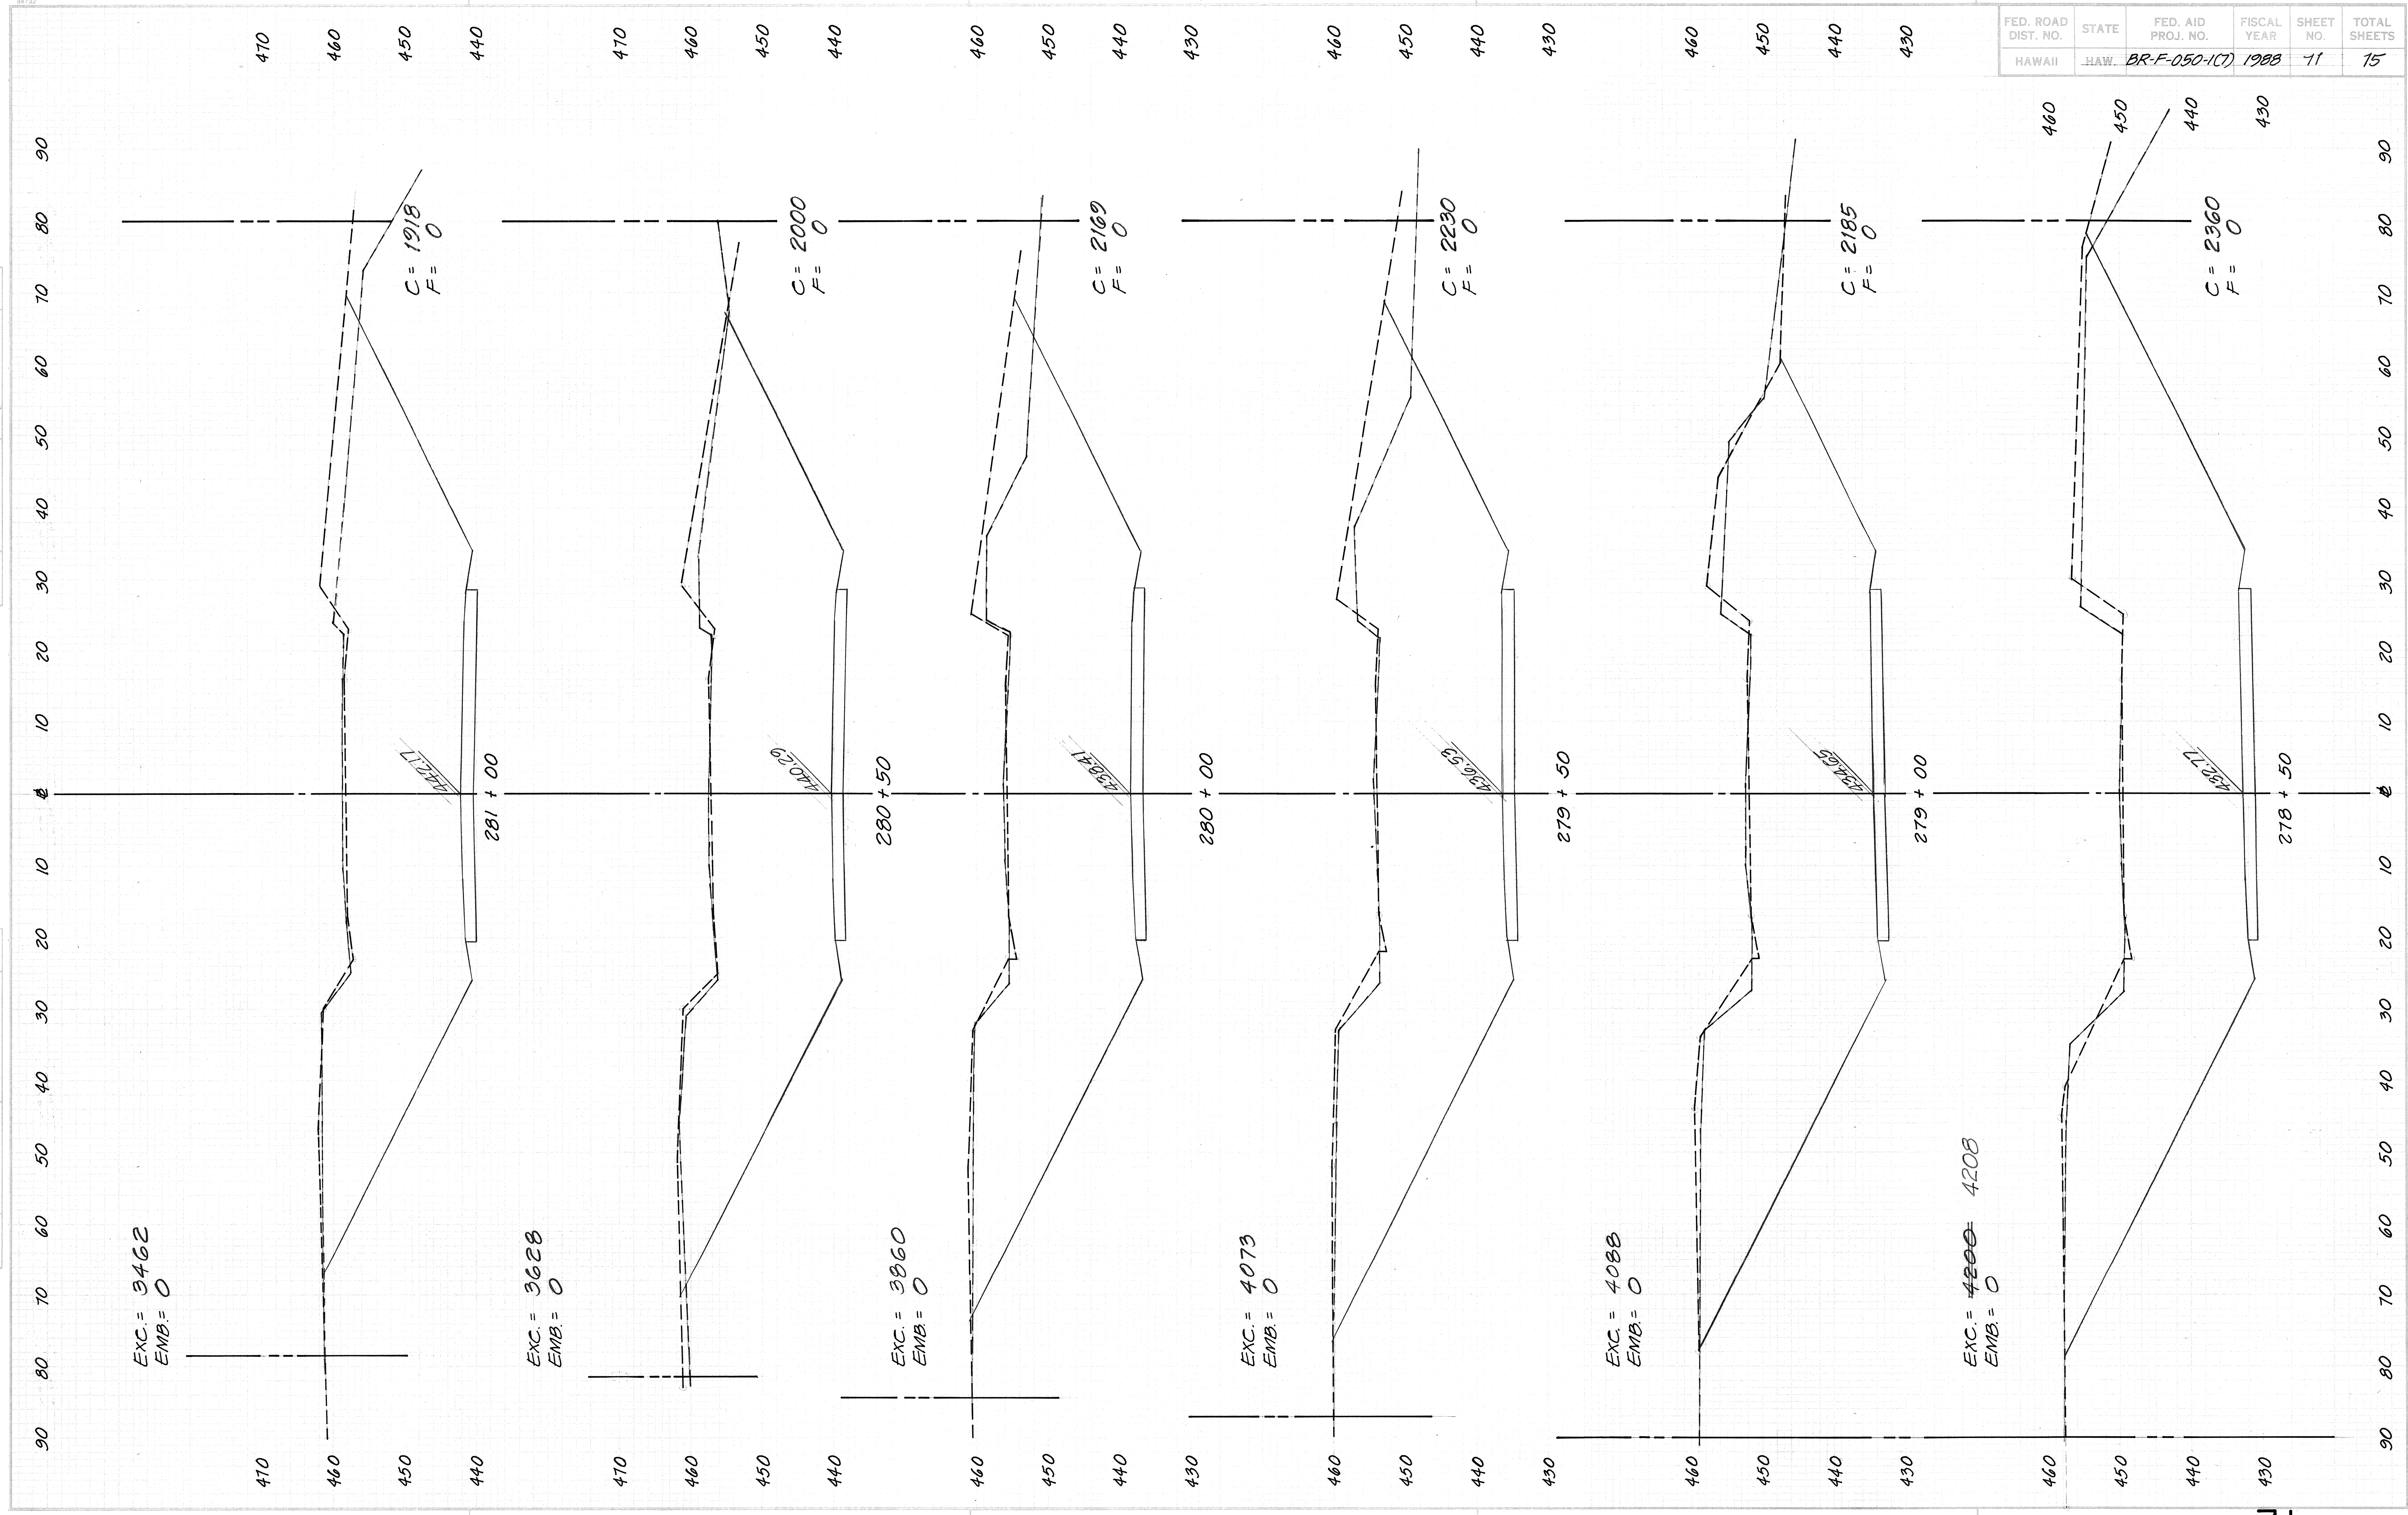

FED. ROAD DIST. NO.	STATE	FED. AID PROJ. NO.	FISCAL YEAR	SHEET NO.	TOTAL SHEETS
HAWAII	HAW.	BR-F-050-1(7)	1988	71	15

ORIGINAL SURVEY	SURVEYED	BY	DATE
NOTE BOOK	PLOTTED		
NO.	DATE		
	AREAS CHECKED		


FINAL SURVEY	SURVEYED	BY	DATE
NOTE BOOK	PLOTTED		
NO.	DATE		
	AREAS CHECKED		

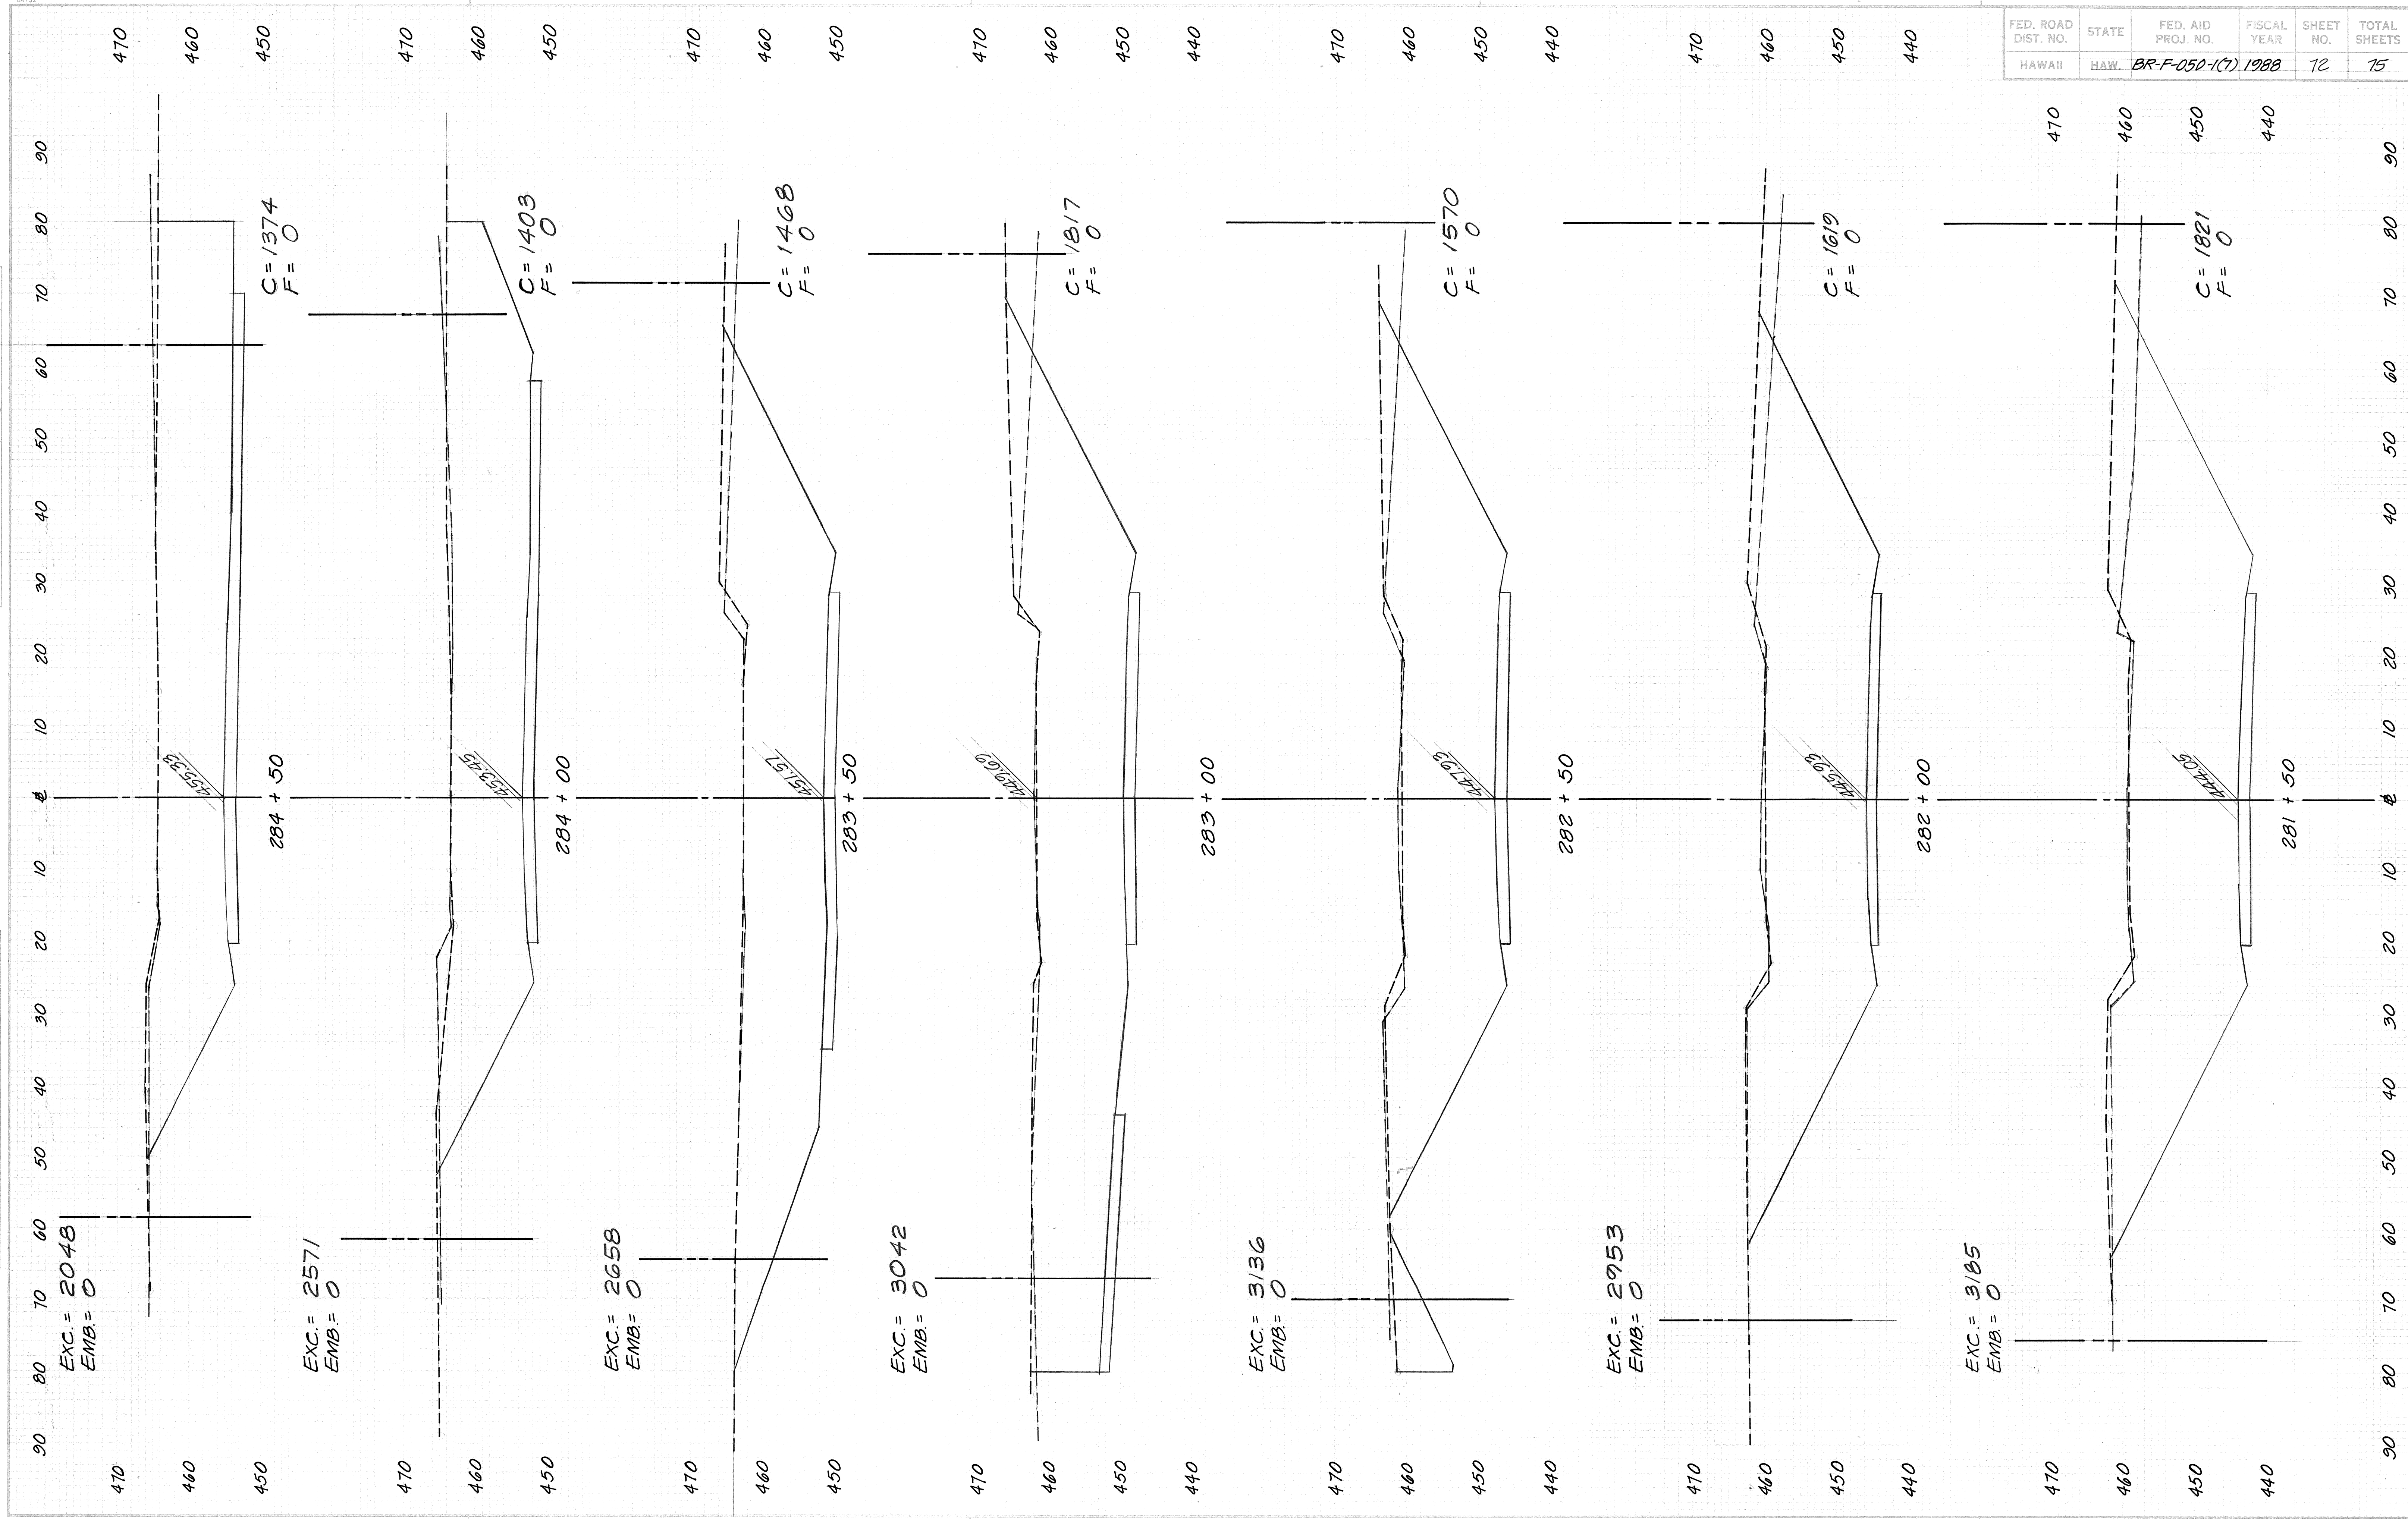

FED. ROAD DIST. NO.	STATE	FED. AID PROJ. NO.	FISCAL YEAR	SHEET NO.	TOTAL SHEETS
HAWAII	HAW.	BR-F-050-1(7)	1988	12	15

ORIGINAL	SURVEYED	BY	DATE
SURVEY	PLOTTED		
NOTE BOOK	REMARKS		
NO.	AREAS CHECKED		

FINAL	SURVEYED	BY	DATE
SURVEY	PLOTTED		
NOTE BOOK	REMARKS		
NO.	AREAS CHECKED		

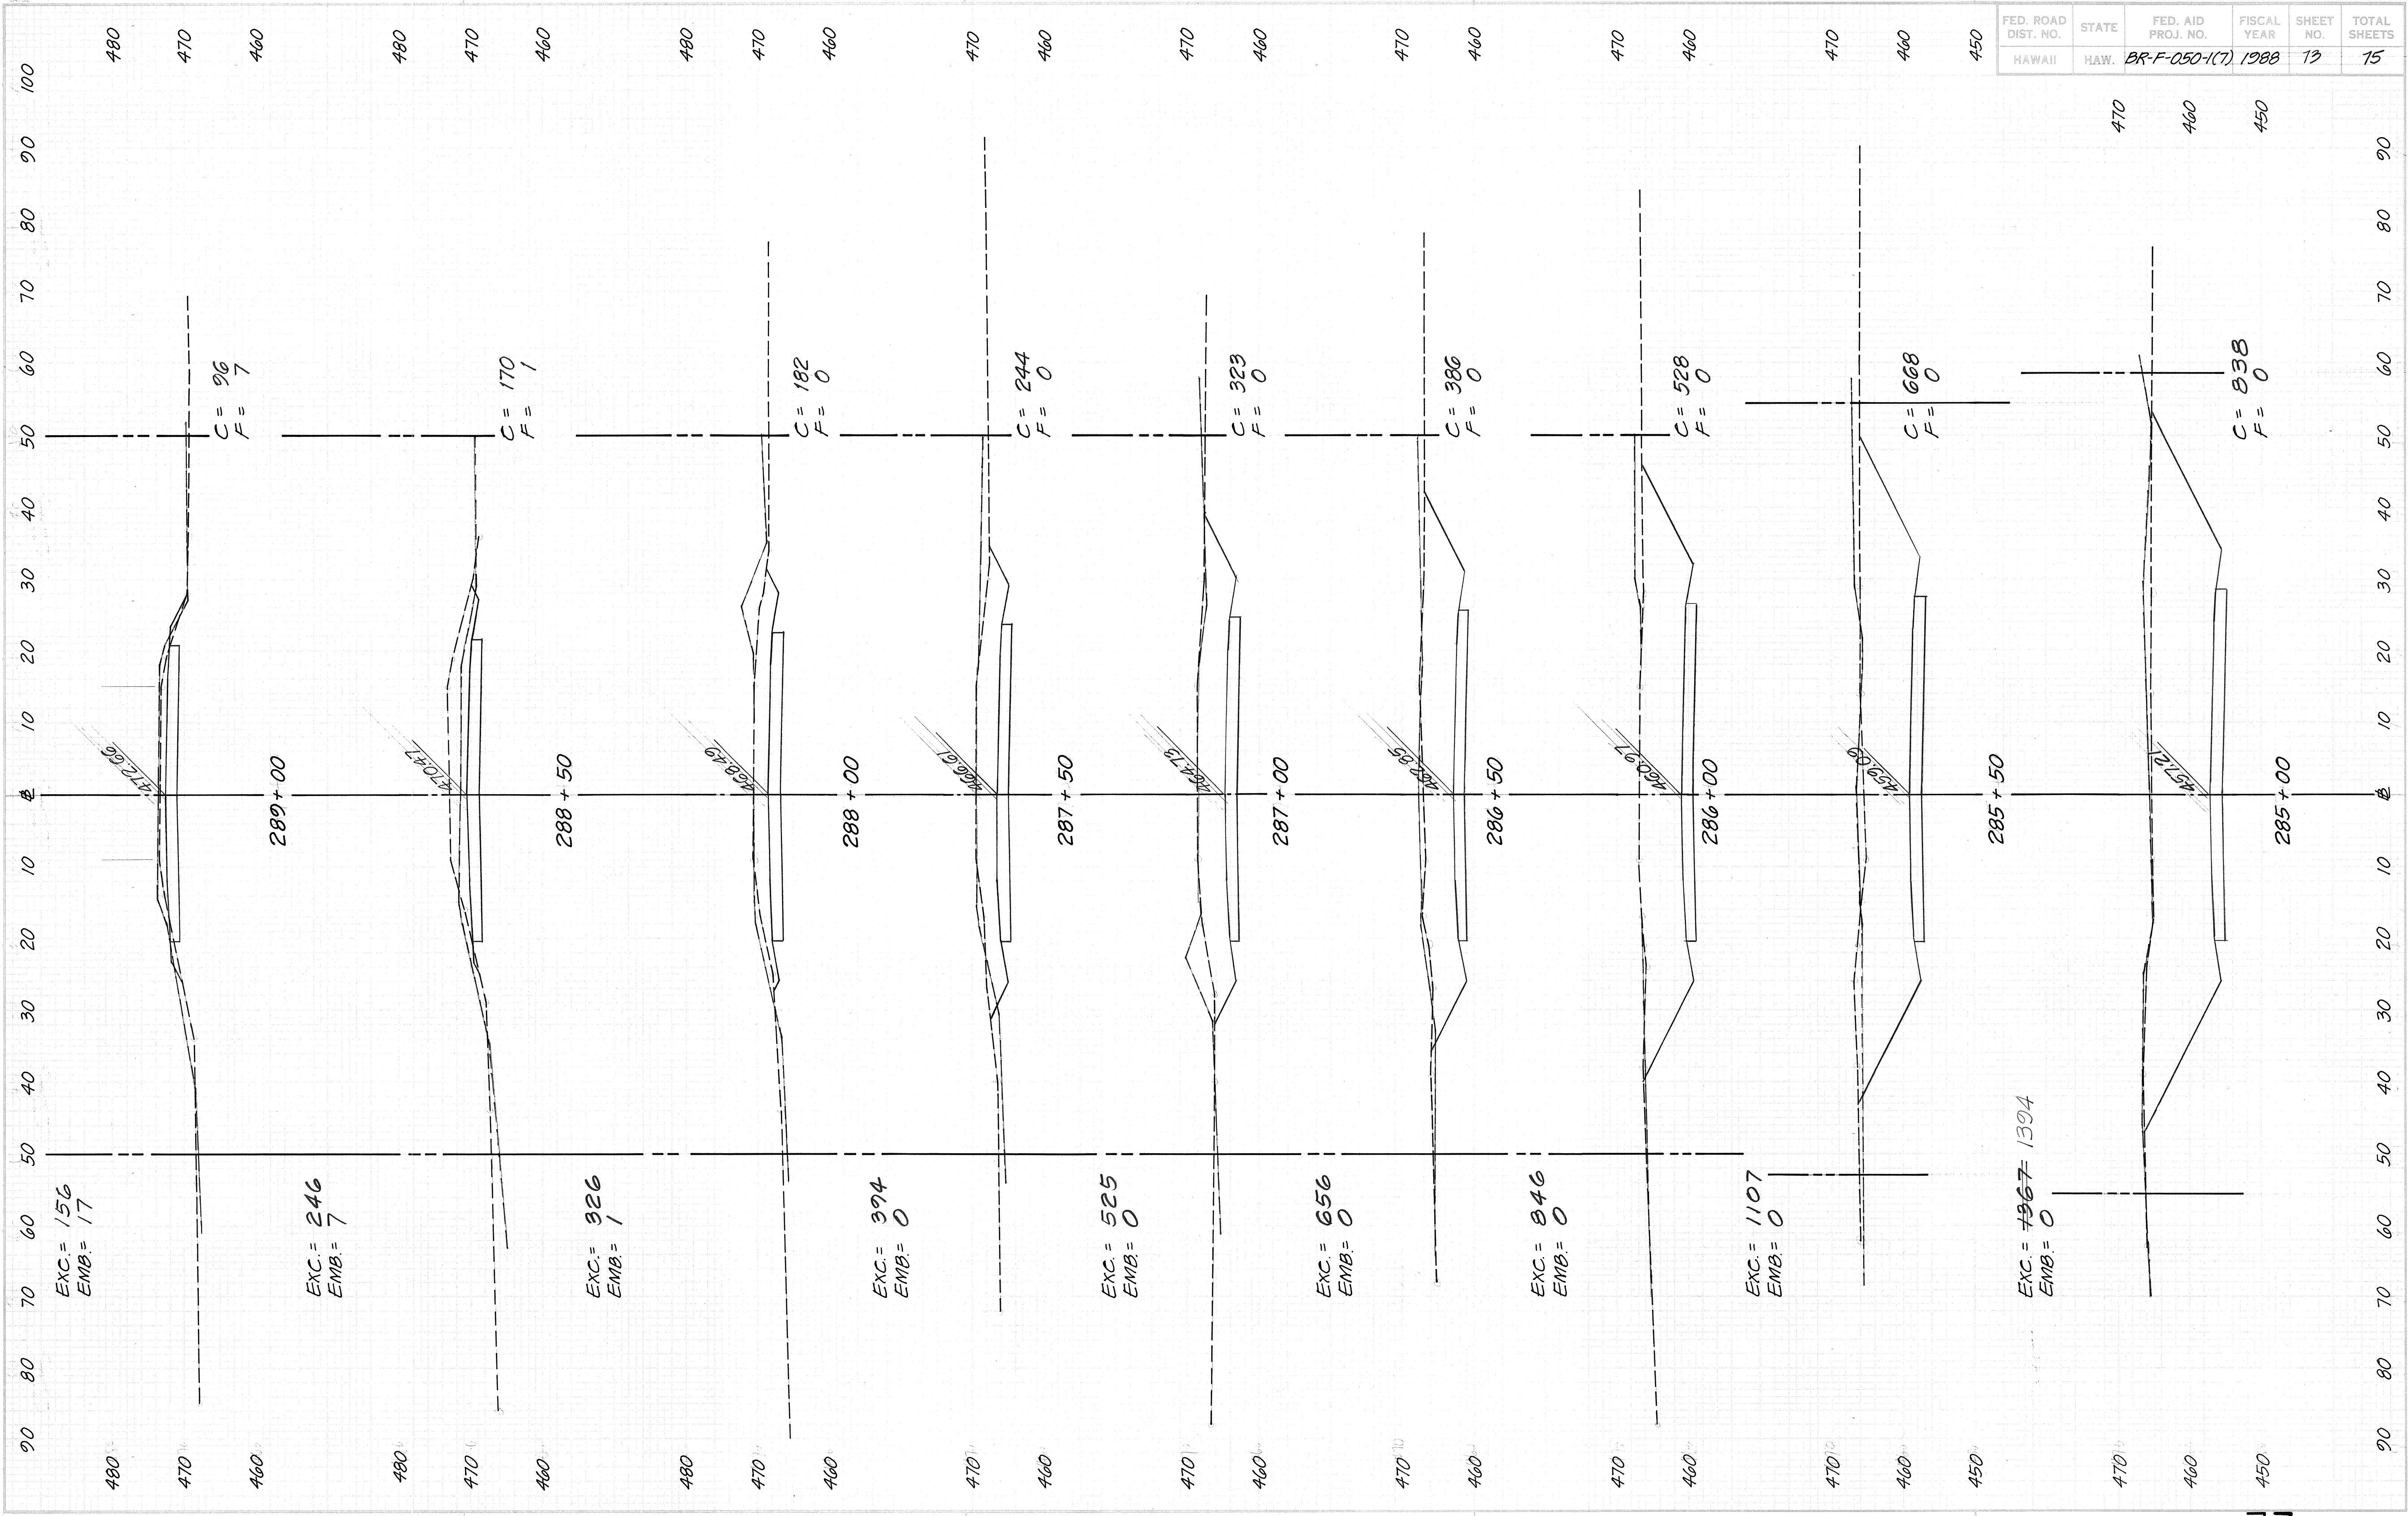

FED. ROAD DIST. NO.	STATE	FED. AID PROJ. NO.	FISCAL YEAR	SHEET NO.	TOTAL SHEETS
HAWAII	HAW.	BR-F-050-1(7)	1988	13	15

ORIGINAL	SURVEYED	BY	DATE
SURVEY	PLOTTED		
NOTE BOOK	TEMPLATE		
NO.	AREAS CHECKED		

FINAL	SURVEYED	BY	DATE
SURVEY	PLOTTED		
NOTE BOOK	TEMPLATE		
NO.	AREAS CHECKED		

94732

291+25

Exc. = 25
EMB. = 29

490

480

470

460

291+00

C = 55
F = 63

490

480

470

460

490

480

470

460

290+50

C = 64
F = 46

490

480

470

460

480

470

460

290+00

C = 109
F = 5

480

470

460

480

470

460

289+50

C = 72
F = 11

480

470

460

90

80

70

60

50

40

30

20

10

0

10

20

30

40

50

60

70

80

90

FED. ROAD DIST. NO.	STATE	FED. AID PROJ. NO.	FISCAL YEAR	SHEET NO.	TOTAL SHEETS
HAWAII	HAW.	BR-F-050-1(7)	1988	74	75

FED. ROAD DIST. NO.	STATE	FED. AID PROJ. NO.	FISCAL YEAR	SHEET NO.	TOTAL SHEETS
HAWAII	HAW.	BR-F-050-1(1)	1988	15	15

FINAL SURVEY	BY	DATE
SURVEYED		
PLOTTED		
NOTE BOOK		
AREAS CHECKED		
NO.		

ORIGINAL SURVEY	BY	DATE
SURVEYED		
PLOTTED		
NOTE BOOK		
AREAS CHECKED		
NO.		

