


DD-D-10-5

DESIGN UNIT C
DESIGNED BY
A. TAKESHITA
P. S. & E. BY
548-7537
PHONE
FEB. 1988
DATE

INDEX TO DRAWINGS	
SHEET NO.	DESCRIPTION
1	TITLE SHEET
2	STANDARD PLAN SUMMARY
3	TYPICAL SECTION
4-10	PLAN AND PROFILE
11	SUPERELEVATION
12-15	CONST. PHASING TYPICAL SECTION NOTES AND PLAN
16-19	PAV'T. MARKING & SIGNING PLANS
20-24	DRAINAGE PLANS & DETAILS
25-57	BRIDGE PLANS & DETAILS
58-75	CROSS-SECTION

STATE OF HAWAII
DEPARTMENT OF TRANSPORTATION
HIGHWAYS DIVISION
"AS-BUILT"
PLANS FOR
KAUMUALII HIGHWAY
HULEIA BRIDGE REPLACEMENT AND APPROACHES
FEDERAL AID PROJECT NO. BR-F-050-1(7)
DISTRICT OF LIHUE
ISLAND OF KAUAI

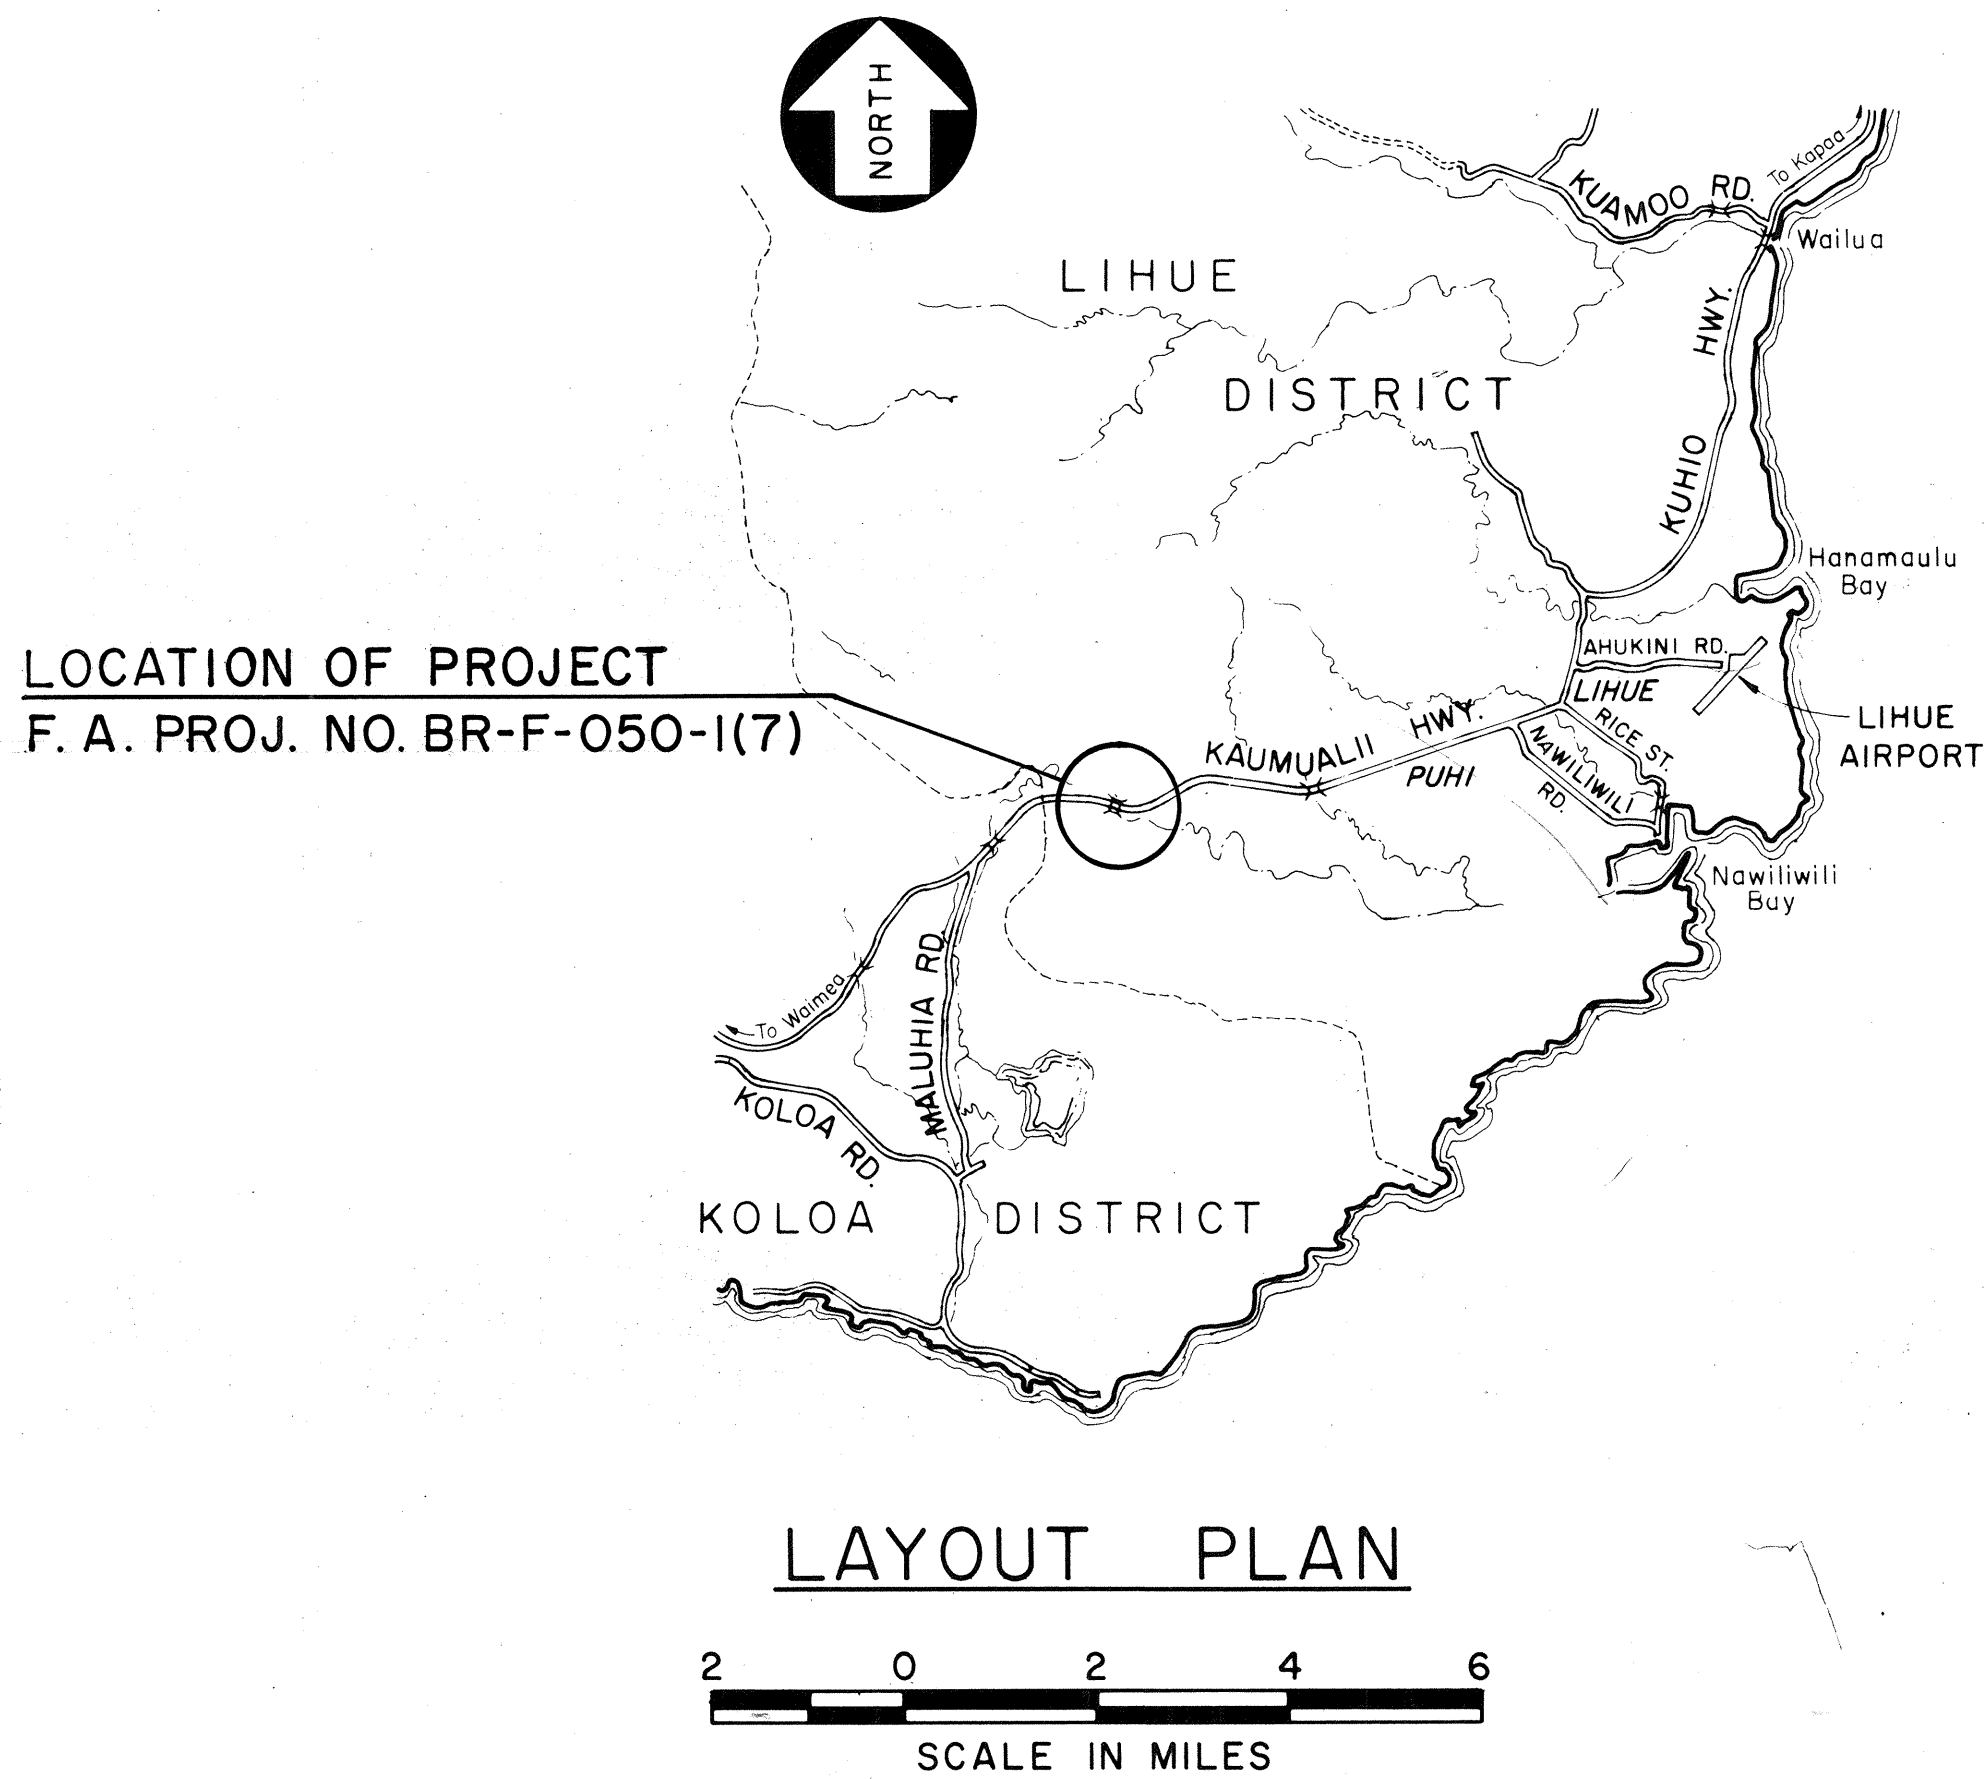

DESIGN DESIGNATION

CURRENT ADT (1986) . . . 14,400
DESIGN ADT (2006) . . . 24,700
DHV 2,350
D 75/25
T₂₄ 5.5%
V 60 M.P.H.

CHANGES MADE DURING CONSTRUCTION HAVE
BEEN NOTED ON THESE PLANS AND CHECKED BY:




[Signature]
RESIDENT ENGINEER

5-13-91
DATE

DEPARTMENT OF TRANSPORTATION
FEDERAL HIGHWAY ADMINISTRATION
APPROVED:
[Signature]
DIVISION ADMINISTRATOR
2/22/88
DATE

DEPARTMENT OF TRANSPORTATION
STATE OF HAWAII
APPROVED:
[Signature]
DIR. OF TRANSPORTATION
2/18/88
DATE

FED. ROAD DIST. NO.	STATE	FED. AID PROJ. NO.	FISCAL YEAR	SHEET NO.	TOTAL SHEETS
HAWAII	HAW.	BR-F-050-1(7)	1988	1	75

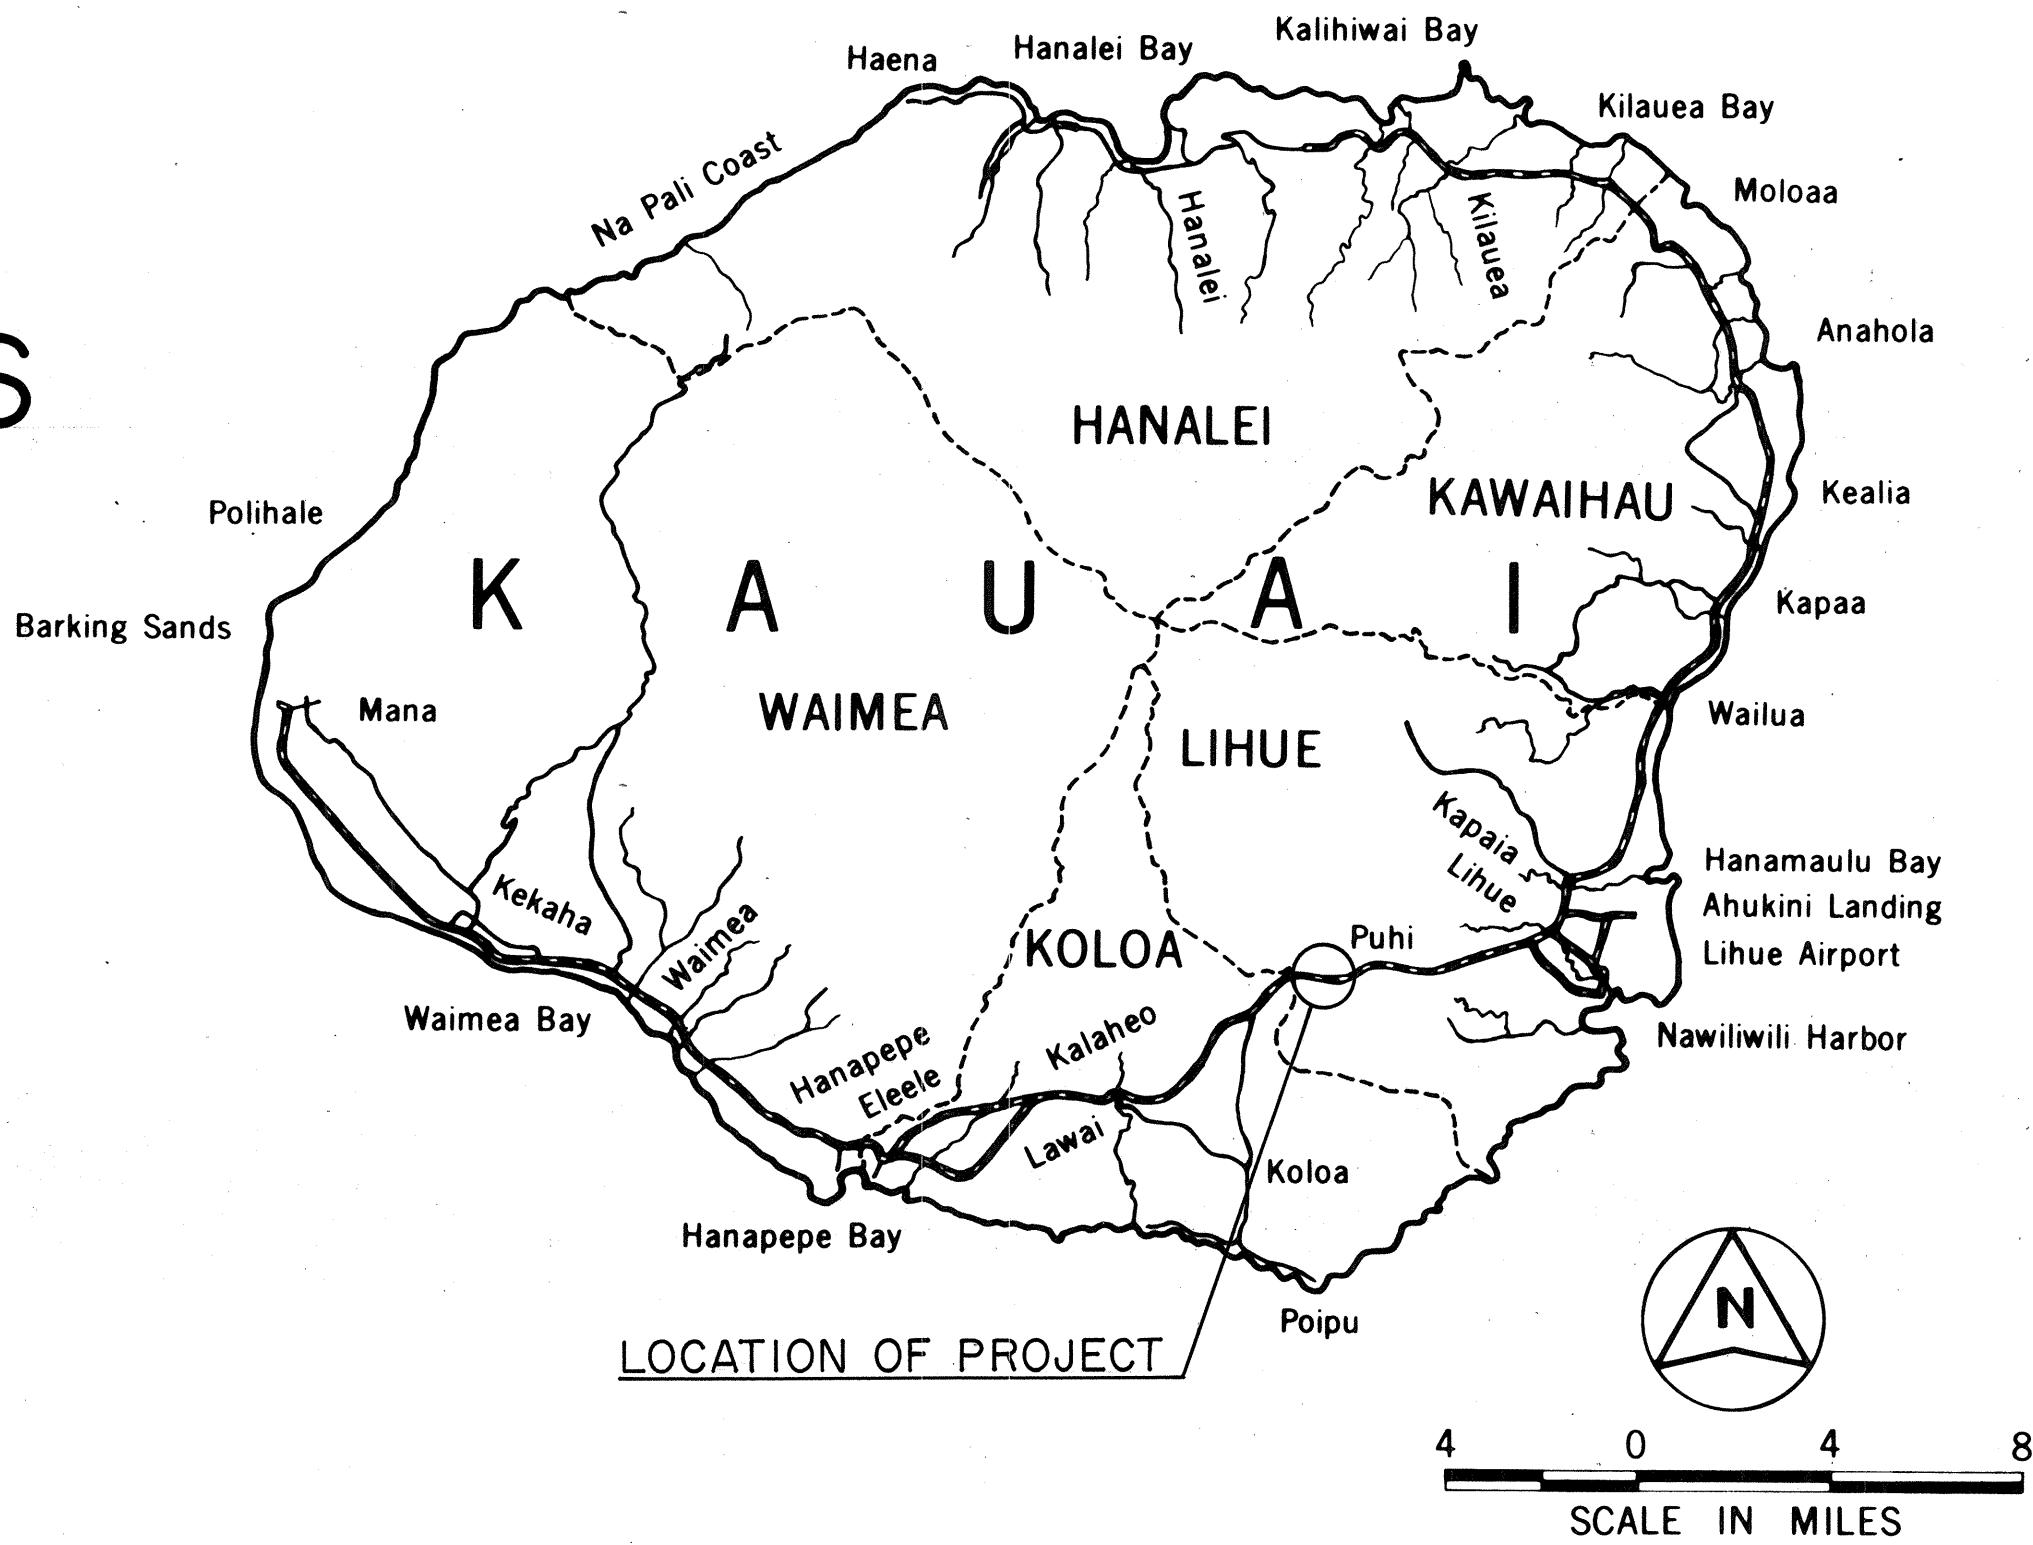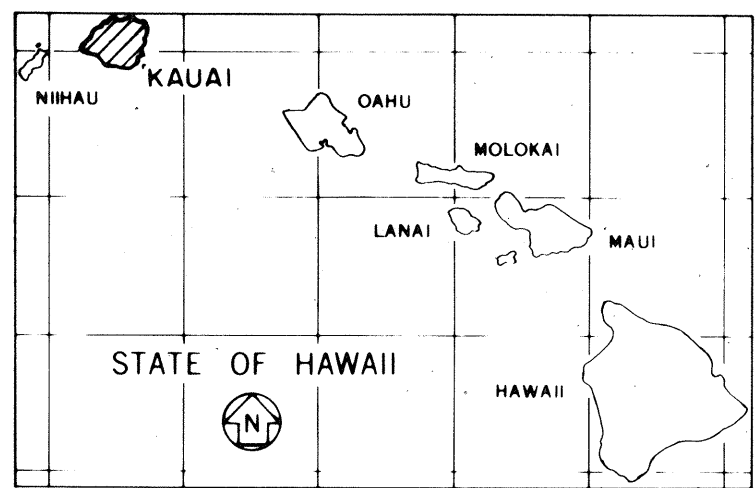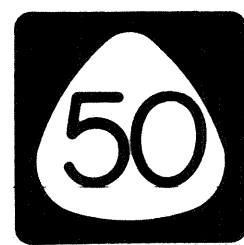

FEDERAL AID PROJECTS PREVIOUSLY CONSTRUCTED
OR UNDER CONSTRUCTION