	INDEX TO DRAWINGS
SHEET NO.	DESCRIPTION
derening aming animag in a series an area an area anna	TITLE SHEET
2	SUMMARY PLAN SHEET
3	LAYOUT PLAN, MISCELLANEOUS
N.	DETAILS AND GENERAL NOTES
in de la companya de	
oranga terminan ngakarakan ngakal <del>a daga d</del>	
e de la compressión de la comp	

MAY, 1988 DATE

548-4125 PHONE

R.TAKAESU P. S. & E. BY

KAUAI DISTRICT DESIGNED BY

STATE OF HAWAII

DEPARTMENT OF TRANSPORTATION


HIGHWAYS DIVISION

"AS BUILT"

PLANS FOR

HANAPEPE BRIDGE,
REPAIR SPALLS ON CONCRETE GIRDERS
PROJECT NO. HWY - K - 02-88M

DISTRICT OF WAIMEA
ISLAND OF KAUAI

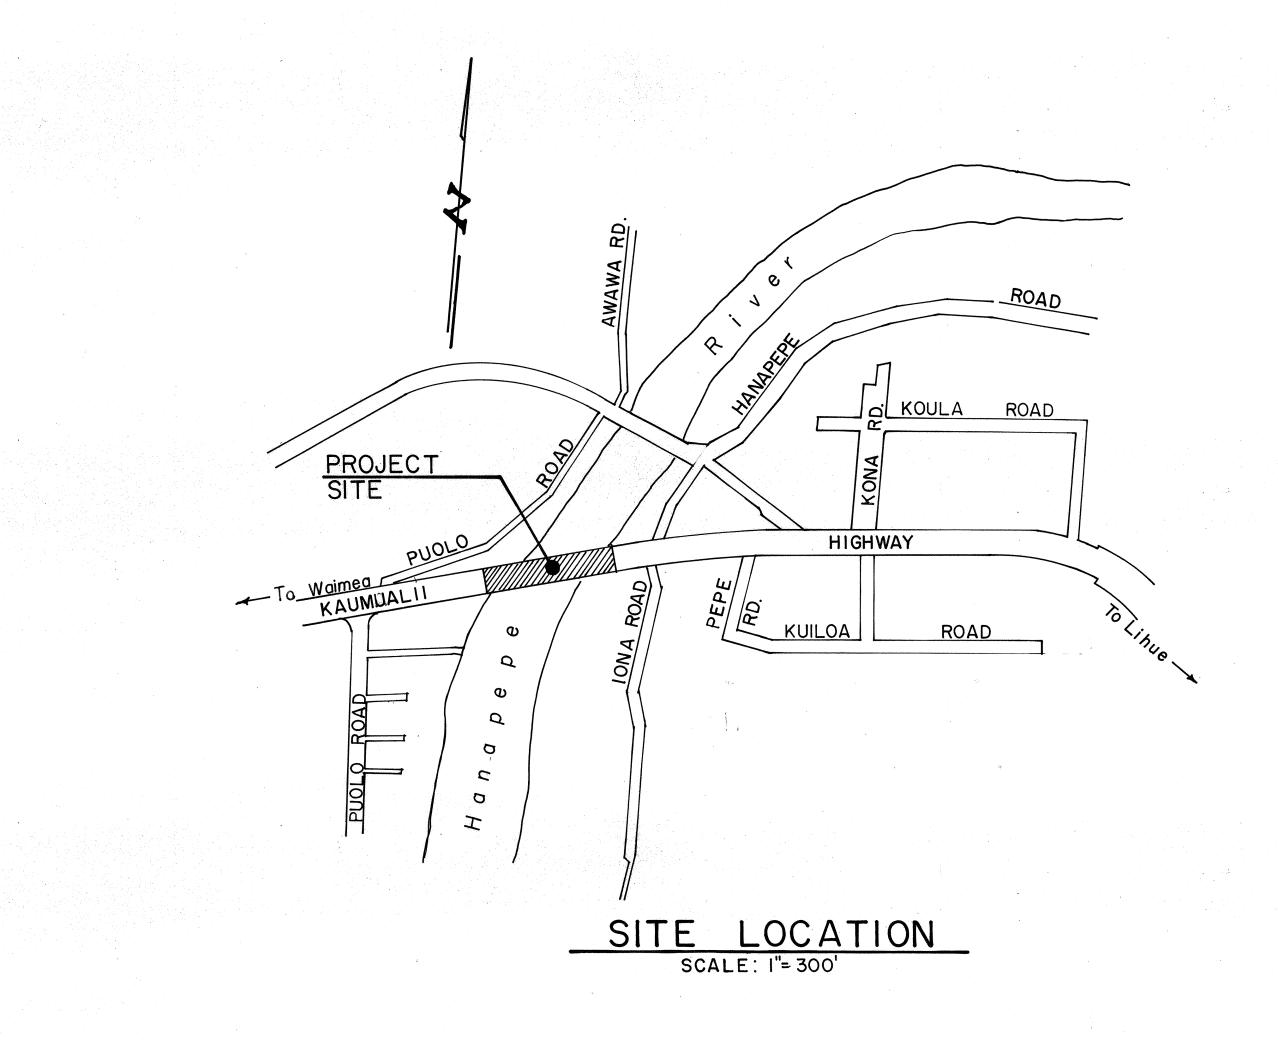

FED. ROAD DIST. NO.

HAWAII

HAW.

STATE


FISCAL SHEET TOTAL YEAR


NO.


SHEETS

1

3

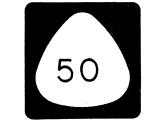

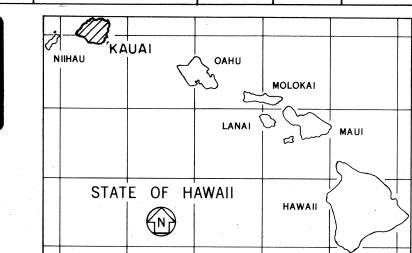

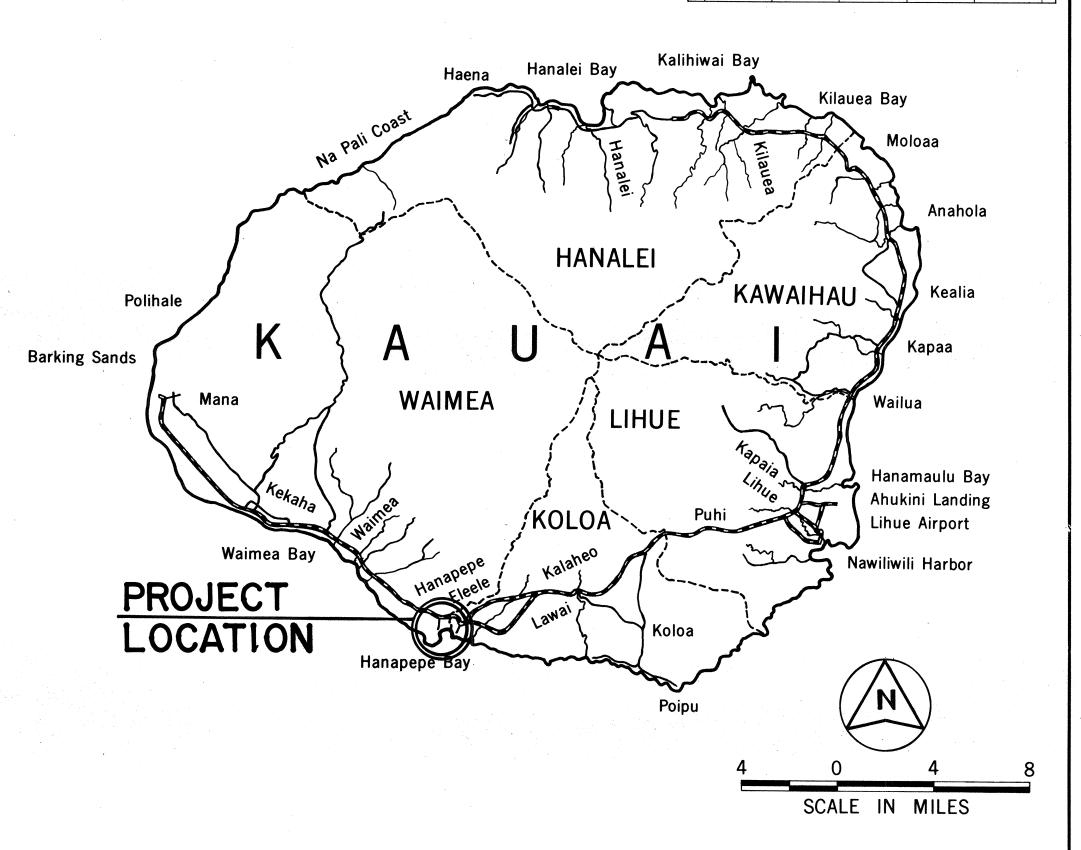

FEDERAL AID PROJECTS PREVIOUSLY CONSTRUCTED
OR UNDER CONSTRUCTION

CHANGES MADE DURING CONSTRUCTION HAVE BEEN INCORPORATED ON THESE PLANS EXCEPT CHANGES IN THE ORIGINAL THEORETICAL QUANTITIES, FOR ACTUAL QUANTITIES, REFER TO PROJECT LEDGER AND/OR COMPUTATION BOOK.

RESIDENT ENGINEER

4/14/09 DATE

DEPARTMENT OF TRANSPORTATION
STATE OF HAWAII

APPROVED:

Solution

DIR OF TRANSPORTATION

DIR OF TRANSPORTATION

DATE

DATE