	INDEX TO DRAWINGS
SHEET NO.	DESCRIPTION
	TITLE SHEET
2	STANDARD PLANS SUMMARY
3	GENERAL NOTES AND PLANS
4	PLANS
5	WORK SCHEDULE, GUARDRAIL
	DETAIL
6	DETAILS-CONC. RAMP, REVISED
•	BRIDGE END POST
7	DETAILS

STATE OF HAWAII


DEPARTMENT OF TRANSPORTATION HIGHWAYS DIVISION HONOLULU, HAWAII

"AS-BUILT"

PLANS FOR


KAUMUALII HIGHWAY GUARDRAIL IMPROVEMENTS AT VARIOUS LOCATIONS, WAHIAWA STREAM BRIDGE TO WAIMEA STREAM BRIDGE

> PROJECT NO. 50BC - OI - 89 DISTRICT OF WAIMEA ISLAND OF KAUAI

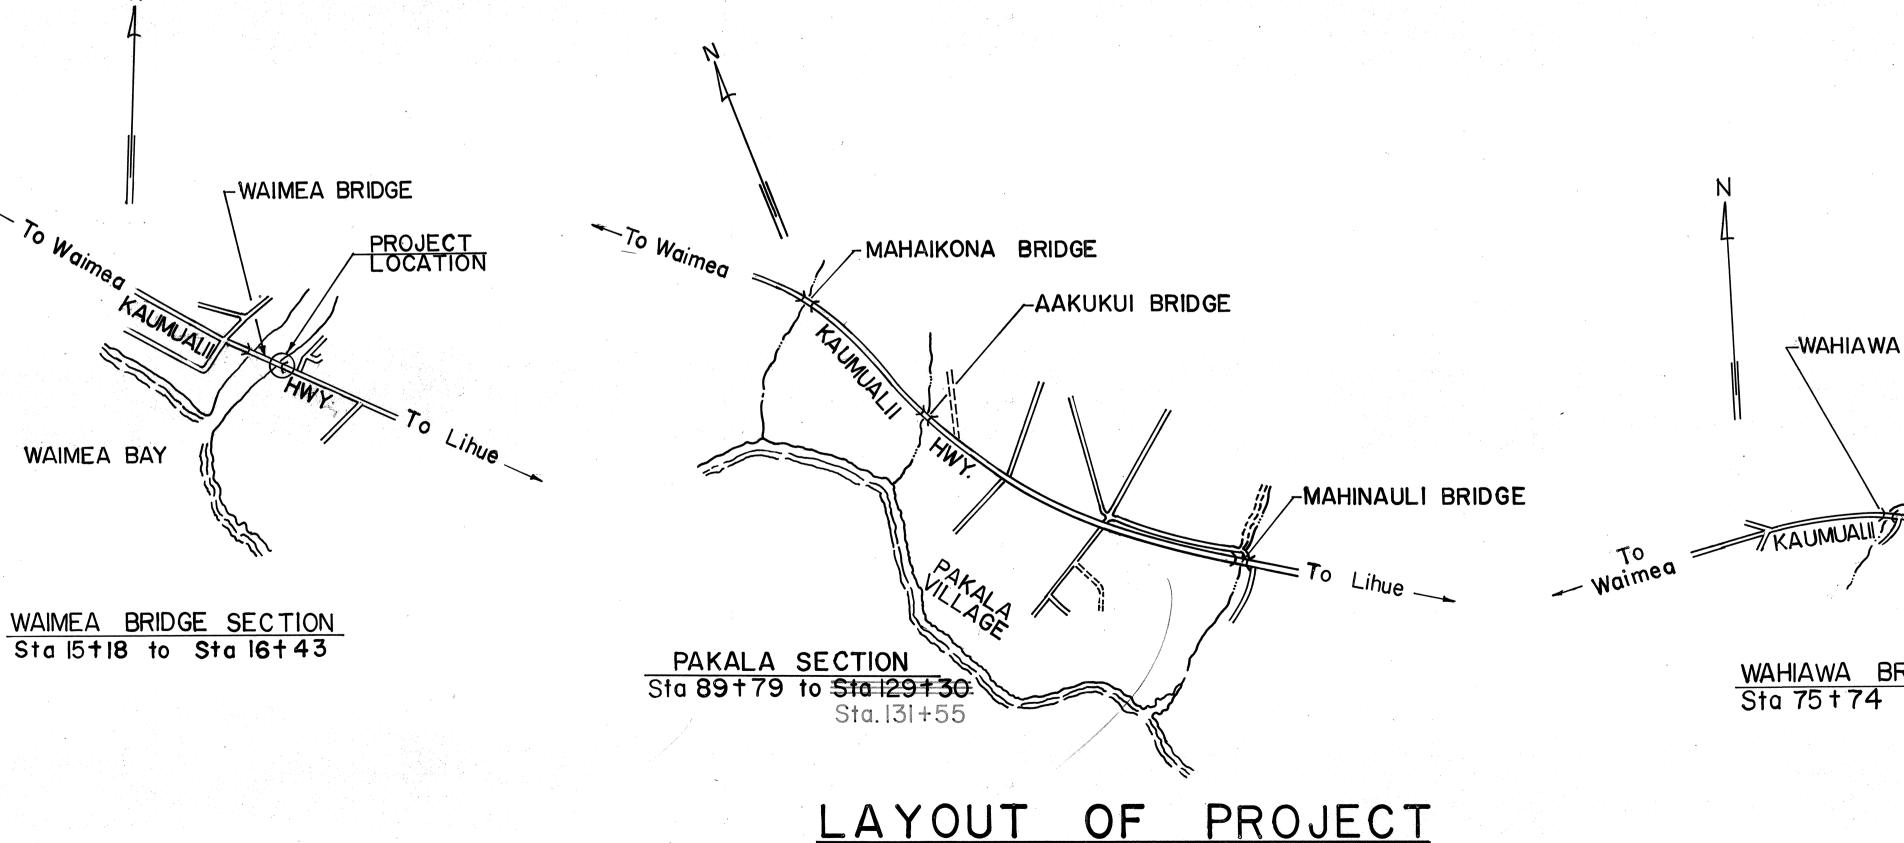


50BC - 01-89

PROJ. NO.

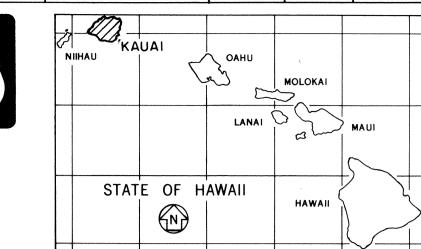

FISCAL SHEET TOTAL YEAR NO. SHEETS

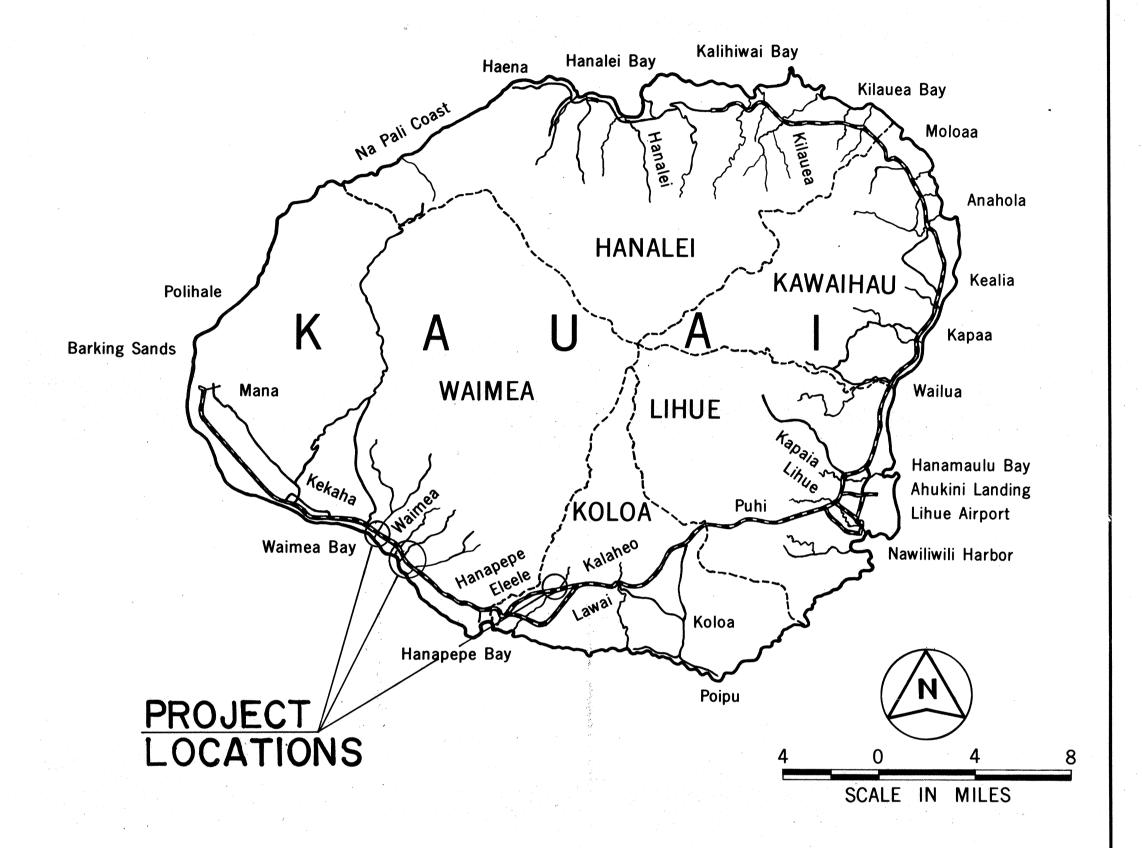

FED. ROAD DIST. NO.

STATE

FEDERAL AID PROJECTS PREVIOUSLY CONSTRUCTED OR UNDER CONSTRUCTION

MILE POST _____ TO MILE POST _____

←WAHIAWA BRIDGE

CHANGES MADE DURING CONSTRUCTION HAVE BEEN INCORPORATED ON THESE PLANS EXCEPT CHANGES IN THE ORIGINAL THEORETICAL QUANTITIES. FOR ACTUAL QUANTITIES, REFER TO PROJECT LEDGER AND/OR COMPUTATION BOOK.

Donel H Maeda RESIDENT ENGINEER WAHIAWA BRIDGE SECTION
Sta 75 + 74 to Sta 80 + 74

6/27/90 DATE

DEPARTMENT OF TRANSPORTATION STATE OF HAWAII APPROVED:

SCALE: |" = 1000"

JUNE, 1989 DATE

548-7534 PHONE

A. YAMAGUCHI P. S. & E. BY

KAUAI DISTRICT DESIGNED BY