



FED. ROAD DIST. NO.	STATE	PROJ. NO.	FISCAL YEAR	SHEET NO.	TOTAL SHEETS
HAWAII	HAW.	508C-01-89	1990	ADD.5	7

INSTALLATION SCHEDULE

STATION	GUARDRAIL STEEL POST W/ RUBRAIL	GUARD W/ STEEL POST (Ft)	TERMINAL SECTION	DELINEATOR
0+00 - 16+30 Rt	37.5	100	TYPE F	2-RM-1, 6-RM-3, 2-RM-4
8+60 - 16+43 Lt	37.5	87.5	TYPE C	3-RM-1, 6-RM-3, 2-RM-4
71+94 - 73+58 Rt	37.5	101.5	(25') BCT	1-RM-1, 4-RM-3, 1-RM-4
71+94 - 73+58 Lt	37.5	101.5	(25') BCT	2-RM-1, 2-RM-3, 1-RM-4
74+40 - 84+54 Rt	37.5	951.5	(25') BCT	10-RM-1, 2-RM-3, 1-RM-4
74+40 - 84+54 Lt	37.5	951.5	(25') BCT	9-RM-1, 4-RM-3, 1-RM-4
89+97 - 91+22 Rt	37.5	62.5	(25') BCT	4-RM-3, 1-RM-4
89+79 - 91+04 Lt	37.5	62.5	(25') BCT	2-RM-3, 1-RM-4
91+86 - 93+11 Rt	37.5	62.5	(25') BCT	2-RM-3, 1-RM-4
91+66 - 92+91 Lt	37.5	62.5	(25') BCT	4-RM-3, 1-RM-4
118+85 - 126+85 Rt	37.5	737.5	(25') BCT	7-RM-1, 4-RM-3, 1-RM-4
118+97.5 - 126+85 Lt	37.5	725	(25') BCT	8-RM-1, 2-RM-3, 1-RM-4
128+05 - 129+43 Rt	37.5	100	TYPE F	2-RM-3, 1-RM-4
128+05 - 129+30 Lt	37.5	87.5	TYPE C	4-RM-3, 1-RM-4
129+30 - 131+55 Lt		22.5	TYPE C	4-RM-3, 4-RM-1
74+15 - 83+50	37.5	437.5	(25') BCT	12-RM-1, 12-RM-3, 4-RM-4

REMOVE & SALVAGE SCHEDULE

STATION	GUIDE-POST (ea)	WOOD. GUARD RAIL/ POST (Ft)	GUARDRAIL/CONC OR STEEL POST (Ft)	DELINEATOR AND POST (EA)
15+18 - 16+31 Rt				3-RM-3 1-RM-4
15+18 - 16+31 Lt				5-RM-3 1-RM-4
71+94 - 73+58 Rt	6		62.5	5-RM-3 1-RM-4
71+94 - 73+58 Lt		162		3-RM-3 1-RM-4
74+40 - 84+54 Rt	54			3-RM-3 1-RM-4
74+40 - 84+54 Lt		936	62.5	5-RM-3 1-RM-4
90+56 - 91+22 Rt			62.5	4-RM-3 1-RM-4
90+56 - 91+00 Lt				3-RM-3 1-RM-4
91+75 - 92+40 Rt				2-RM-3 1-RM-4
91+75 - 92+40 Lt			62.5	5-RM-3 1-RM-4
118+76 - 126+84 Rt		738	62.5	5-RM-3 1-RM-4
119+00 - 126+84 Lt	44			3-RM-3 1-RM-4
128+06 Rt				1-RM-3 1-RM-4
128+06 - 128+71 Lt			62.5	1-RM-3 1-RM-4
80+11 - 80+74 Lt			62.5	

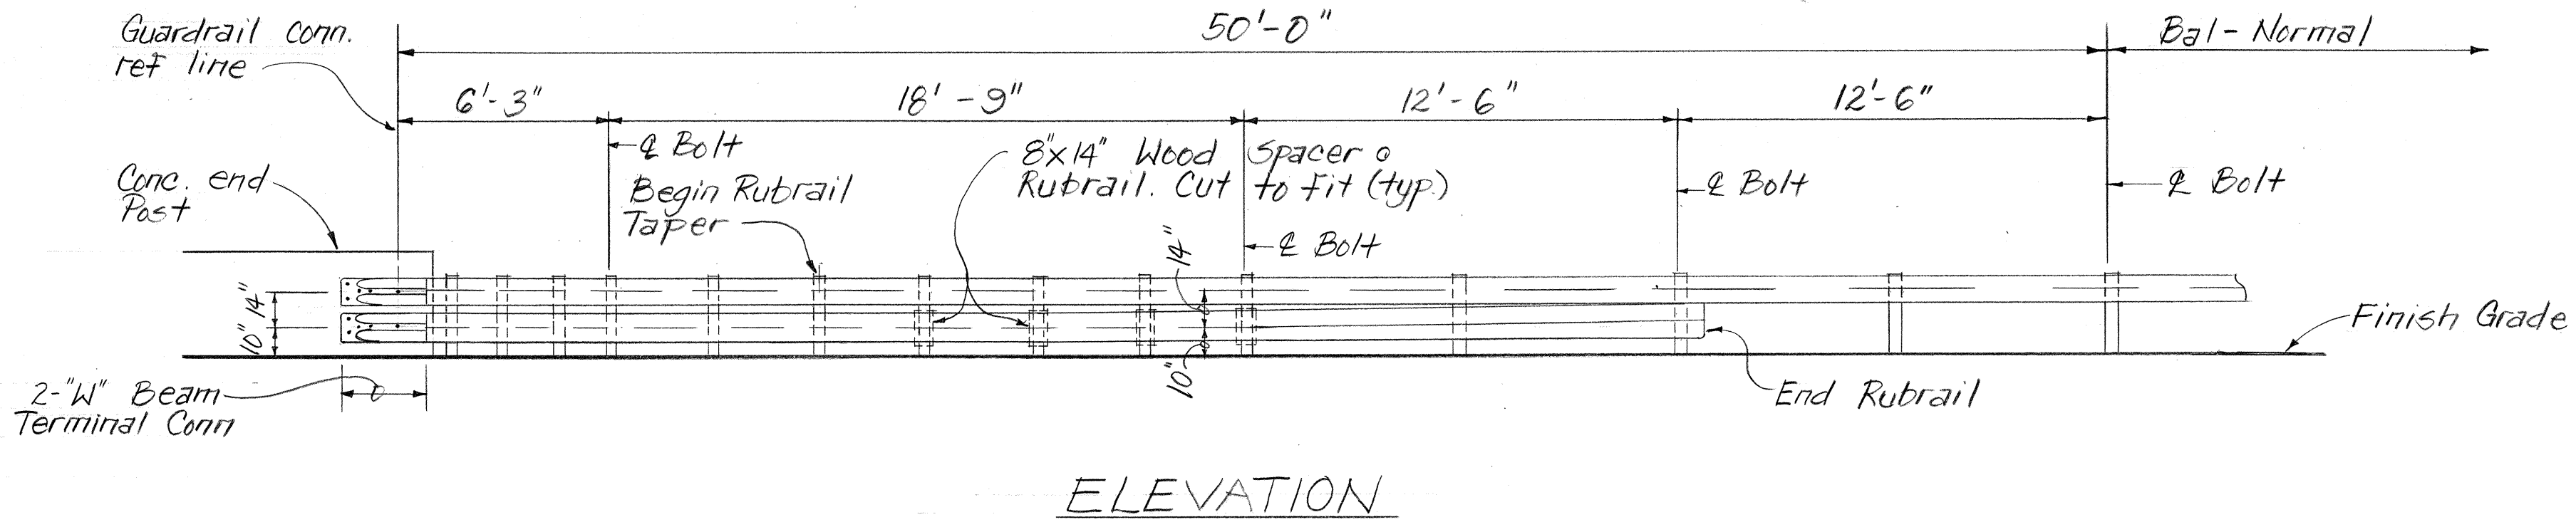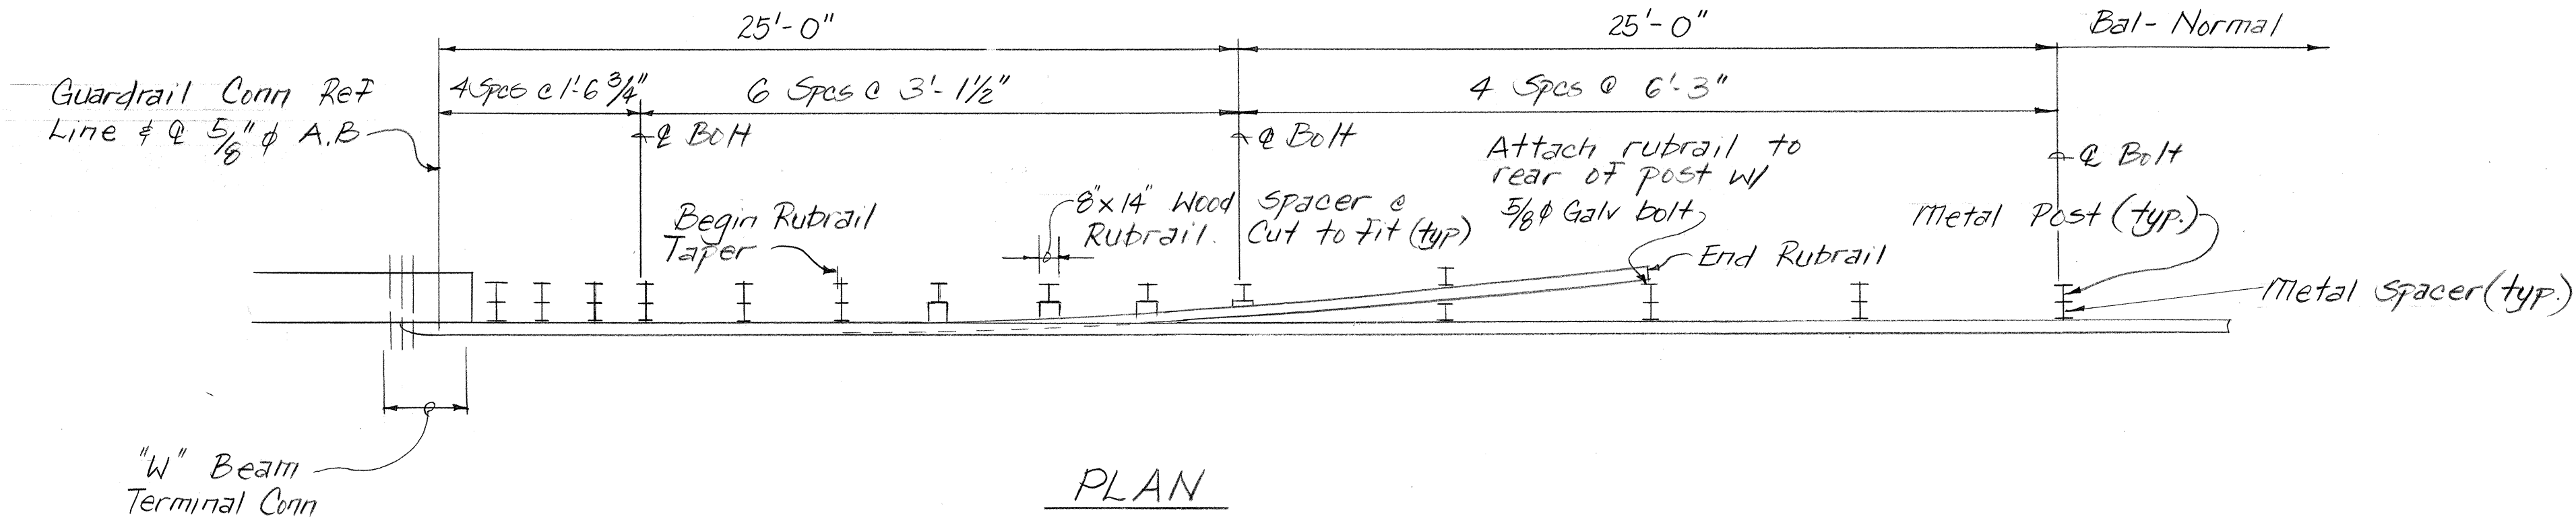

BEAM TYPE GUARDRAIL WITH RUBRAIL CONN. & SPACING DETAIL
Scale: 1/4" = 1'-0"

8/22/89 Revised Delineator Quantities
DATE REVISION

STATE OF HAWAII
DEPARTMENT OF TRANSPORTATION
HIGHWAYS DIVISION
WORK SCHEDULE, GUARDRAIL DETAIL
KAUMUALII HIGHWAY
GUARDRAIL IMPROVEMENTS AT
VARIOUS LOCATIONS
WAHIAWA BRIDGE TO WAIWEEA BRIDGE
PROJECT NO. 508C-01-89
Scale: As Shown Date: June, 1989
SHEET No. 1 OF 1 SHEETS